

RE: NEW LONDON VILLAGE-
PLANT 1

Report
Drinking Water Program
Huron County
PWS ID: OH3900911

3-6-17



VILLAGE OF

NEW LONDON

Inc OHIO 1854

Public Side SERVICE LINE	①	Private Side SERVICE LINE
LEAD	●	LEAD
LEAD	●	NONLEAD
LEAD	●	NO INFO
NONLEAD	●	LEAD
NONLEAD	●	NONLEAD
NONLEAD	●	NO INFO
NO INFO	●	LEAD
NO INFO	●	NONLEAD
NO INFO	●	NO INFO

○	CUSTOMER PLUMBING
●	LEAD
●	NON LEAD
●	NO INFO



RECEIVED

MAR 08 2017

DDAGW - NWDO



STATE ROUTE NORTH MAIN


Biglow Pkwy
NOT DEDICA

60 STREET

RECEIVED
MAR 08 2017
DDAGW - NWDO

1:100

CHABLES
PARKWAY

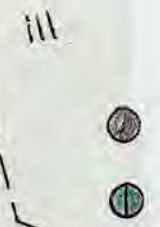



1:100

RECEIVED


MAR 08 2017

DDAGW - NWDO

W. FIR St.

50

50

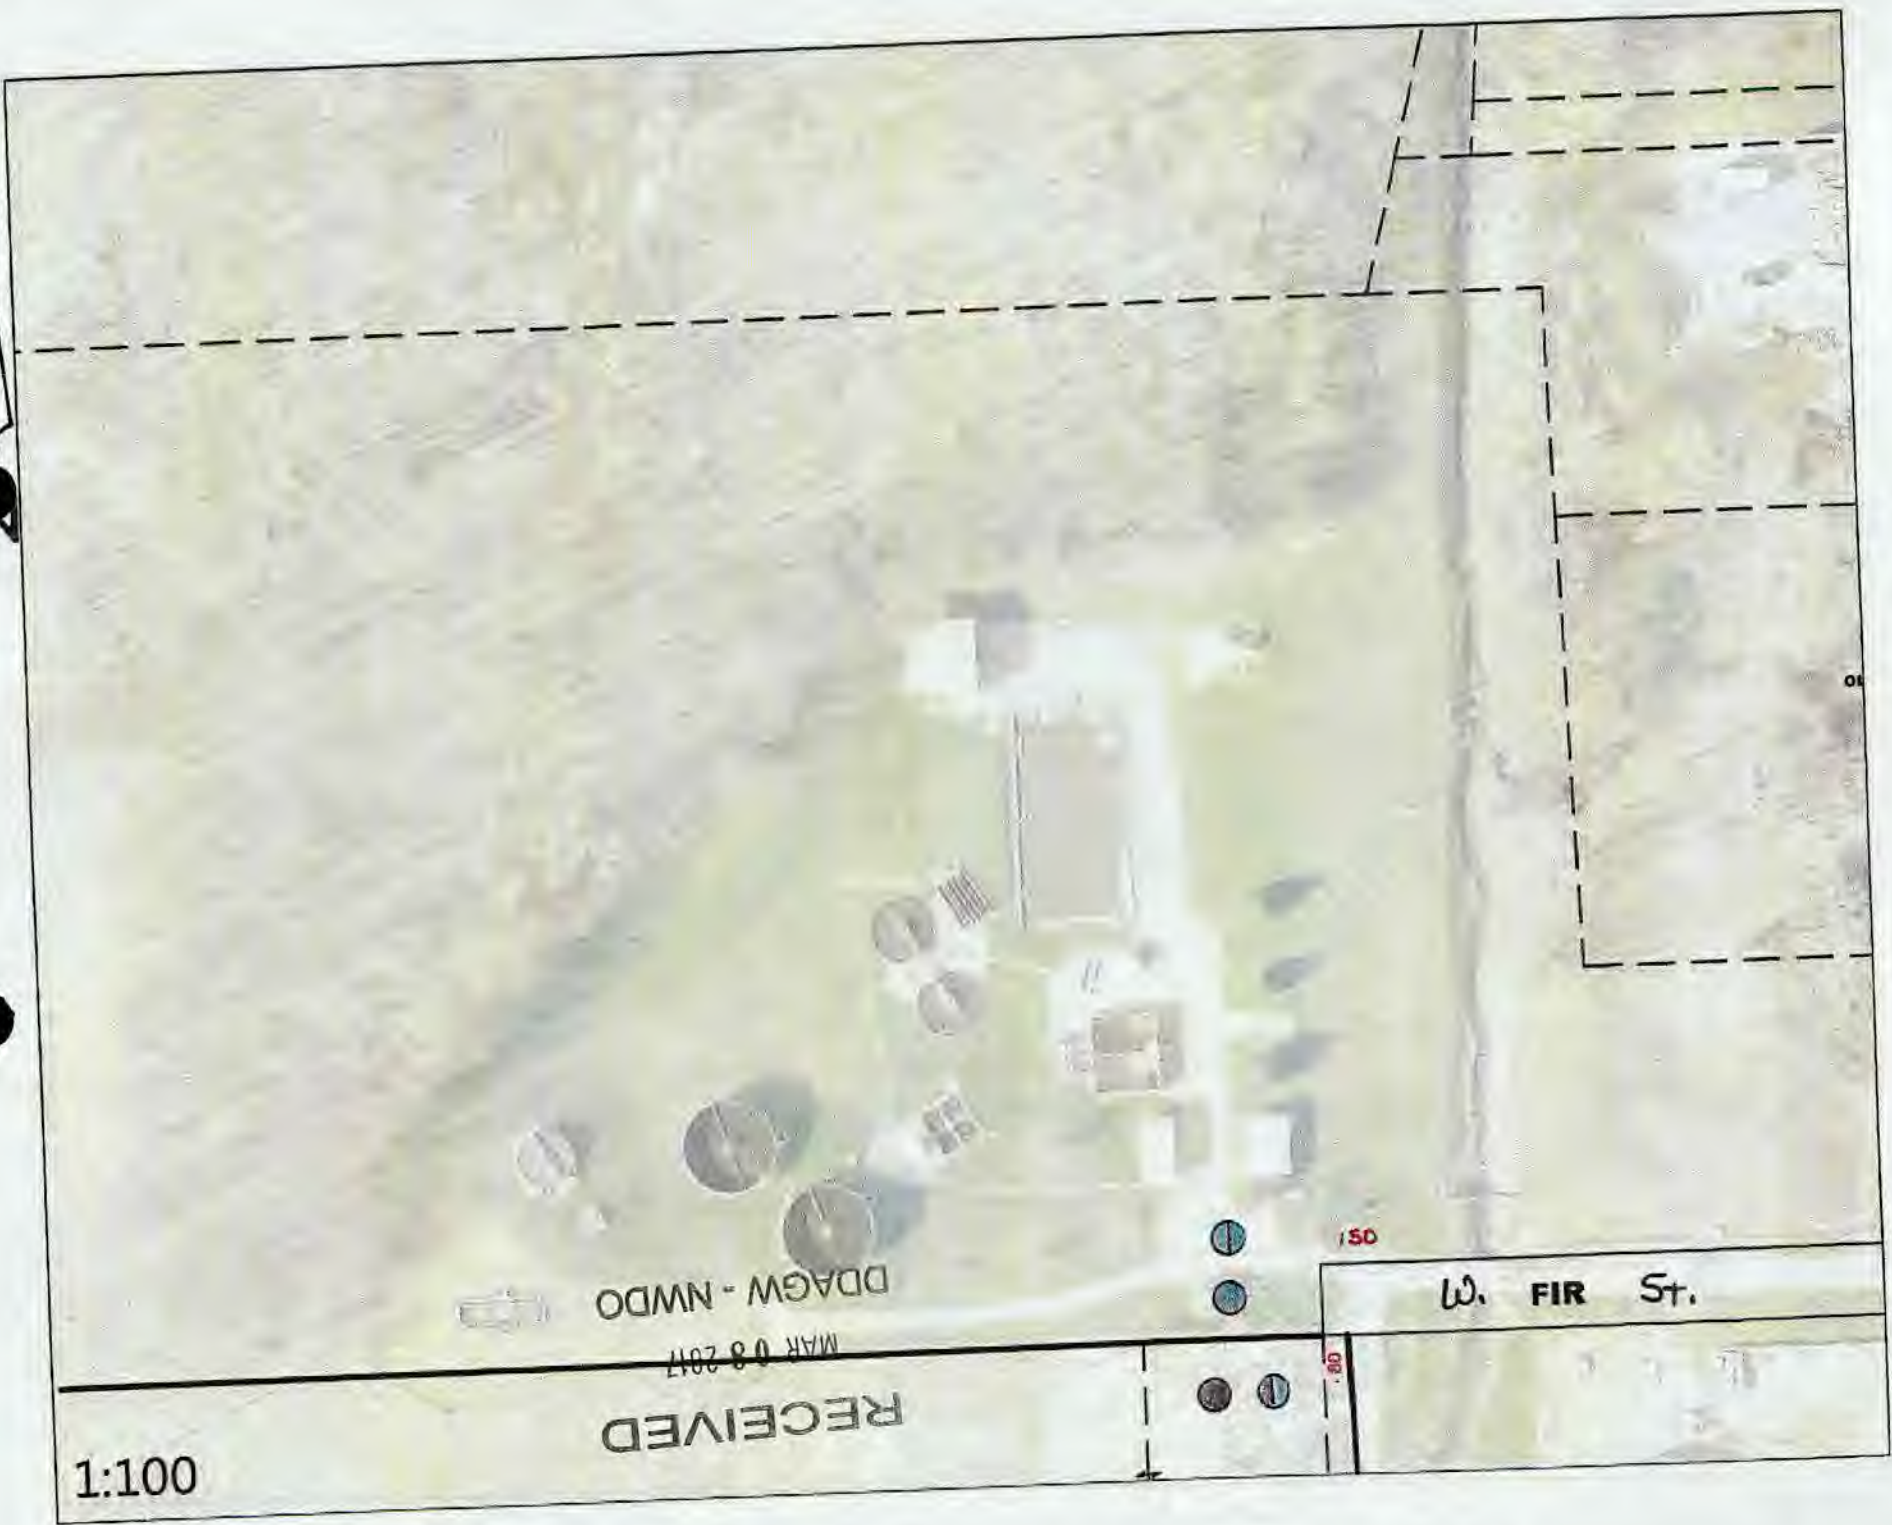



RECEIVED


DDAGW - NWDO

201

60' R/W

STATE
NORTH

ROUTE

MAI

206

189

184

182

183

185

29

PARKWAY

CHARLES

STREET

40' R/W

OL 14

7

37

1:100

OL 14



RECEIVED

MAR 08 2017

DDAGW - NWDO

VACATED 07-17-01
ORD. # 00-18 OR 107/754-783
REC. PLAT 20 PG. 38 & 39



1:100

W. FIR

DDAGW - NWDO

STREET

50' R/W

60' R/W

EDGEHILL ST

RECEIVED

MAR 08 2017

DDAGW - NWDO

N ↑

NOT DEDICATED

1:100

N. RAILROAD ST.

GRIFFIN RD.

5498



OL 12

RECEIVED

MAR 08 2017


DDAGW - NWDO

40' R/W

W. WASHBURN ST.

CENTER LINE OF CLINTON RAILROAD

1:100

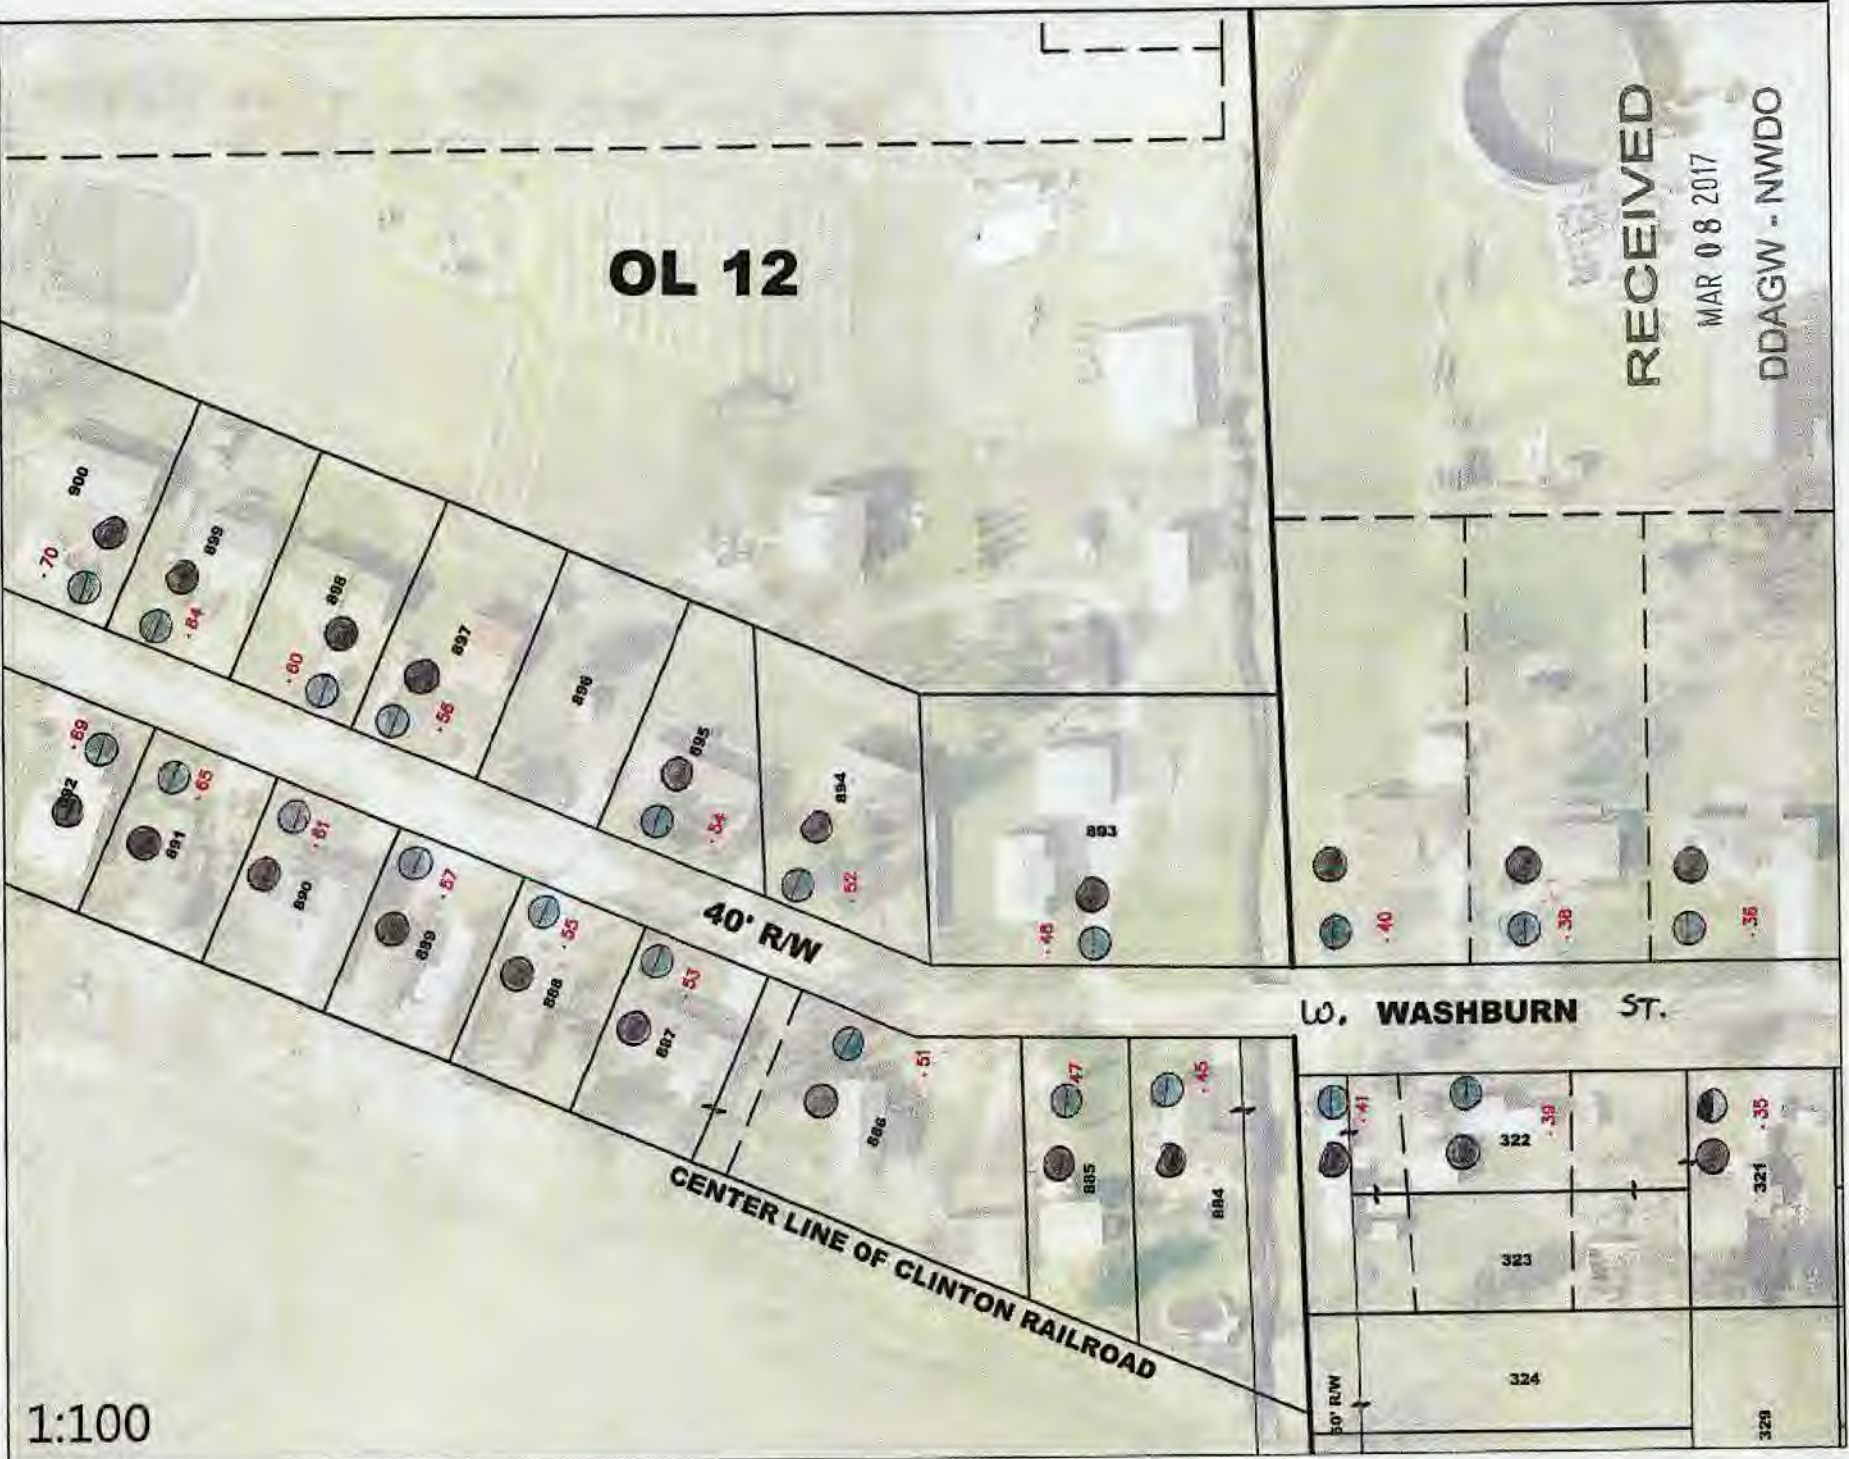

OL 13

RECEIVED

MAR 08 2017

DDAGW - NWDO

NEW LONDON MOBILE TEL. PARK

W. WASHBURN STREET

60' R/W

GRANT ST.
60' R/W

1:100

60

STREET
60' R/W

2

176

175

32

313

311

309

152

321

71

31

75

318

73

316

29

315

25

314

23

312

15

310

ORD. 78-15

60' R/W

STREET

VACATED

LIFTON

9

9 1/2

308

7

307


4

306

2

305

135

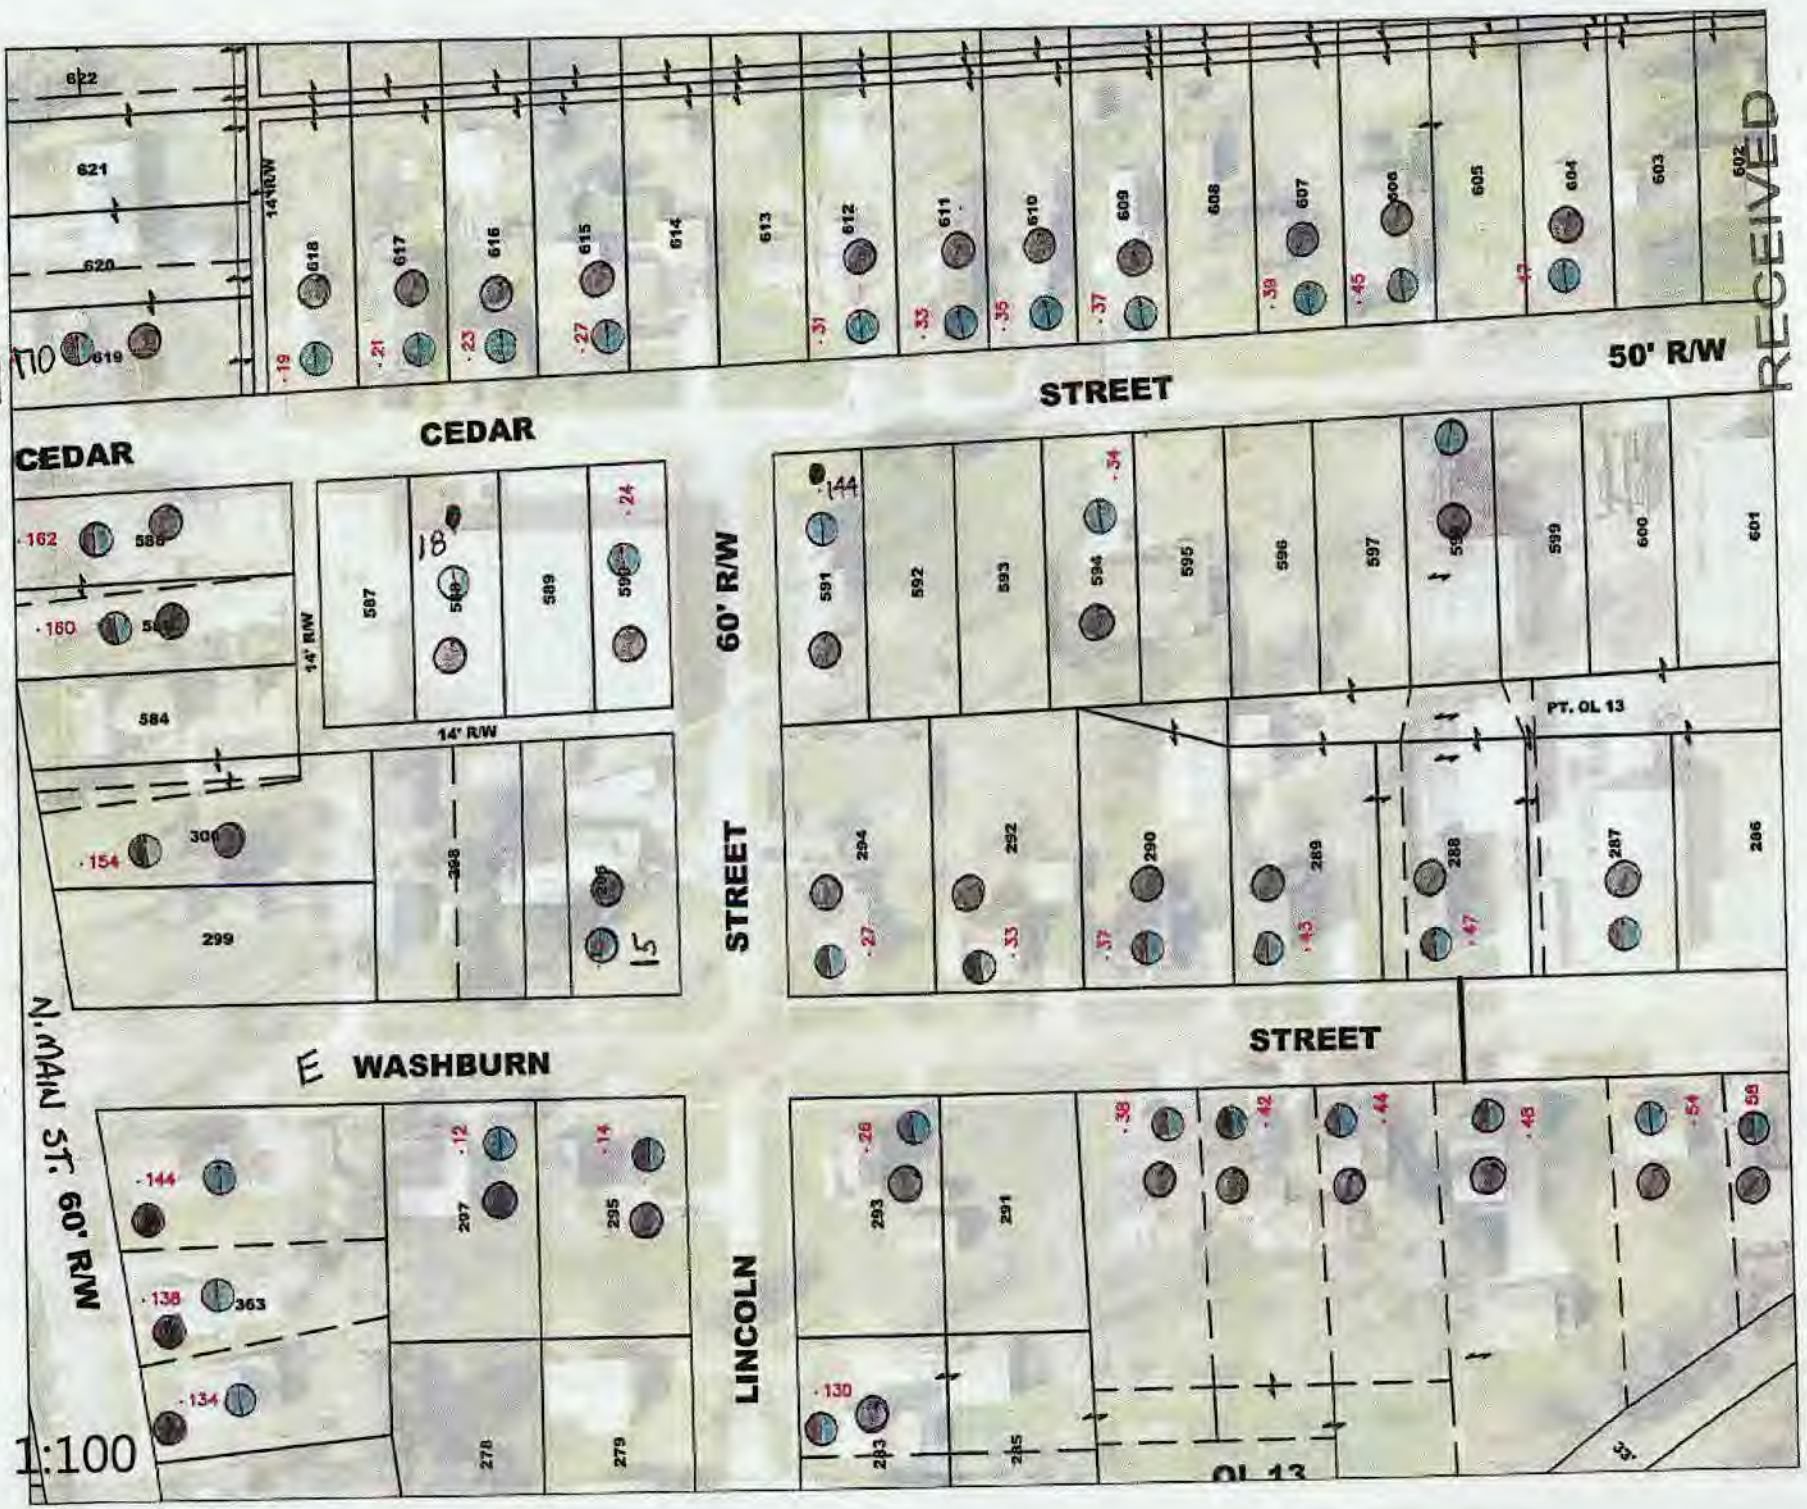

RECEIVED

MAR 08 2017
DDAGW - NWDO



STREET RECEIVED

LEDGETT

MAR 08 2017

DDAGW - NWDO



1:100

80' R/W

60' R/W E. WASHBORN ST.

OL 28

1 HARMONY PLACE

50' R/W WALNUT STREET

PT. OL 28


419

418

479

416

417

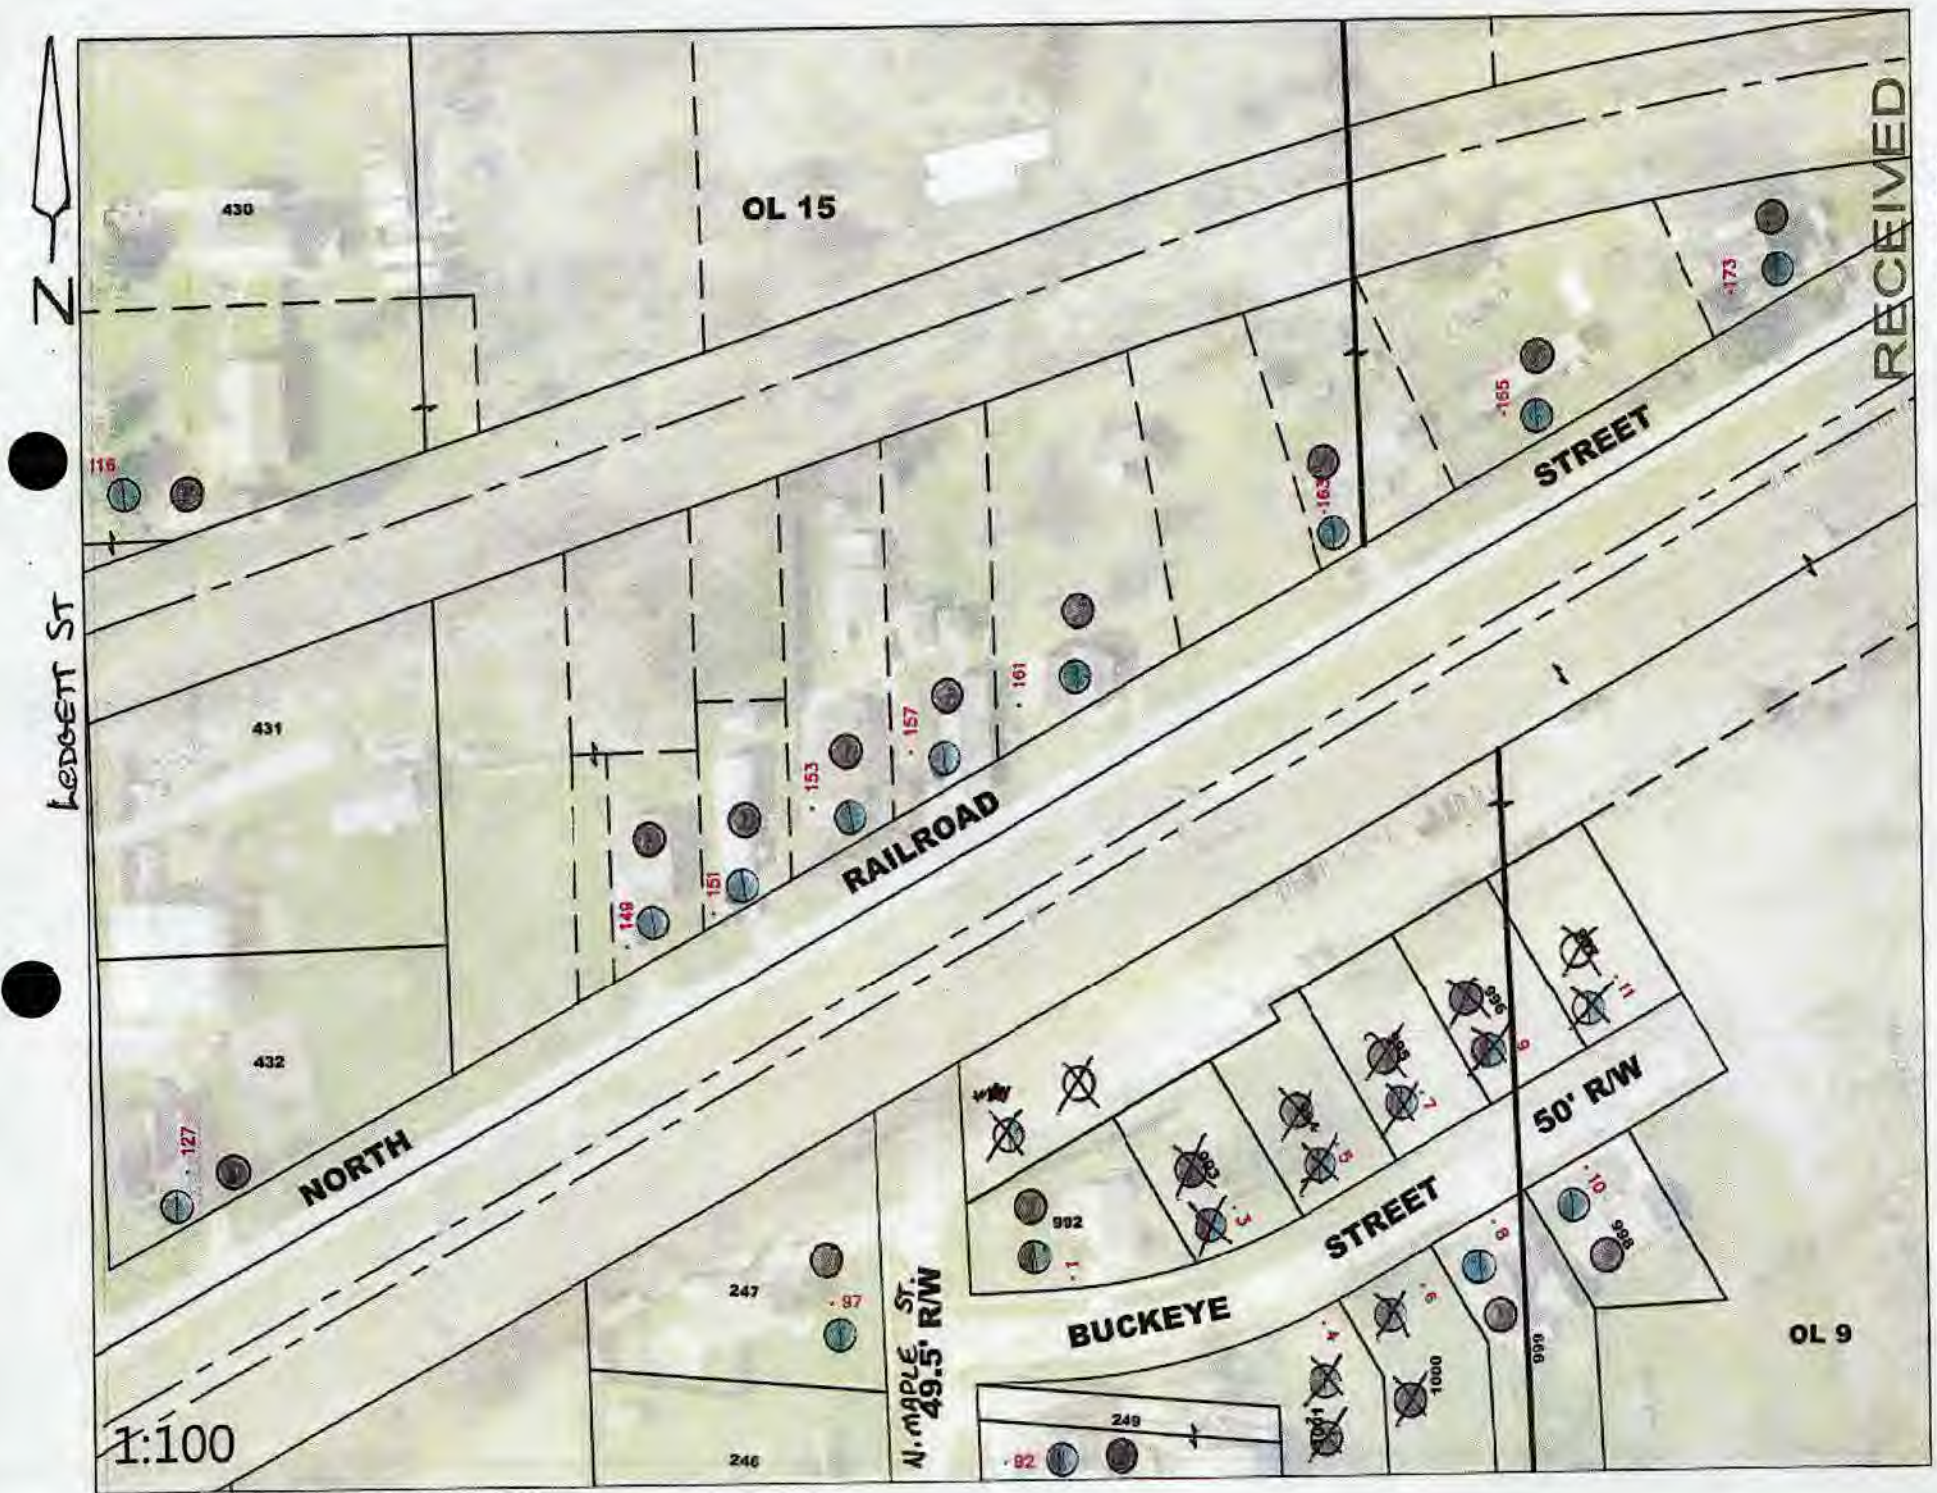

MAR 08 2017

DDAGW - NWDO

RECEIVED



1:100



4764

ST. RT. 162



86



RECEIVED

MAR 08 2017


INDUSTRIAL DR.

DDAGW - NWDO



MAR 08 2017

DDAGW - NWDO

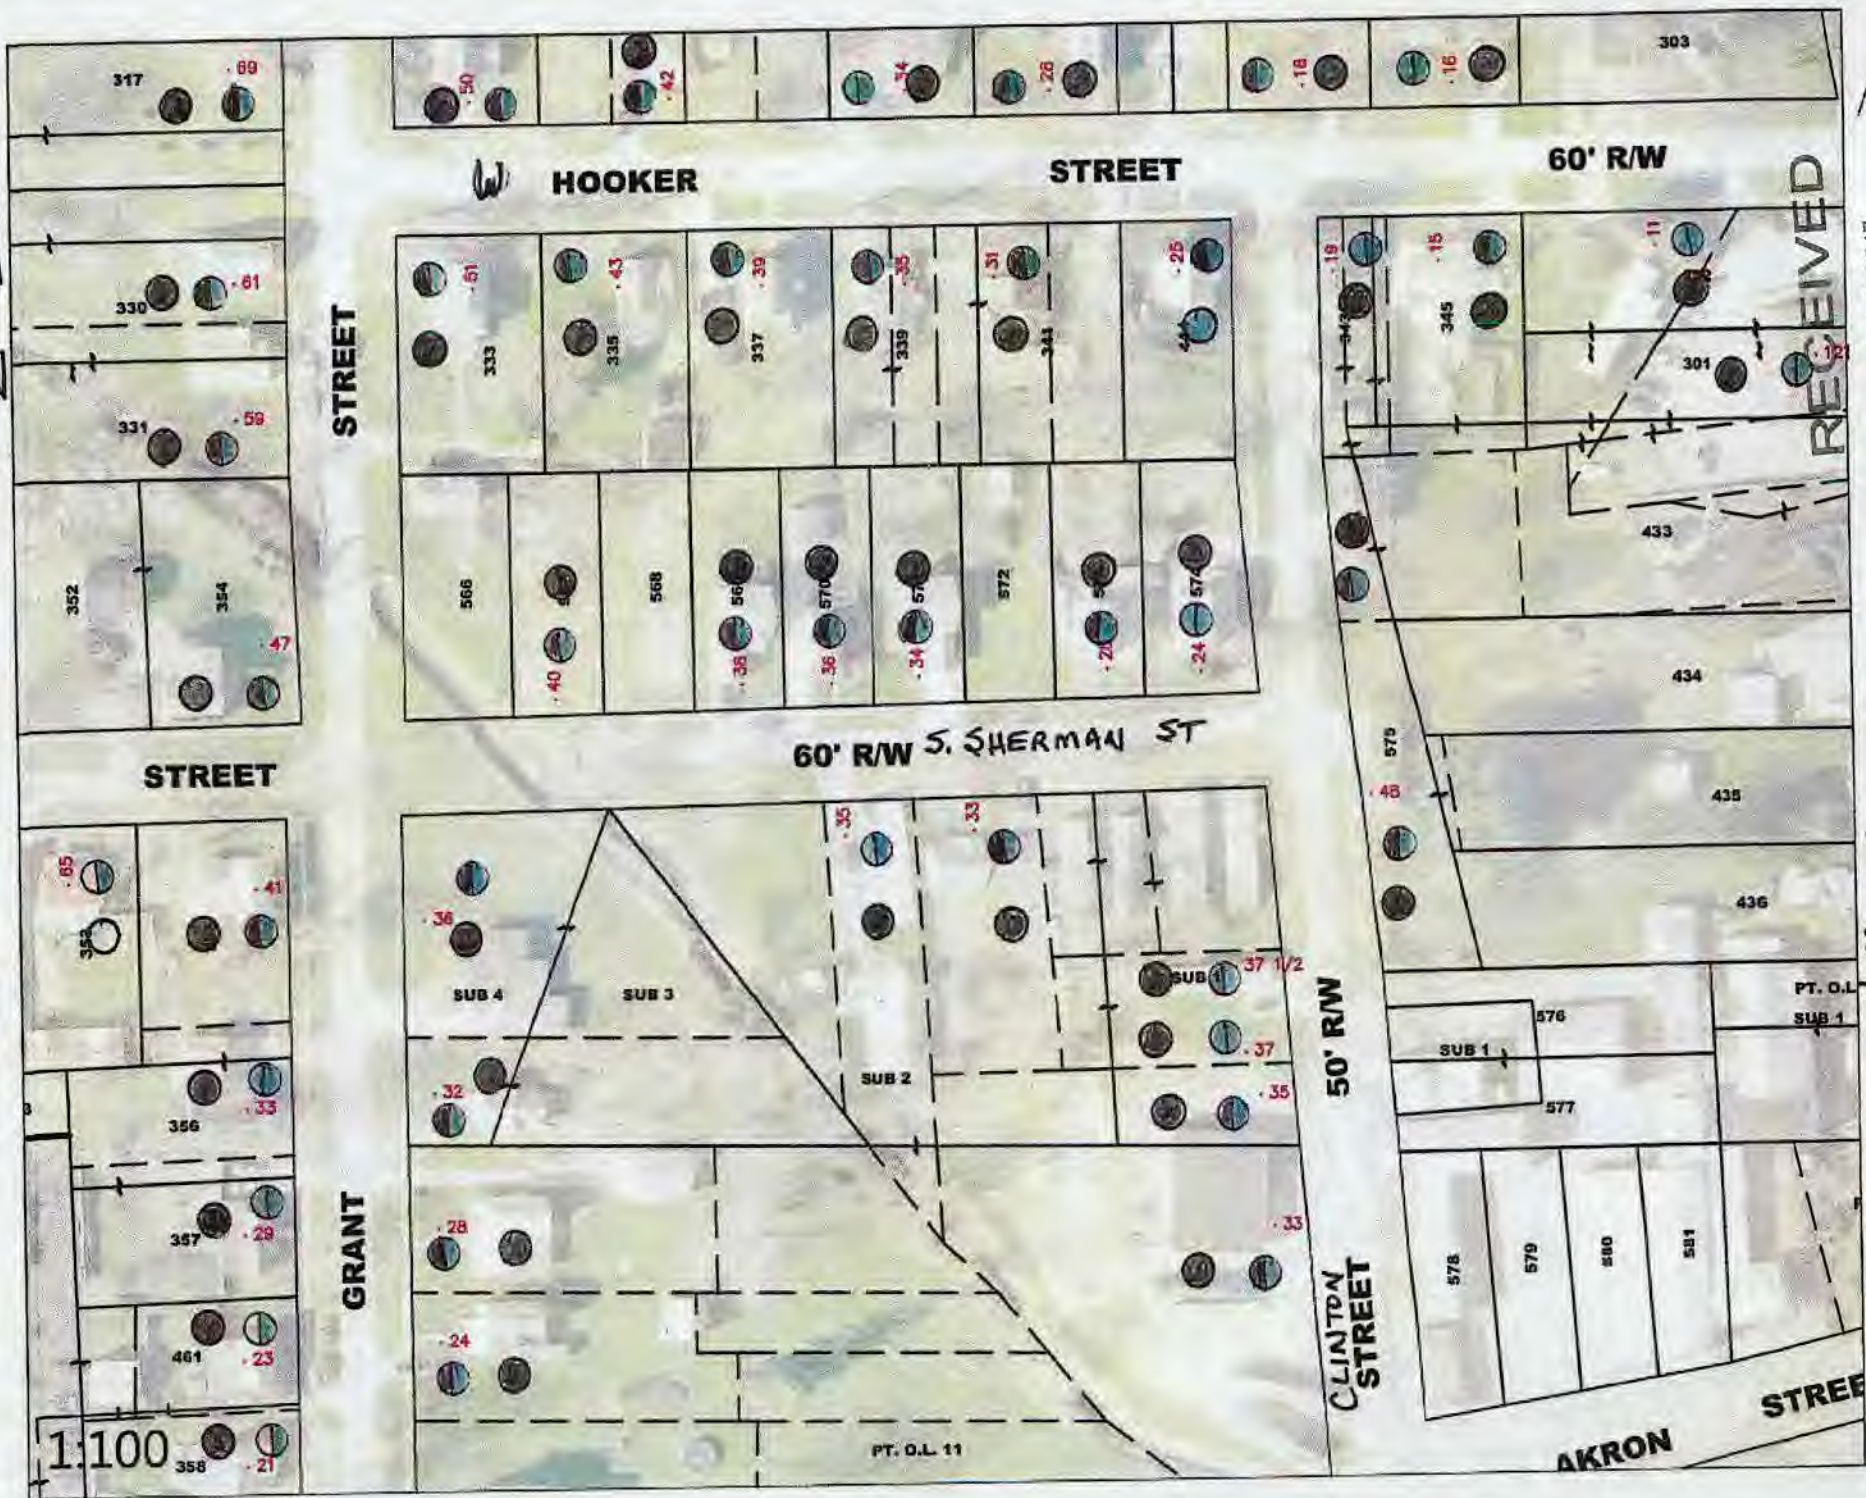

N1

MAR 08 2017

DDAGW - NWDO

N. MAIN ST.




RECEIVED
MAR 08 2017
DDAGW - NWDO



RECEIVED

MAR 08 2017

DDAGW - NWDO

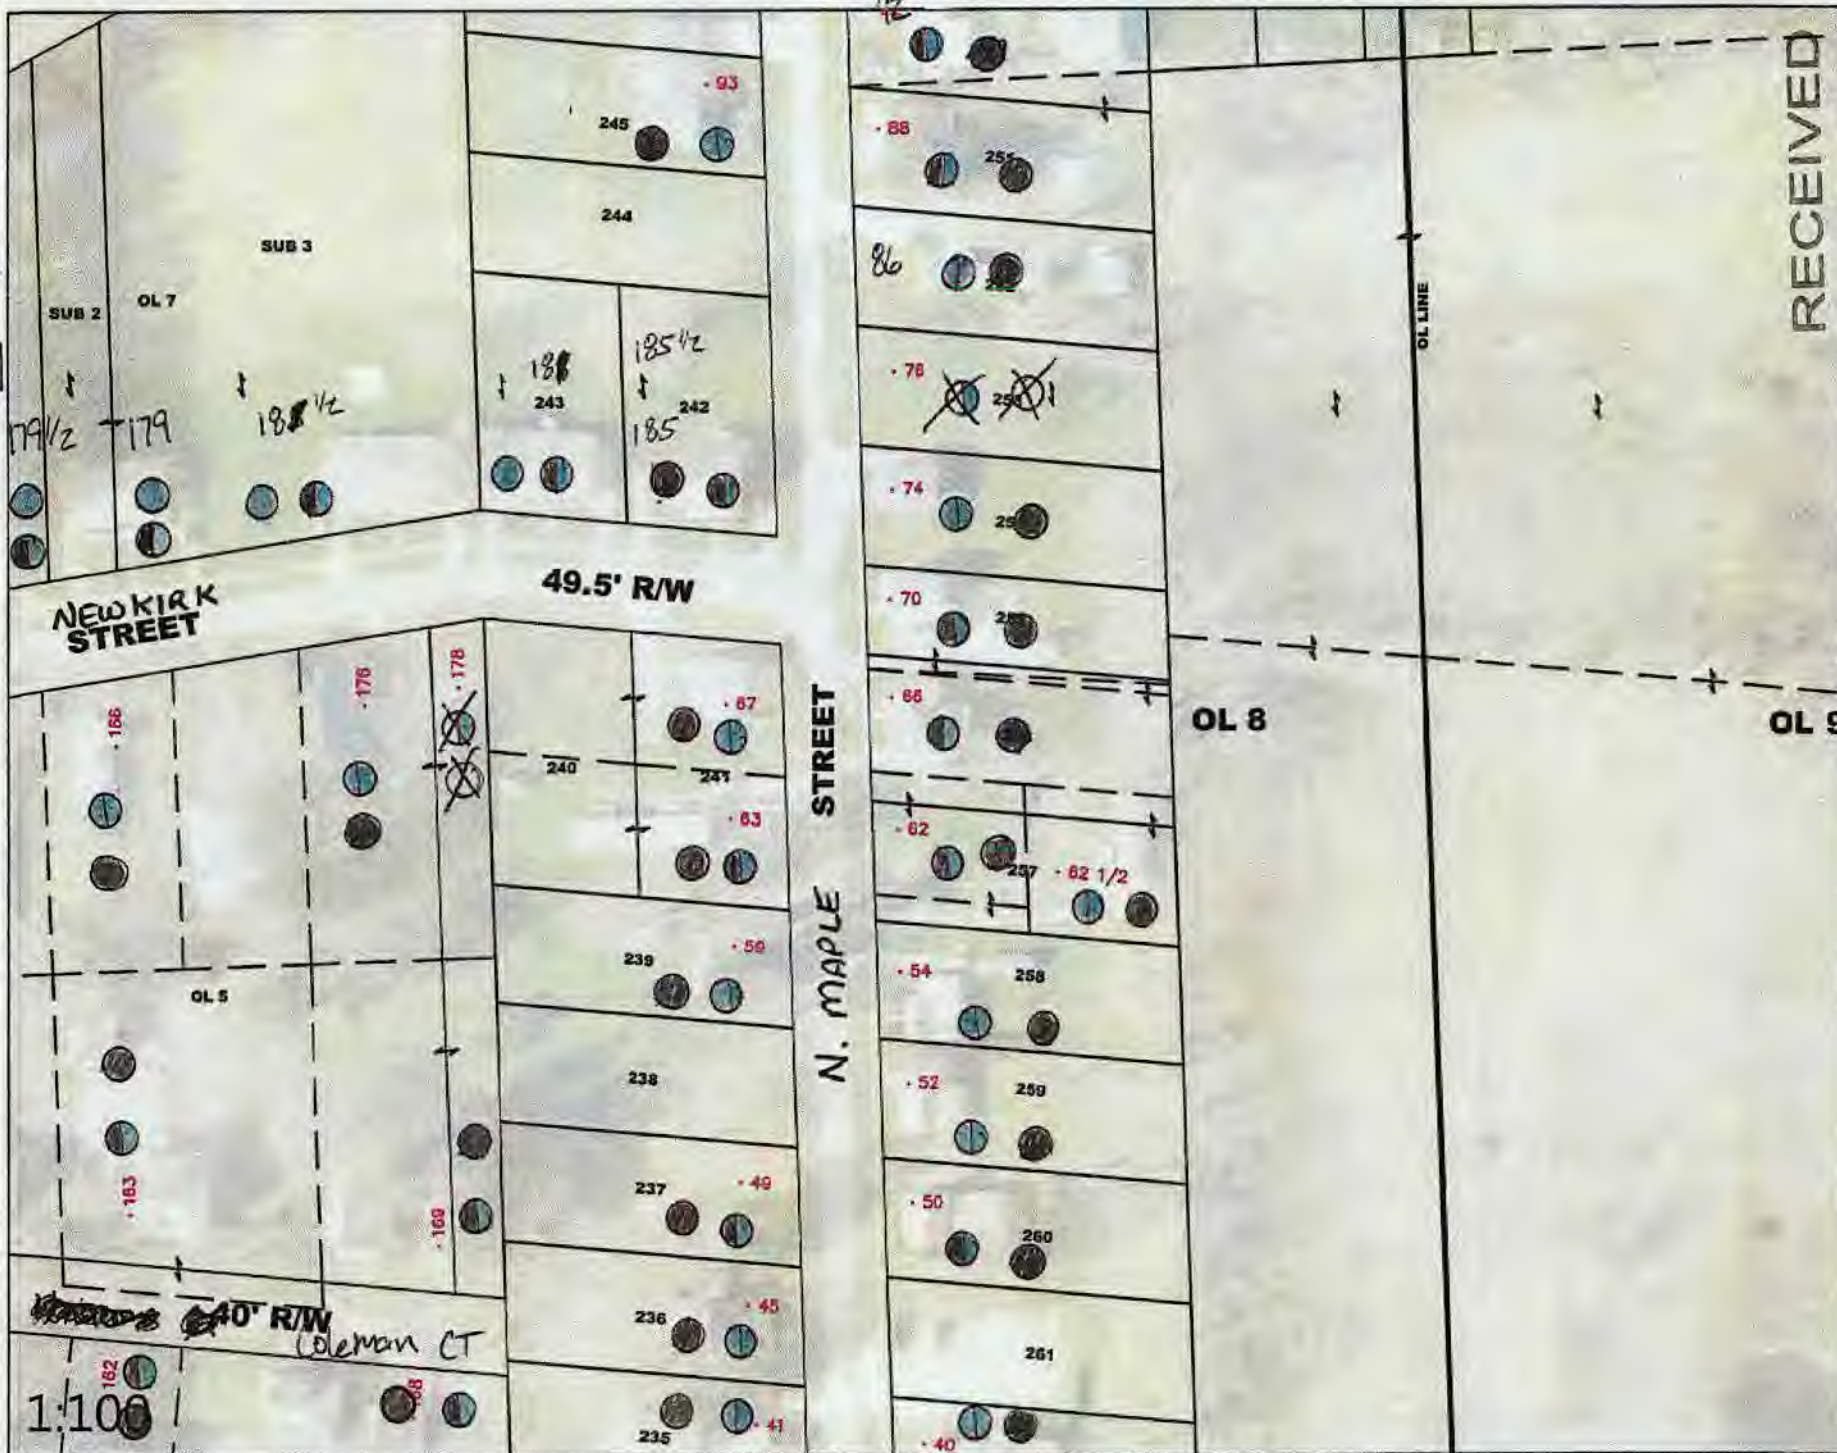

RECEIVED

MAR 08 2017

DDAGW - NWDO



NA

• 4757

• 4785

• 478

• 4813

• 4839

STATE ROUTE 162 STATE


RECEIVED

MAR 08 2017

DDAGW - NWDO

1:100

Z

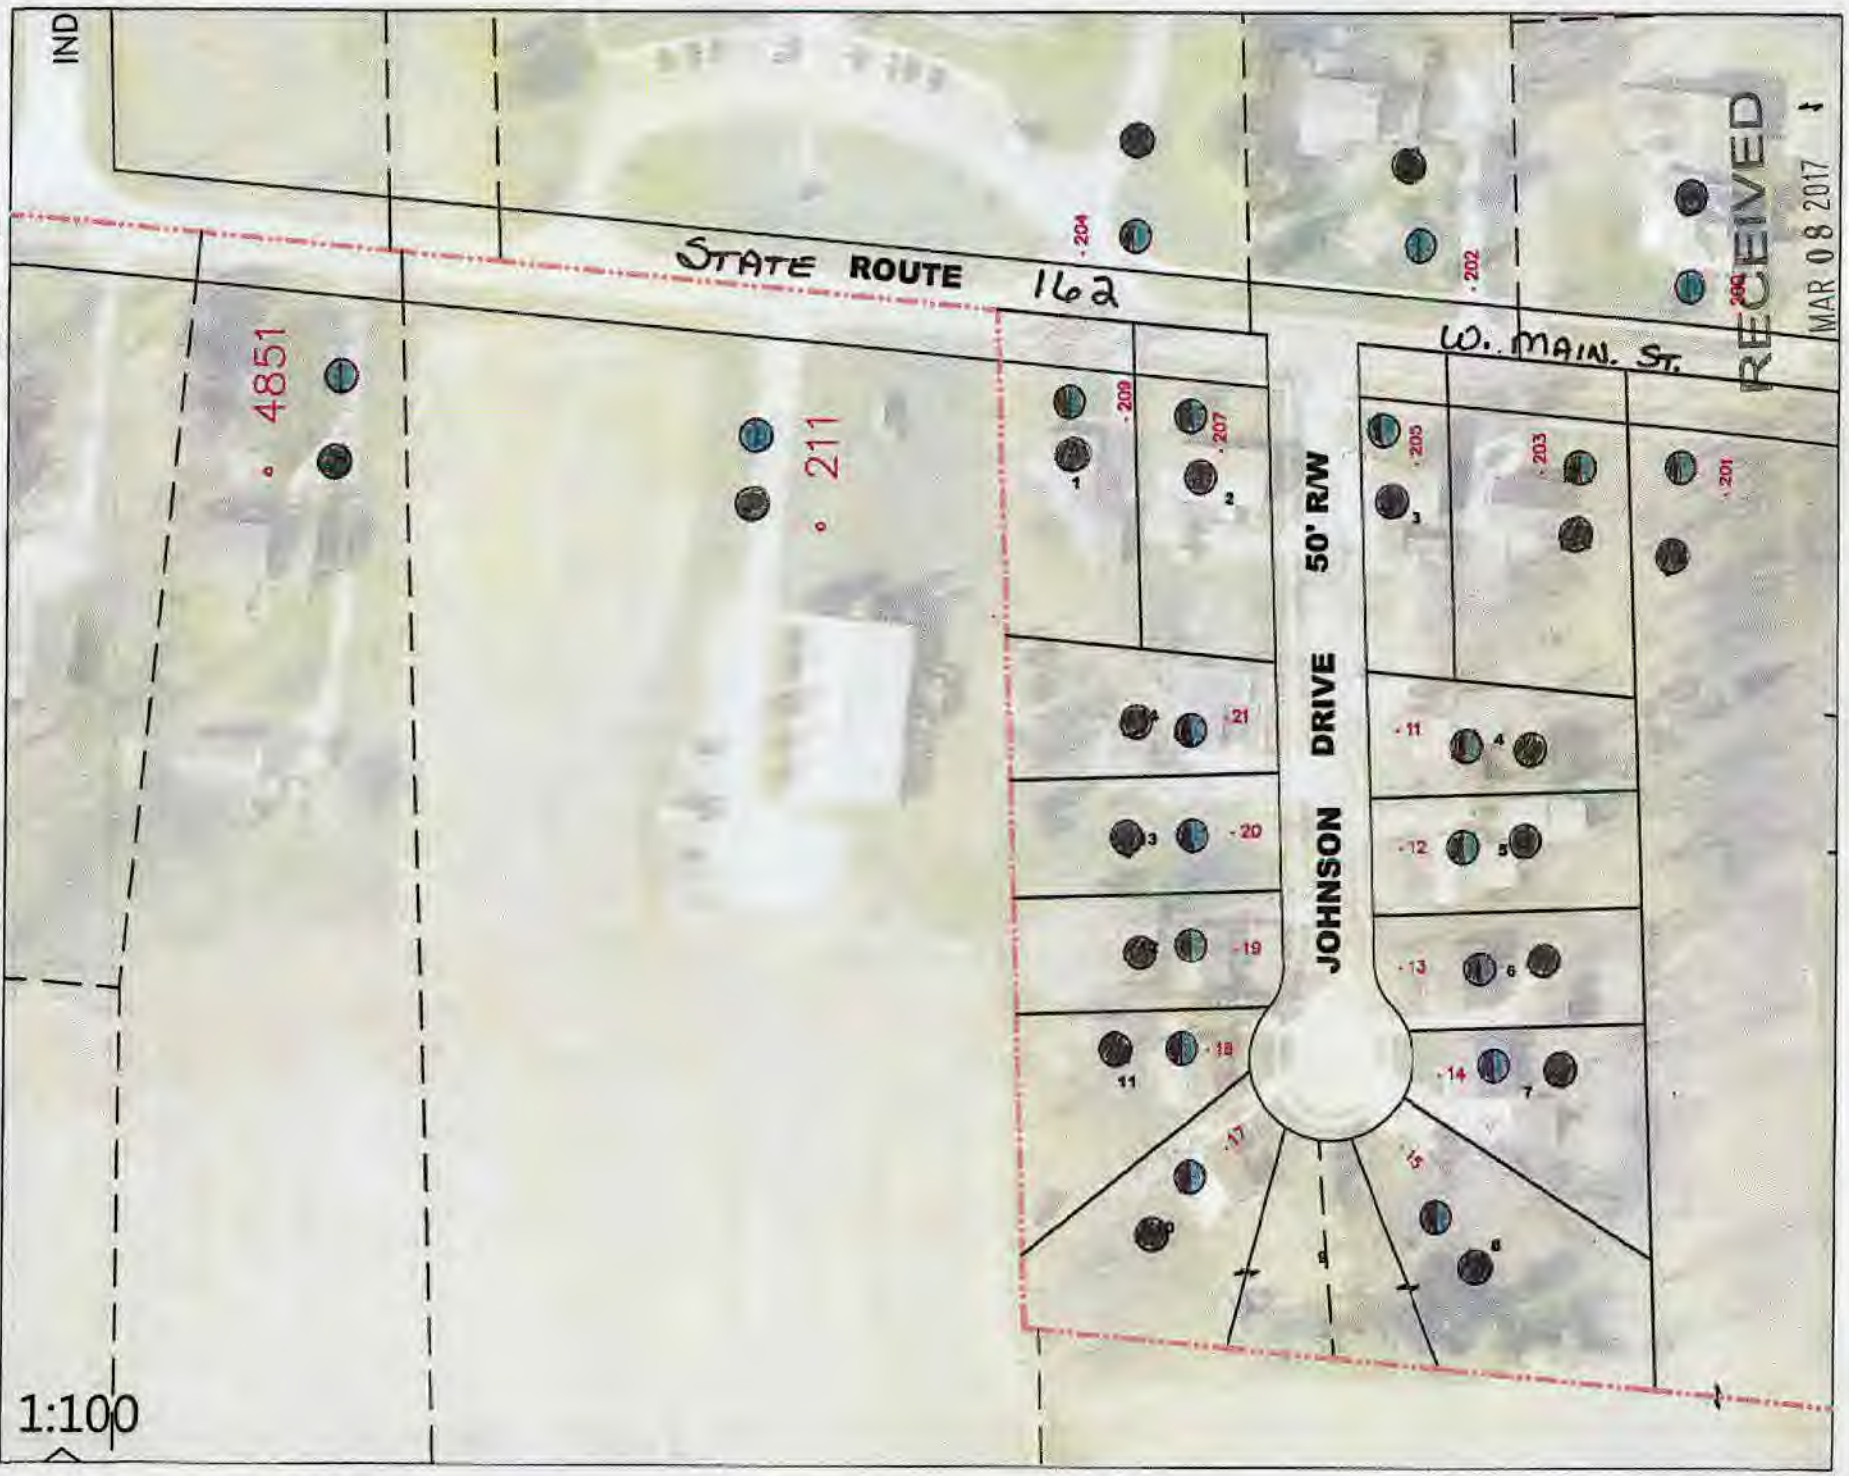

DDAGW - NWDO



DDAGW - NWDO



RECEIVED

MAR 08 2017

DDAGW - NWDO



RECEIVED 4

MAR 08 2017

DDAGW - NWDO

JAMES ST.





RECEIVED
MAR 08 2017
DDAGW - NWDO




1:100



RECEIVED


MAR 08 2017


DDAGW - NWDO

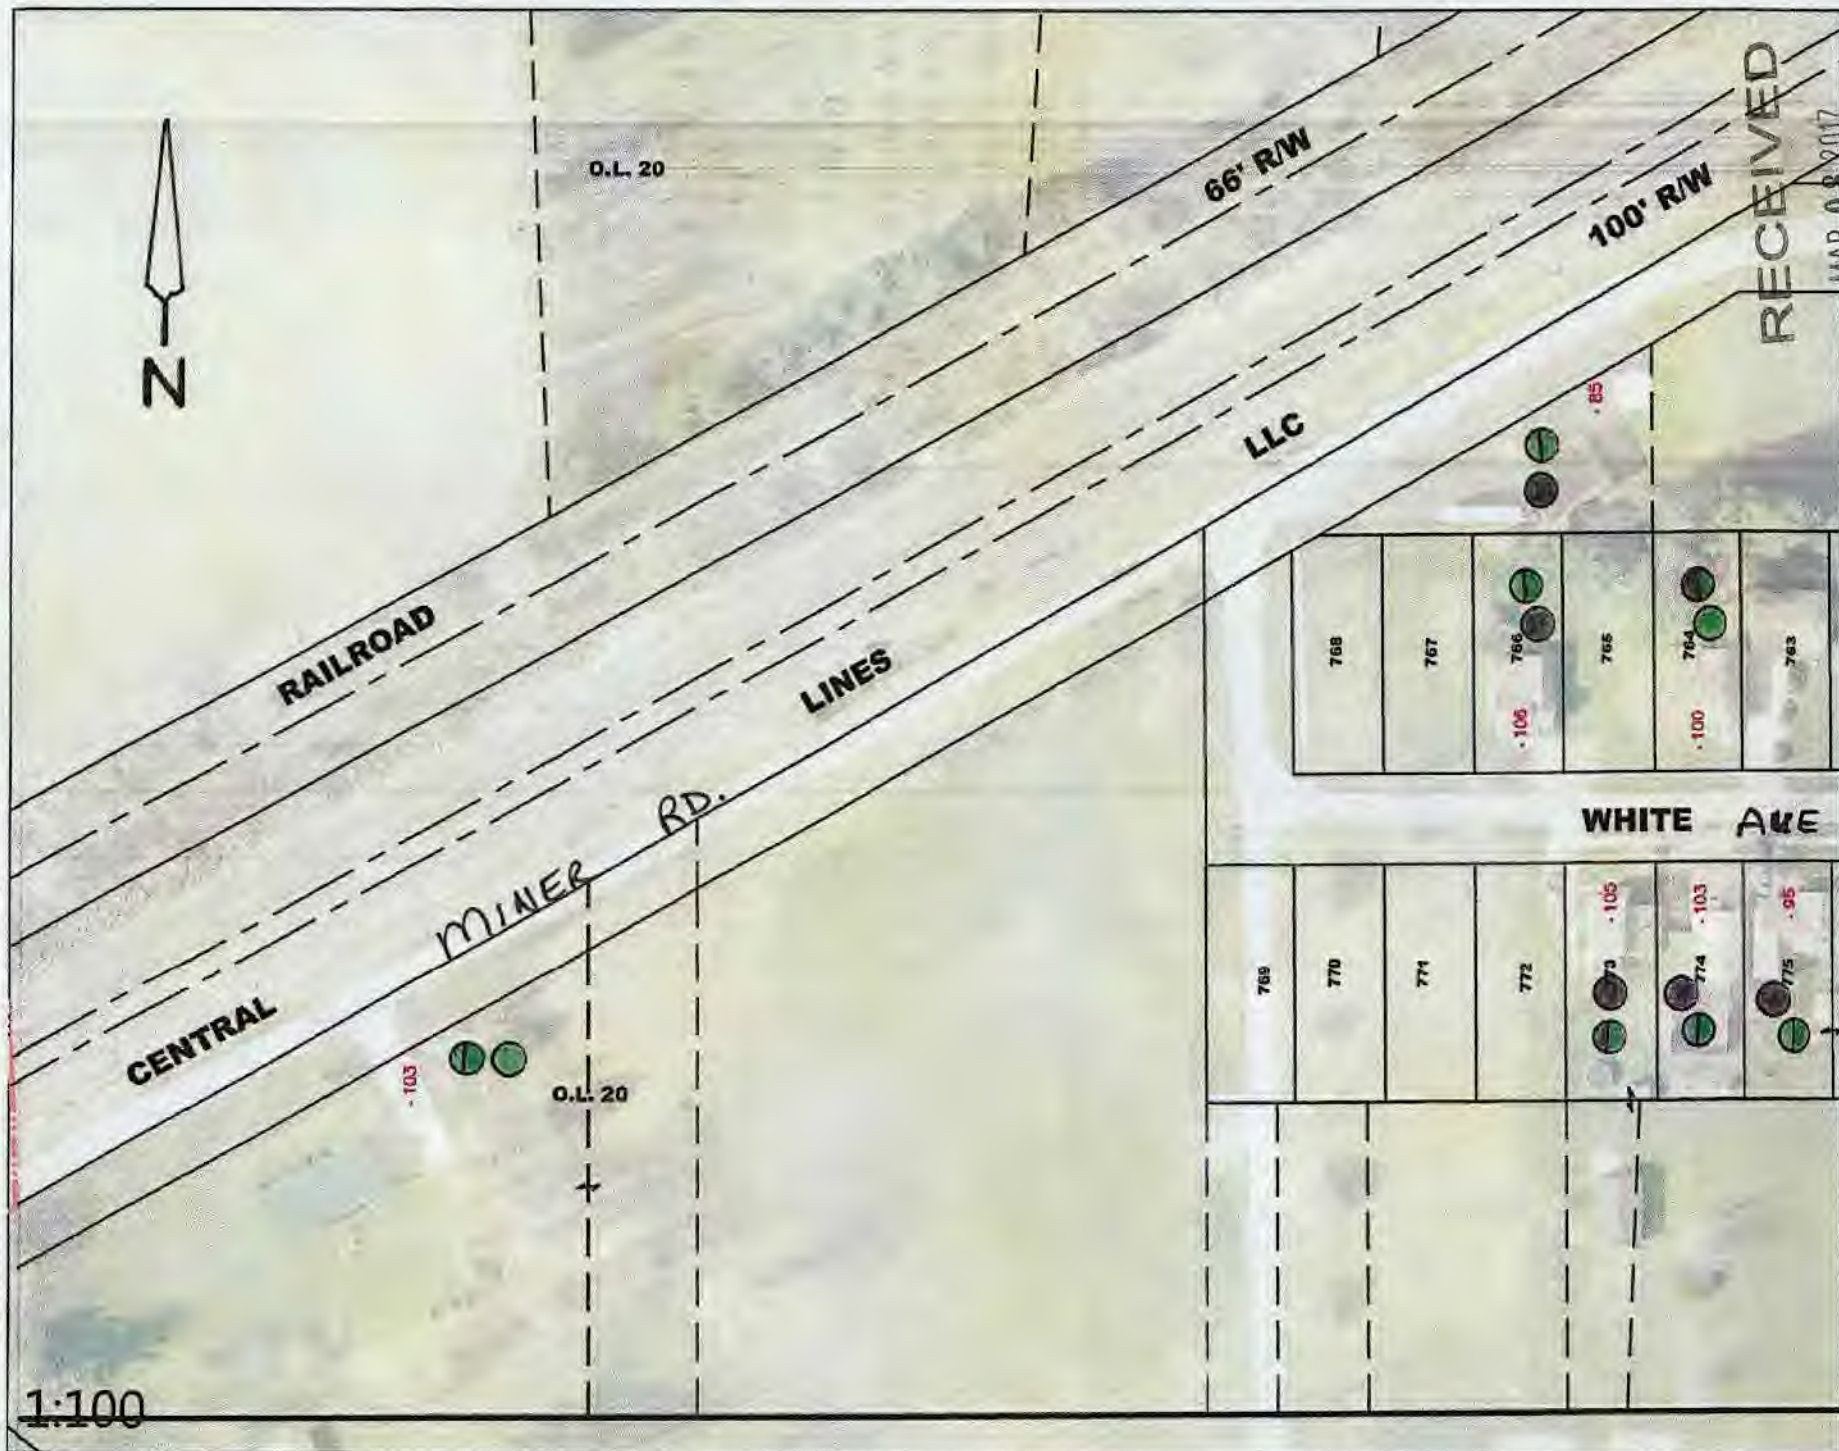



DDAGW - NWDO


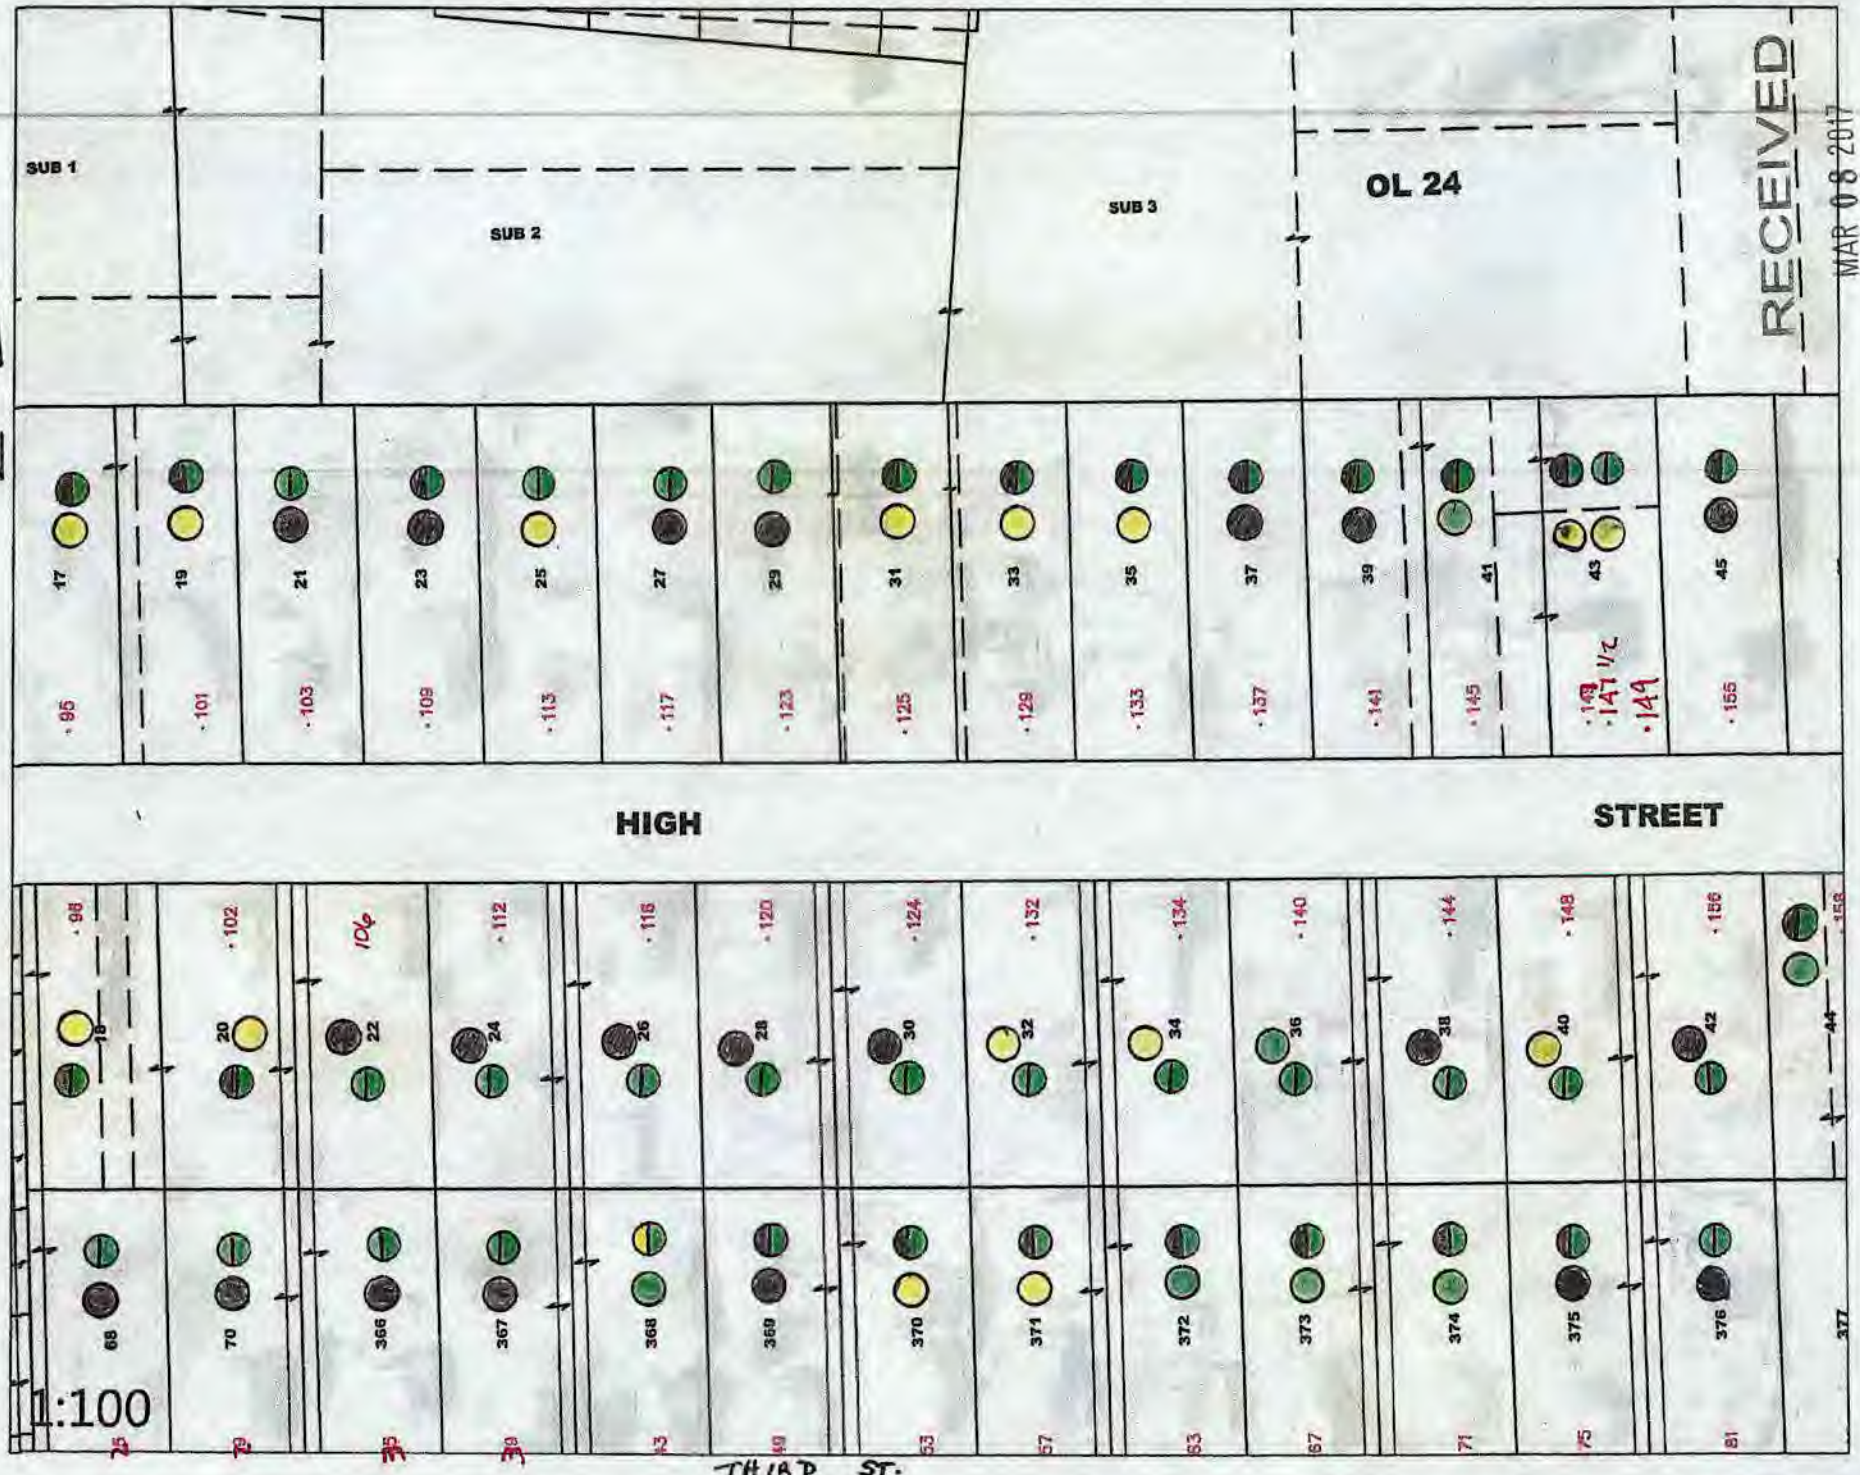


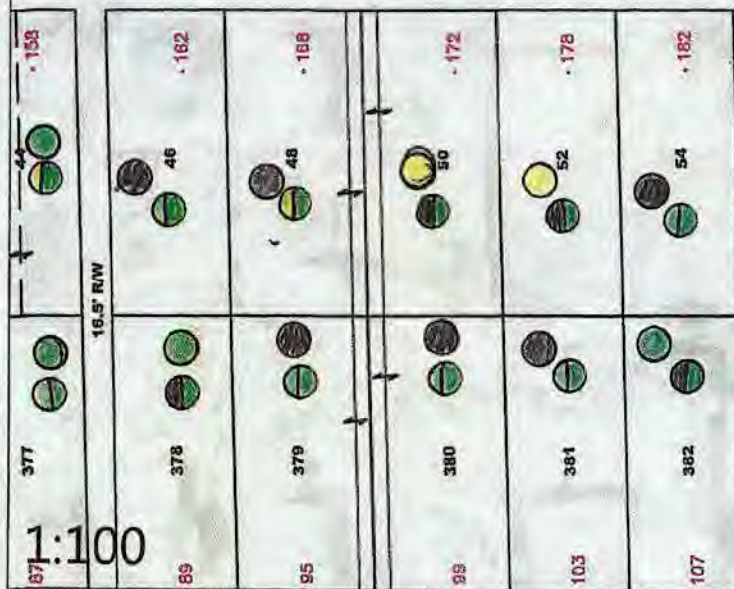


THIRD ST.

HIGH ST.

66' R/W

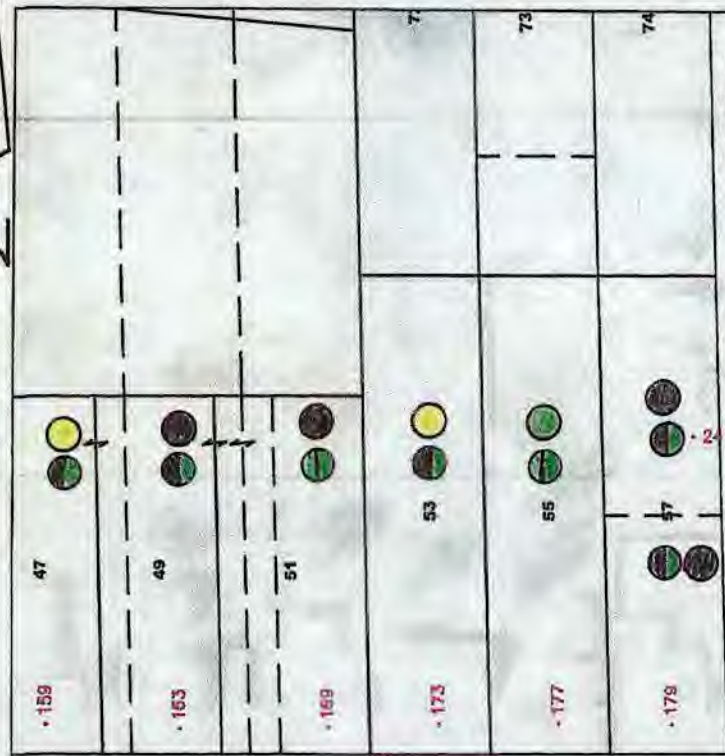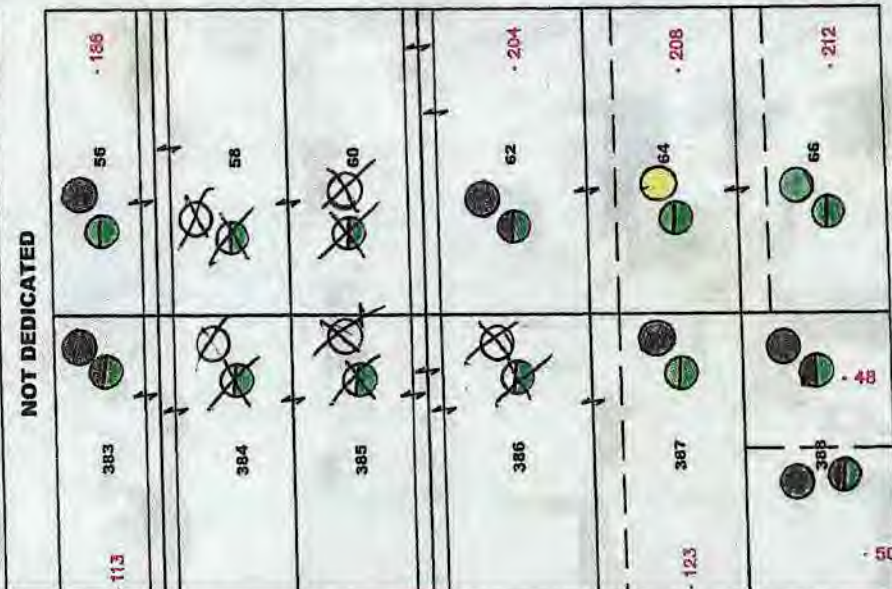

S. MAPLE STREET

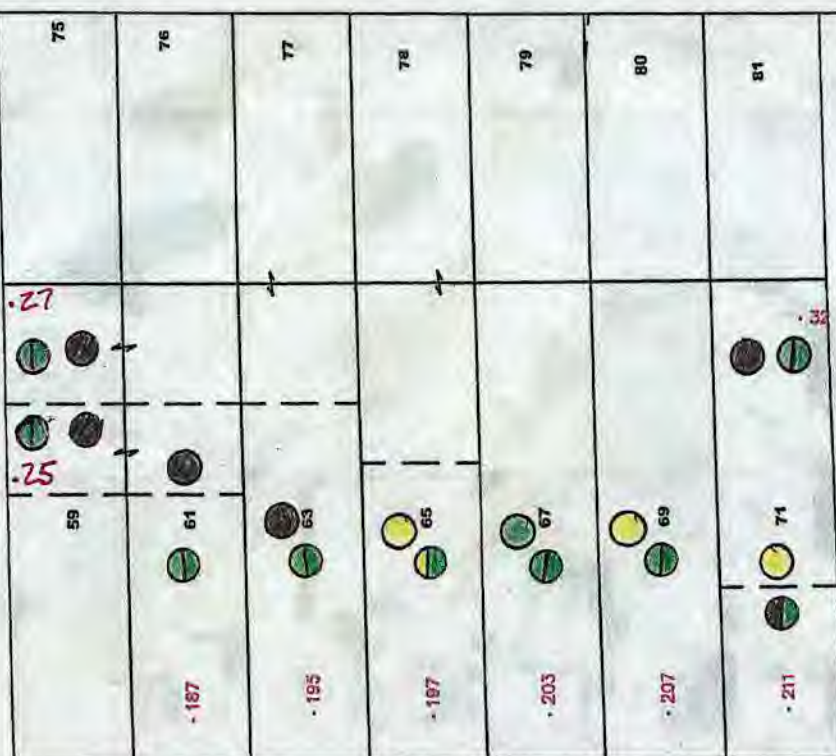

EAST STREET 49.5' R



RECEIVED

MAR 08 2017

DDAGW - NWDO

N



RECEIVED

MAR 08 2014

DDAGW - NWDO




3-6-17



VILLAGE OF

NEW LONDON

Inc OHIO 1854

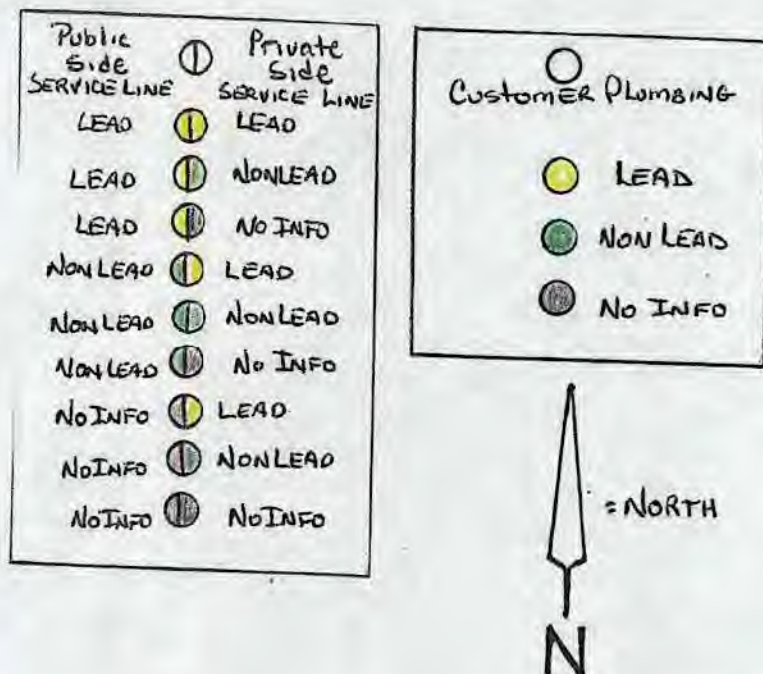

RECEIVED

MAR 08 2017

DDAGW - NWDO


RECEIVED

MAR 08 2017

THIRD

STREET

DDAGW - NWDO

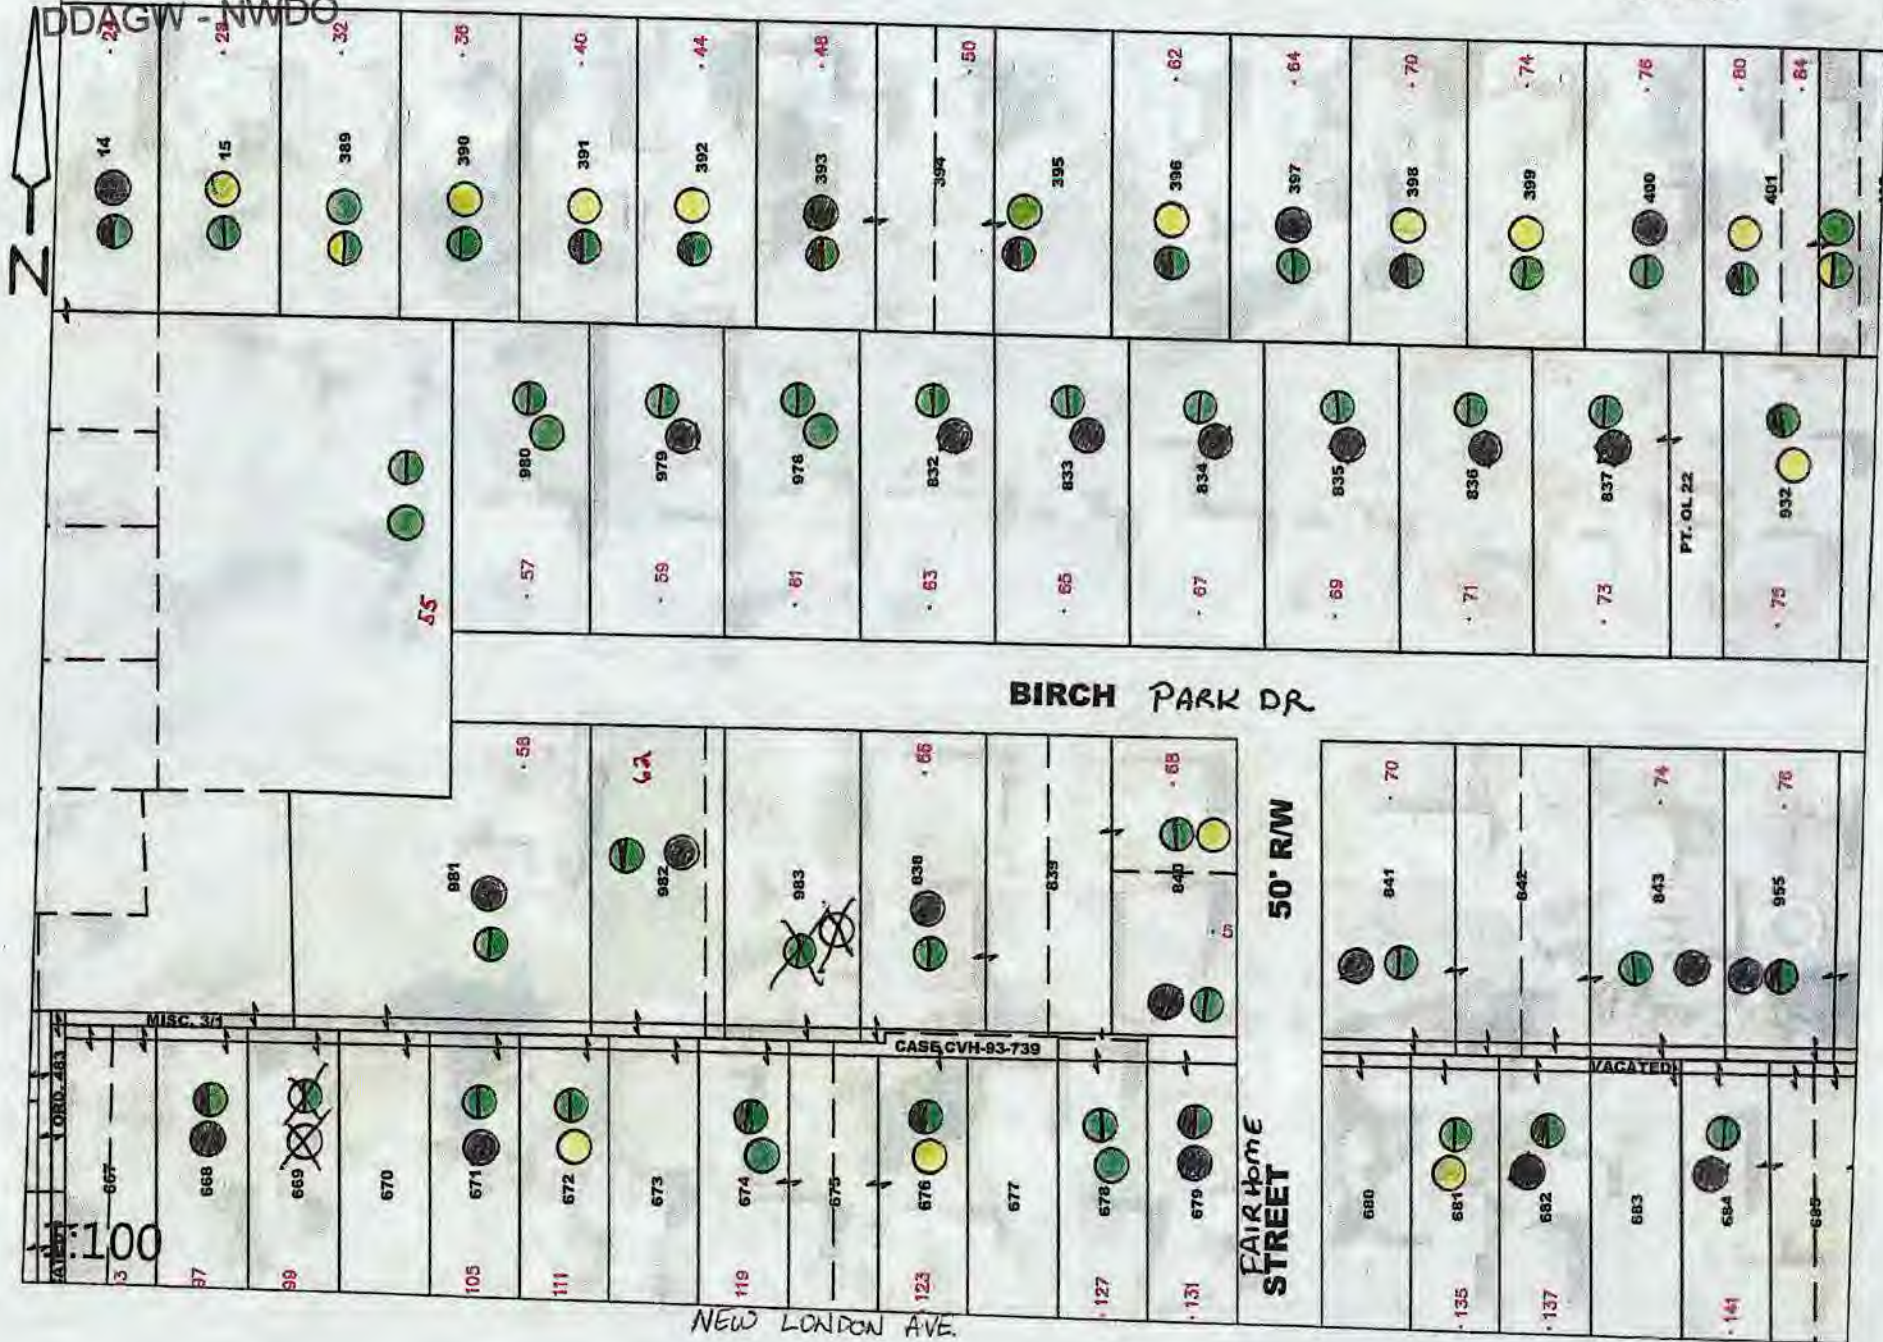

RECEIVED

MAR 08 2017

N

DAGW - NWDO

THIRD ST.

66' R/W

STREET

EAST


50' R/W

BIRCH PARK

DRIVE

1:100

NEW LONDON AVE.

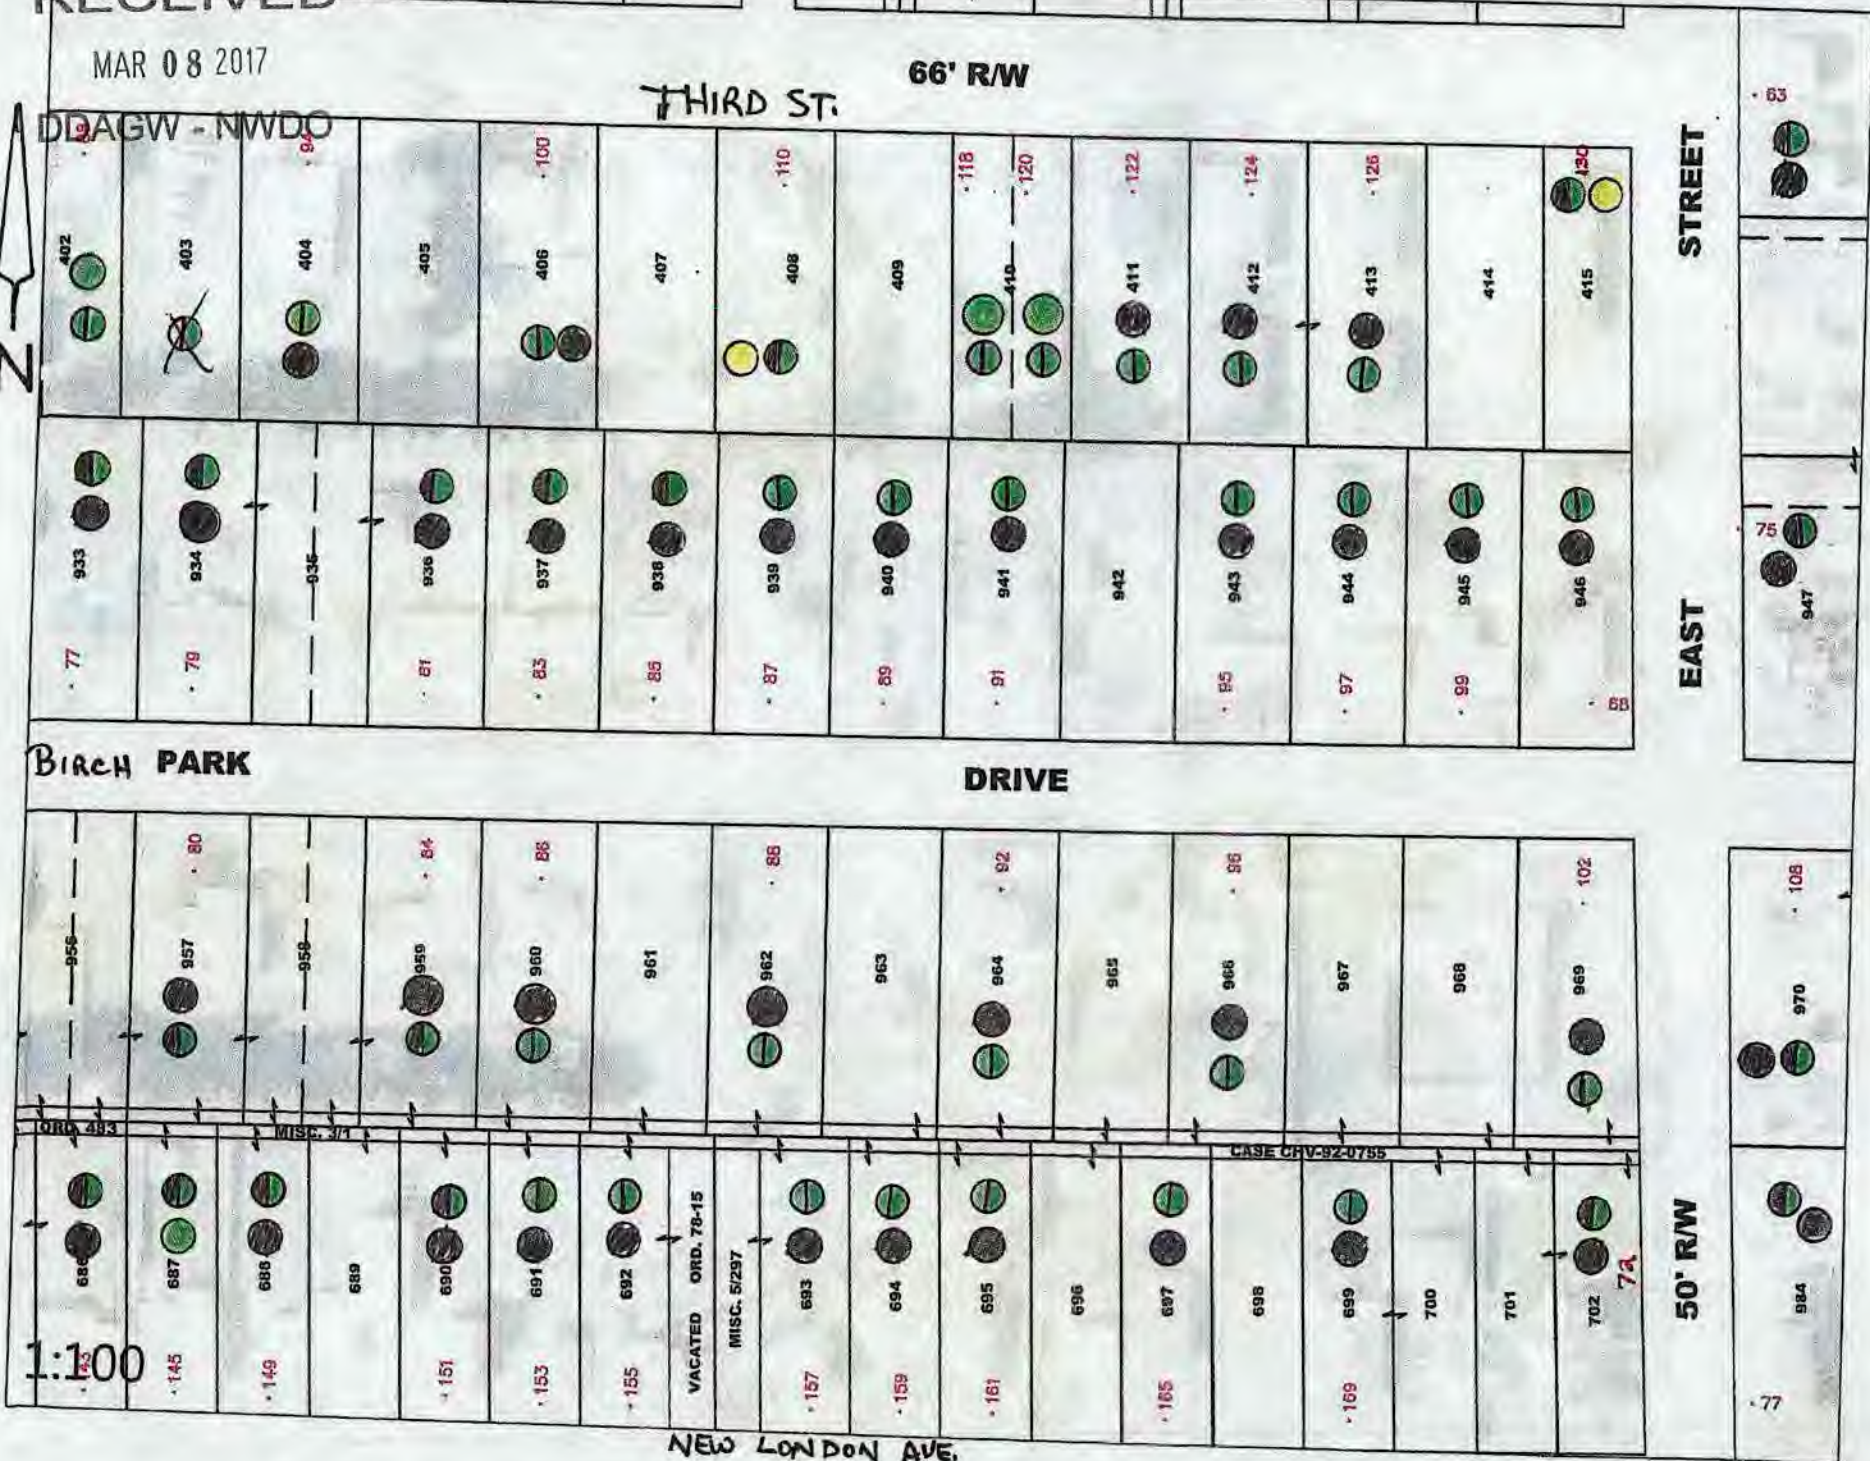

RECEIVED

MAR 08 2017

DDAGW - NWDO





RECEIVED
MAR 08 2017
DDAGW - NWDO

1:100

-120

-128

-130

-132

-134

-138

-148

-170

NEW LONDON AVE.

664

-125

663

662

PARK AVE.

147

149

-167



NEW


LONDON AVE.

FAIRHOME

RECEIVED
MAR 08 2017
DDAGW - NWDO

1:100

MISC 5/29/7

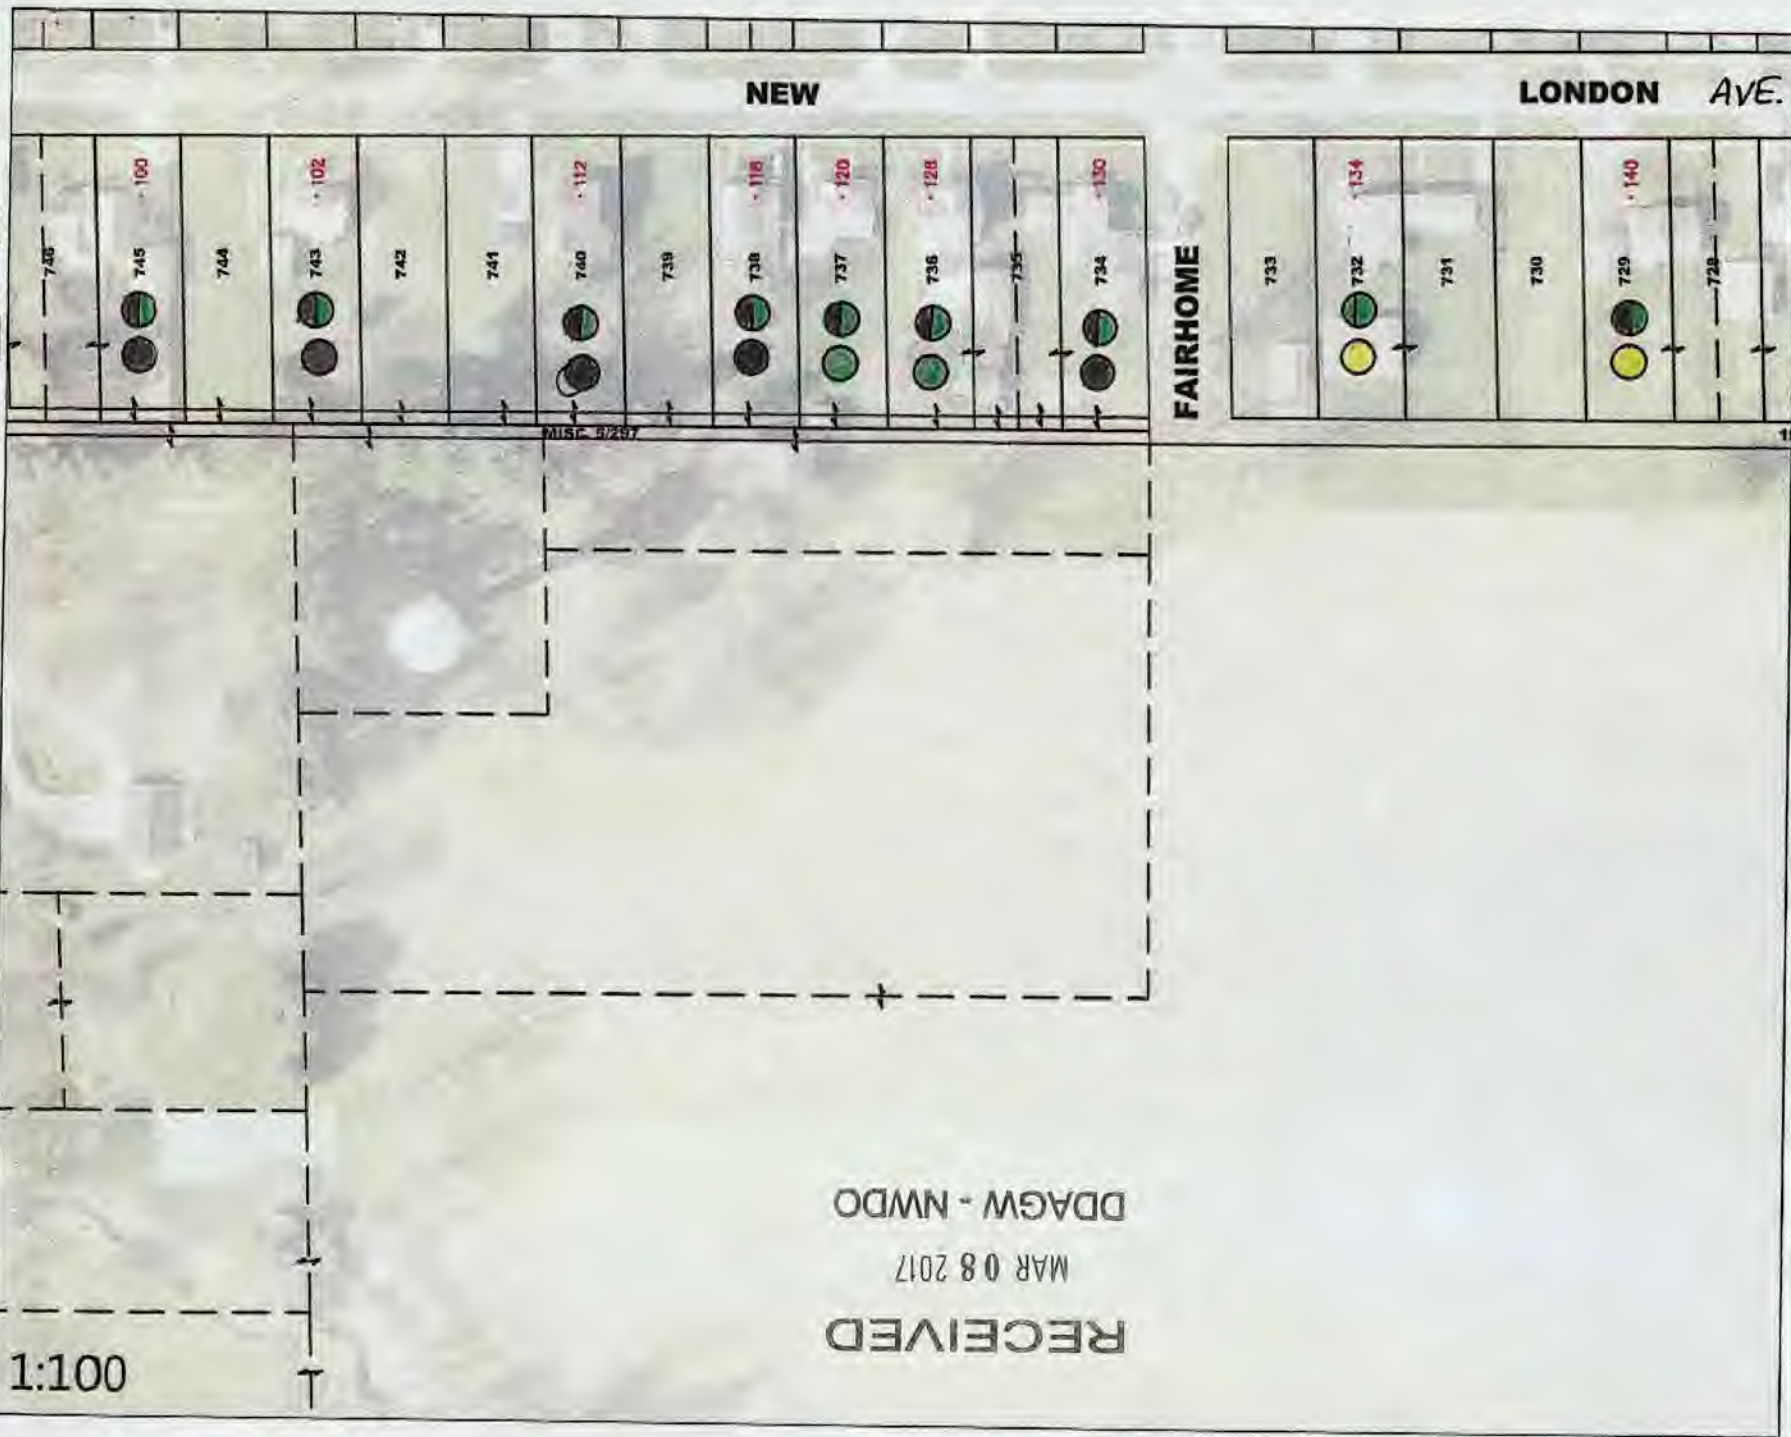

100

745

744

102

743

742

741

112

740

739

118

738

120

737

128

736

735

130

734

733

134

732

731

730

140

729

728



NEW LONDON AVENUE

50' R/W

727 • 144	728 • 148	725	724 • 150	723	722 • 154	721
--------------	--------------	-----	--------------	-----	--------------	-----

15' R/W

720 • 150	719 • 162	718 • 165	717 • 168	716	715 • 170	714 • 172	713	712	711
--------------	--------------	--------------	--------------	-----	--------------	--------------	-----	-----	-----

988 • 180

OL 22

RECEIVED

MAR 08 2017

DDAGW - NWDO

1:100

EAST STREET

50' R/W



NEW LONDON AVE.

182

989



154

990



100

991



RECEIVED

MAR 08 2017

DDAGW - NWDO

1:100



LLC

2235



2275



Euclid Rd.

RECEIVED
MAR 08 2017
DDAGW - NWDO

1:100

Z-4

T-193

EUCLID RD.

RECEIVED

MAR 08 2017

DDAGW - NWDO

1:100

2275

2240

2-2

RECEIVED
MAR 08 2017
DDAGW - NWDO

1:100

925 -64	926 -62	927 -60
CLYDE		AVENUE



RECEIVED

MAR 08 2017

DDAGW - NWDO



928

58



929

56

930

931



52



185



178



174



175



179



187



193



195



187



189

60

ROUTE

Park Ave

1:100

CLYDE

AVENUE

60' R/W

N

RECEIVED
MAR 08 2017
DDAGW - NWDO

1:100



RECEIVED

MAR 08 2017

DDAGW - NWDO

OL 23

NEW LONDON
HIGH SCHOOL

WILDCAT DR.



1



2



3



4




2



2

1:100

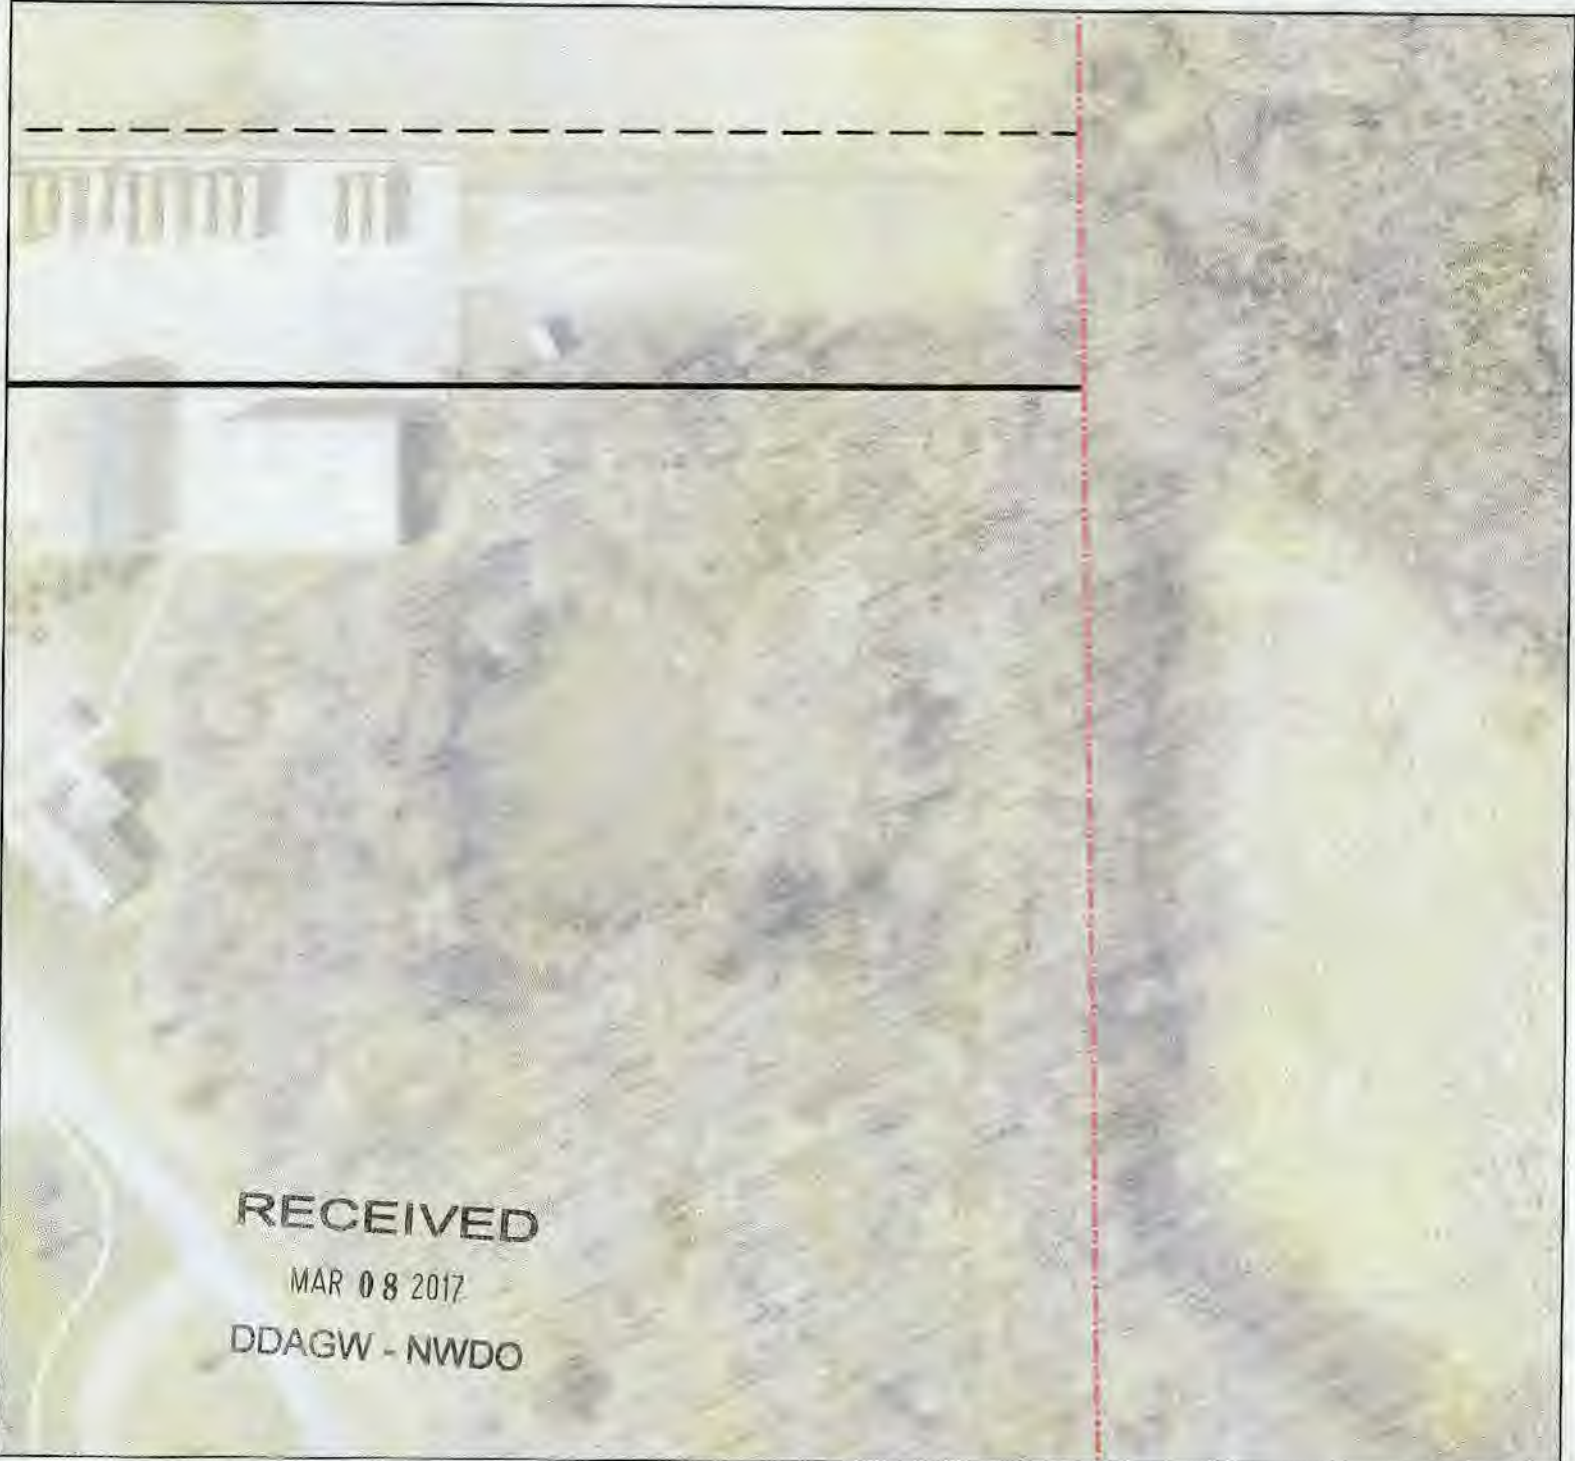

RECEIVED

MAR 08 2017

DDAGW - NWDO

1:100



RECEIVED
MAR 08 2017
DDAGW - NWDO

1:100



2367

EUCLID RD.

N

Euclid Rd

2281

2345

2373

2375


RECEIVED
MAR 08 2017
DDAGW - NWDO

1:100



RECEIVED
MAR 08 2017
DDAGW - NWDO

1:100

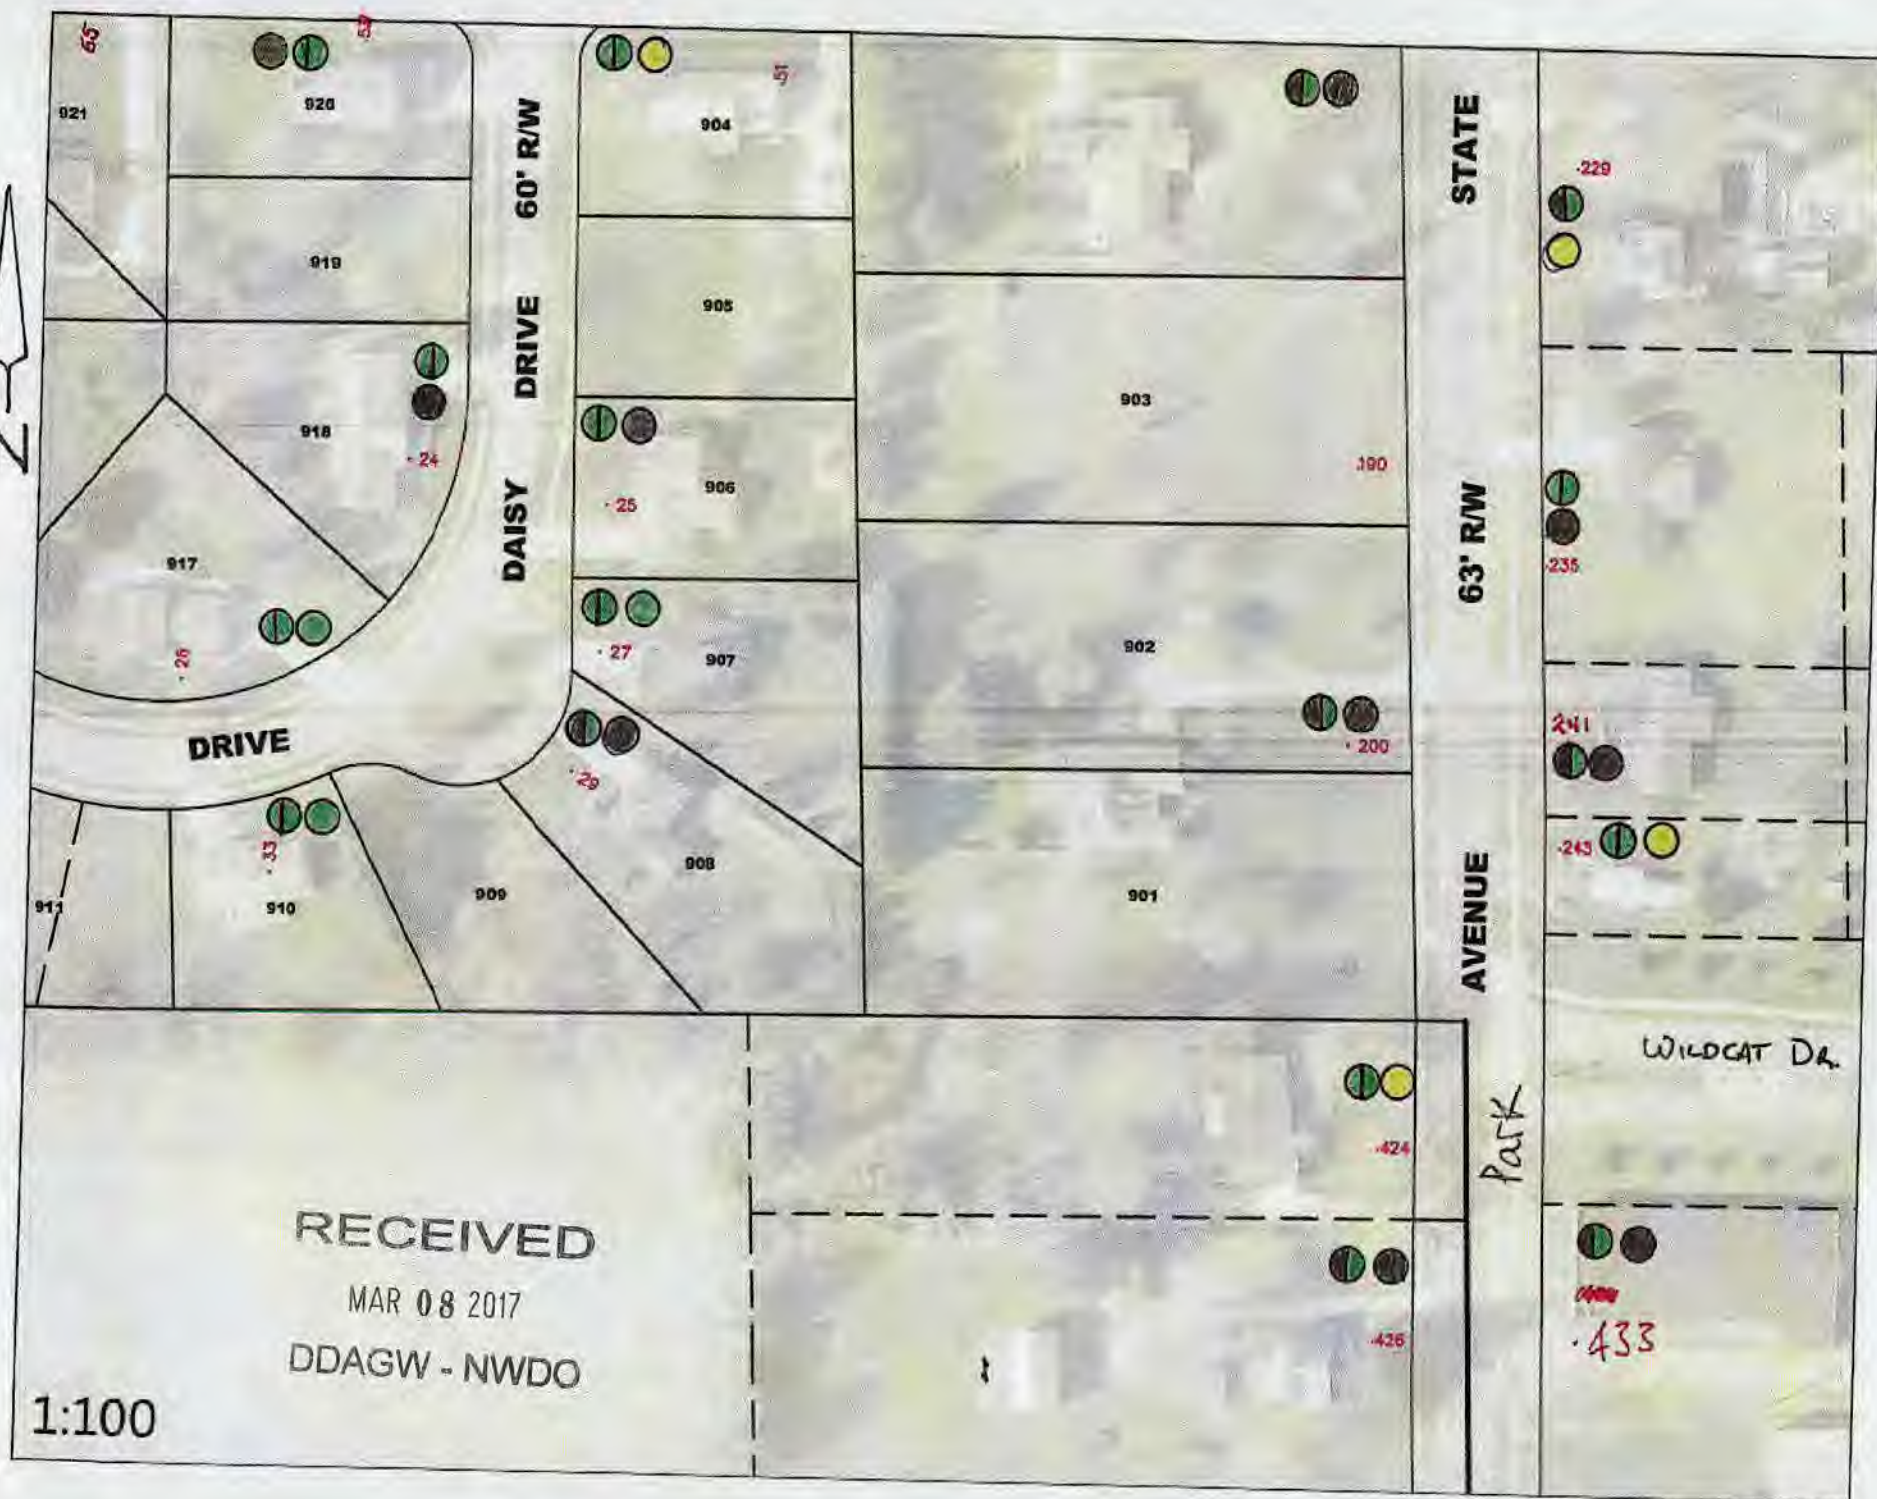



Euclid Rd

• 2414

• 2442

RECEIVED

MAR 08 2017

DDAGW - NWDO

1:100

ROAD

N

PARK AVE.

432

433

2396

440

2447

ST. RT. 60

RECEIVED

MAR 08 2017

DDAGW - NWDO

1:100