

PWS ID # OH 2838112


LEAD AND COPPER SAMPLE SITE MAP



SAINT ANSELM PARISH & SCHOOL

13013 CHILLICOTHE ROAD, CHESTERLAND, OH 44026

PWS #2838112

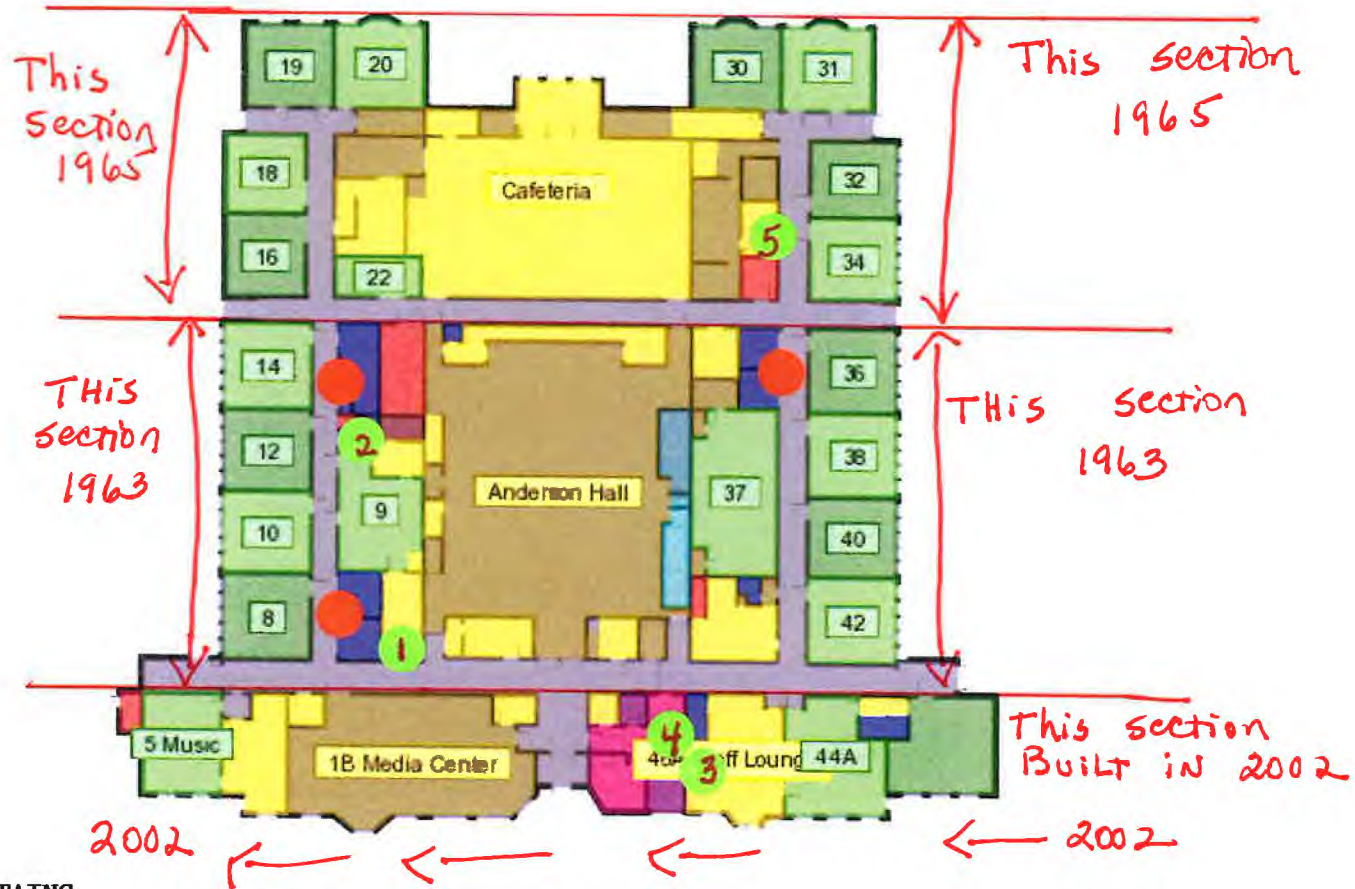

- = DRINKING FOUNTAINS
- = SAMPLE SITES
- 1 = LC201
- 2 = LC 202
- 3 = LC 203
- 4 = LC 204
- 5 = LC 205

TIER 2
 NO LEAD SERVICE LINES