


PSW: HAMETOWN BAPTIST CHURCH
ID: OH7721512

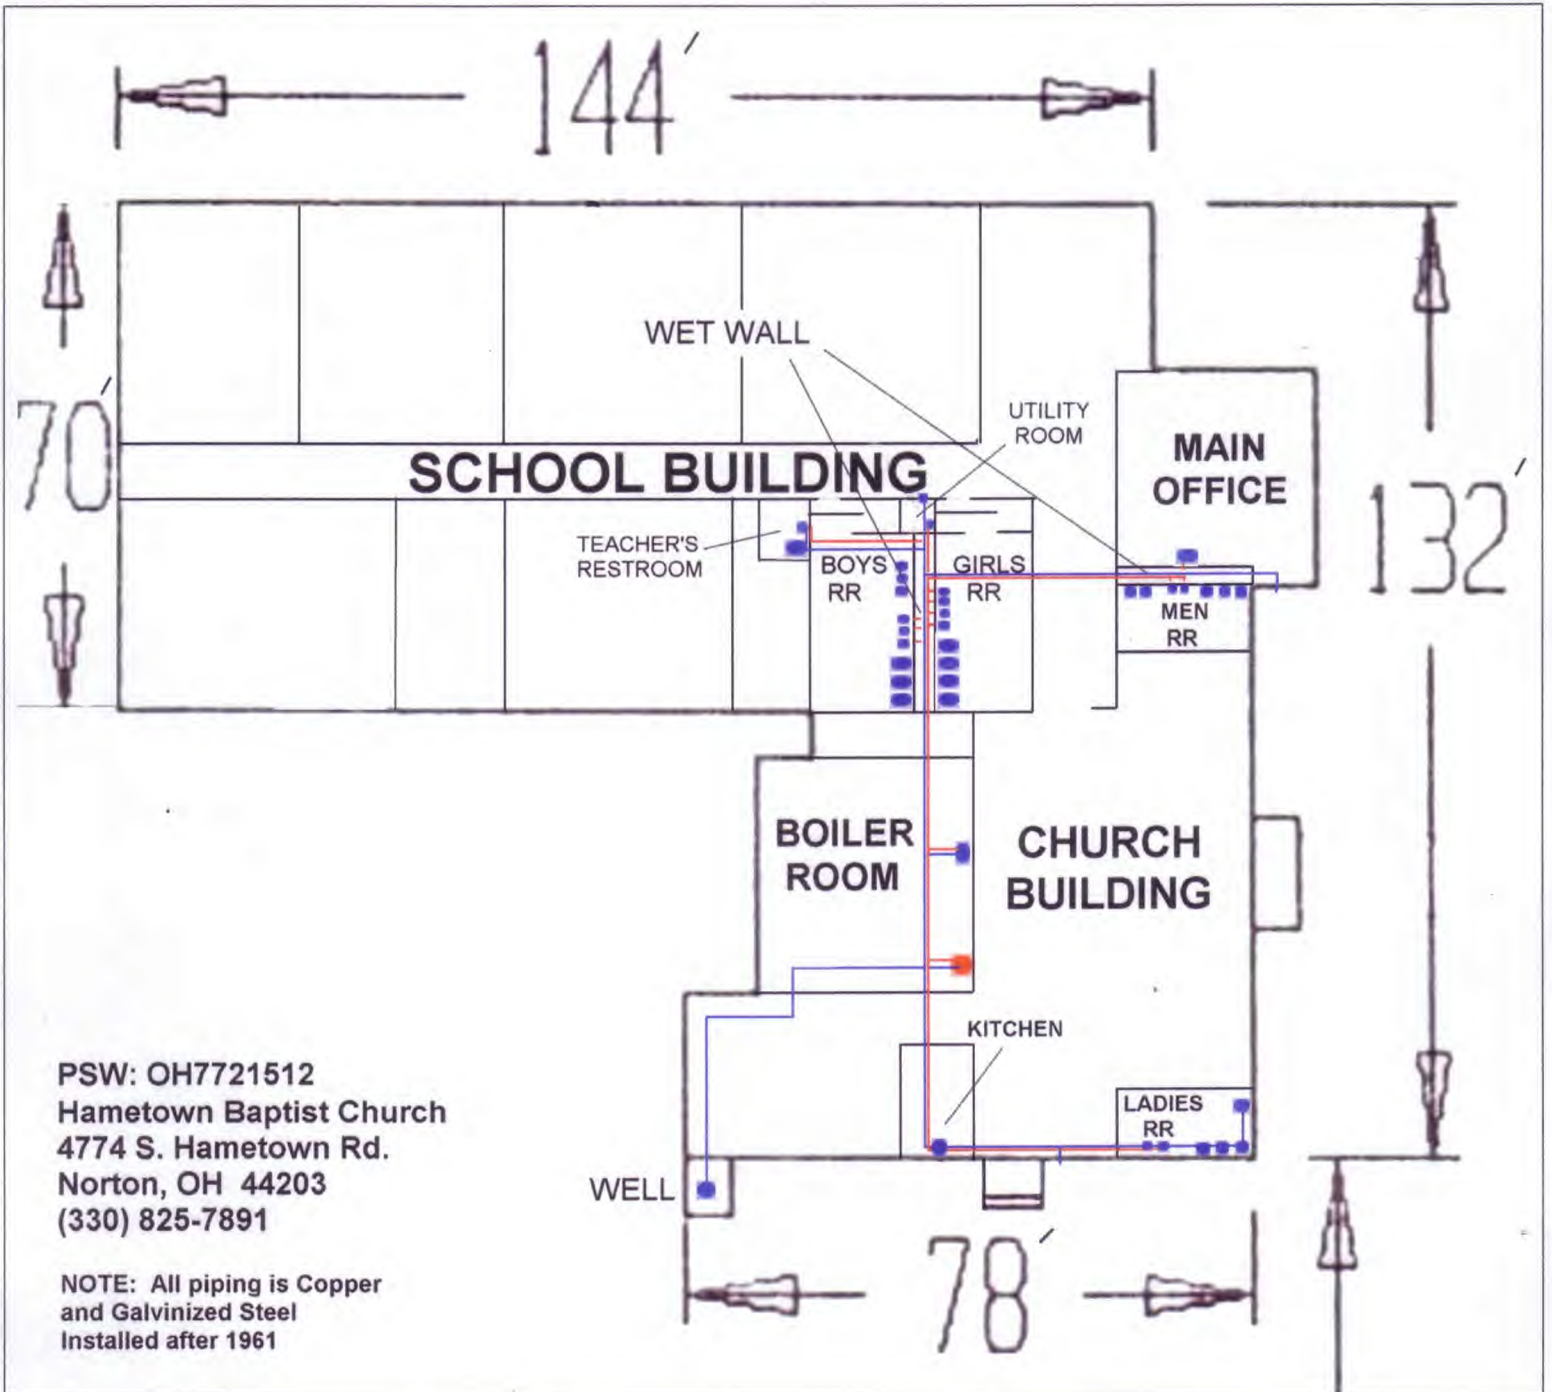

PSW: OH7721512
Hametown Baptist Church
4774 S. Hametown Rd.
Norton, OH 44203
(330) 825-7891

NOTE: All piping is Copper
and Galvanized Steel
Installed after 1961

