

Water Line Sizes

4" Lines

W. Prospect- 4" (mechanical)
E. Prospect- 4"
Parkview & Parkview circle- 4"
Dawn Dr.- 4"
Eldorado- 4"
Jane Dr.- 4"(switches to 6" at last hydrant goes to
Carter Grove)
David- 4"
Dan St.- 4"
Dennis Cr.- 4"
S. Mill St.- 4"

6" Lines

S. Milton St.- 6"
N. Milton St.- 6"
Carter Grove- 6"
Charles Ave.- 6"
Fairlawn Ave.- 6"
N. Mill St.- 6"
Gilbert Dr.- 6" (private)
WCSCC- 6" (private)
Barn Rest.- 6"(private)

8" Lines


East & West Center St.- 8"
Northeast St.-8"
Weller Dr.- 8"
Moss Creek St.- 8"
Gable Ln.- 8"
Kauffman Dr.- 8"
Smithie Dr.- 8"(private)
Red Barn at Barn Complex- 8"(private)

12" Lines

Loop around Square- 12"
Main St.- 12"
North & South Summit- 12"

2" Lines

E. Main From Leepers to Cemetery- 2"
Eberly- 2"
Hooley- 2"
Franklin Court- 2"
Church St.- 2"(6" stub at main)
Parkview to S. Milton- 2"

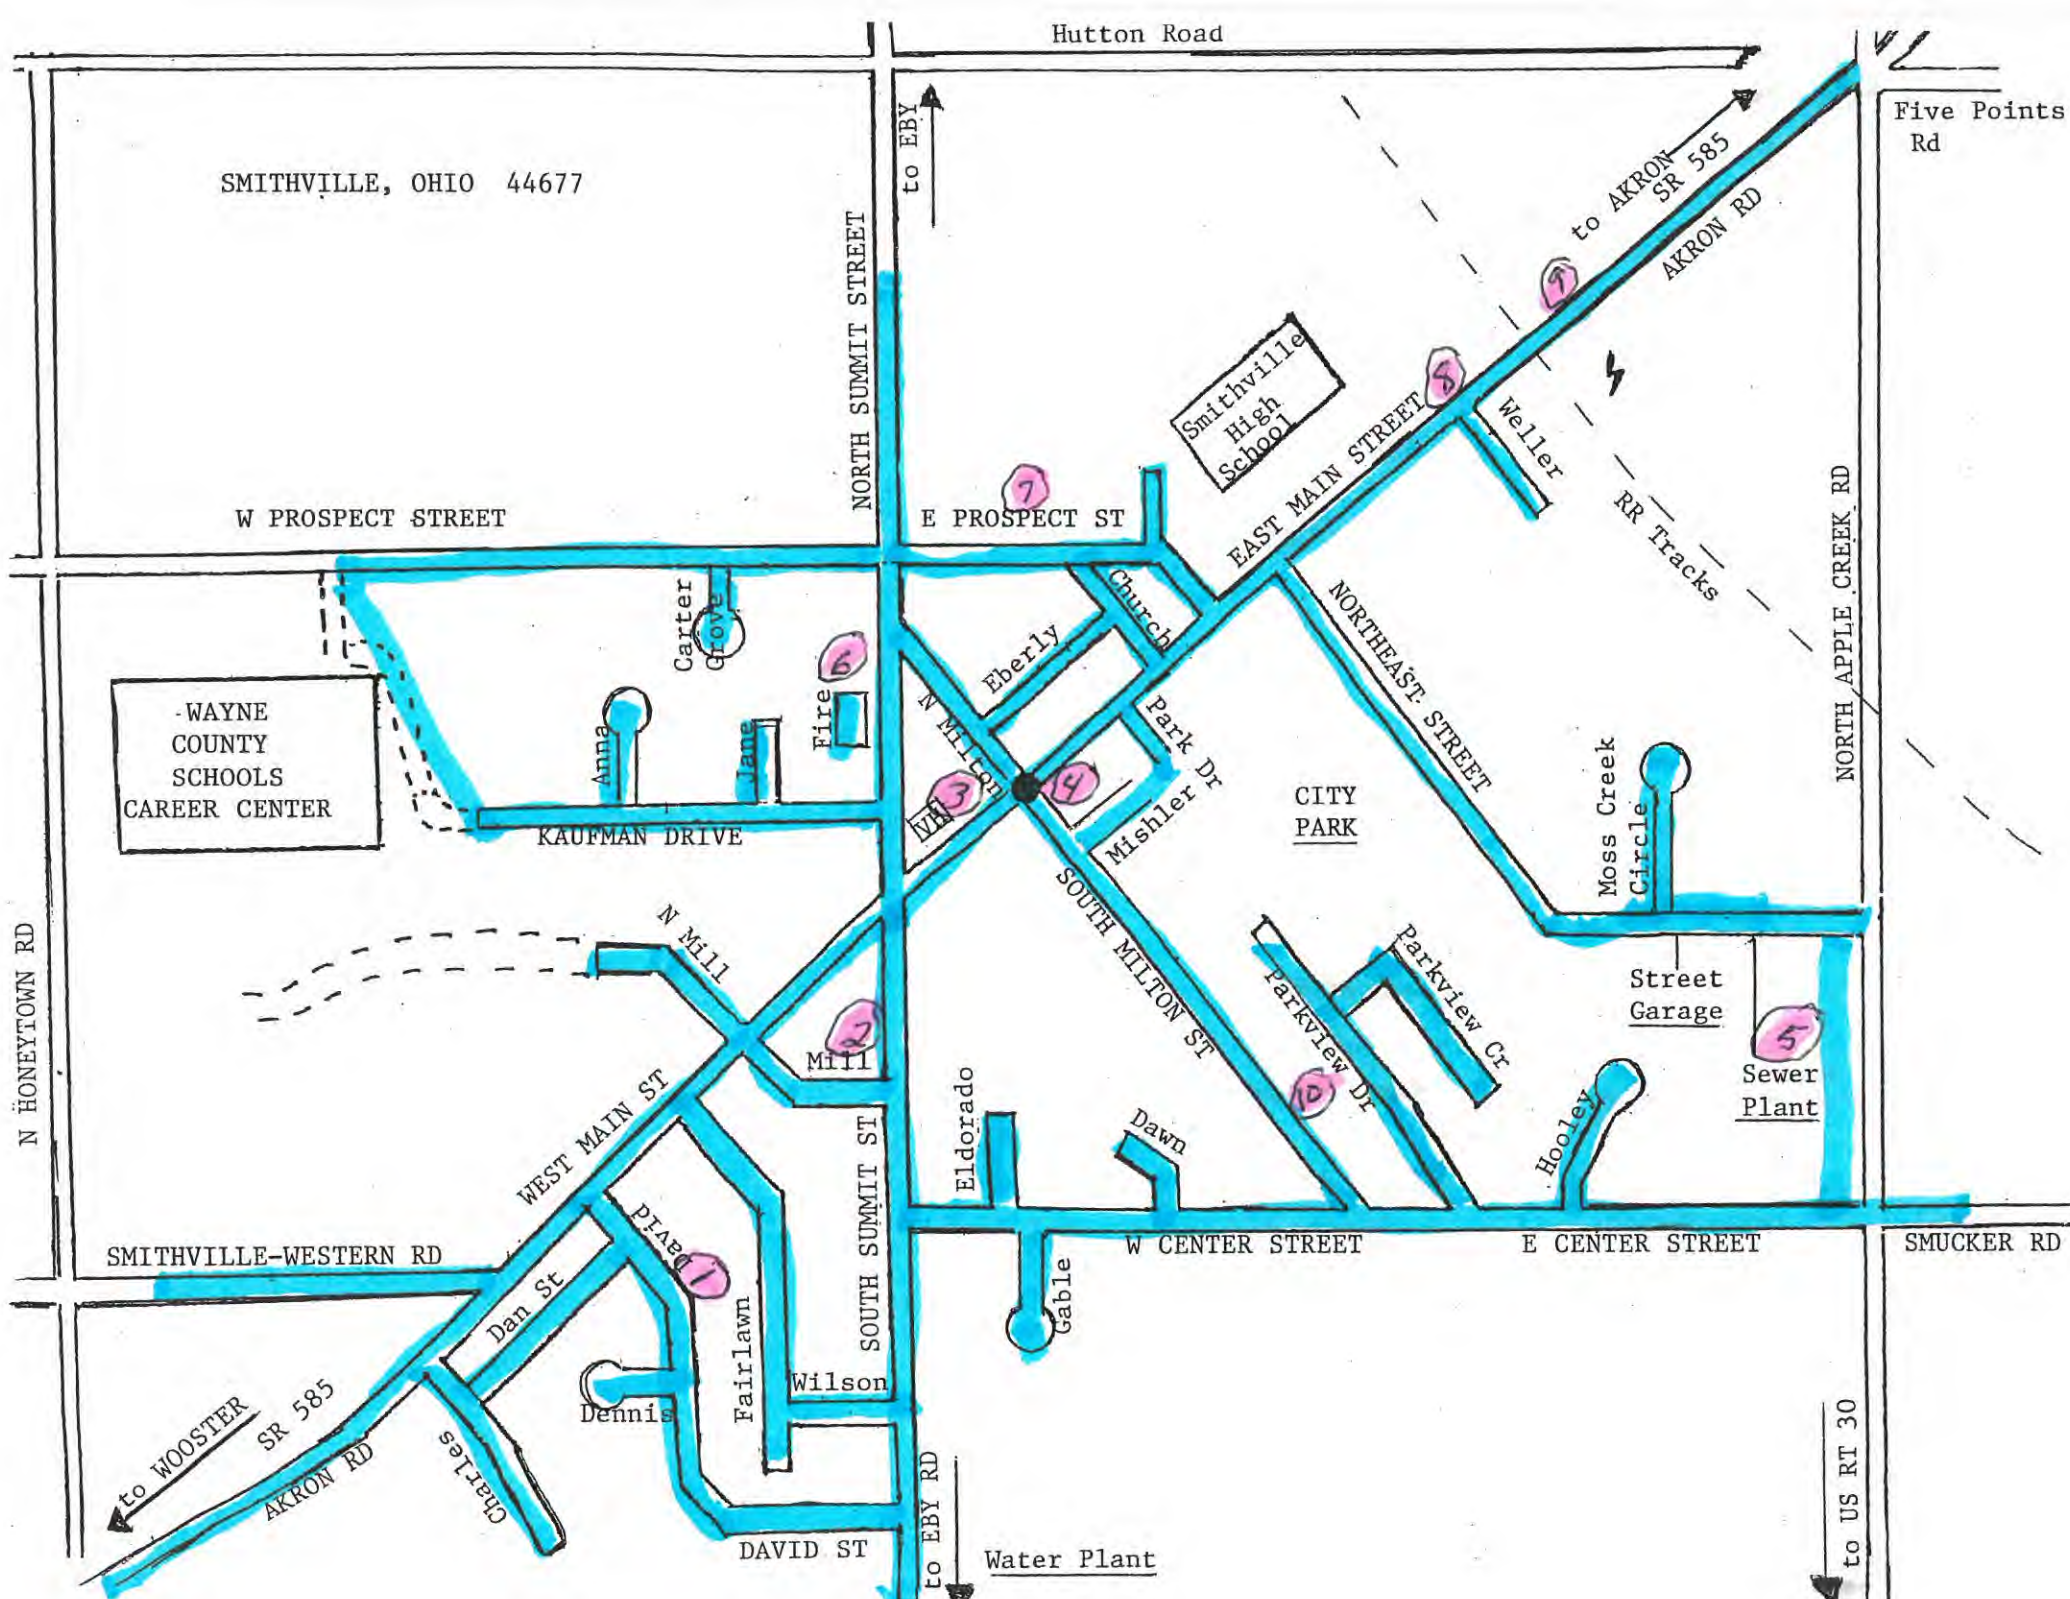

SMITHVILLE, OHIO 44677

Hutton Road

Five Points Rd

W PROSPECT STREET

NORTH SUMMIT STREET

to EBY

E PROSPECT ST

Smithville High School

to AKRON SR 585
AKRON RD

EAST MAIN STREET

Weller

RR Tracks

NORTH APPLE CREEK RD

WAYNE COUNTY SCHOOLS CAREER CENTER

Carter Grove

Anna

Jane

Fire

KAUFMAN DRIVE

N MILL

Eberly

Park Dr

SOUTH MILTON ST

CITY PARK

Parkview Dr

Parkview Cr

Moss Creek Circle

Street Garage

Sewer Plant

N HONEYTOWN RD

N MILL

WEST MAIN ST

Mill

Eldorado

Dawn

Hooley

SMITHVILLE-WESTERN RD

W CENTER STREET

E CENTER STREET

SMUCKER RD

to WOOSTER SR 585
AKRON RD

Charles

Dan St

Dennis

Fairlawn

Wilson

DAVID ST

to EBY RD

Water Plant

to US RT 30