

Georgetown Water District

77075 Zitko Road

Cadiz, Ohio 43907

PWSID; OH3400503

The Georgetown Water District was installed in the early 1970's and purchases its water from the Tri-County Water Authority. Most of the main lines and service lines are plastic with just a few hundred feet of asbestos cement. Most of the buildings are single family homes with a mixture of older and new homes. Inside plumbing of copper or plastic with dates not know.


**VERIFICATION FORM FOR COMMUNITY PUBLIC WATER SYSTEMS
CLAIMING NO LEAD SERVICE LINES**

The owner or operator of all community public water systems must identify and map areas of their distribution system that are known or are likely to contain lead service lines. Systems must submit a copy of the applicable map to the Ohio Department of Health and the Ohio Department of Job and Family Services. Systems must also submit a report to the director containing at least both of the following: (1) The applicable map with narrative, and (2) A list of sampling locations used to collect samples as required by Ohio Revised Code (ORC) Section 6109.121 and any rules adopted thereunder, including contact information for the owner and occupant of each sampling site.

Should a water system determine no lead service lines exist in their distribution system, they must provide information stating they reviewed, at the minimum, historical permit records and local ordinances, distribution maintenance records and information pertaining to installation dates or materials for all services lines. This information must be verified below.

I HEREBY CERTIFY THAT THE FOLLOWING METHOD(S) WERE USED TO DETERMINE NO LEAD SERVICE LINES EXIST IN THIS WATER SYSTEM'S DISTRIBUTION SYSTEM, AS REQUIRED BY ORC 6109.121(F):

LEAD SERVICE LINE VERIFICATION
<p>This PWS states they have no lead service lines and has reviewed the following information (select one or more of the following):</p> <ul style="list-style-type: none"><input type="checkbox"/> Historical permit records and/or local ordinances<input checked="" type="checkbox"/> Distribution maintenance records (i.e. meter replacement, waterline break repairs)<input type="checkbox"/> Information pertaining to installation dates for all service lines (i.e. after 1986 when lead services lines were banned)<input type="checkbox"/> Service line material of all service lines is known (i.e. all service lines are known to be PVC)

	03/08/2017
Signature of Responsible Person	Date
Karl Bowers Operator in Charge	
Printed Name and Title of Responsible Person	

PWS NAME:
Georgetown Water District
PWS ID: OH_34005003
COUNTY: Harrison

<p><u>For Ohio EPA use only:</u></p> <p>Date Verification Rec'd: _____</p>

Google Maps



North
↑

Google Maps

S+R+S19 - Stumptown Rd

pg 1



16 Road

North
↑

Georgetown Water Dist.

Google Maps

St Rt 519 - Stumptown Rd

Pg 2



New Athens

↑
North

Google Maps

US Rt 250 - Cadiz Harrisville Rd Page 3



North



Google Maps

US Rt 250 Cadiz Harrisville Rd Page 4



1 - David Peltz
77085 Zithke Rd

2 - Scott Peltz
48920 Georgetown Adams Rd

North
↑

Google Maps

Georgetown Adena Rd Page 5



North

Google Maps

Georgetown - Cadiz Harrisonville Rd Page 6




North



Google Maps

Georgetown

Page 7

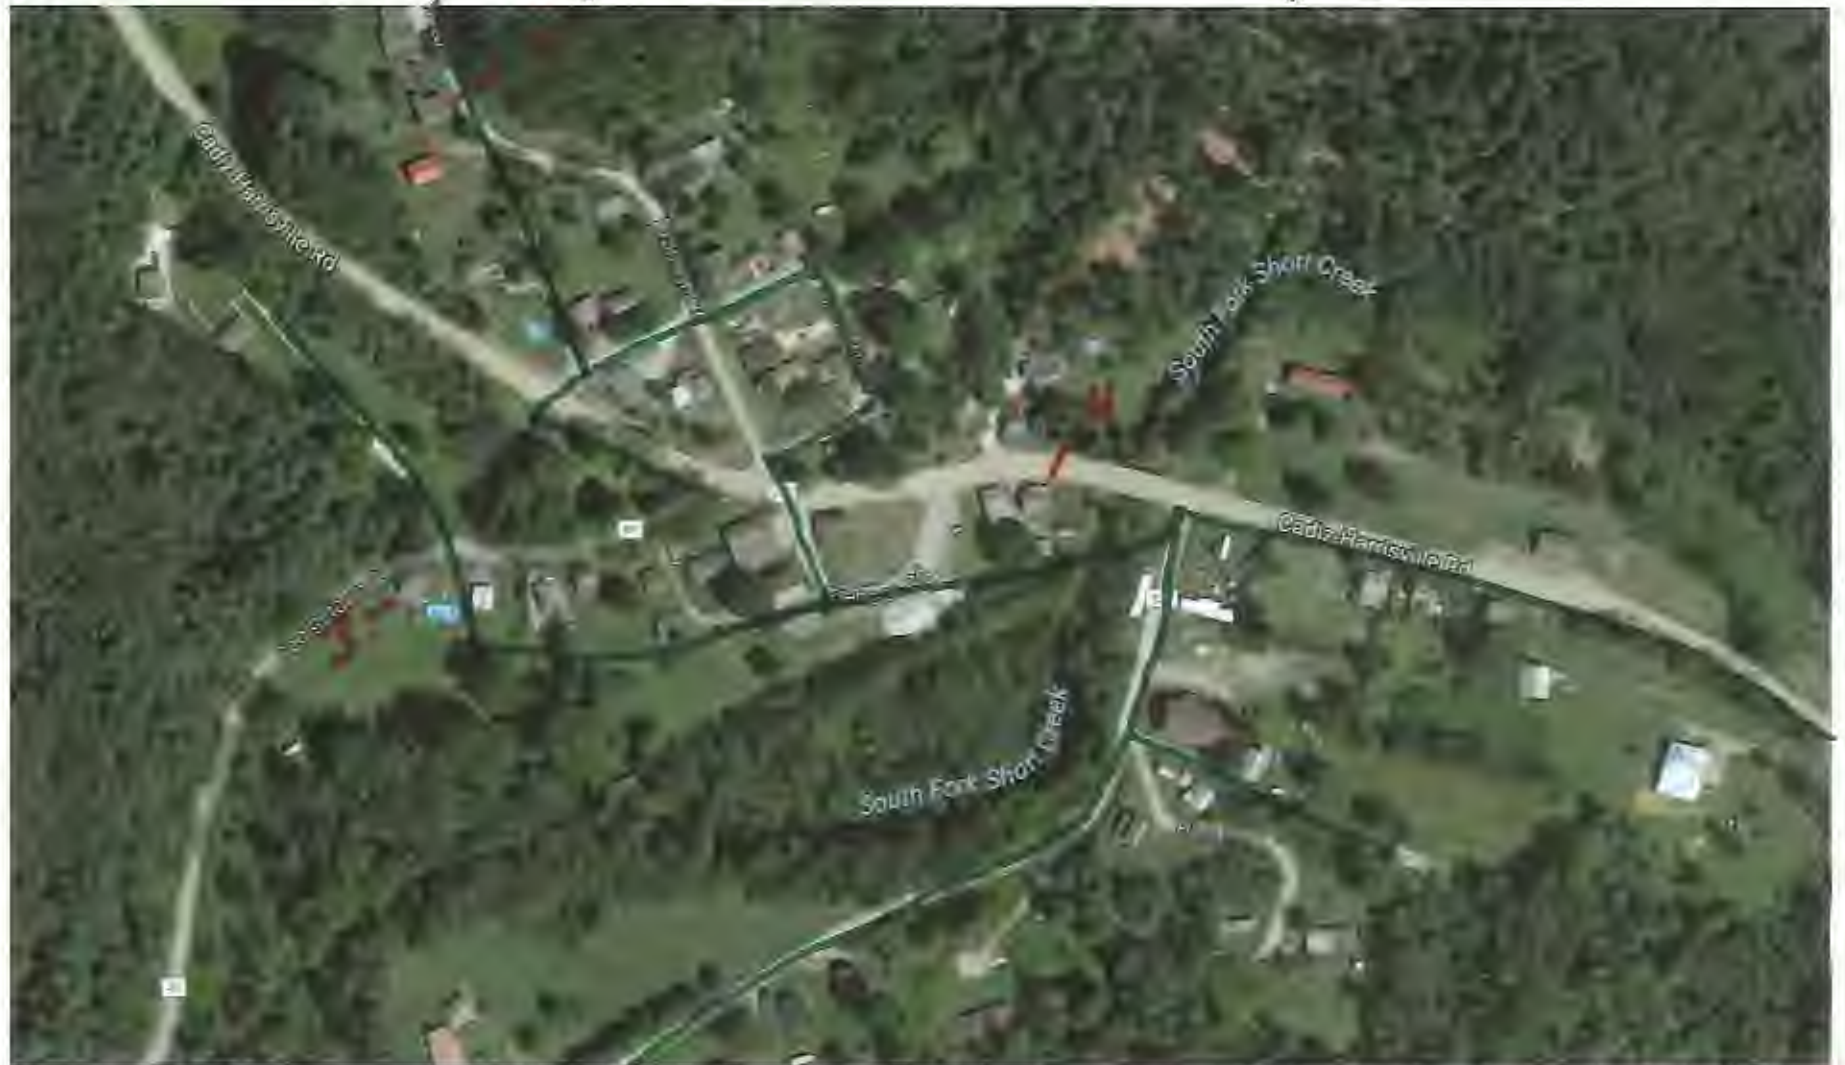

3 Cheryl Yarrish
47735 Front St.

4 Martha Ferris
47915 Cádiz Harrison Rd

5 Ed. Caszorst
71308 Branson Rd