

Village of Adena

P.O. Box 507

Adena, Ohio 43901

Jefferson County

PWS ID; OH4100003

The Adena Water System was started sometime in the 1930's. Many changes have occurred from operating their own water plant to buying all their water from Tri-County Water. Many of the lines in town have been replaced including a couple of expansions and the addition of 2 water tanks and the replacement of another one. Through all the work that has been done in Adena I have not seen or heard of anyone finding a lead service line.

The majority of the buildings in Adena were built before 1950, most have been updated over time with many of the owners or contractors no longer around. There are a lot of unknowns with many of the homes and the type of solder that was used and when. When the plan was first developed the operator at the time did his best to locate houses with lead solder that was in the time frame requested, since that time some have been replaced with plastic.

## VERIFICATION FORM FOR COMMUNITY PUBLIC WATER SYSTEMS CLAIMING NO LEAD SERVICE LINES

The owner or operator of all community public water systems must identify and map areas of their distribution system that are known or are likely to contain lead service lines. Systems must submit a copy of the applicable map to the Ohio Department of Health and the Ohio Department of Job and Family Services. Systems must also submit a report to the director containing at least both of the following: (1) The applicable map with narrative, and (2) A list of sampling locations used to collect samples as required by Ohio Revised Code (ORC) Section 6109.121 and any rules adopted thereunder, including contact information for the owner and occupant of each sampling site.

Should a water system determine no lead service lines exist in their distribution system, they must provide information stating they reviewed, at the minimum, historical permit records and local ordinances, distribution maintenance records and information pertaining to installation dates or materials for all services lines. This information must be verified below.

I HEREBY CERTIFY THAT THE FOLLOWING METHOD(S) WERE USED TO DETERMINE NO LEAD SERVICE LINES EXIST IN THIS WATER SYSTEM'S DISTRIBUTION SYSTEM, AS REQUIRED BY ORC 6109.121(F):

### LEAD SERVICE LINE VERIFICATION

**This PWS states they have no lead service lines and has reviewed the following information (select one or more of the following):**


- ☐ Historical permit records and/or local ordinances
- ☐ Distribution maintenance records (i.e. meter replacement, waterline break repairs)
- ☐ Information pertaining to installation dates for all service lines (i.e. after 1986 when lead services lines were banned)
- ☒ Service line material of all service lines is known (i.e. all service lines are known to be PVC)

Karl Bowers 03/08/2017  
Signature of Responsible Person Date  
Karl Bowers Operator in Charge  
Printed Name and Title of Responsible Person

**PWS NAME:** Village of Adena  
**PWS ID:** OH4300003  
**COUNTY:** Jefferson

#### For Ohio EPA use only:

Date Verification Rec'd: \_\_\_\_\_

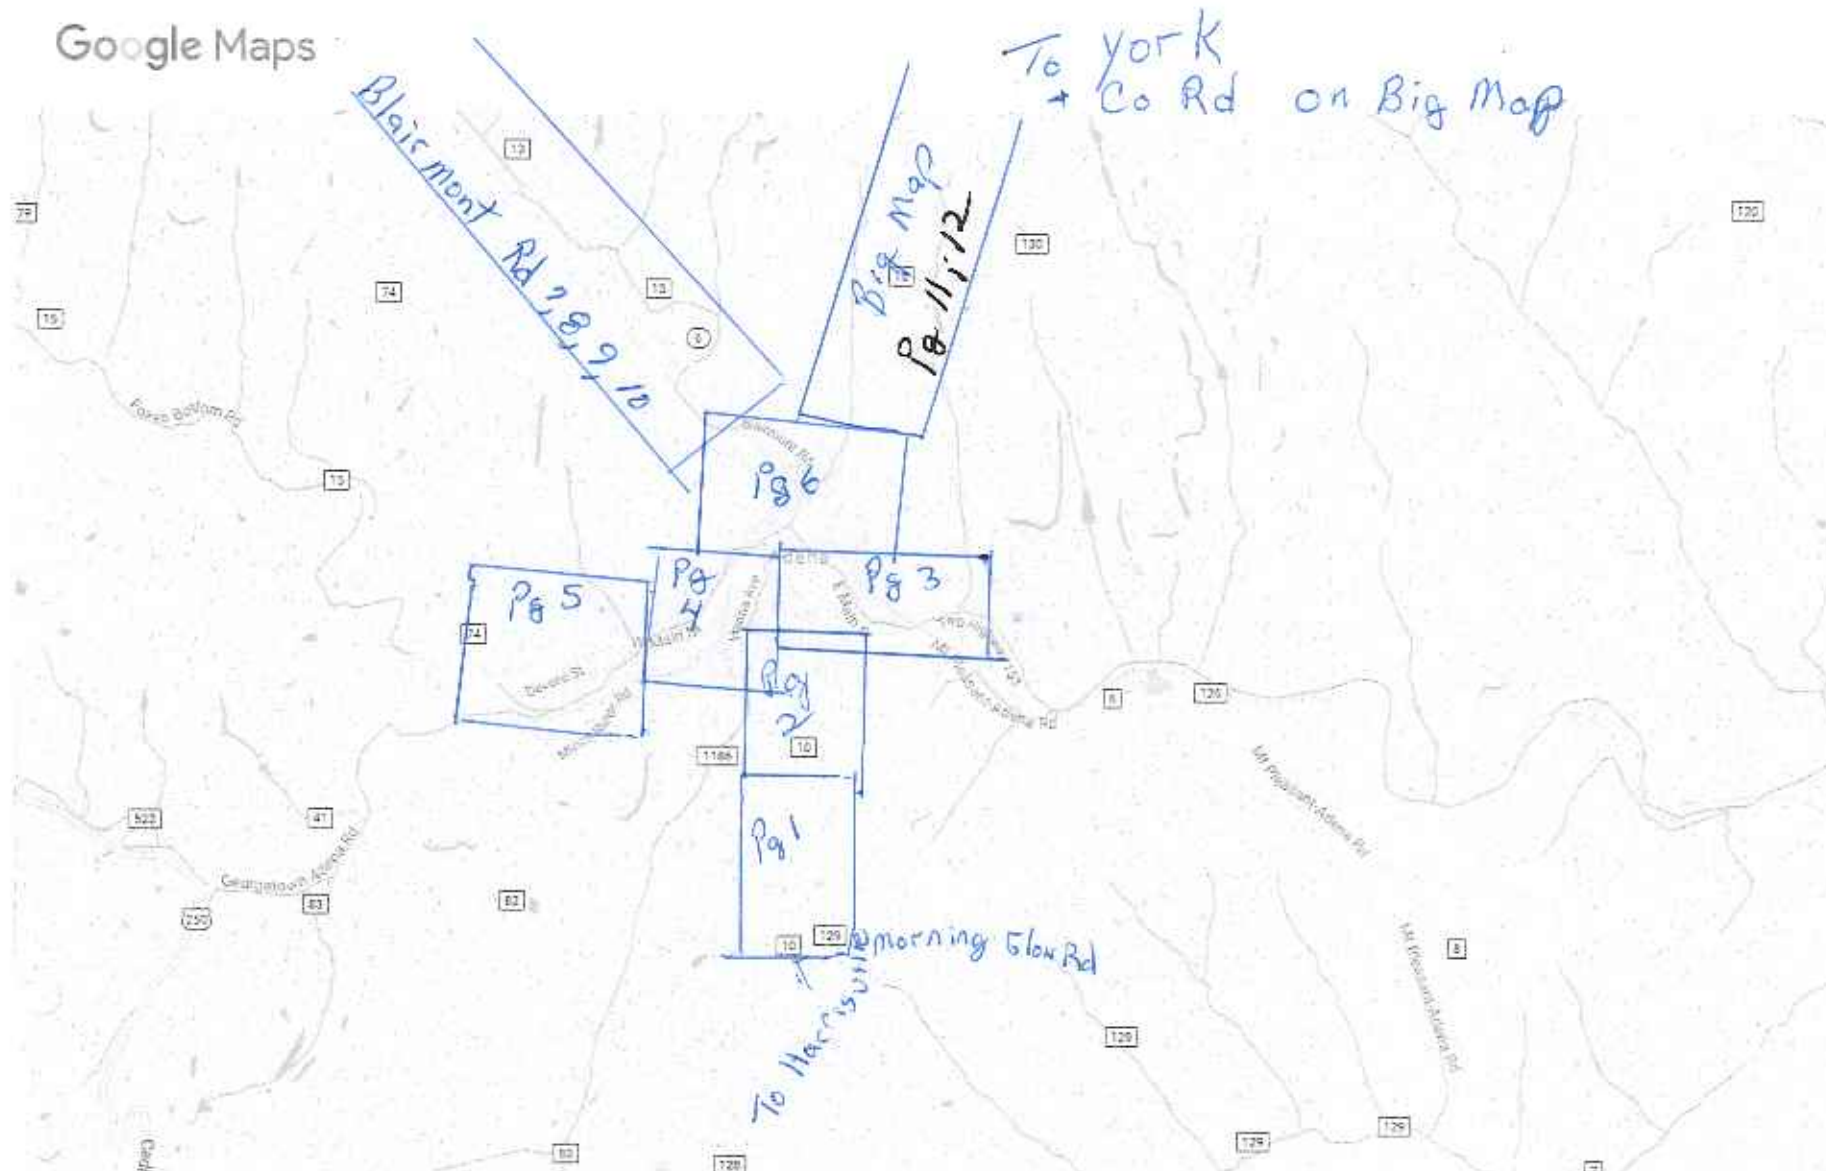



← North

Village of Adena

Google Maps

Smithfield Adena Rd



To  
→  
Harrisville

Adena Start  
Tri County Stops

← North

Google Maps

Smithfield Adena Rd to Adena



7 Alysha Wilson  
57 Shields Lane



North Village of Adena

Google Maps

South Bridge Street and East Side of Adena





Google Maps

S. Bridge Street and West side of Adena



10 Dan Bednarski  
67 Marie Ridge Rd

6 Thomas Bowling  
40 Sandborn St

4 St. Casimir Church  
221 Hanna Ave



North  
↑

Village of Adena

Hagen Addition-Harrison County



Father son / Harrison Co Mine



North



Google Maps

Adena North side



5 143 west Main St  
Adena Village office

3 Shirley Braun  
18 Hanna Ave.

8 James Nagy  
76 Hamilton St

Google Maps

Blairmont Rd - Jefferson Co. Pg 1



1 Nancy Walker  
49885 Blairmont Rd.

9 Kenneth Allen  
33 Hill St.



North → Village of Adena  
Blairmont Rd - Harrison Co. pg 2

Google Maps



Michael Basiek  
49740 Blairmont Rd

↓  
Toward Adena

North → Village of Adena

Google Maps

Blairmont Rd - Harrison Co Pg 3



Toward Adena



North → Village of Adena

Google Maps

Blairmont Rd - Harrison Co Pg 4




Toward Adena

North  
←

Village of Adena  
York Line

Google Maps

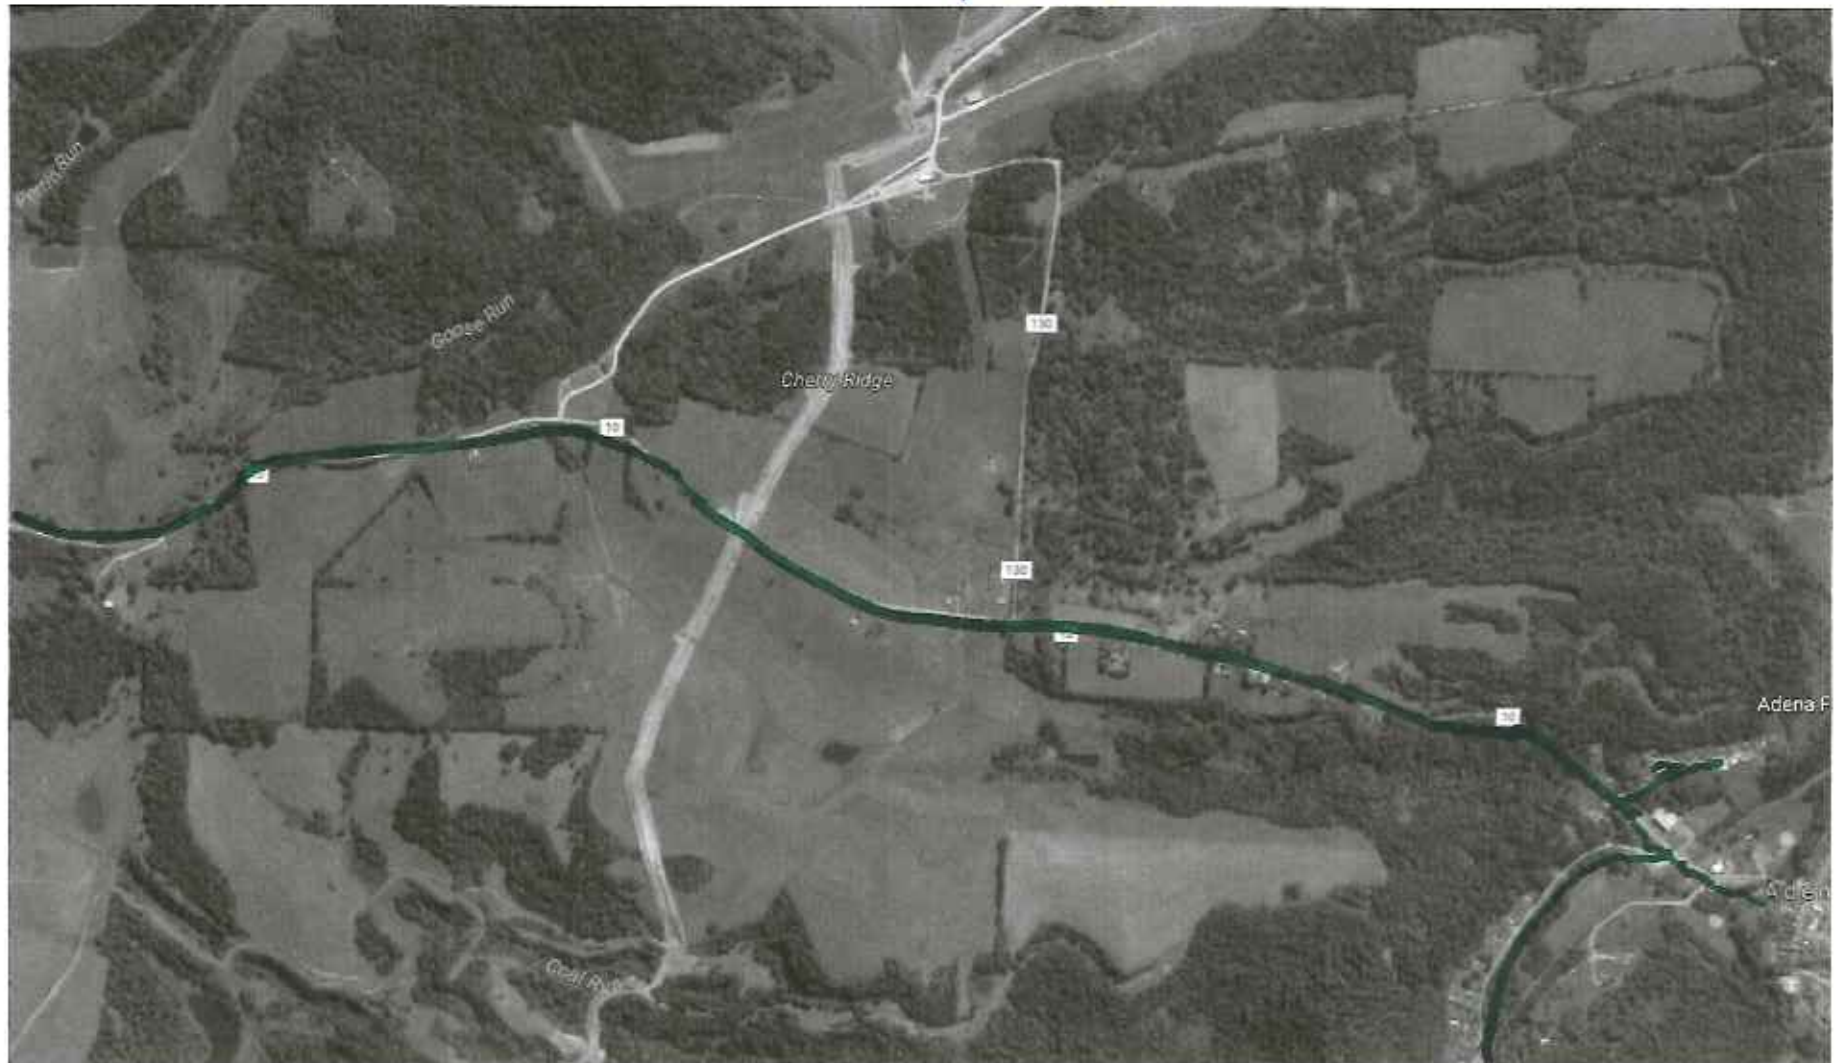





Google Maps

York Line

