



1ST FLOOR

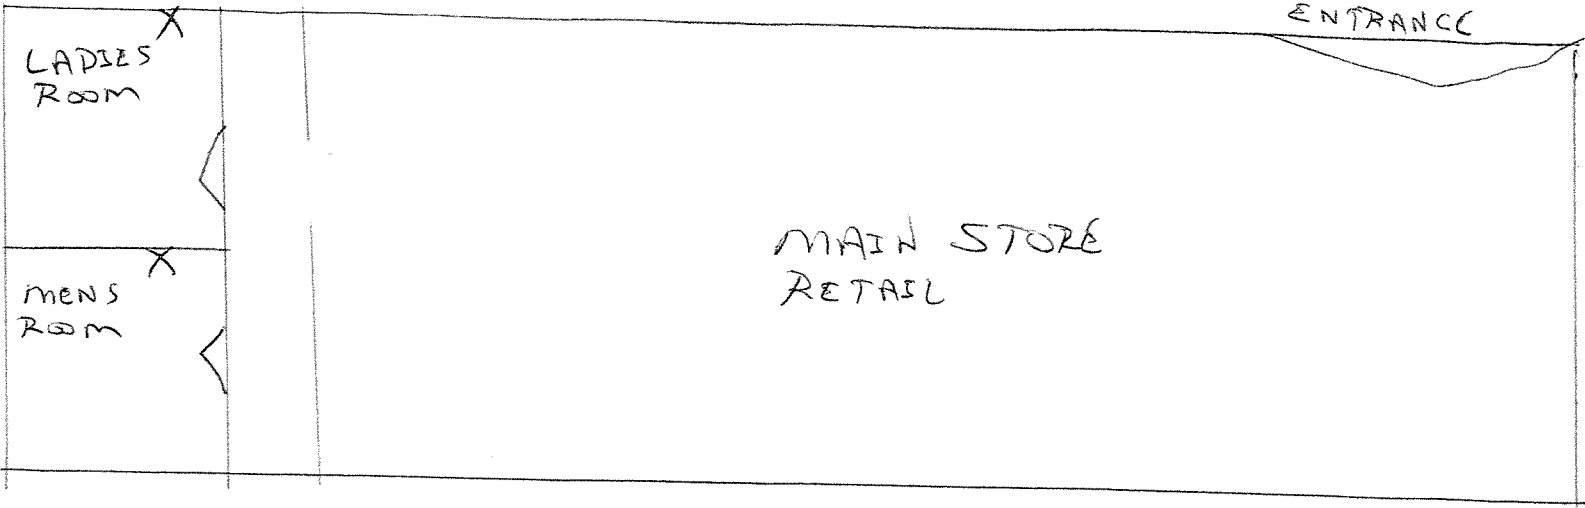

2ND FLOOR

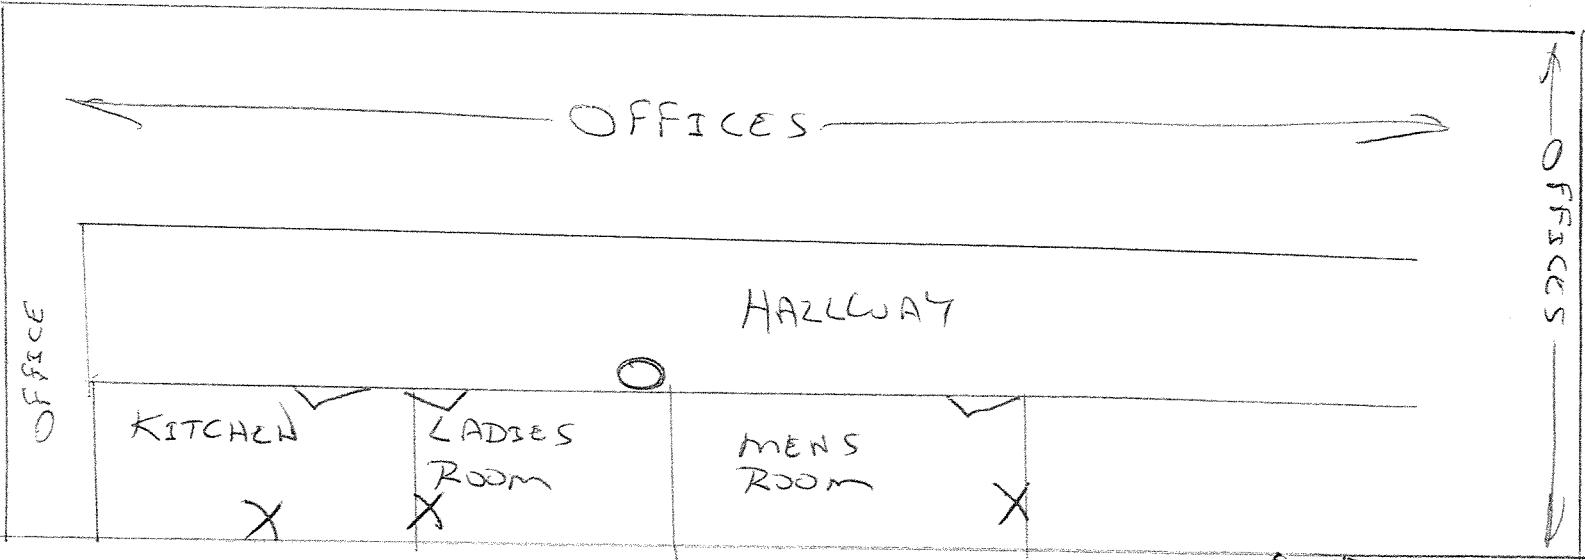

HOLMES LUMBER

PWS. ID# OH3833212 TIER 1

BUSLT PRE 1980 PLUMBING MATERIAL COPPER W/ LEAD SOLDER

SAMPLE MONITORING PLAN

- ① LC 201
MENS ROOM
- ② LC 202
LADIES ROOM
- ③ LC 203
MENS ROOM 1 FLOOR
- ④ LC 204
LADIES ROOM 2 FLOOR
- ⑤ LC 205
KITCHEN

LEGEND

- X LAVATORY
- DRINKING FOUNTAIN

PWS: OPERATOR
FERMAN MILLER
330-674-4505
CLASS A #
WSA-1108002-1D

Entity: Holmes Lumber and Building
 Doc Type: REPORT
 Doc Subtype: _____
 Program: _____
 County: Holmes
 Secondary ID: OH 3833212

RECEIVED
MAR 03 2017

BY: