





Google Earth


feet 400
meters 100



Pine Tree Barn
4374 Shreve Rd
Wooster, OH 44691

Lead Line 

Water Well 

Outside Hydrants 


- A - Alpha
- B - Bravo
- C - Charlie
- D - Well Head

Entity: Pine Tree Barn
 Doc Type: Report
 Doc Subtype: _____
 Program: OSW
 County: Wayne
 Secondary ID: OH 8553612

RECEIVED

MAR 19 2017

OHIO EPA NEDO

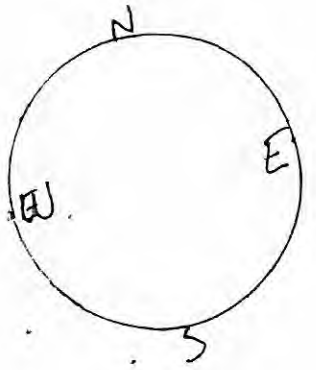


Pine Tree Barn 4374 Shreve Rd
 Wooster, OH 44691
 (330) 264-1014

LOWER LEVEL

Alpha Building

RECEIVED
 MAR 19 2017
 OHIO PAINTED PRESSURE TANK

- Lead █
- Non Lead █
- Hot water █
- Sink █
- Softener █
- Pressure Tank █

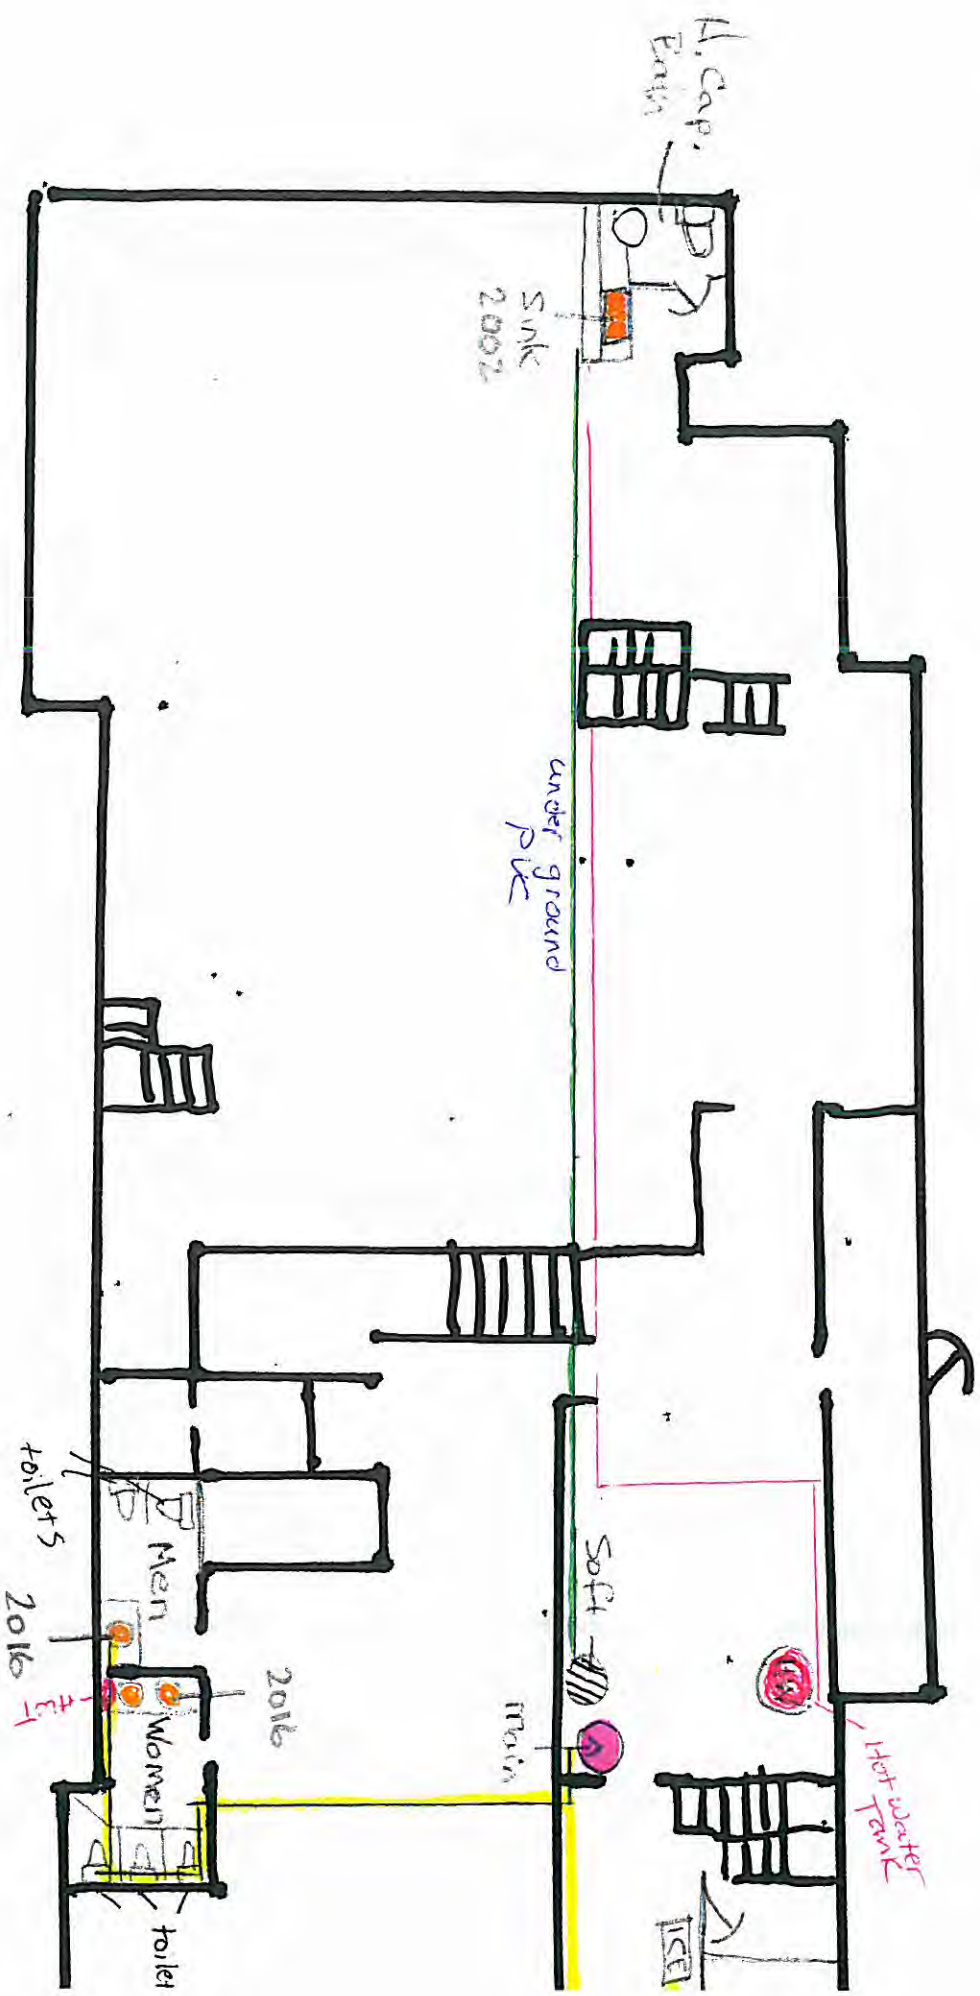



Pine Tree Barn

and farms, inc.

4374 Shreve Road
Wooster, Ohio 44691
Tel. 330.264.1014
Fax 330.264.8987
www.pinetreebarn.com

March 4, 2017

To Whom It May Concern,

Enclosed please find the information you requested regarding our water supply here at our business. If you have any questions or concerns please don't hesitate to contact us.

Sincerely,

A handwritten signature in black ink, appearing to read "Matt Kilbourne". The signature is fluid and cursive, with a long horizontal stroke at the end.

Matt Kilbourne
Owner
Pine Tree Barn
matt@pinetreebarn.com
330-264-1014

RECEIVED
MAR 09 2017
OHIO EPA NEDO


RECEIVED

MAR 19 2017

OHIO EPANEDO

Pine Tree Barn 4374 Shreve Rd
KITCEN wooster Ohio 44691
(330)264-1014

Alpha Building

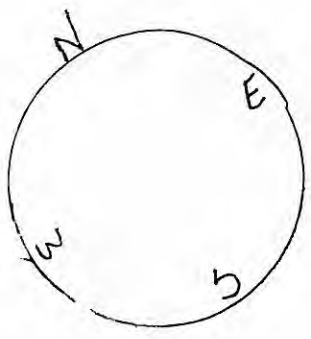

- Lead (Copper Lines) ■
- Non Lead ■
- Hot Water ■
- Sinks ■

