

Lead Mapping

Top of The Hill
Community
4287 Mandator Avenue, NW
North Lawrence, Ohio 44666

330 7155860 Jacob GRINN owner

OH 7603912
Facility ID 7658301

William L. Roth Sr
Operator

John M. Roth + Sons Inc
DBA Mr Dependable pump
6200 Manchester Rd
New Franklin Ohio 44216

330 8824111

FAX 330 8826778

Cell 330 819 9638


E. NAPI Mr Dependable pump @ SBC Global. Net

I Have included another Business Supplied
By This water, will need discuss
if Necessary

"FAT ABBEYS"
4291 Manchester Rd. NW
North Lawrence, Ohio 44666
330 837 4330

Water Supply Equipment
is located in Bar
but Also Feeds Top of
The Hill Trailer Park

N1

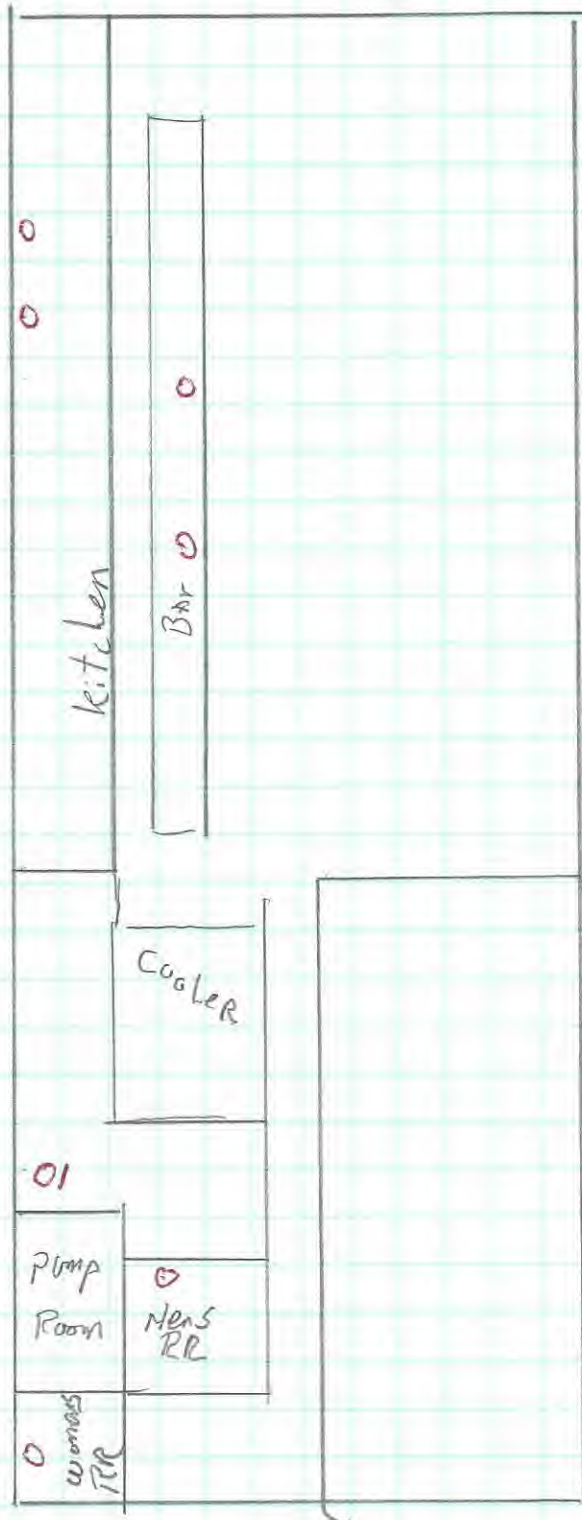

FPT Abbeys BAR
NOT INCLUDED UTIL!
Now.
0 Sink
01 utility Sink.

Google Maps



Imagery ©2017 Google, Map data ©2017 Google 50 ft

Access To individual Homes Are completely at The Choice of owners
 No Normal Test Ports For Lead Testing, This is why I included
 Abby's Not Asked For

• 19 care taker