


PWSID # 7301603

2017 MAR -9 PM 1:37


Scioto Water, Inc.

Lead Service Line Mapping and Sampling Report

March 2017

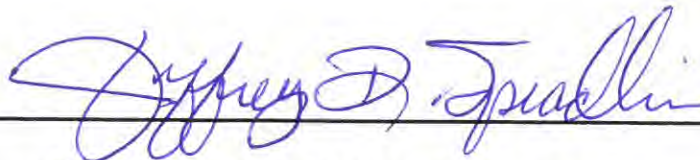

Jeffery Spradlin, General Manager

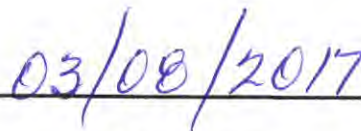

Date

PWSID # 7301603

**Scioto Water, Inc.
Lead Service Line Mapping**

General

The Scioto Water, Inc. (SWI) is a rural not-for-profit water company organized in the late 1960's and provides water service in portions of Scioto, Pike, Jackson, and Lawrence Counties. Scioto Water, Inc. has two treatment facilities and also purchases water from the City of Portsmouth. The distribution system is broken into three distinct service areas which are the Rose Hill, East End, and West End Service Areas. Figure 1.0 -1 provides a general graphical location map of the three services Areas. These areas have been further broken down into zones for purposes of finding lost water.

SWI water distribution mains are not constructed of lead piping or with lead joints.

PWSID # 7301603 is located in the West End service area.

Water Company Side of Meter


The lead service line mapping is broken down into two segments. One segment is the SWI company side of the water meter. SWI uses water meters for each customer for flow measurement for billing purposes. The water meters are located in meter pits generally near the highway right-of-way. In 2016, SWI replaced the meters to incorporate a drive-by radio read meter system. The meters that are currently installed for residential users consist of a plastic material.

On the SWI company side of the water meter, SWI installed the service line connecting the water main to the water meter. SWI left approximately 5 feet of service line beyond the water meter for the customer to connect to. None of the service lines installed by SWI consist of lead material.

PWSID # 7301603 does not contain any lead service lines from the water main to the water meter.

The following map(s) depicts the service area for PWSID # 7301603. The color coded map indicates that there are no lead service lines from the water main to the water meter.


Lead =  No Lead =  No Information = 

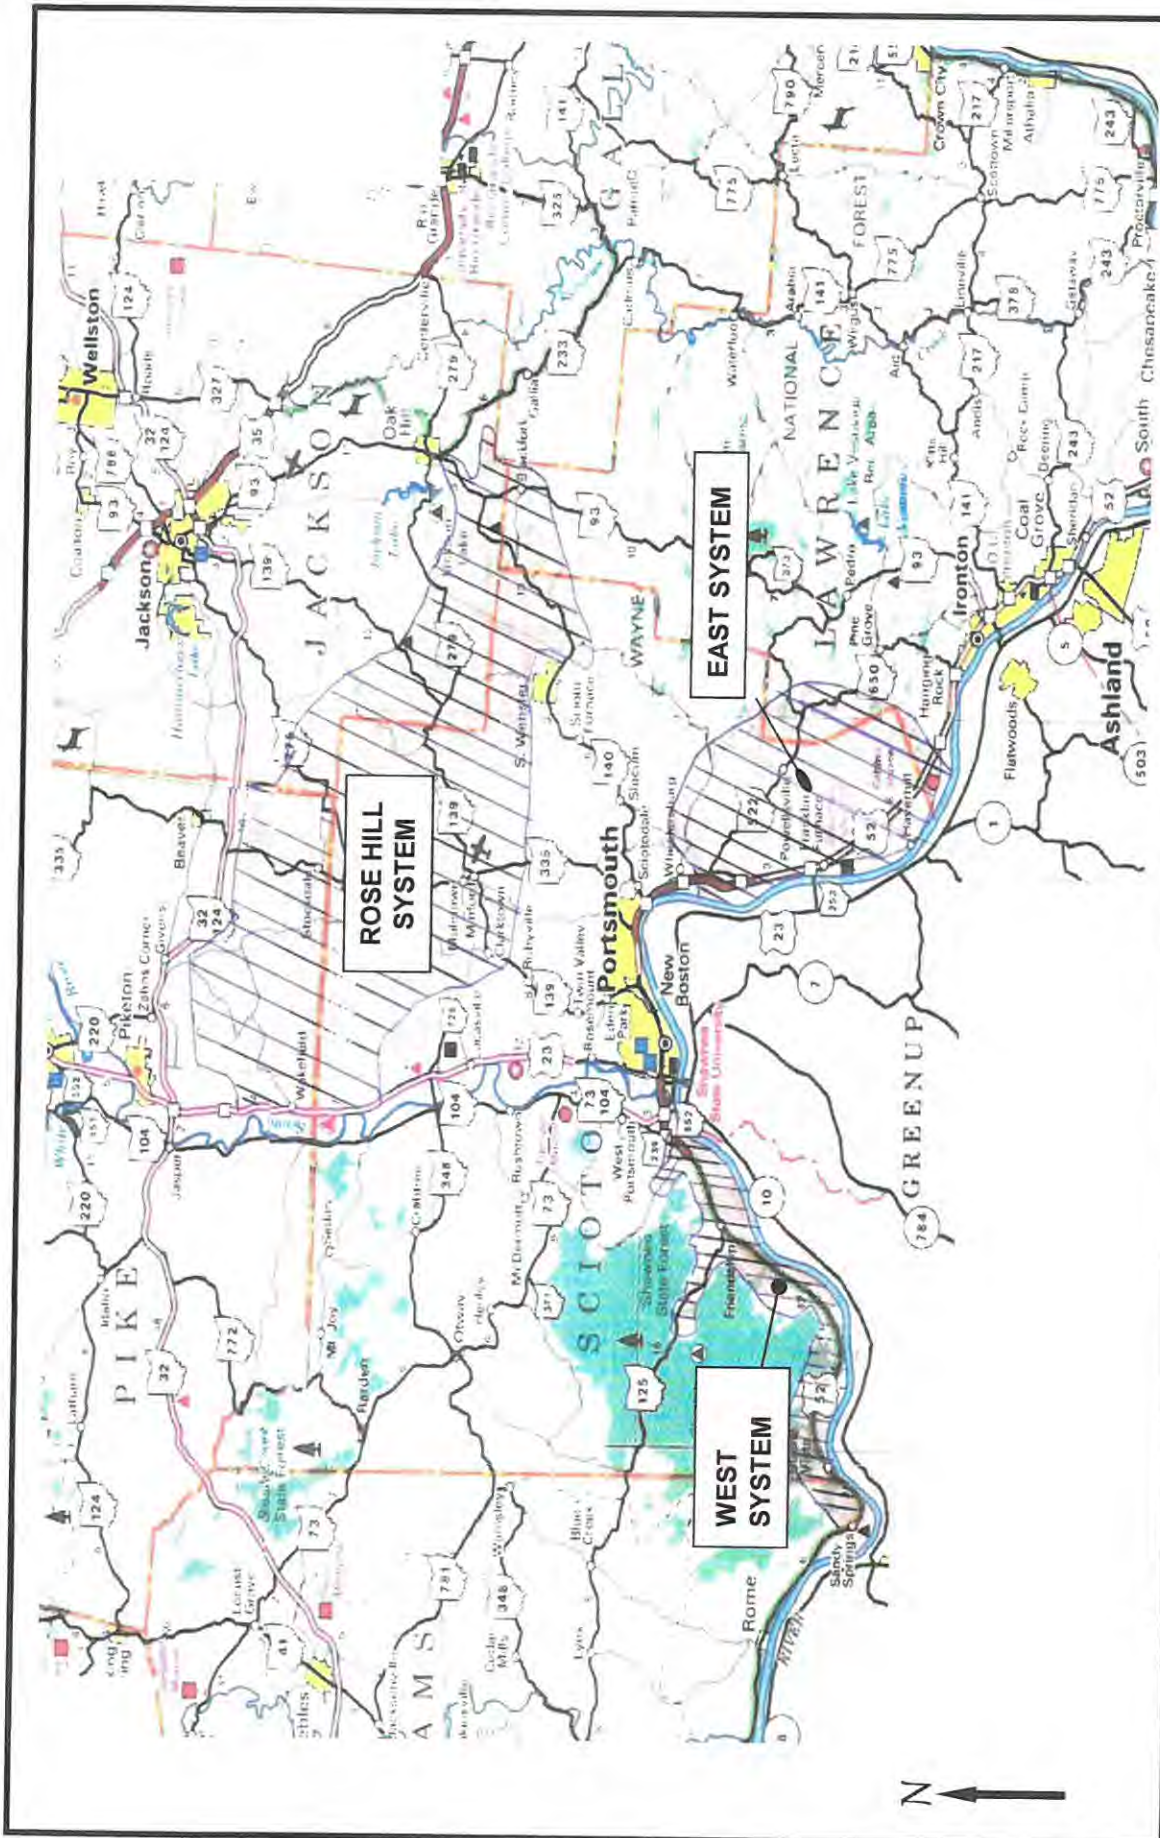

SCIOTO WATER, INC

WATER SYSTEMS GENERAL LOCATION MAP

FIGURE 1.0 - 1

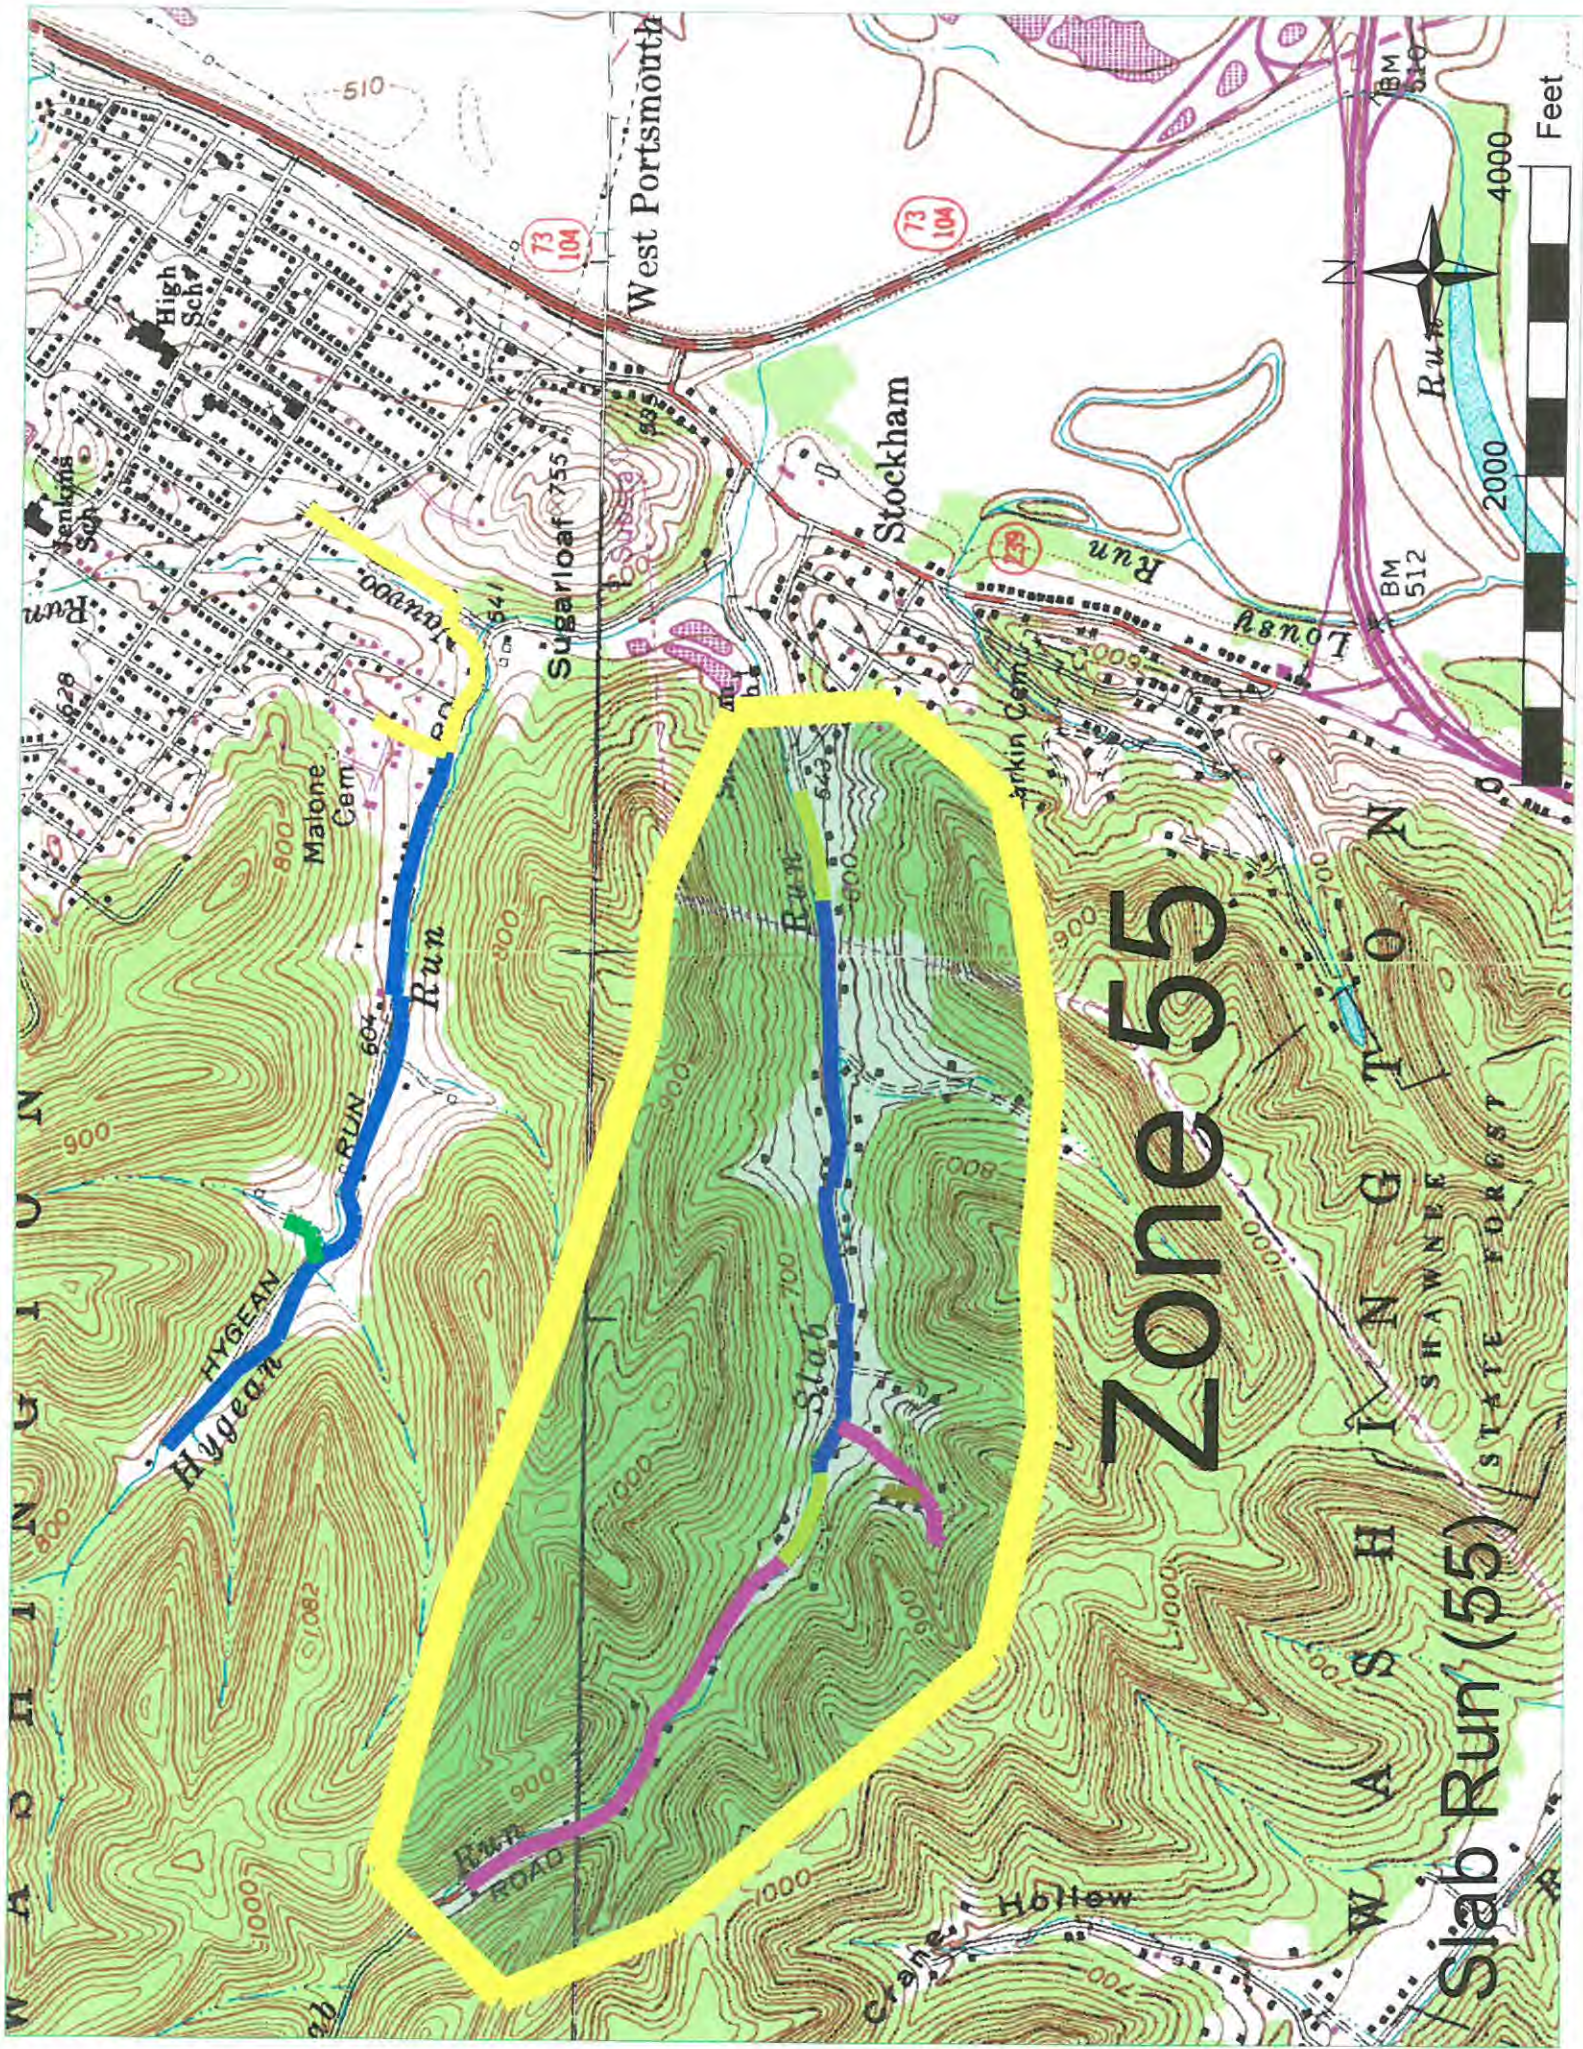

Zone 55

Slab Run (55)

Feet

4000

2000



W A S H I N G T O N

SHAWNEE

STATE FOREST

West Portsmouth

Stockham

HYGEAN

CRANE HOLLOW

SUGARLOAF

PARKIN CEM

MALONE CEM

HIGH SCH

JENKINS SCH

BM 512

BM 510

73 104

73 104

510

10007

1062

800

700

600

500

400

300

200

100

0

100

Customer Side of the Water Meter


After SWI provided the water meter and the service line from the water main to the meter, the customer connected the residence, building, etc. to the water meter. Some of these may have been to existing homes at that time where the property owner switched from a well or cistern to the SWI supplied water. In other cases, new homes or buildings may have been constructed.

PWSID # 7301603 consists of residences, buildings, etc. of various ages. As this is a rural area, newer homes may have been constructed between older existing homes. Nearly all homes in this service area were constructed prior to 2014.

The users in this area should not have lead service lines as connections to the water meter would have been made from approximately 1970 or later. However, they may have fixtures with solder or brass that may contain lead.

The following map(s) indicate the customer side of the meter for the service area for PWSID # 7301603. The map(s) are coded to indicate that it is unknown as to whether any lead products exist for each customer.

Lead =  No Lead =  No Information = 

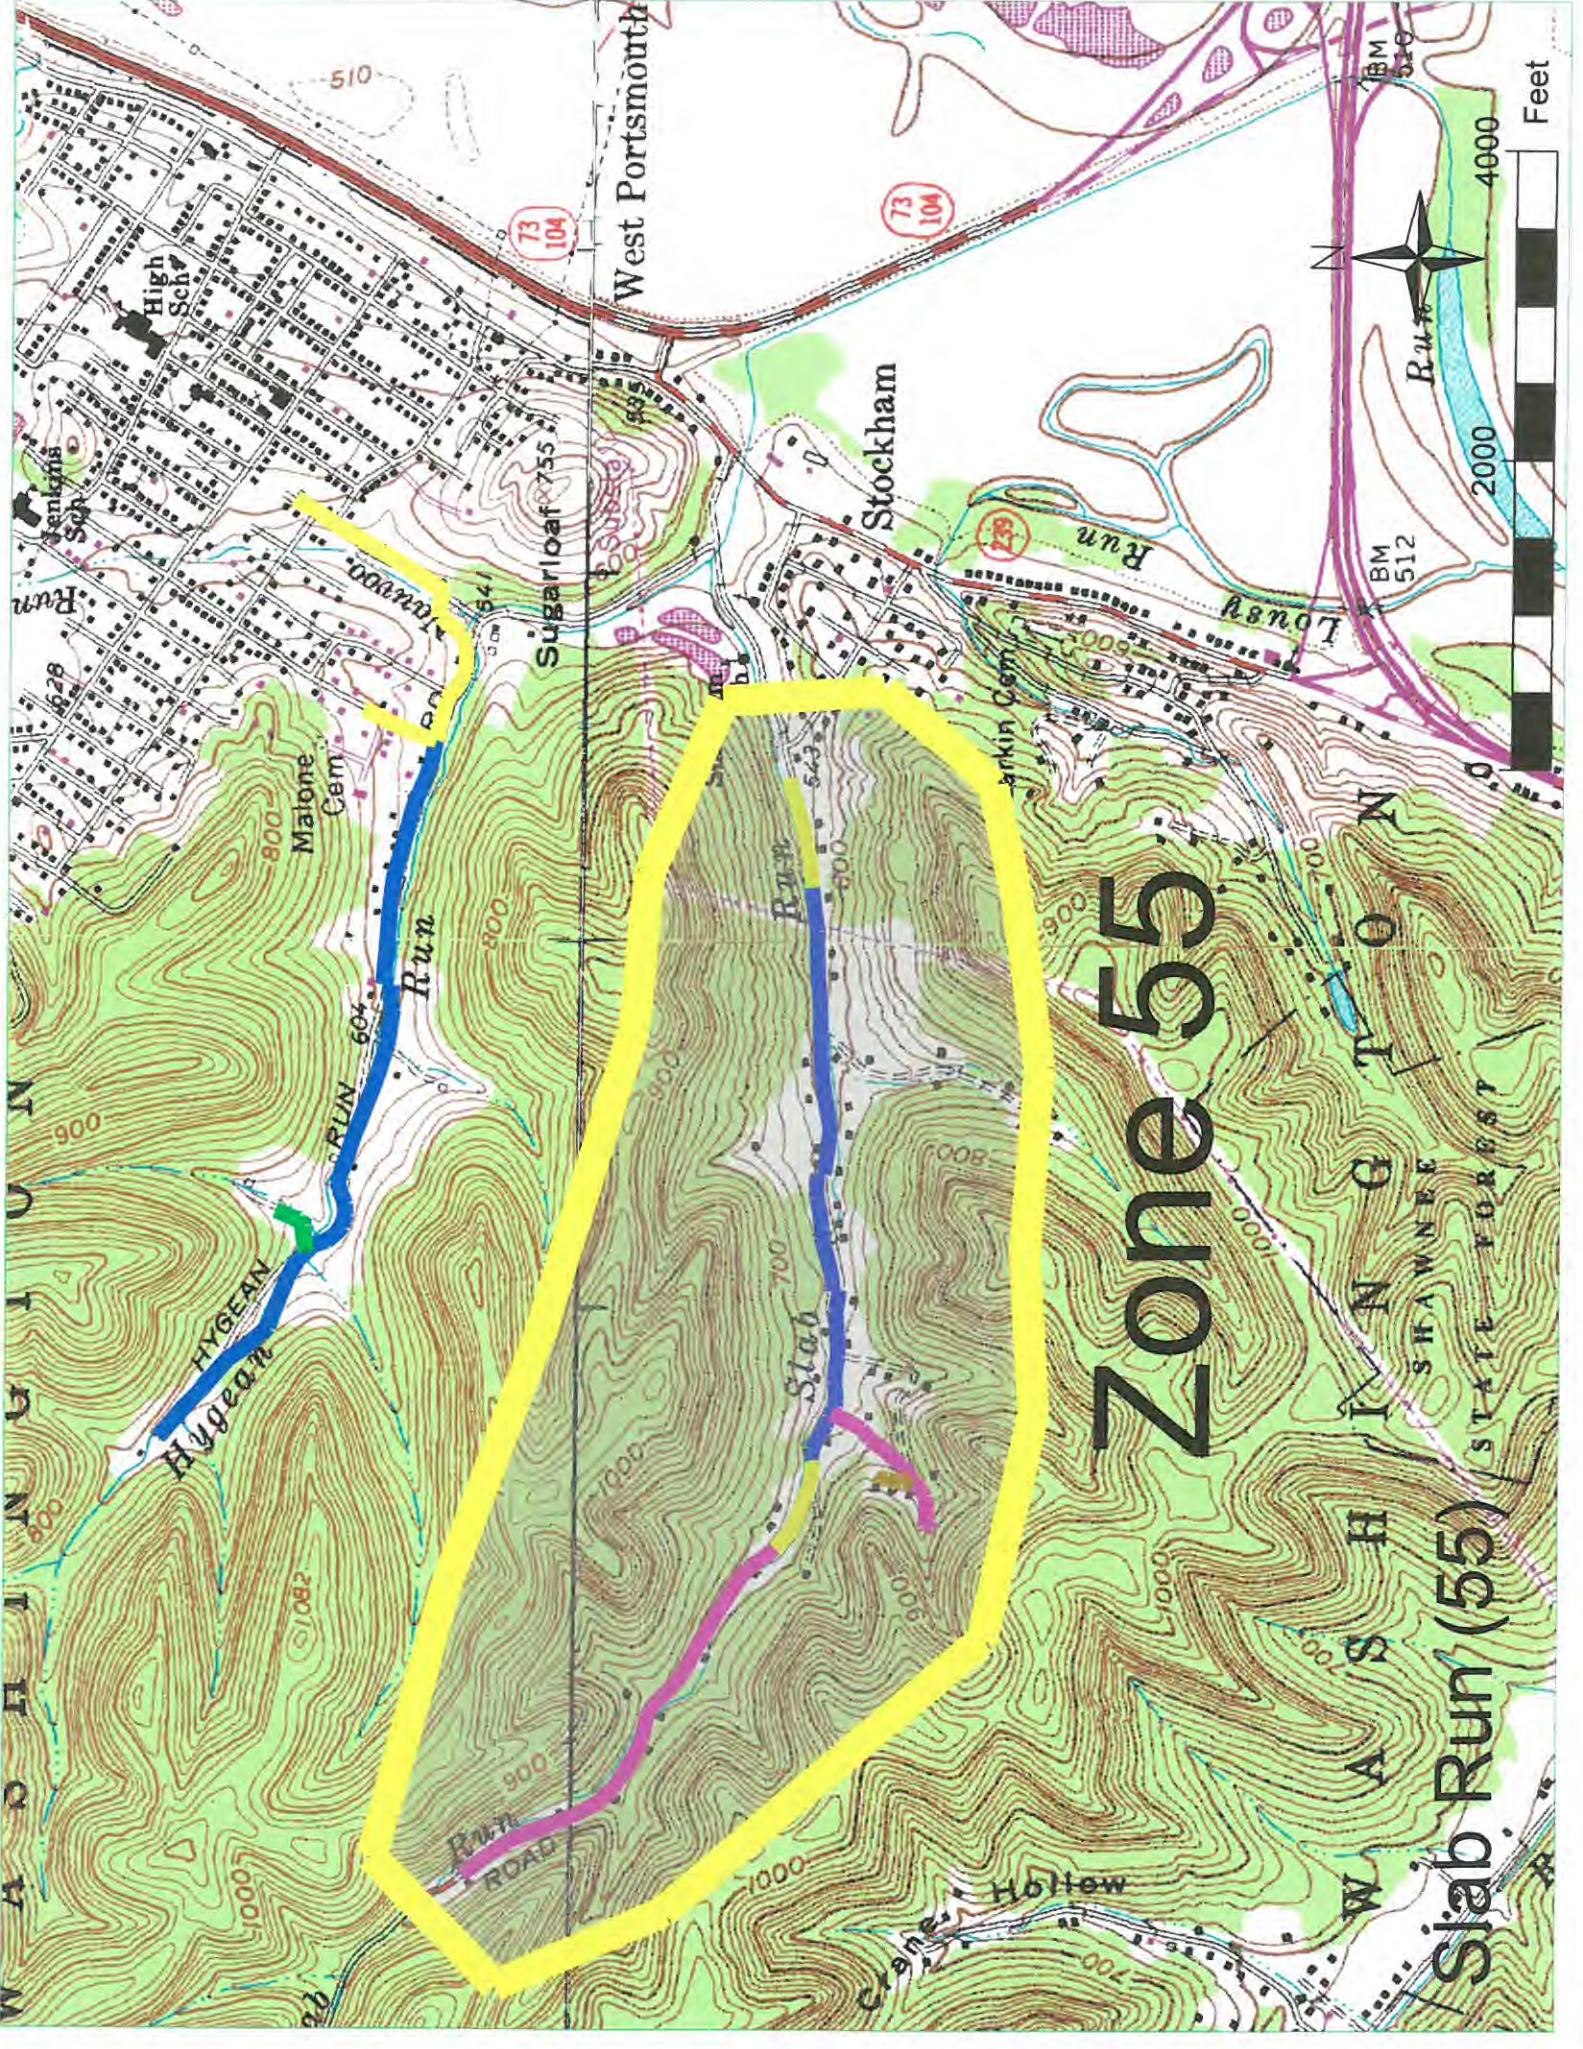

Zone 55

Slab Run (55)

W A S H I N G T O N

SHAWNEE STATE FOREST

West Portsmouth

Stockham

High Sch

Sugarloaf

Long Run

Hygean Run

Slab Run

Crane Hollow

10082

BM 512

BM 510

Feet

4000

2000

73 104

73 104

23

510

628

10007

92

92

900

800

1000













