

RECEIVED

MAR 09 2017

OHIO EPA NEDO

WEST GEAUGA PLAZA - MAIN PWS ID: OH2860212 (CHESTER TWP)

MAPPING LEAD PLUMBING AND FIXTURES (440) 543-7437

SITE PLAN IDENTIFICATION


SITE PLAN NUMBER	ADDRESS	SMP ID	TIER SITE	PLUMBING AGE	TYPE OF INTERIOR PLUMBING	TYPE OF SERVICE LINE	TYPE OF SOLDER	FIXTURES IN PREMISES	STRUCTURE TYPE
1	12692 WEST GEAUGA PLAZA	LC205	2	2001	Copper	Copper	Tin	2 bathrooms 4 kitchen sinks 4 mop sinks	BLDG
2	12670 WEST GEAUGA PLAZA			CuPb<83	Copper	Copper	Unknown	2 bathrooms	BLDG
3	12662 WEST GEAUGA PLAZA			CuPb<83	Copper	Copper	Unknown	1 bathroom 1 kitchen sink	BLDG
4	12660 WEST GEAUGA PLAZA			CuPb<83	Copper	Copper	Unknown	1 bathroom 1 kitchen sink	BLDG
5	12658 WEST GEAUGA PLAZA			CuPb<83	Copper	Copper	Unknown	1 bathroom	BLDG
6	12656 WEST GEAUGA PLAZA			CuPb<83	Copper	Copper	Unknown	1 bathroom 1 mop sink	BLDG
7	12654 WEST GEAUGA PLAZA	LC204	2	CuPb<83	Copper	Copper	Unknown	2 bathrooms	BLDG

Entity: W. Geauga Plaza-W  
 Doc Type: Report  
 Doc Subtype: DDAGW  
 Program: Gaugu  
 County: OH  
 Secondary ID: OH 2860212

**SITE PLAN IDENTIFICATION**

SITE PLAN NUMBER	ADDRESS	SMP ID	TIER SITE	PLUMBING AGE	TYPE OF INTERIOR PLUMBING	TYPE OF SERVICE LINE	TYPE OF SOLDER	FIXTURES IN PREMISES	STRUCTURE TYPE
8	12652 WEST GEAUGA PLAZA (UNIT 1)			CuPb<83	Copper	Copper	Unknown	1 bathroom	BLDG
9	12652 WEST GEAUGA PLAZA (UNIT 2)	LC203	2	CuPb<83	Copper	Copper	Unknown	2 bathrooms 4 sinks	BLDG
10	12650 WEST GEAUGA PLAZA (UNIT 1)			CuPb<83	Copper	Copper	Unknown	2 bathrooms	BLDG
11	12650 WEST GEAUGA PLAZA (UNIT 6)			CuPb<83	Copper	Copper	Unknown	None	BLDG
12	12650 WEST GEAUGA PLAZA (UNIT 2)	LC202	2	CuPb<83	Copper	Copper	Unknown	2 bathrooms 1 mop sink	BLDG
12	12650 WEST GEAUGA PLAZA (UNIT 3-5)			2016	PVC	Copper	Unknown	4 bathrooms 1 kitchen sink 1 mop sink	BLDG
13	12646 WEST GEAUGA PLAZA			CuPb<83	Copper	Copper	Unknown	None	BLDG
14	12644 WEST GEAUGA PLAZA	LC201	2	CuPb<83	Copper	Copper	Unknown	2 bathrooms 1 mop sink	BLDG

WEST GEAUGA PLAZA - MAIN

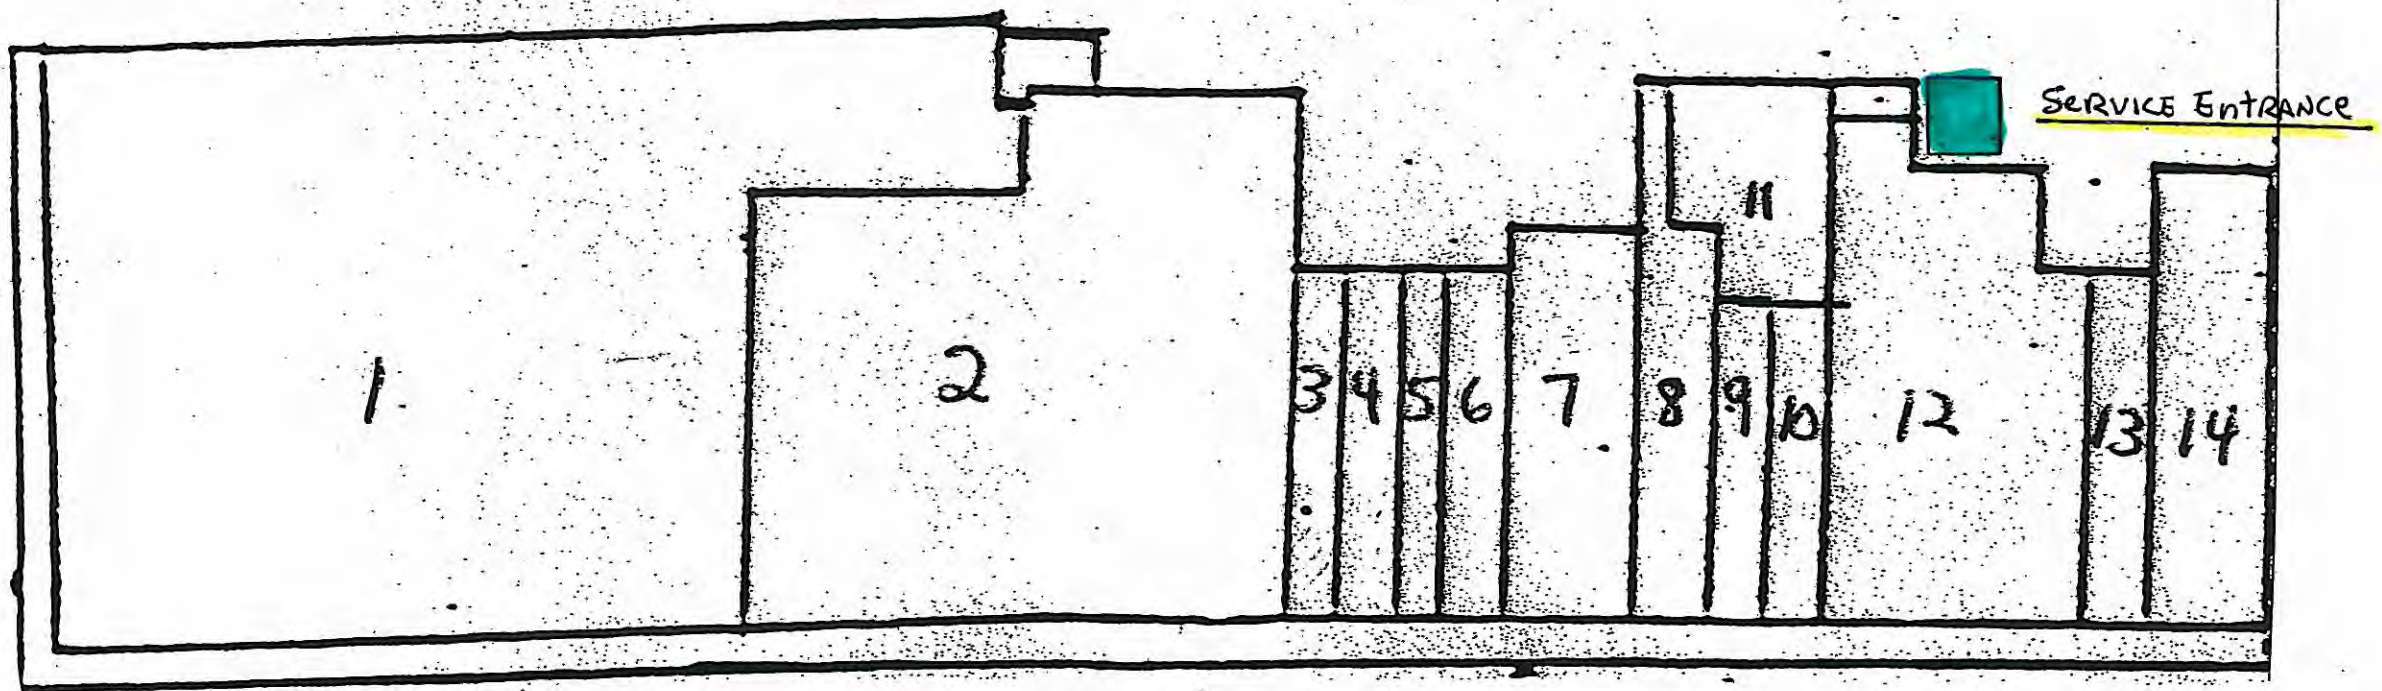

WEST GEUGA PLAZA SHOPPING CENTER

MAYFIELD RD. (S.R. 323)

EXHIBIT B  
SITE PLAN

WEST GEUGA PLAZA - MAIN

CHILlicothe RD. (S.R. 506)

SITE PLAN  
SCALE: 1" = 40'

