


PWSID # 7300903

2017 MAR -9 PM 1:37


Scioto Water, Inc.

Lead Service Line Mapping and Sampling Report

March 2017

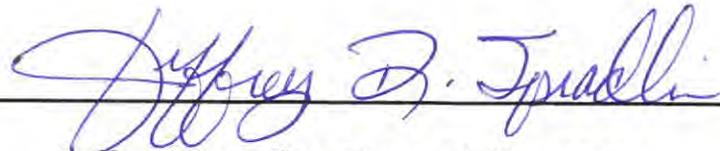

Jeffery Spradlin, General Manager

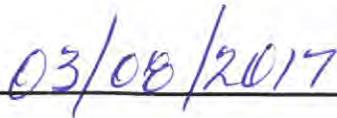

Date

PWSID # 7300903

**Scioto Water, Inc.
Lead Service Line Mapping**

General

The Scioto Water, Inc. (SWI) is a rural not-for-profit water company organized in the late 1960's and provides water service in portions of Scioto, Pike, Jackson, and Lawrence Counties. Scioto Water, Inc. has two treatment facilities and also purchases water from the City of Portsmouth. The distribution system is broken into three distinct service areas which are the Rose Hill, East End, and West End Service Areas. Figure 1.0 -1 provides a general graphical location map of the three services Areas. These areas have been further broken down into zones for purposes of finding lost water.

SWI water distribution mains are not constructed of lead piping or with lead joints.

PWSID # 7300903 is located in the Sugar Camp service area.

Water Company Side of Meter


The lead service line mapping is broken down into two segments. One segment is the SWI company side of the water meter. SWI uses water meters for each customer for flow measurement for billing purposes. The water meters are located in meter pits generally near the highway right-of-way. In 2016, SWI replaced the meters to incorporate a drive-by radio read meter system. The meters that are currently installed for residential users consist of a plastic material.

On the SWI company side of the water meter, SWI installed the service line connecting the water main to the water meter. SWI left approximately 5 feet of service line beyond the water meter for the customer to connect to. None of the service lines installed by SWI consist of lead material.

PWSID # 7300903 does not contain any lead service lines from the water main to the water meter.


The following map(s) depicts the service area for PWSID # 7300903. The color coded map indicates that there are no lead service lines from the water main to the water meter.

Lead =  No Lead =  No Information = 

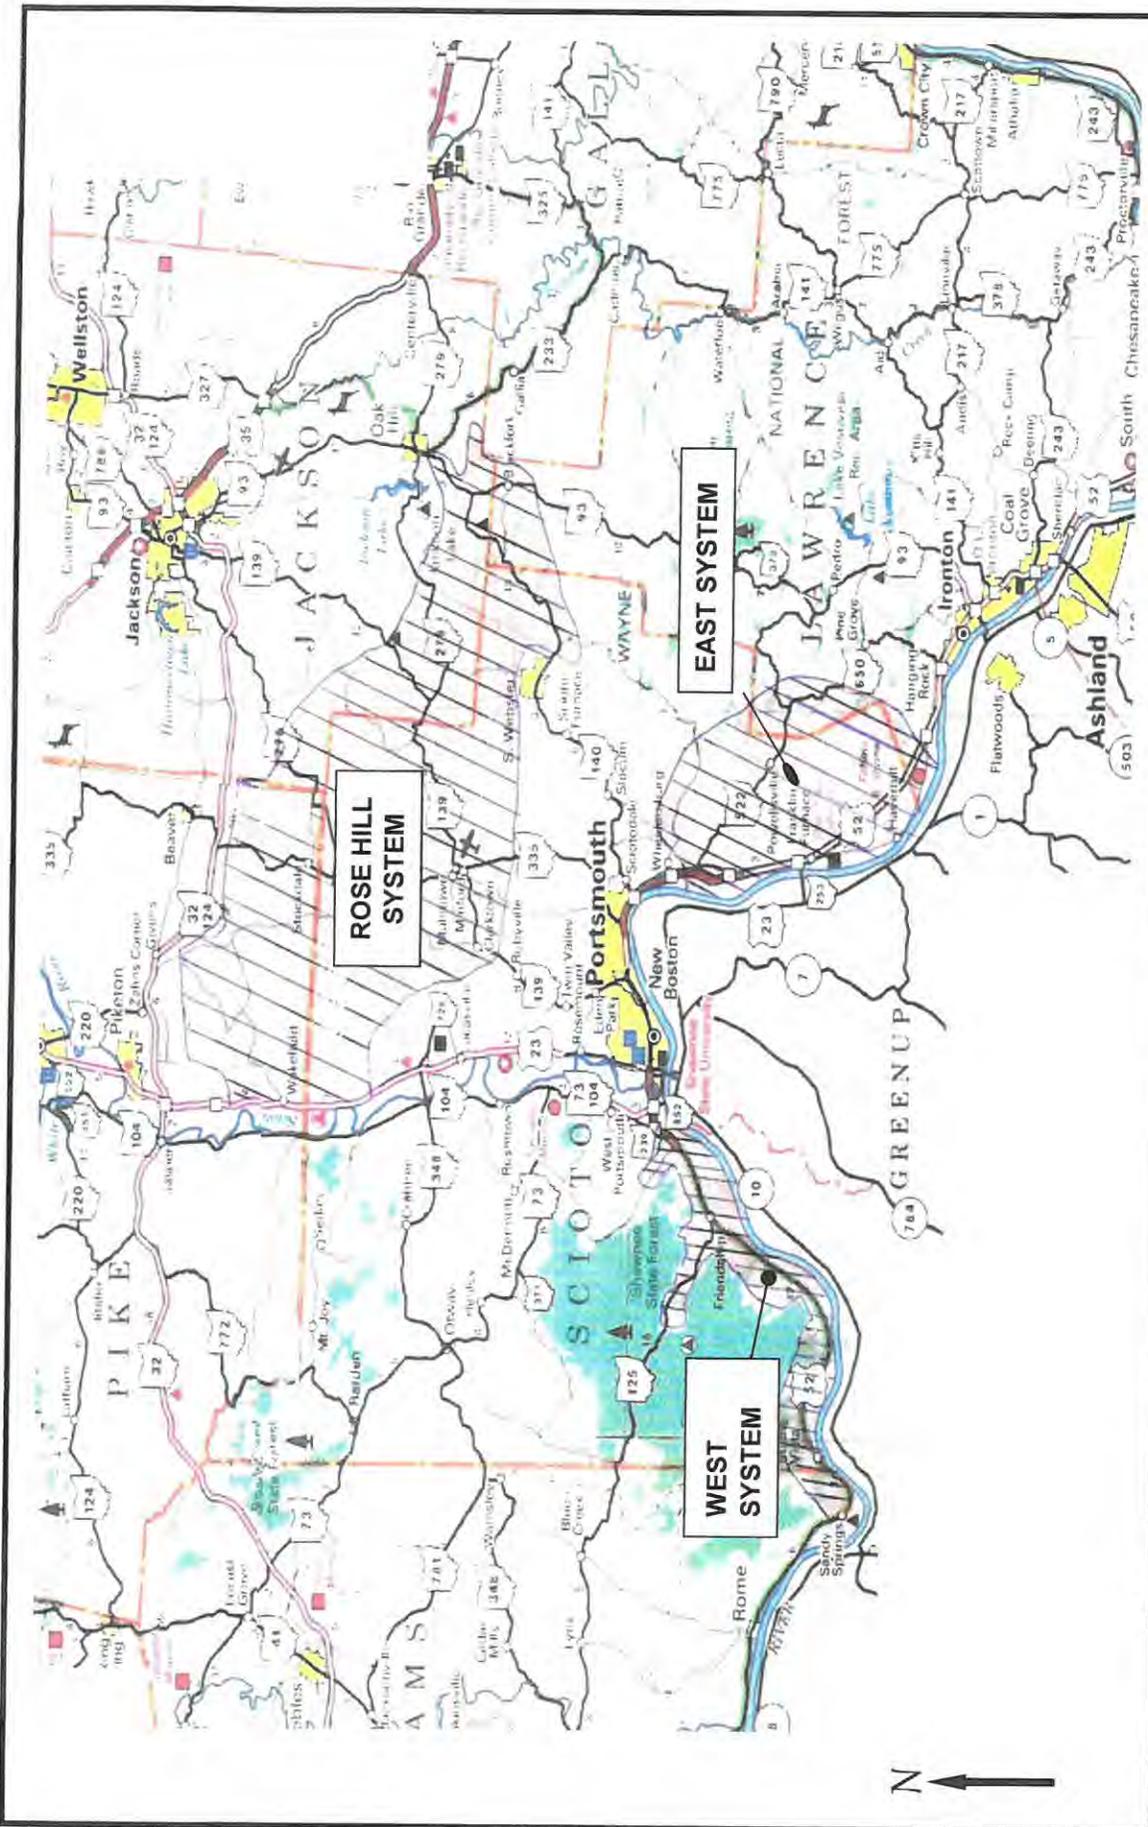

SCIOTO WATER, INC


WATER SYSTEMS GENERAL LOCATION MAP

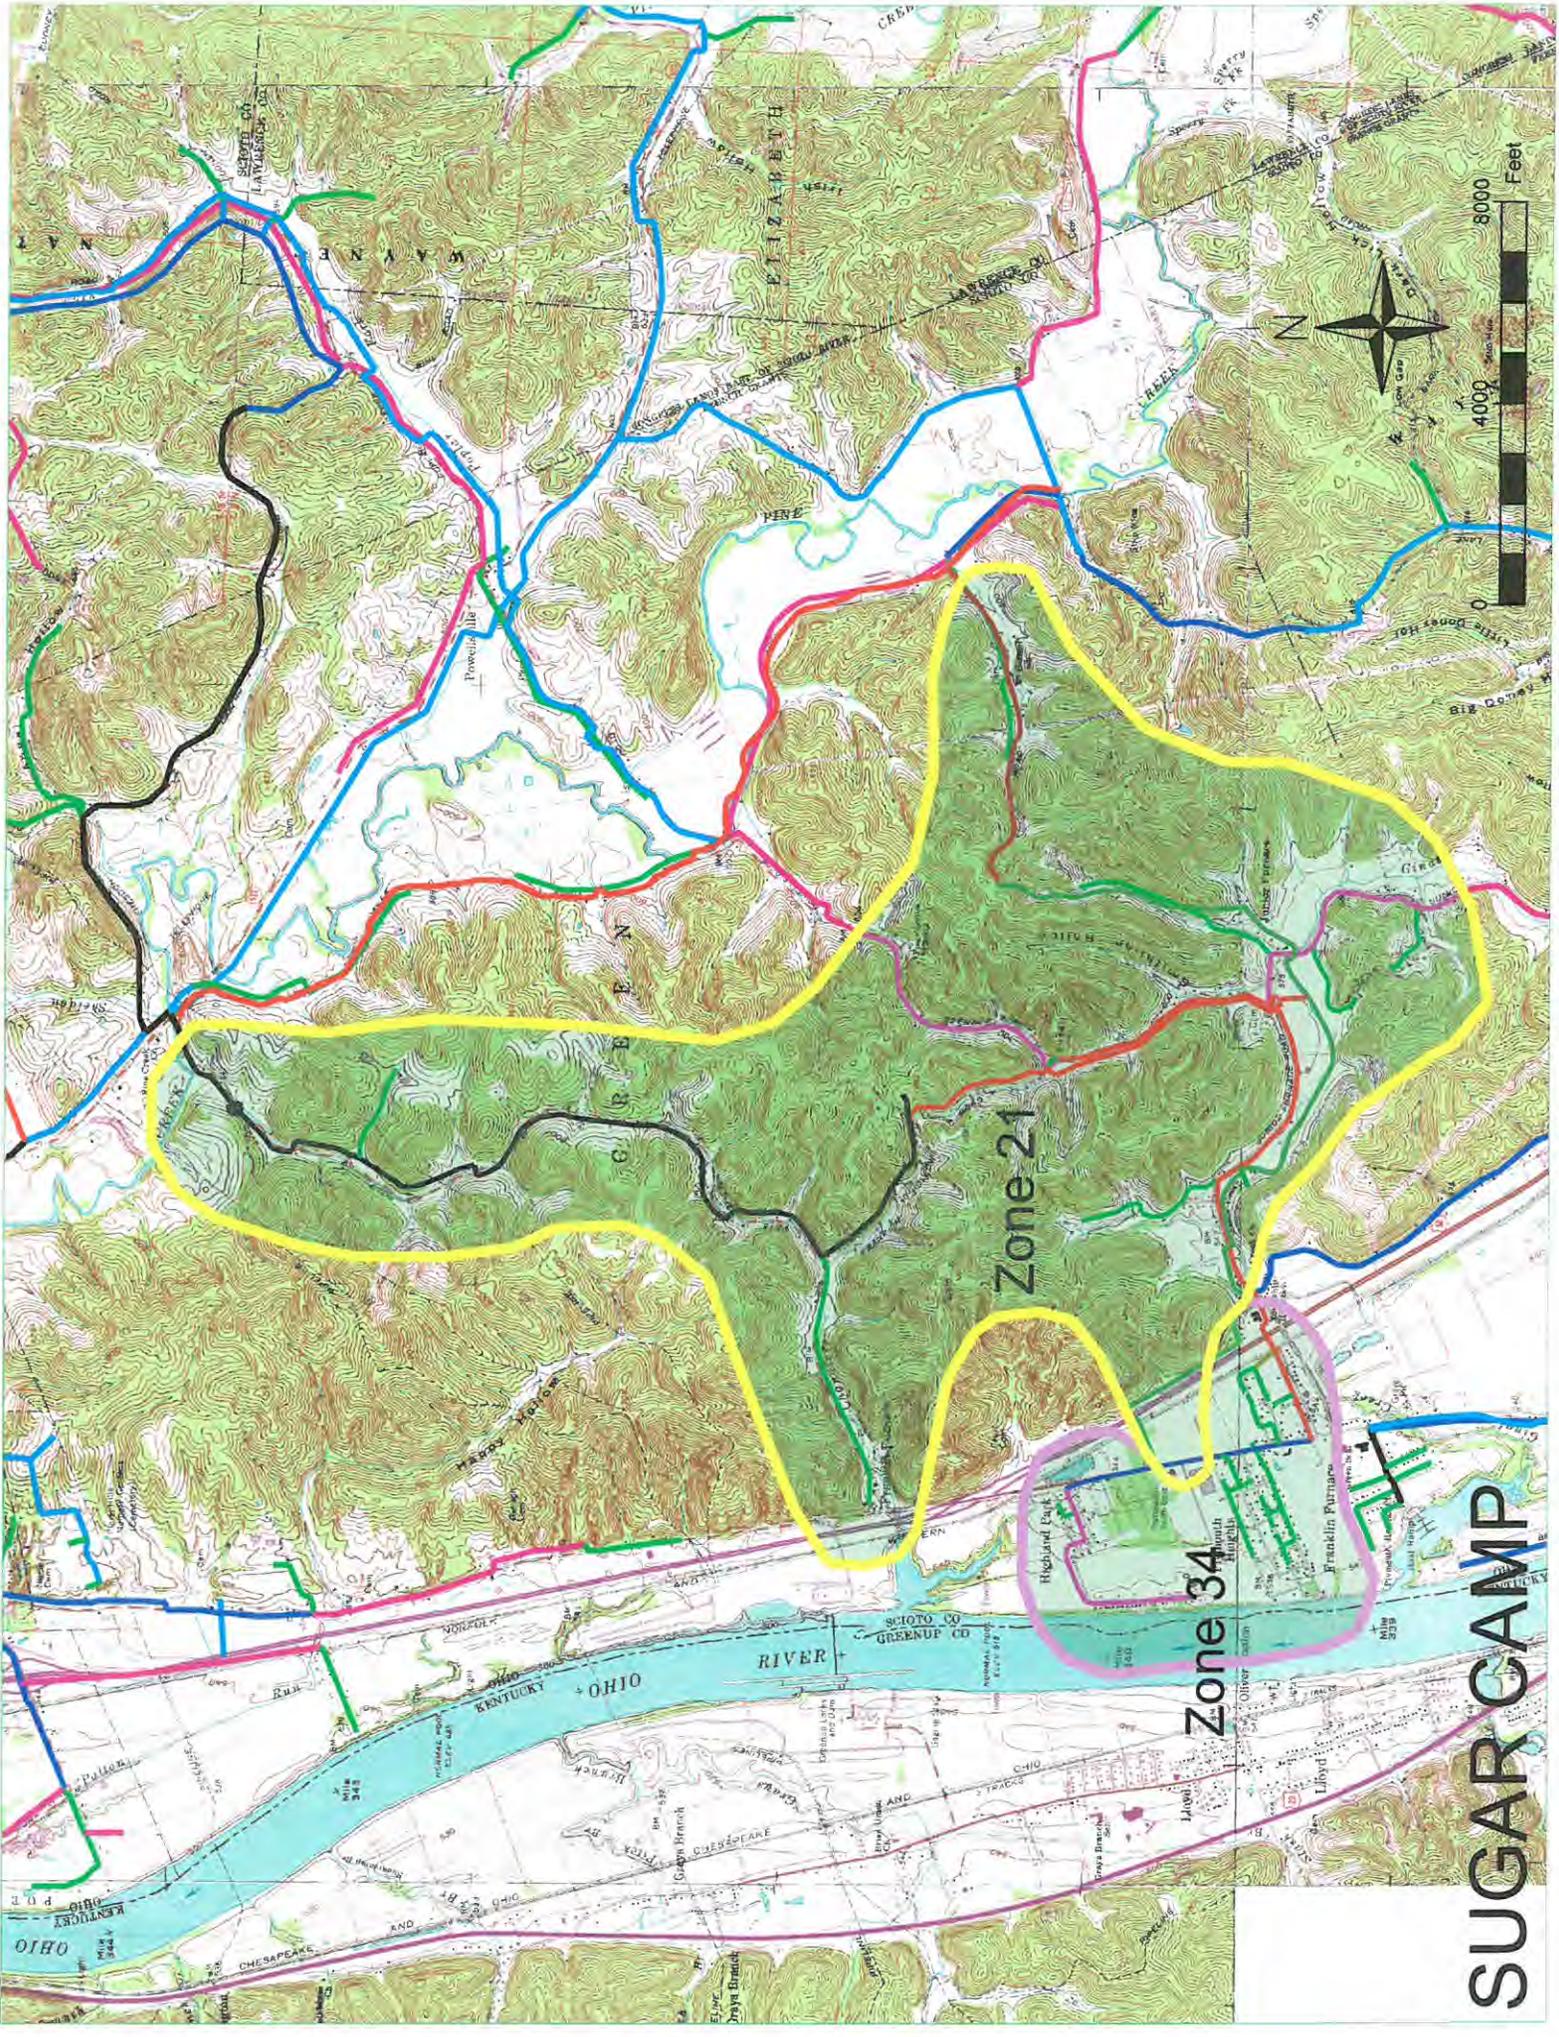

Zone 21

Zone 34

SUGAR CAMP

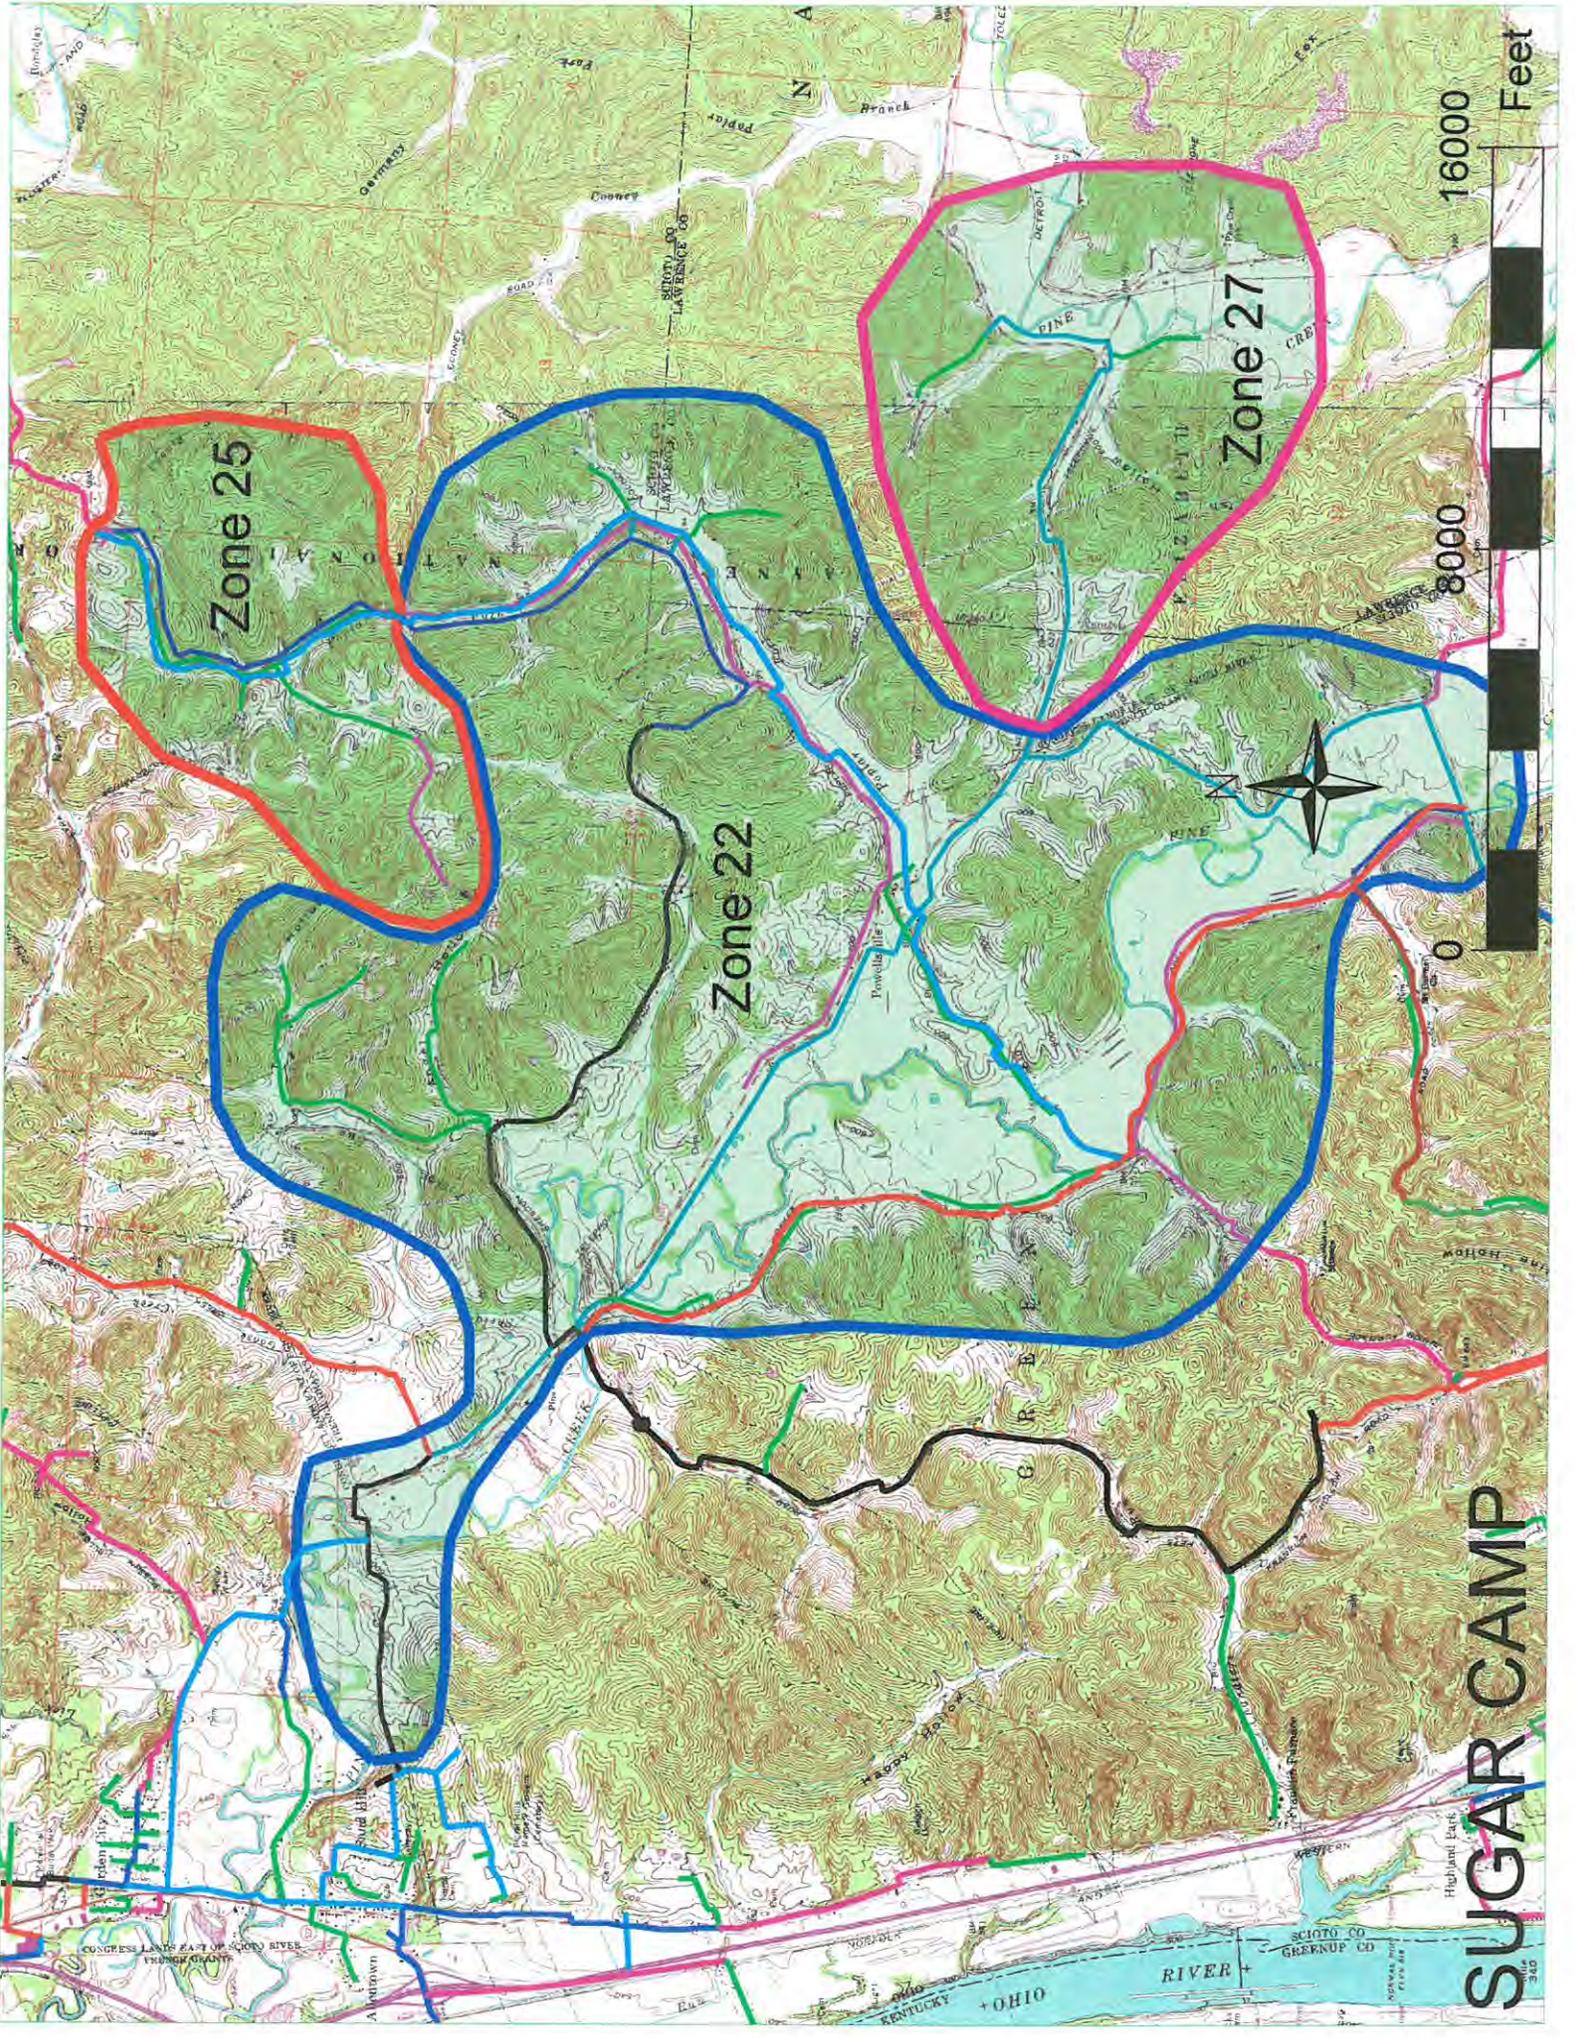

Zone 25

Zone 22

Zone 27

SUGAR CAMP

Feet

16000

8000

0

OHIO

KENTUCKY

SCIO TO CO
GREENUP CO

RIVER

Highland Park

Western




























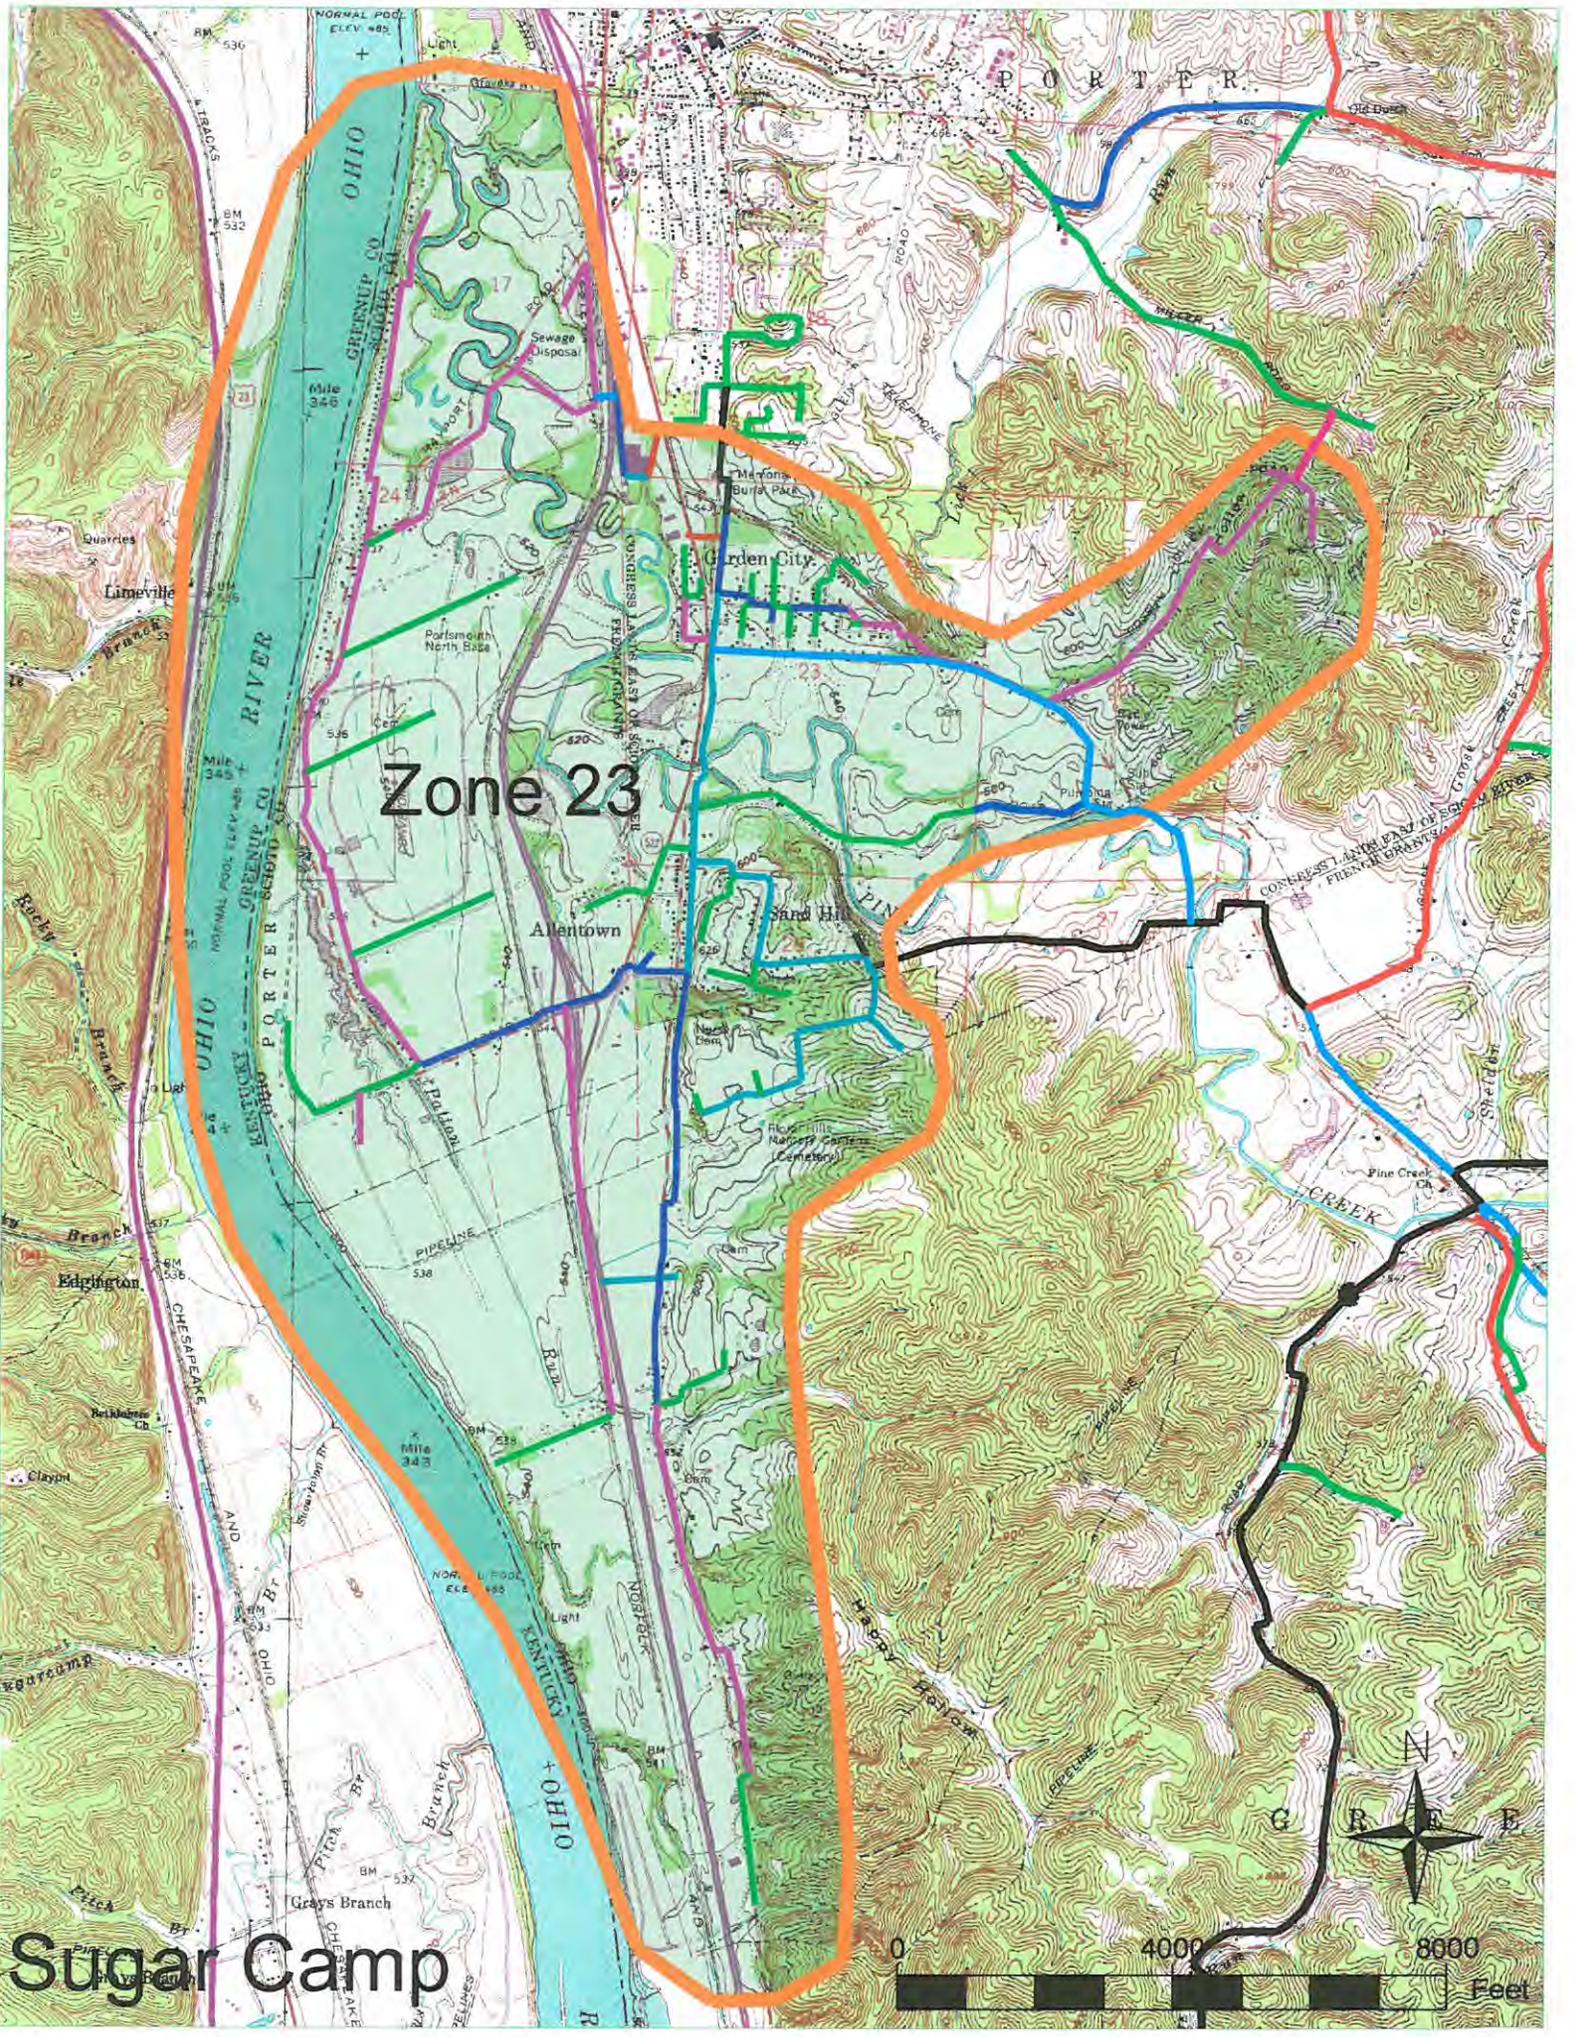

Zone 23

Sugar Camp



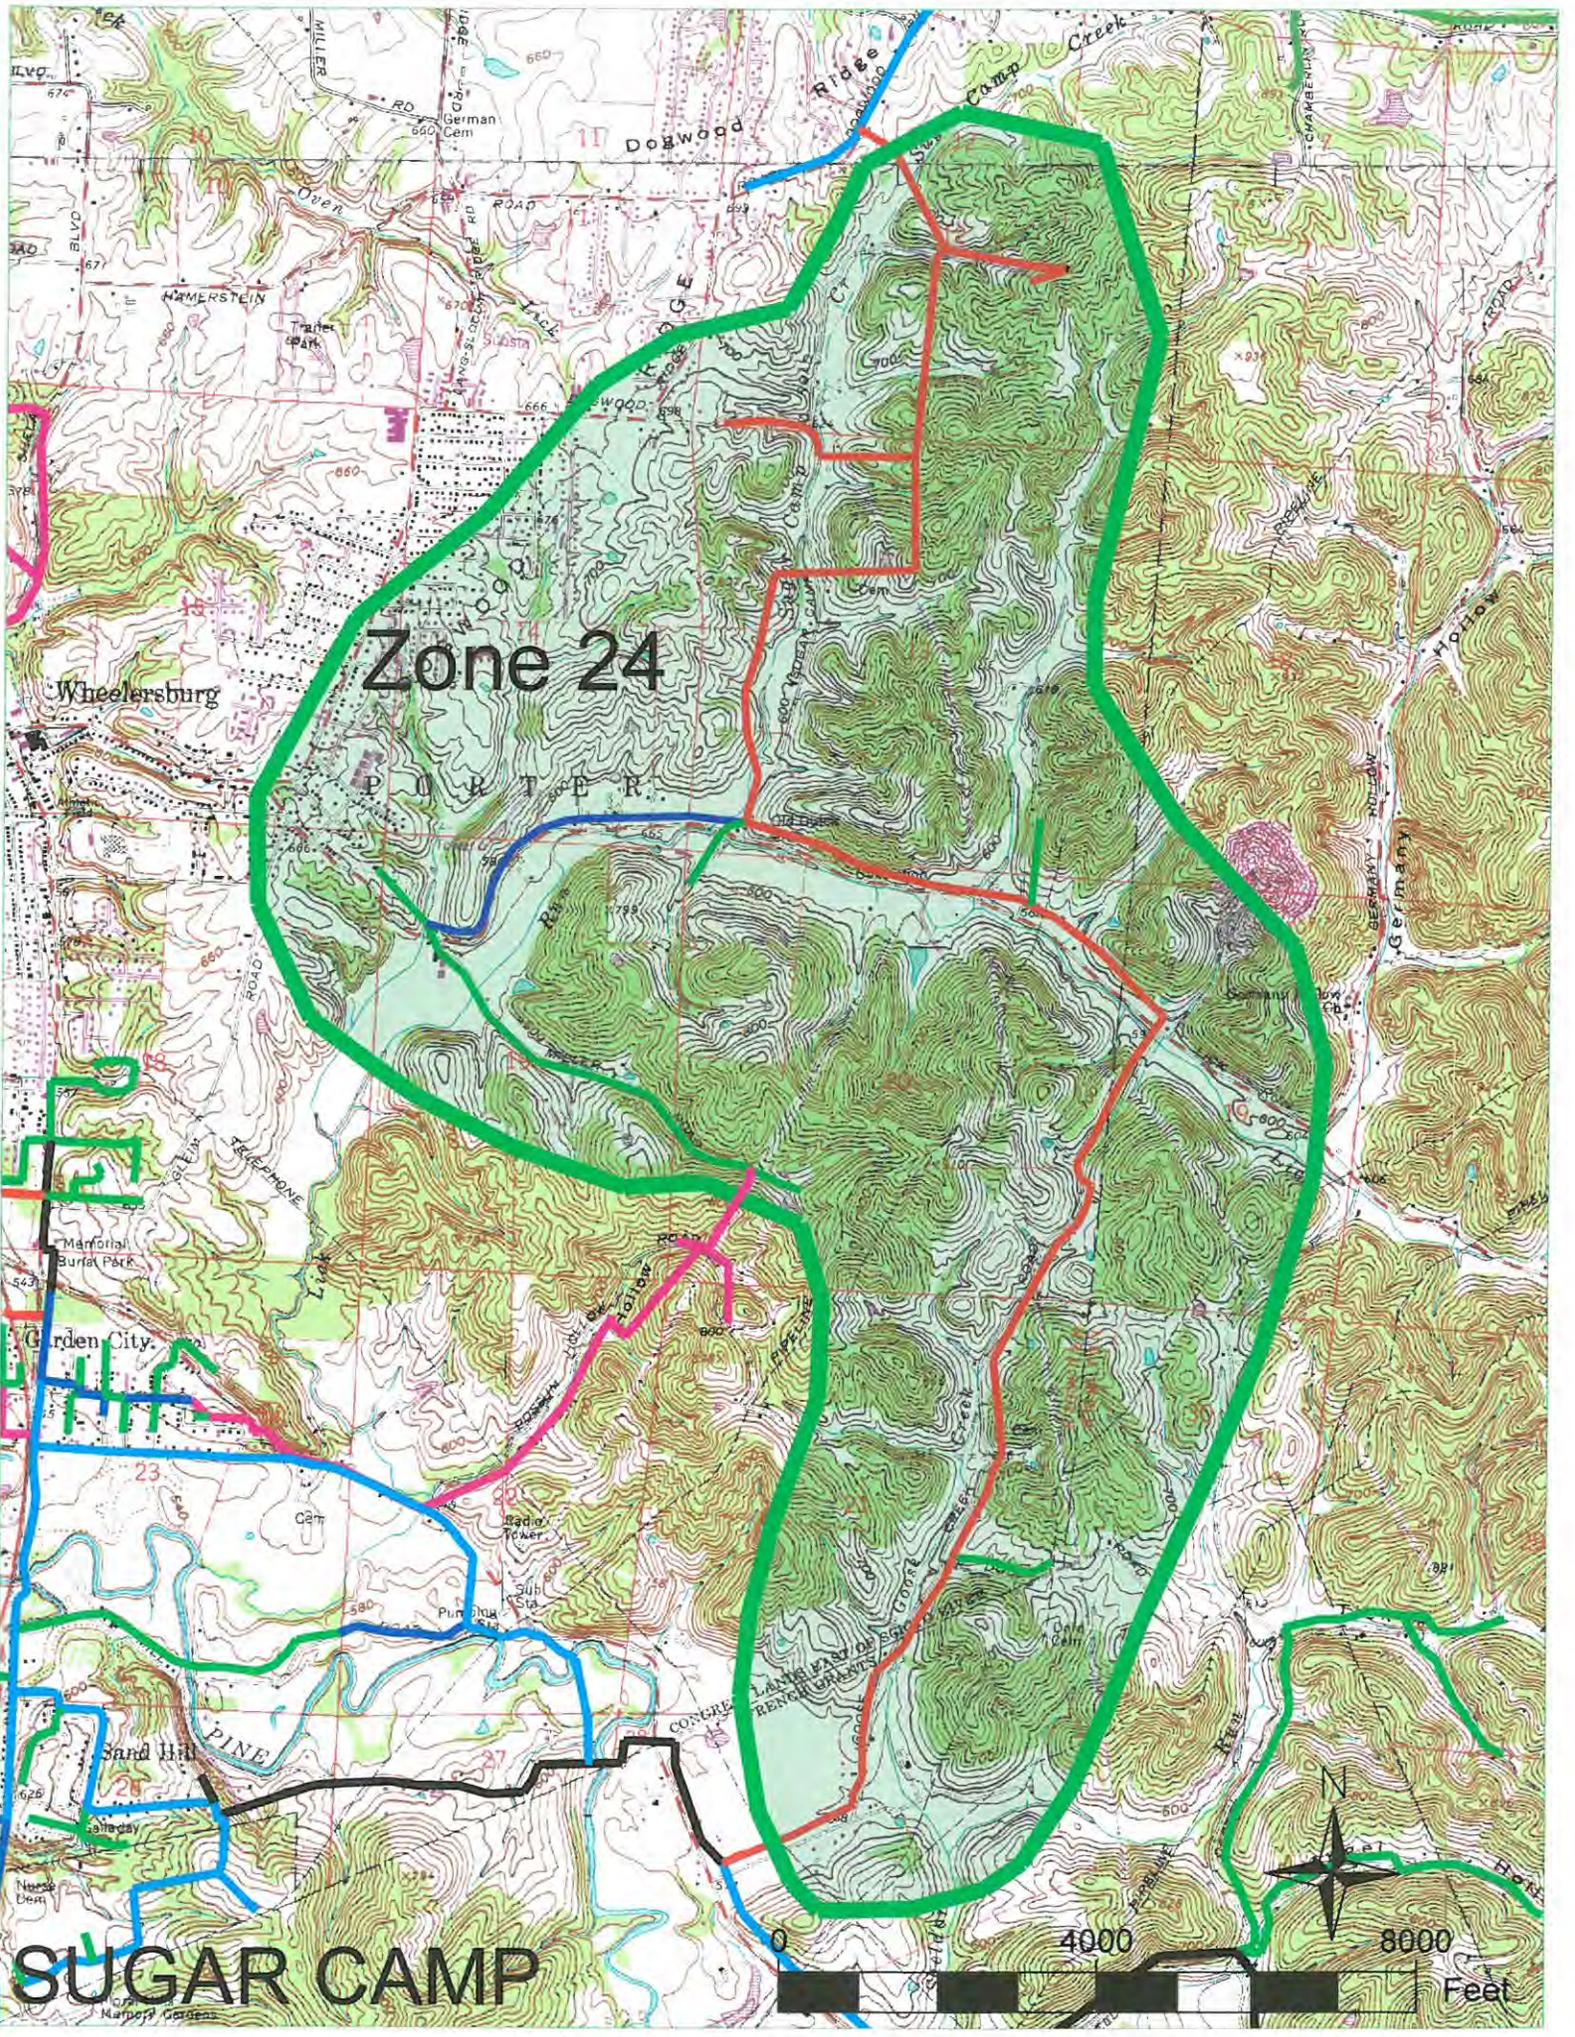

Zone 24


Wheelerburg

P O R T E R

Garden City

SUGAR CAMP



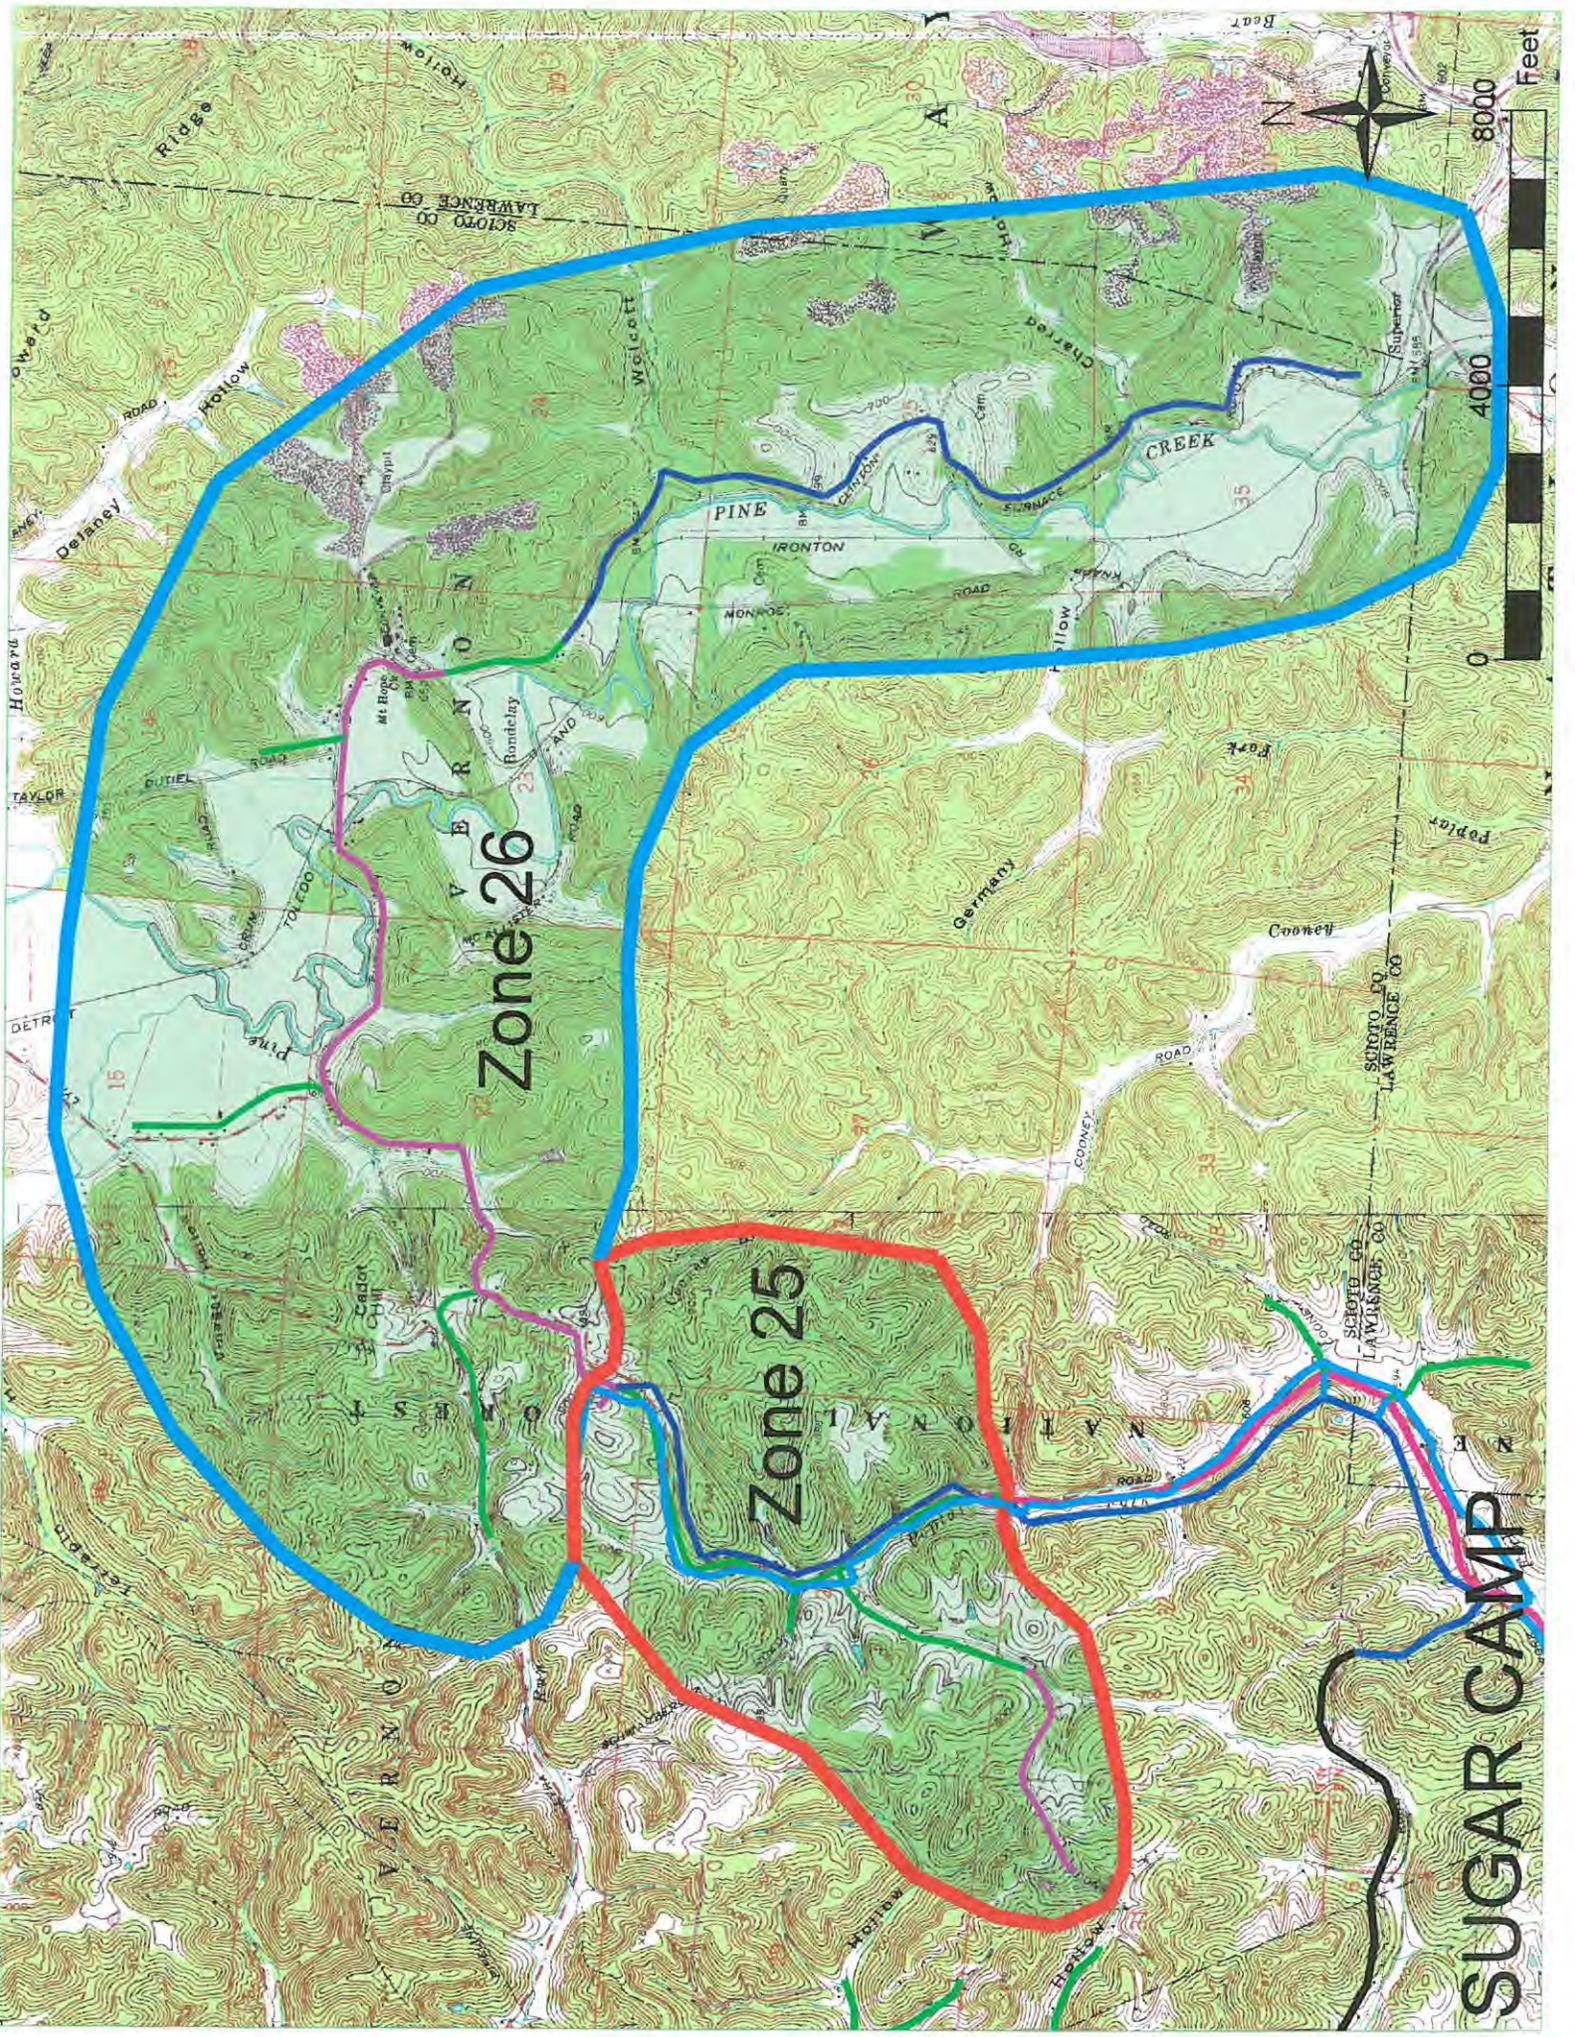



Zone 26

Zone 25

SUGAR CAMP



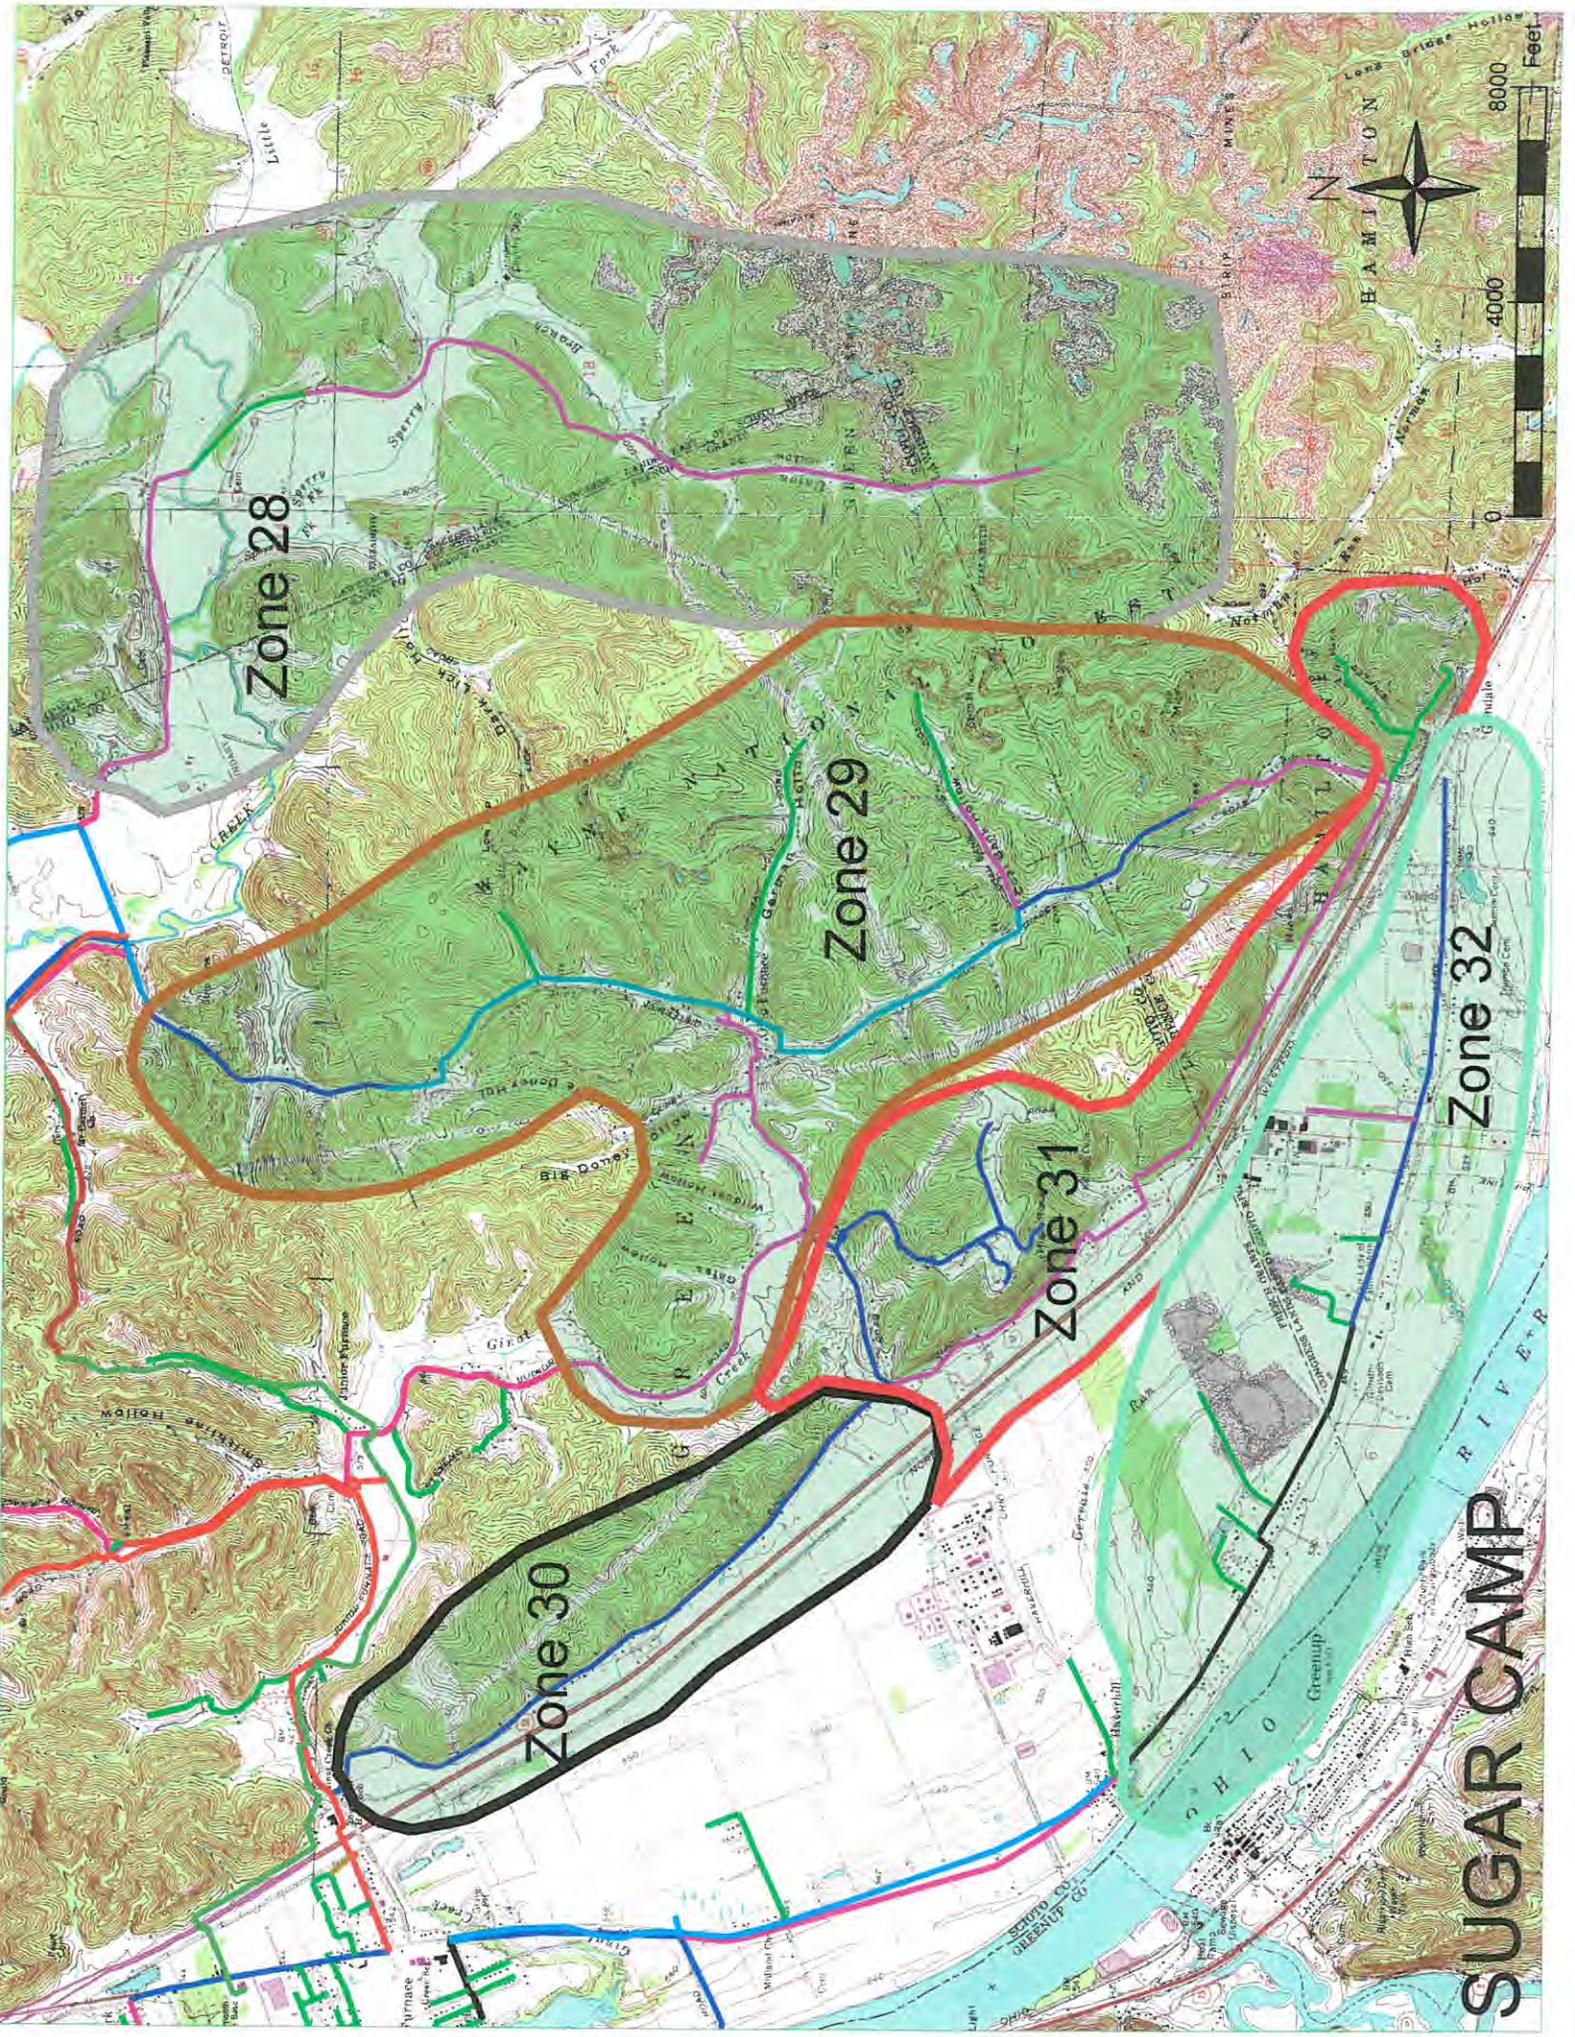

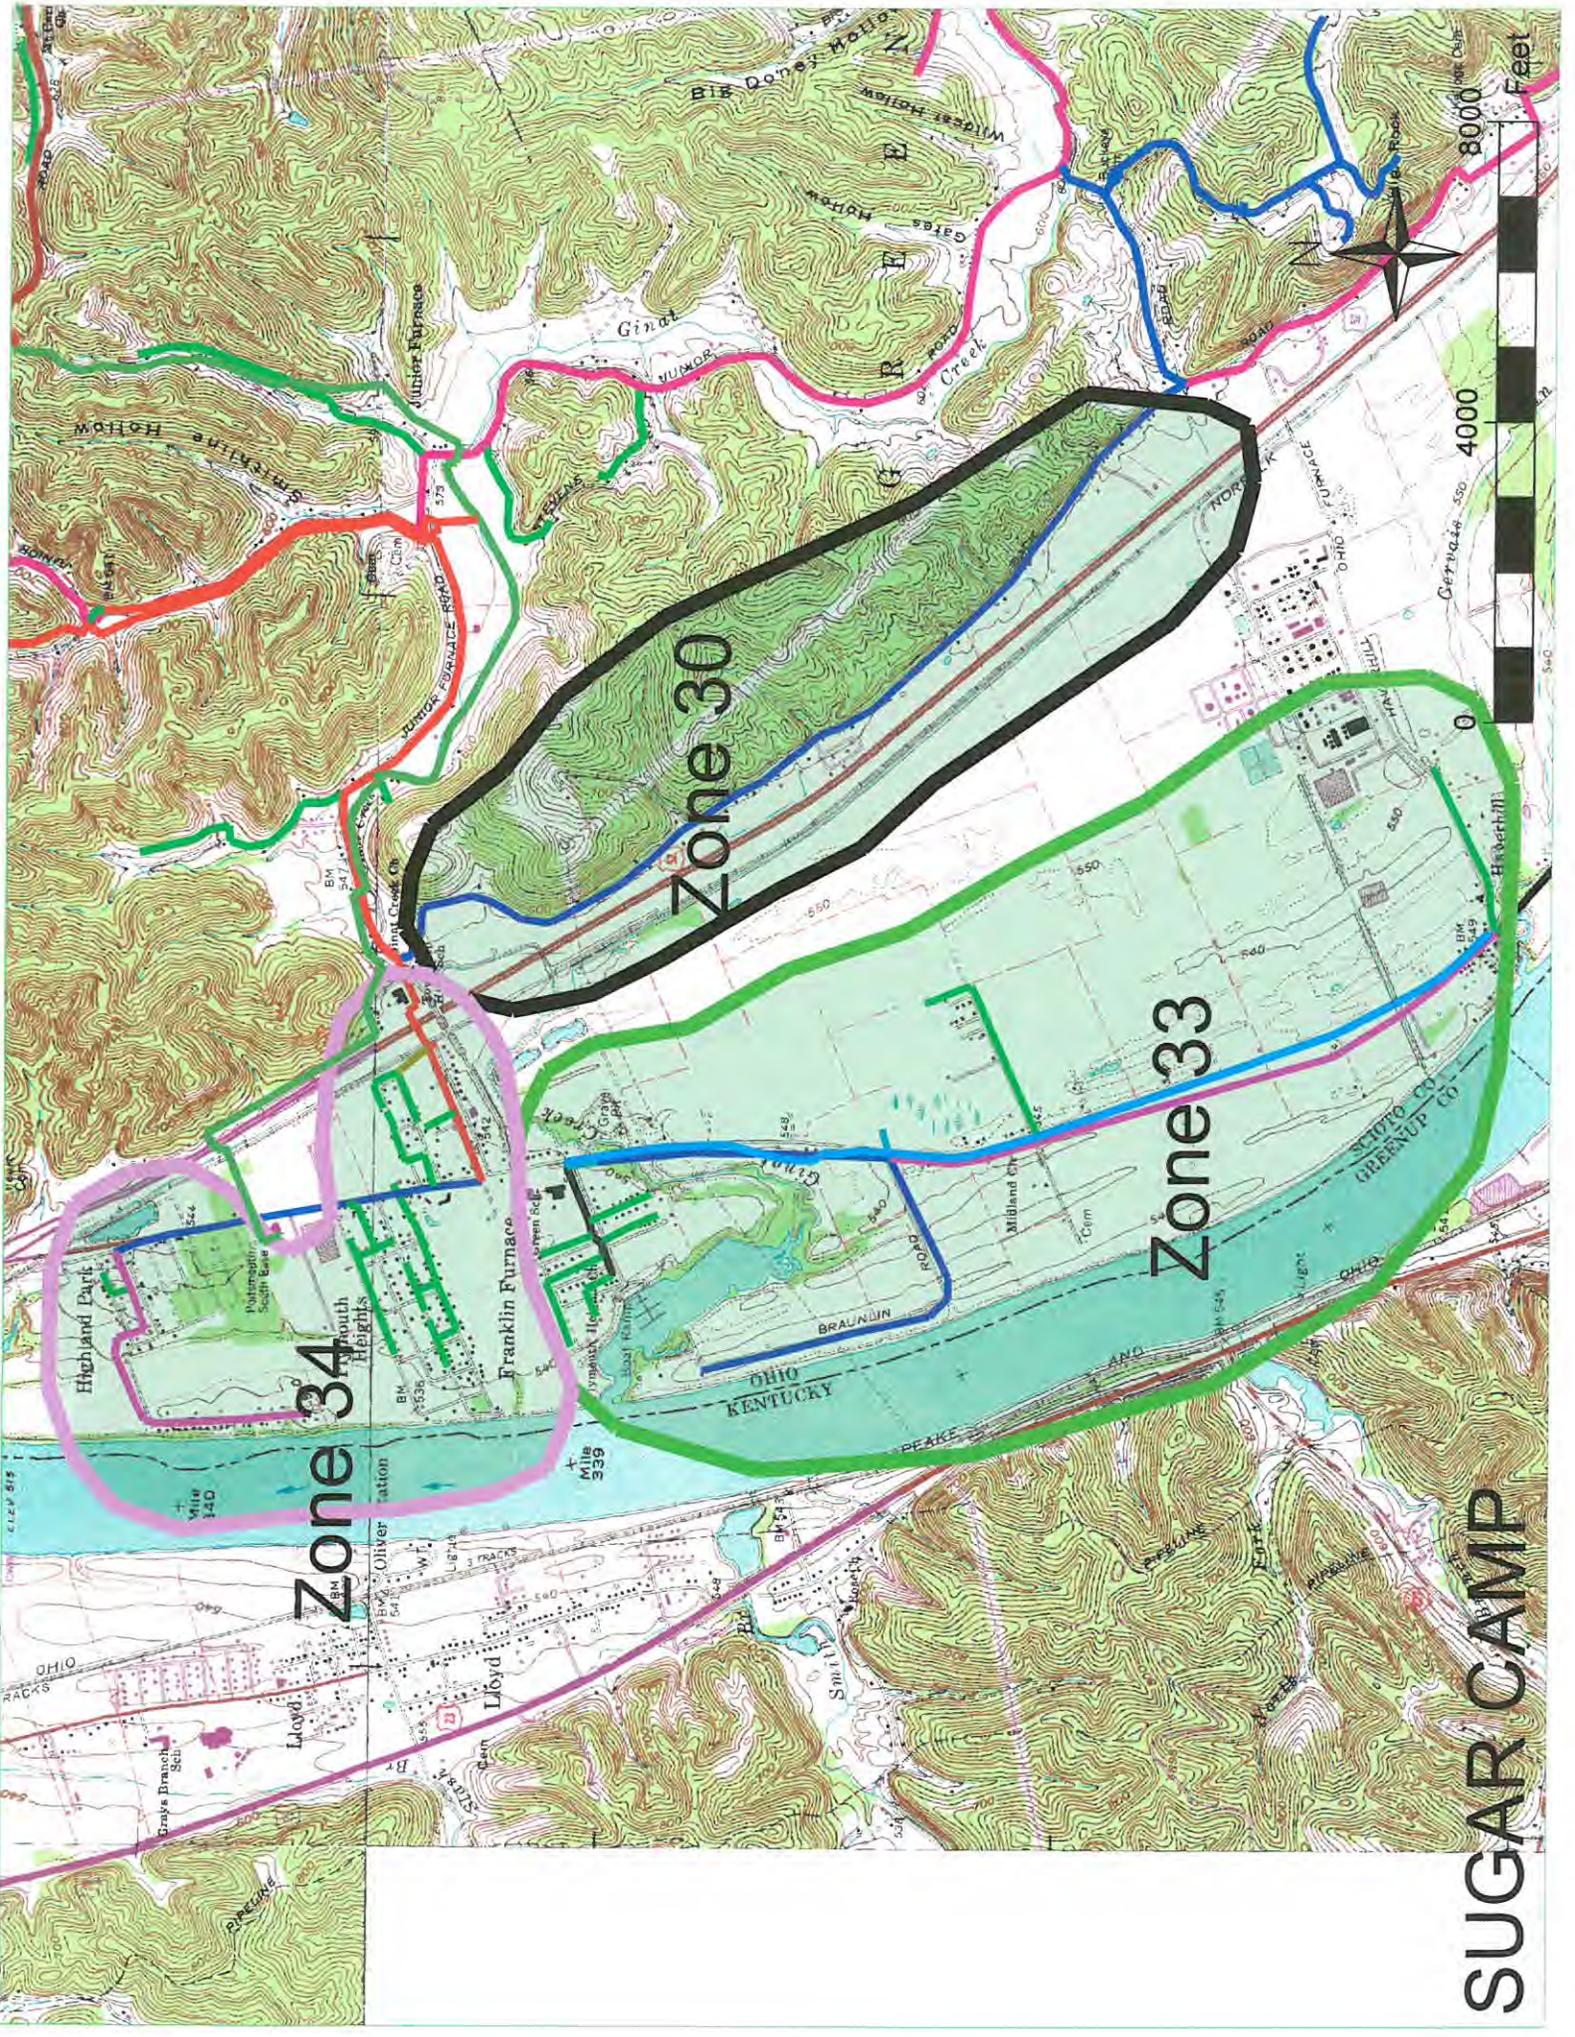

Zone 34

Zone 30

Zone 33

SUGAR CAMP

0 4000 8000 Feet

Customer Side of the Water Meter


After SWI provided the water meter and the service line from the water main to the meter, the customer connected the residence, building, etc. to the water meter. Some of these may have been to existing homes at that time where the property owner switched from a well or cistern to the SWI supplied water. In other cases, new homes or buildings may have been constructed.

PWSID # 7300903 consists of residences, buildings, etc. of various ages. As this is a rural area, newer homes may have been constructed between older existing homes. Nearly all homes in this service area were constructed prior to 2014.

The users in this area should not have lead service lines as connections to the water meter would have been made from approximately 1970 or later. However, they may have fixtures with solder or brass that may contain lead.

The following map(s) indicate the customer side of the meter for the service area for PWSID # 7300903. The map(s) are coded to indicate that it is unknown as to whether any lead products exist for each customer.


Lead =  No Lead =  No Information = 

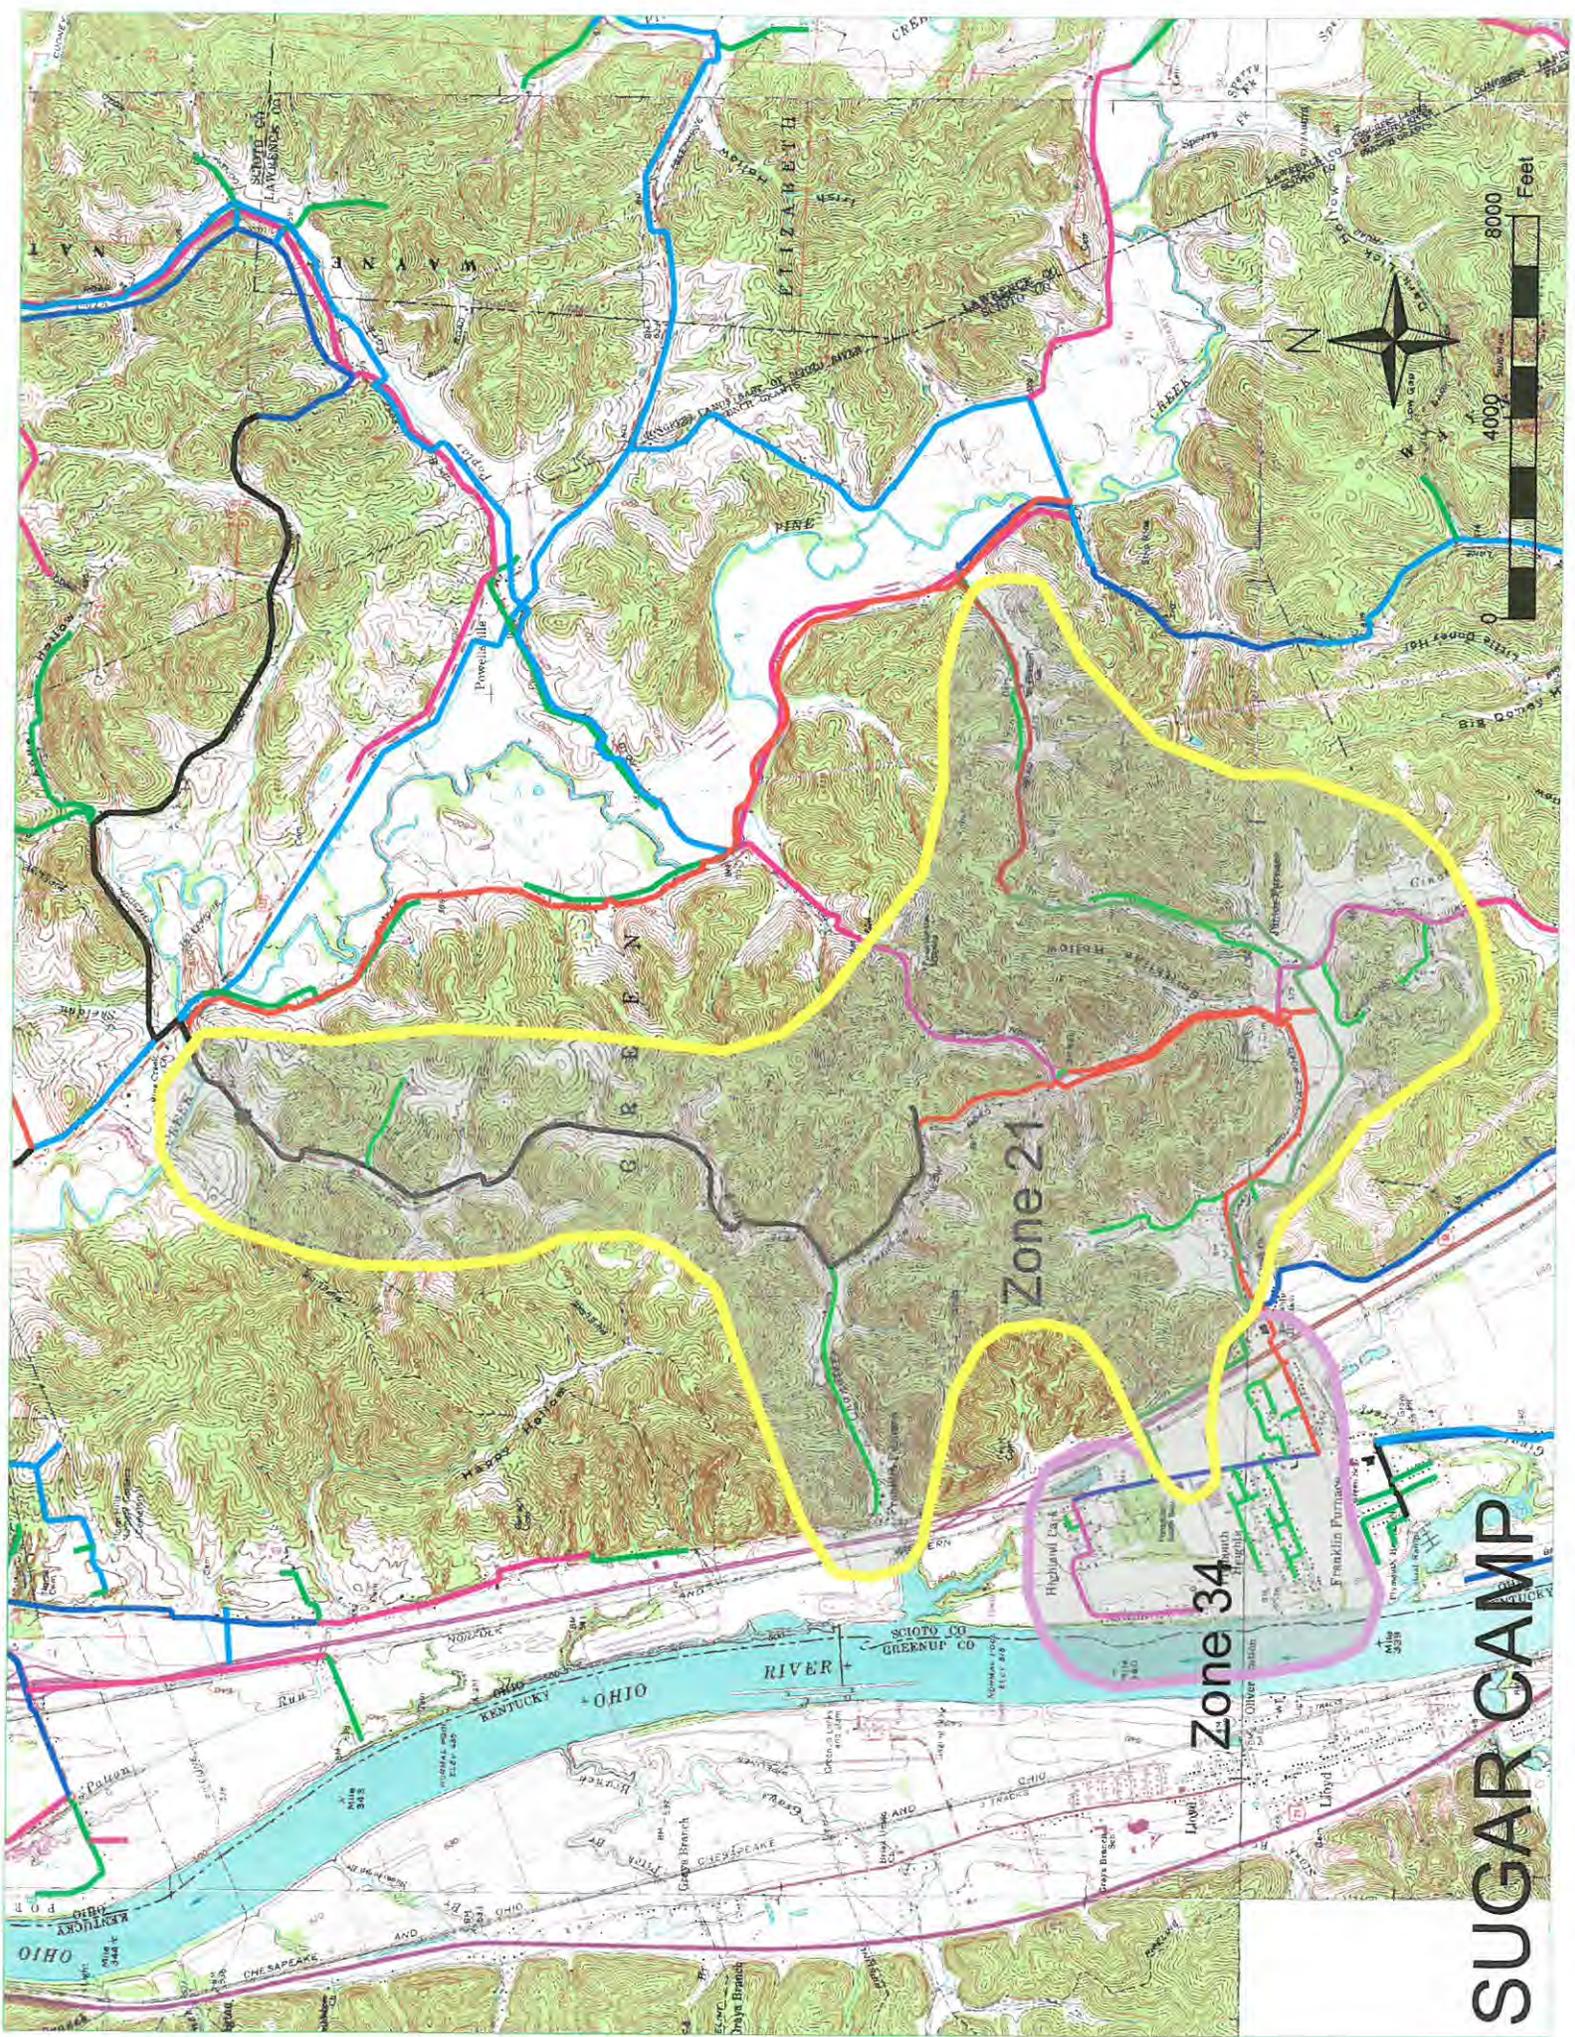


SUGAR CAMP

Zone 21

Zone 34

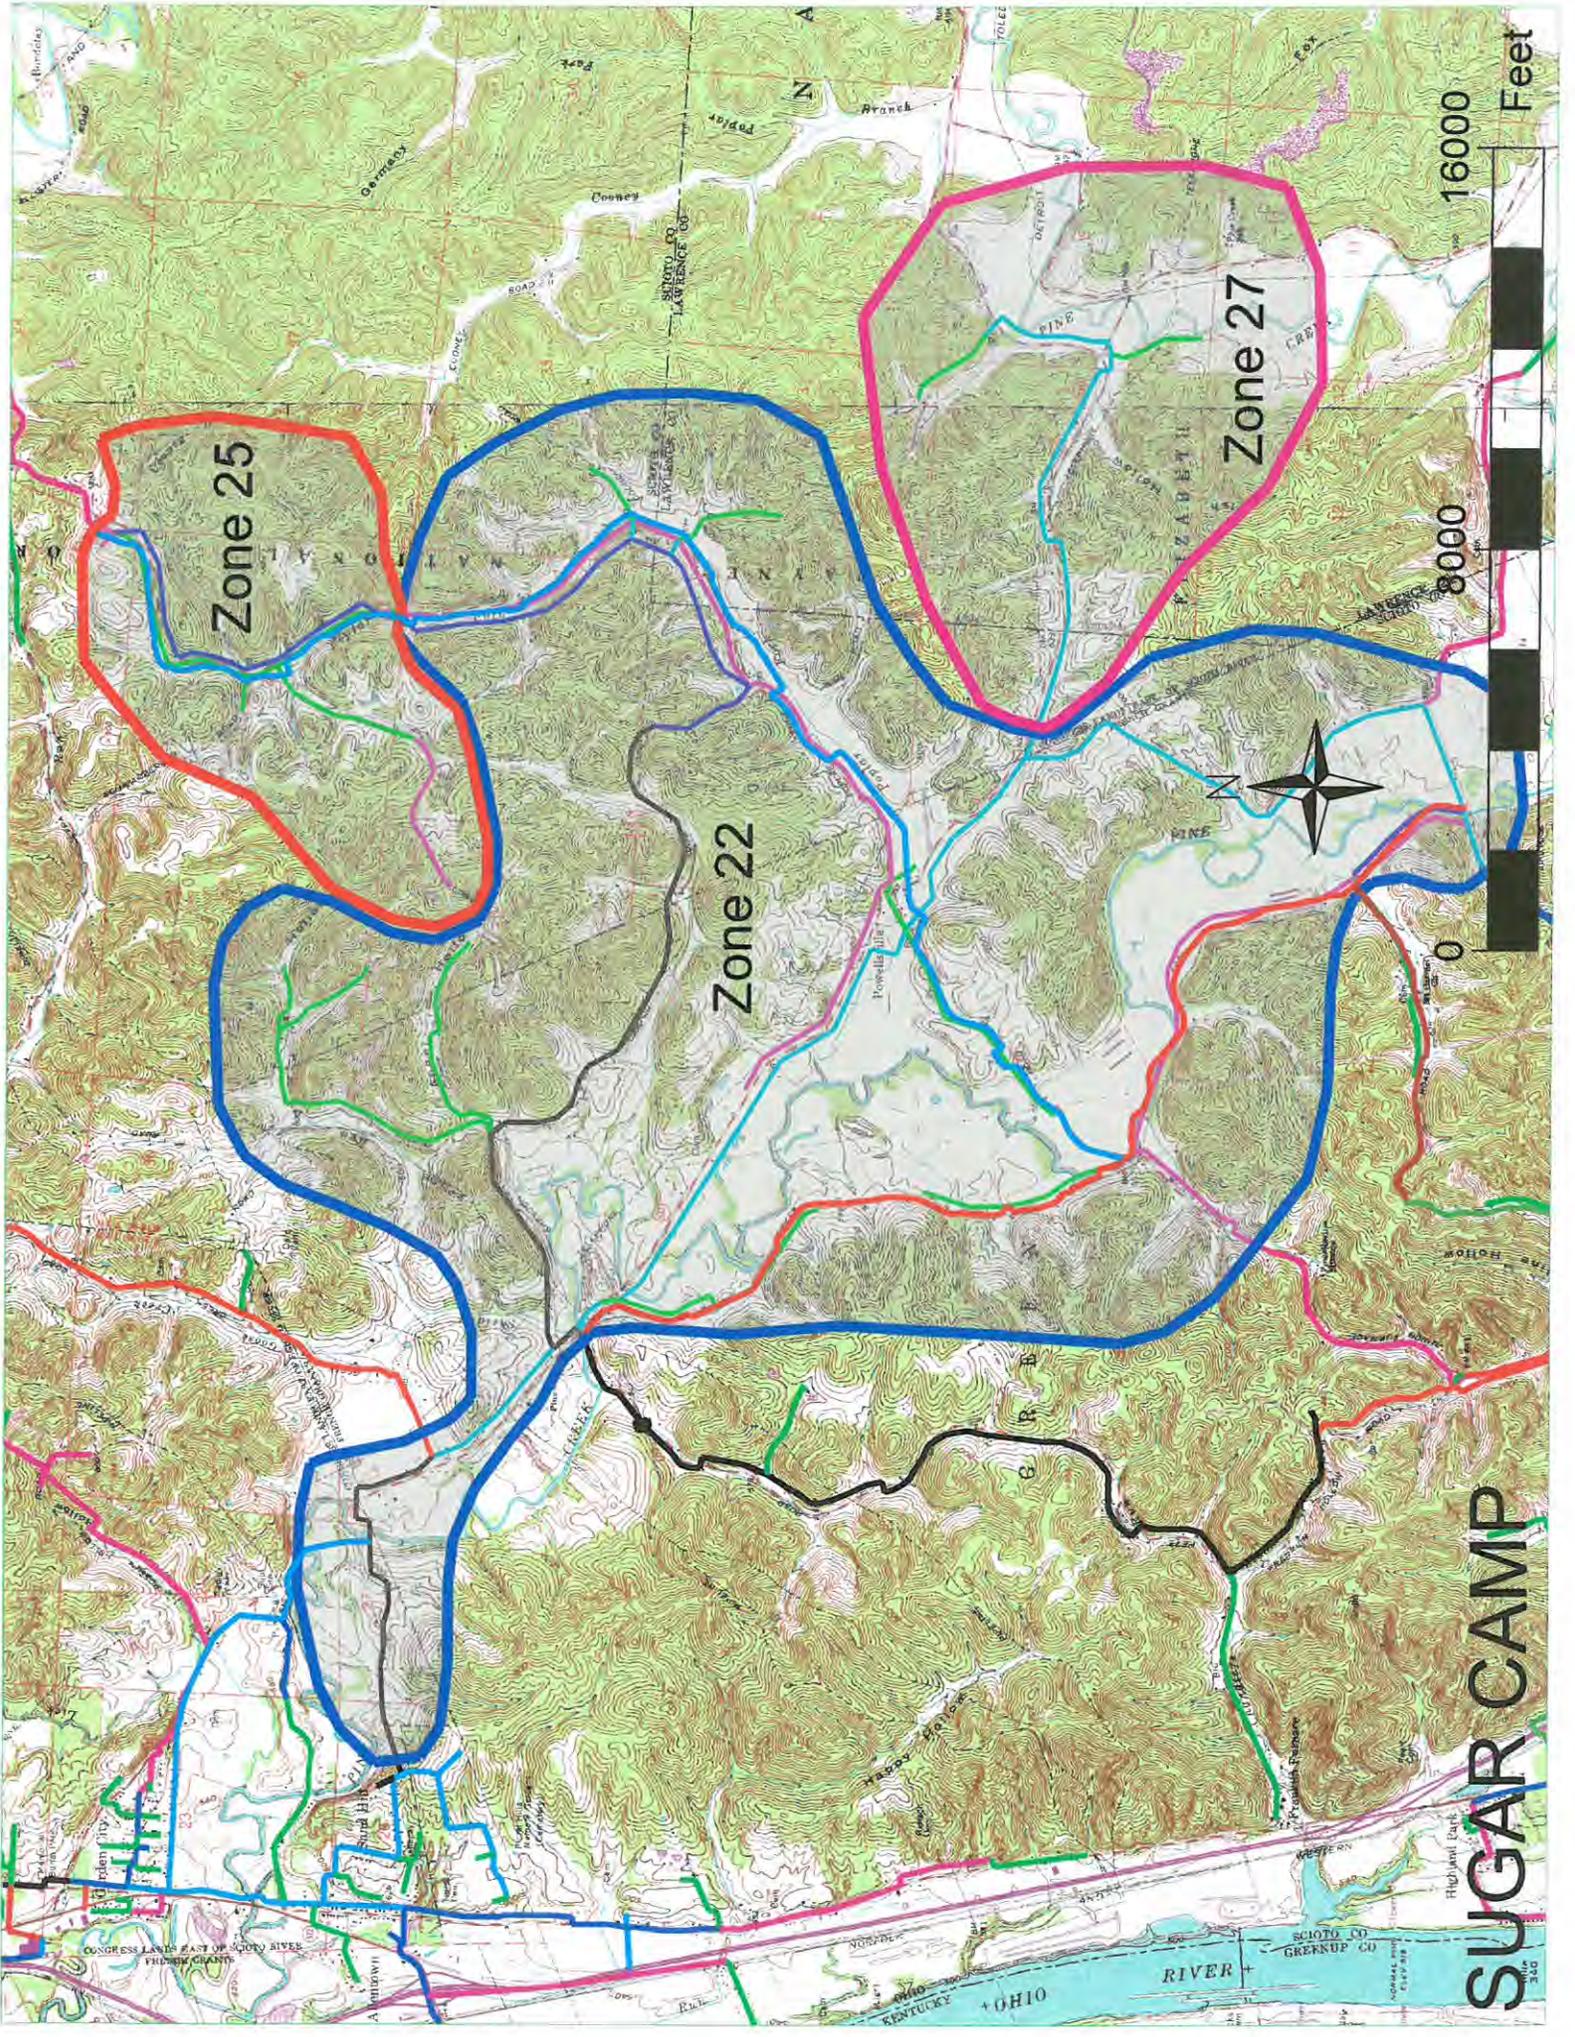


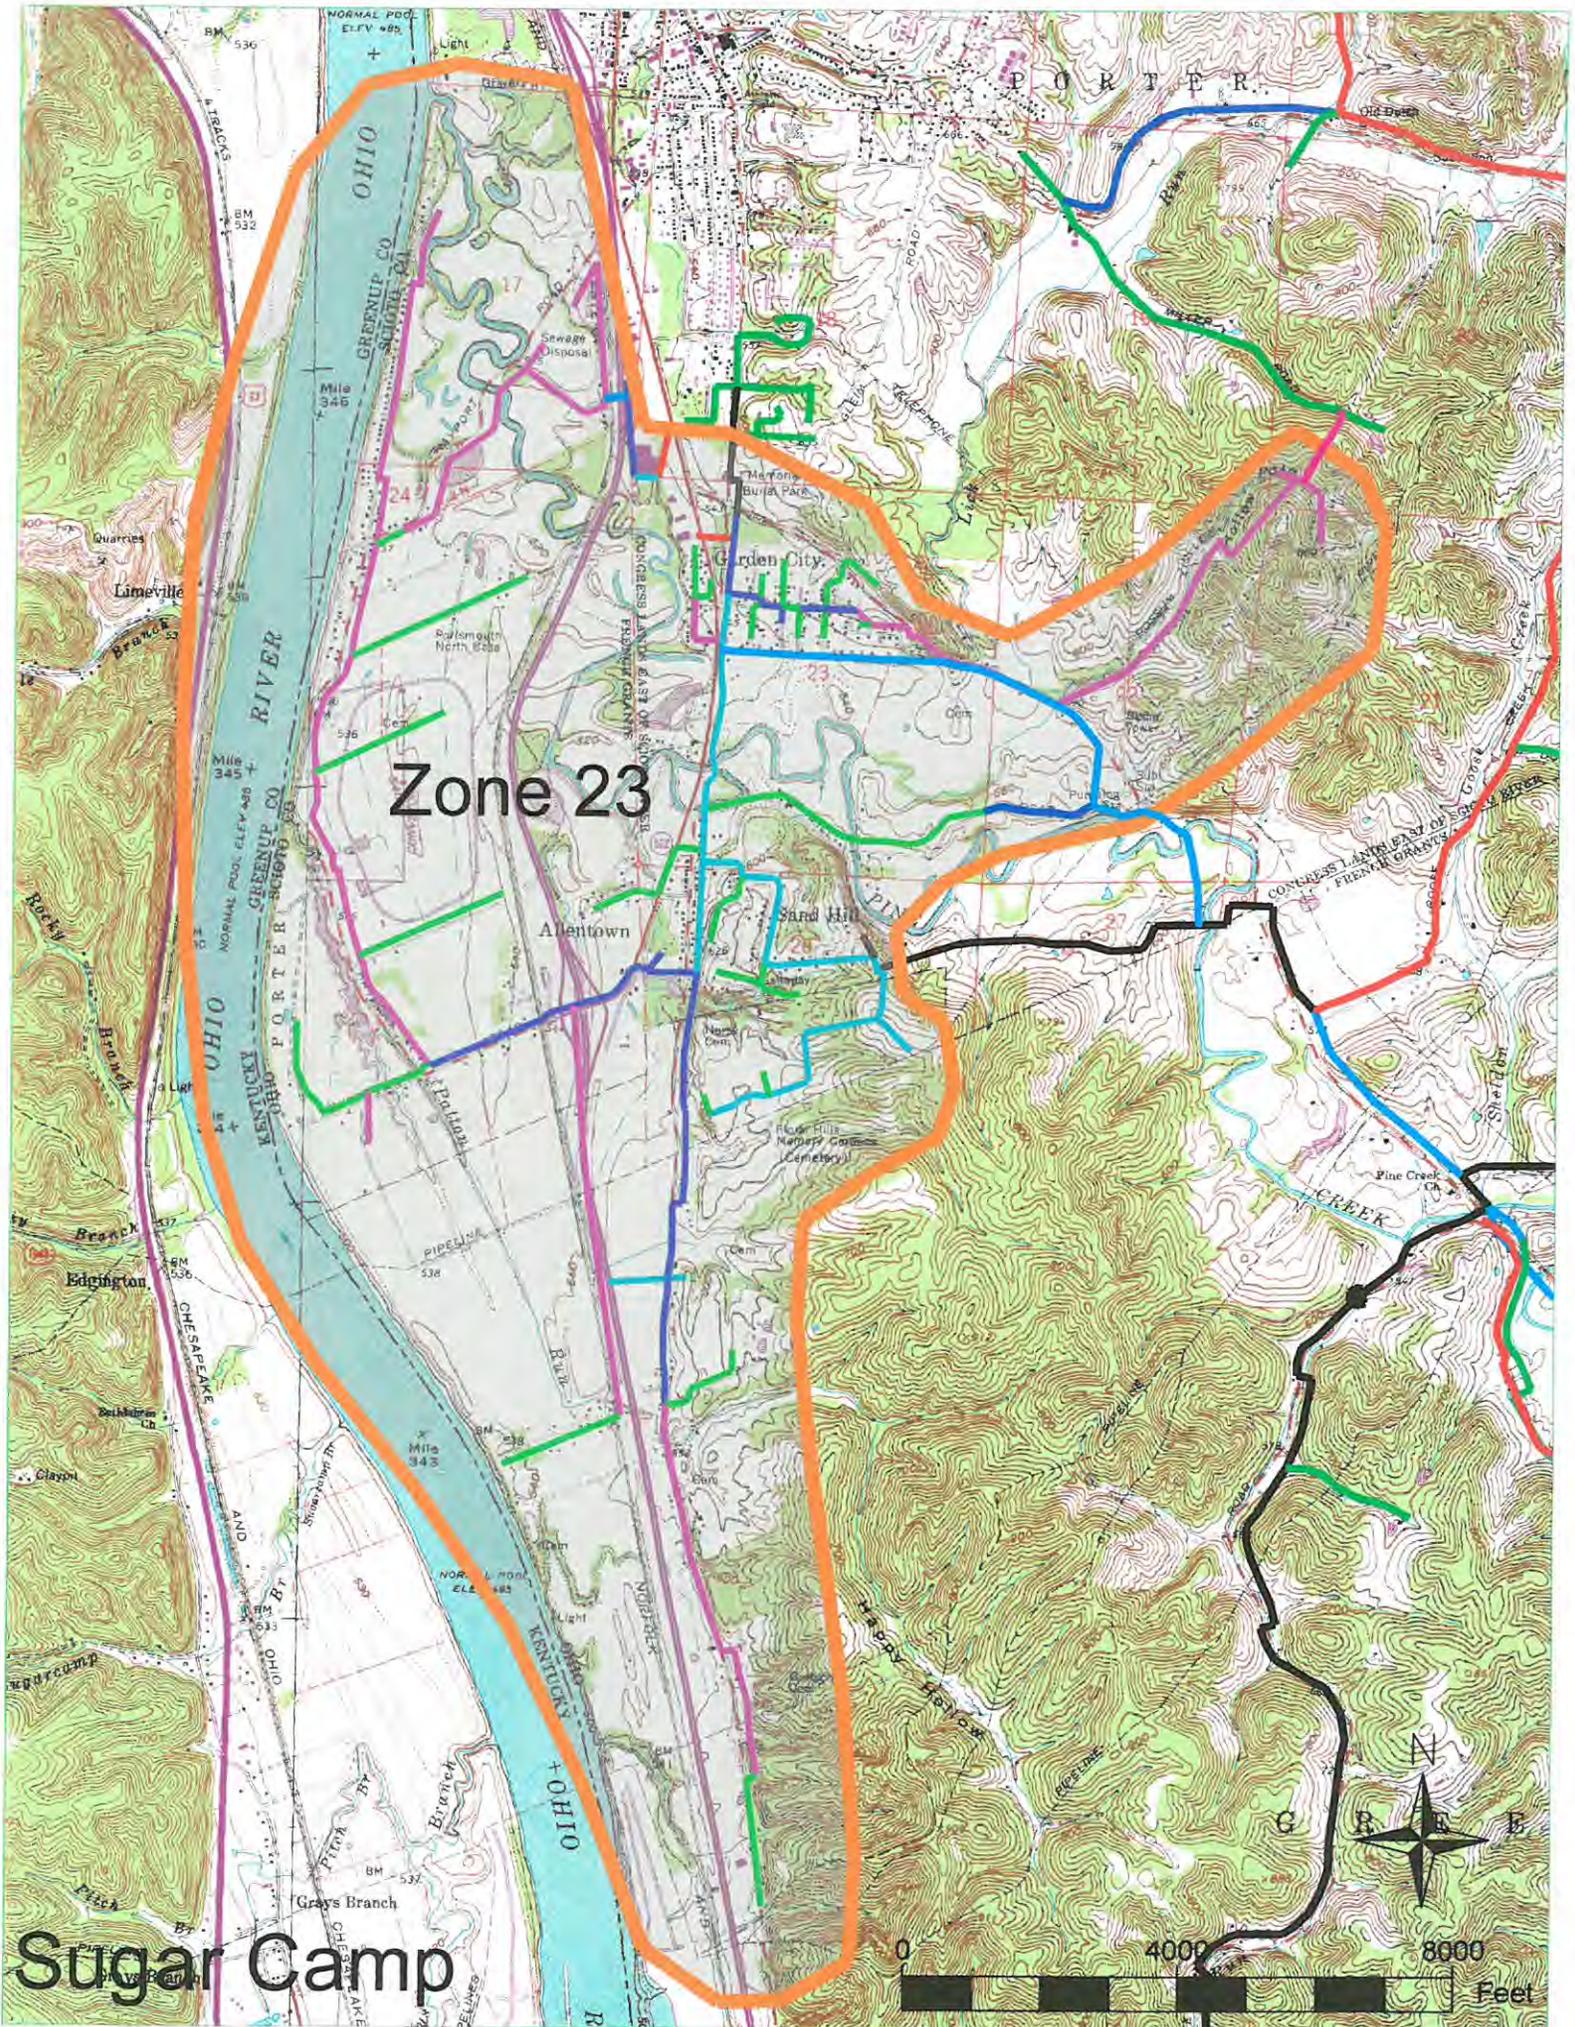

Zone 23

Sugar Camp



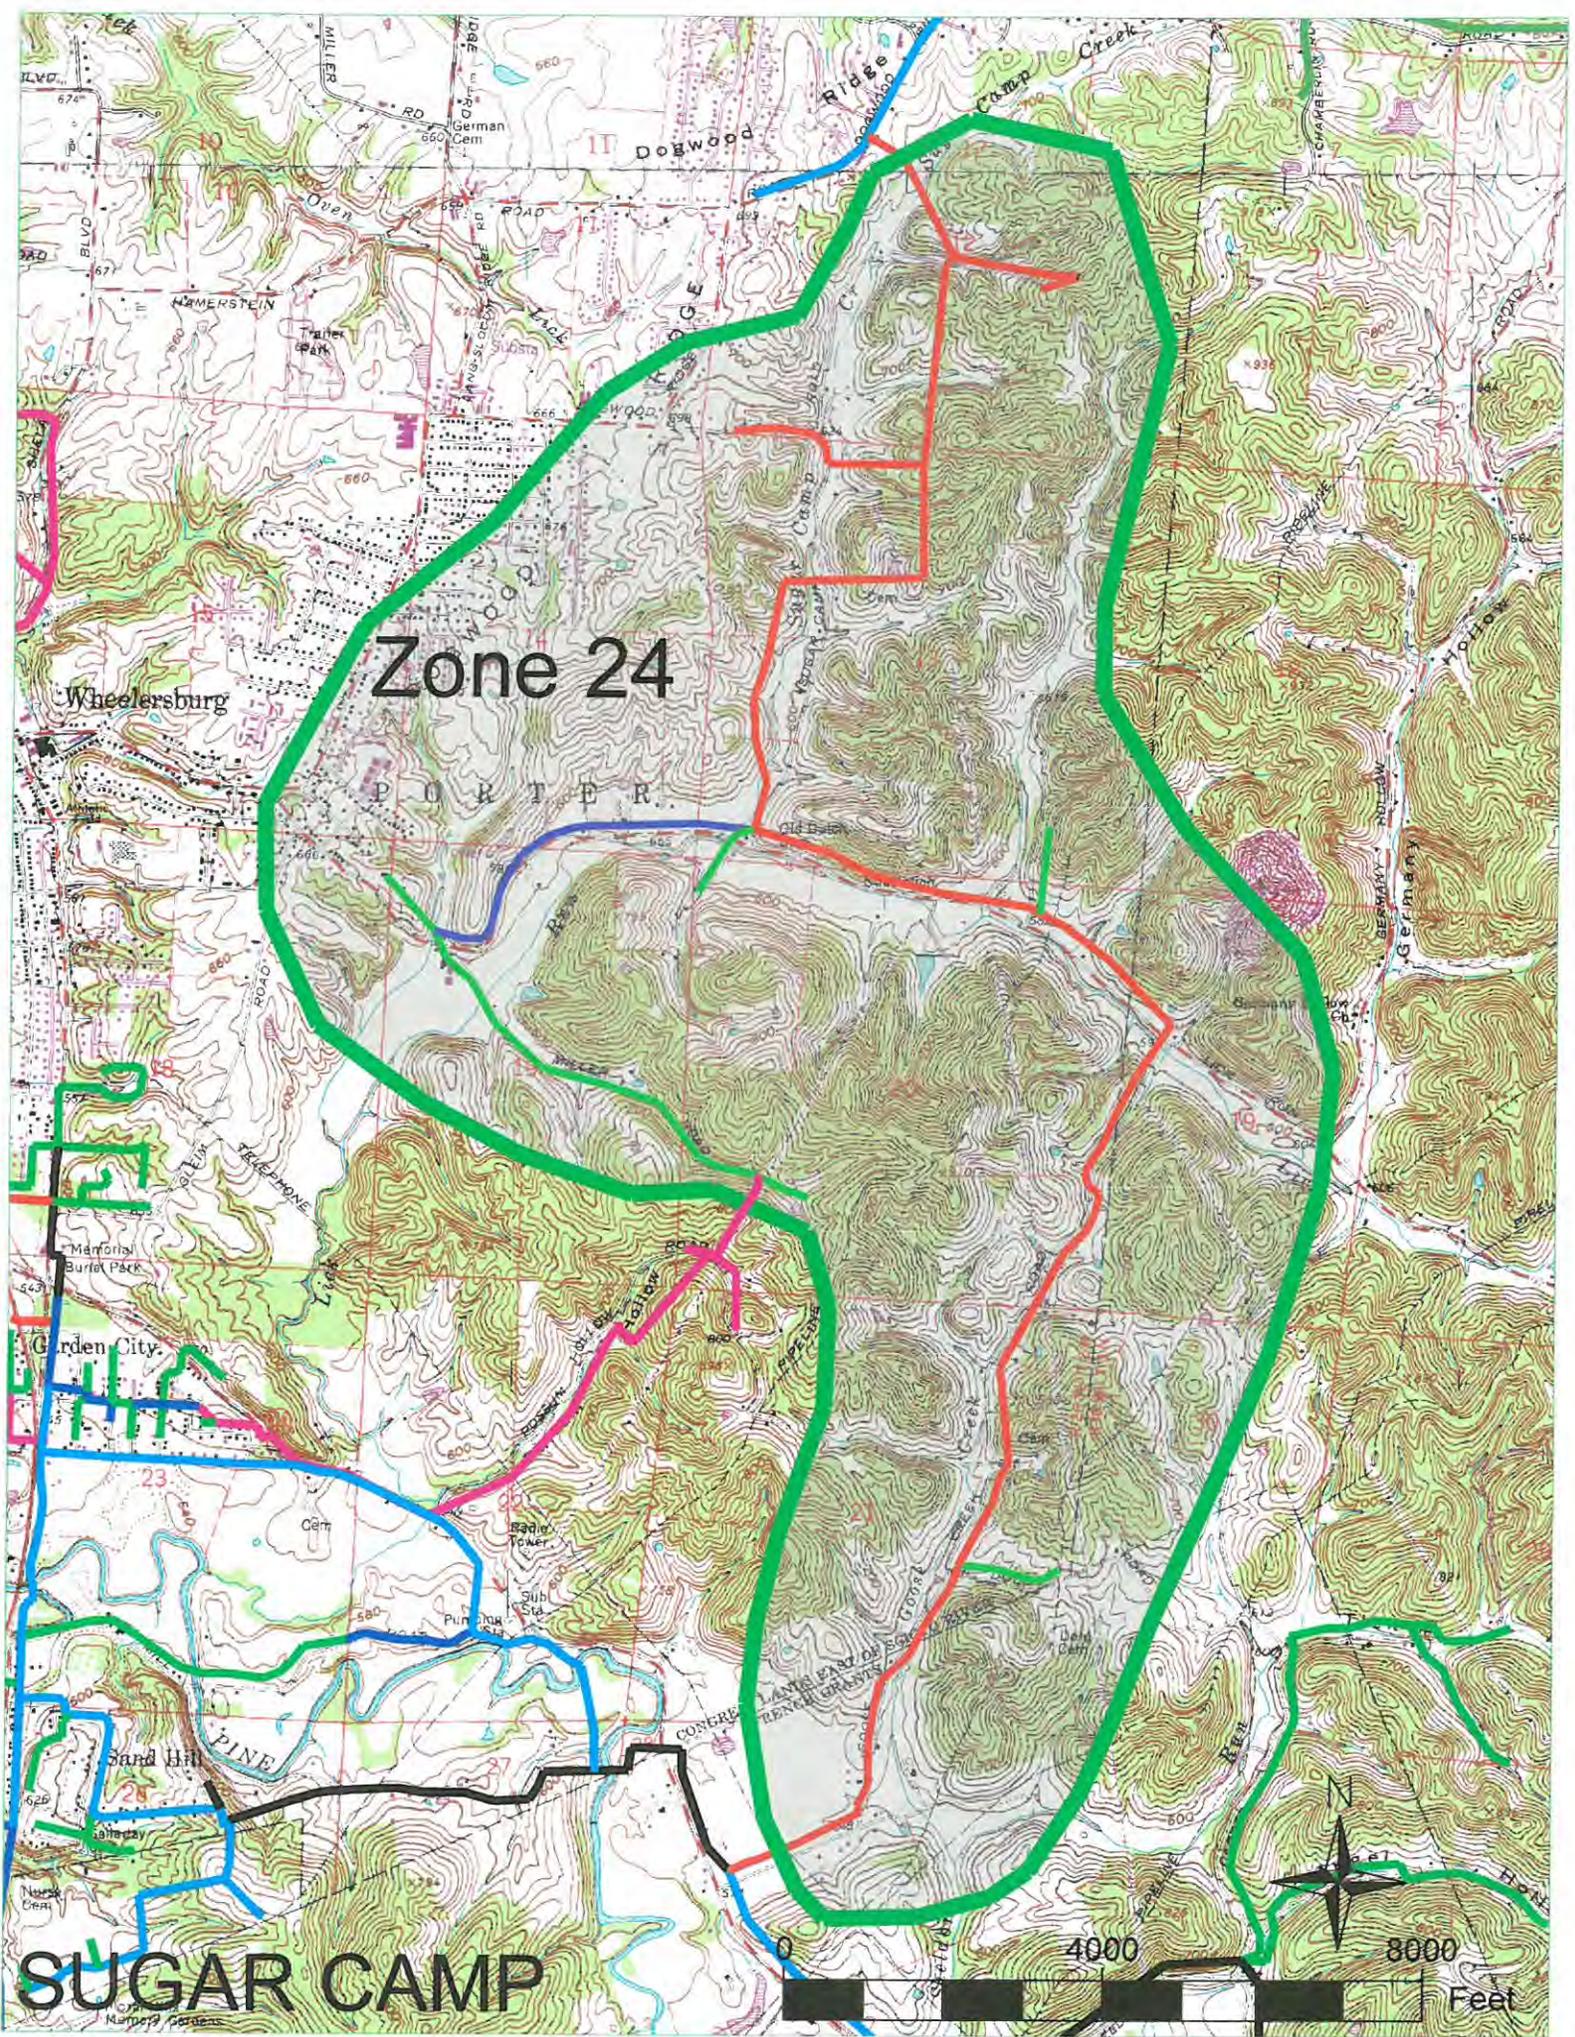


Zone 24

P O R T E R

SUGAR CAMP



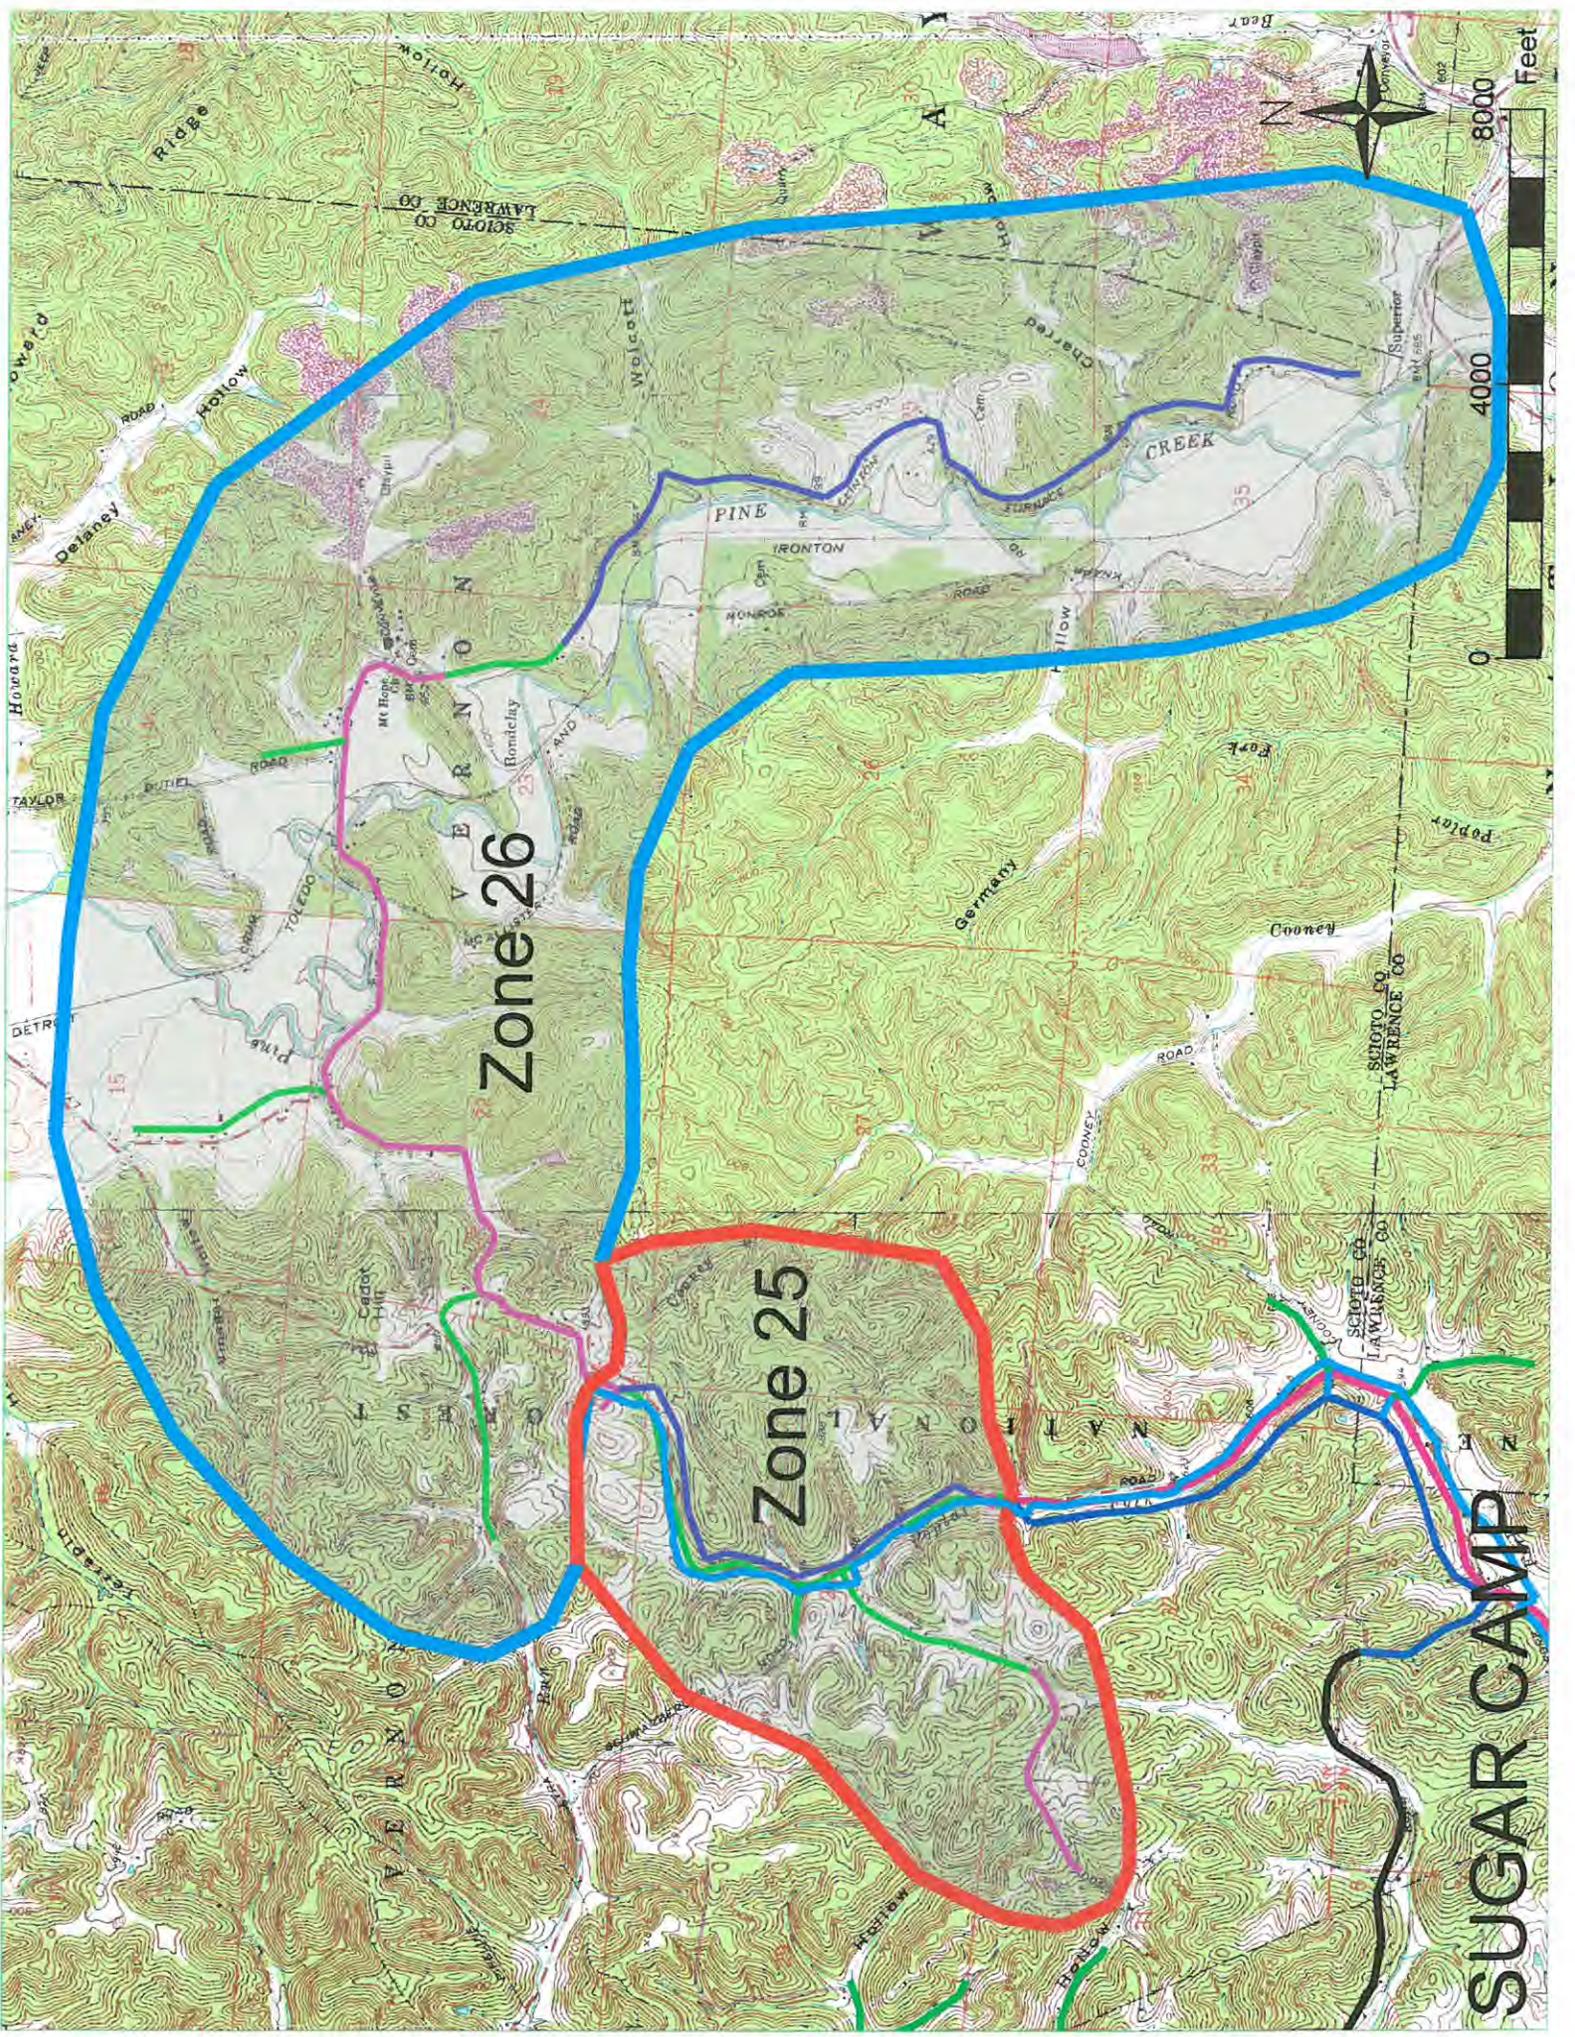

Zone 26

Zone 25

SUGAR CAMP

VERNON

PINE CREEK

LAWRENCE CO

VERNON

NATIONAL

NE


LAWRENCE CO

Feet

8000

4000

0

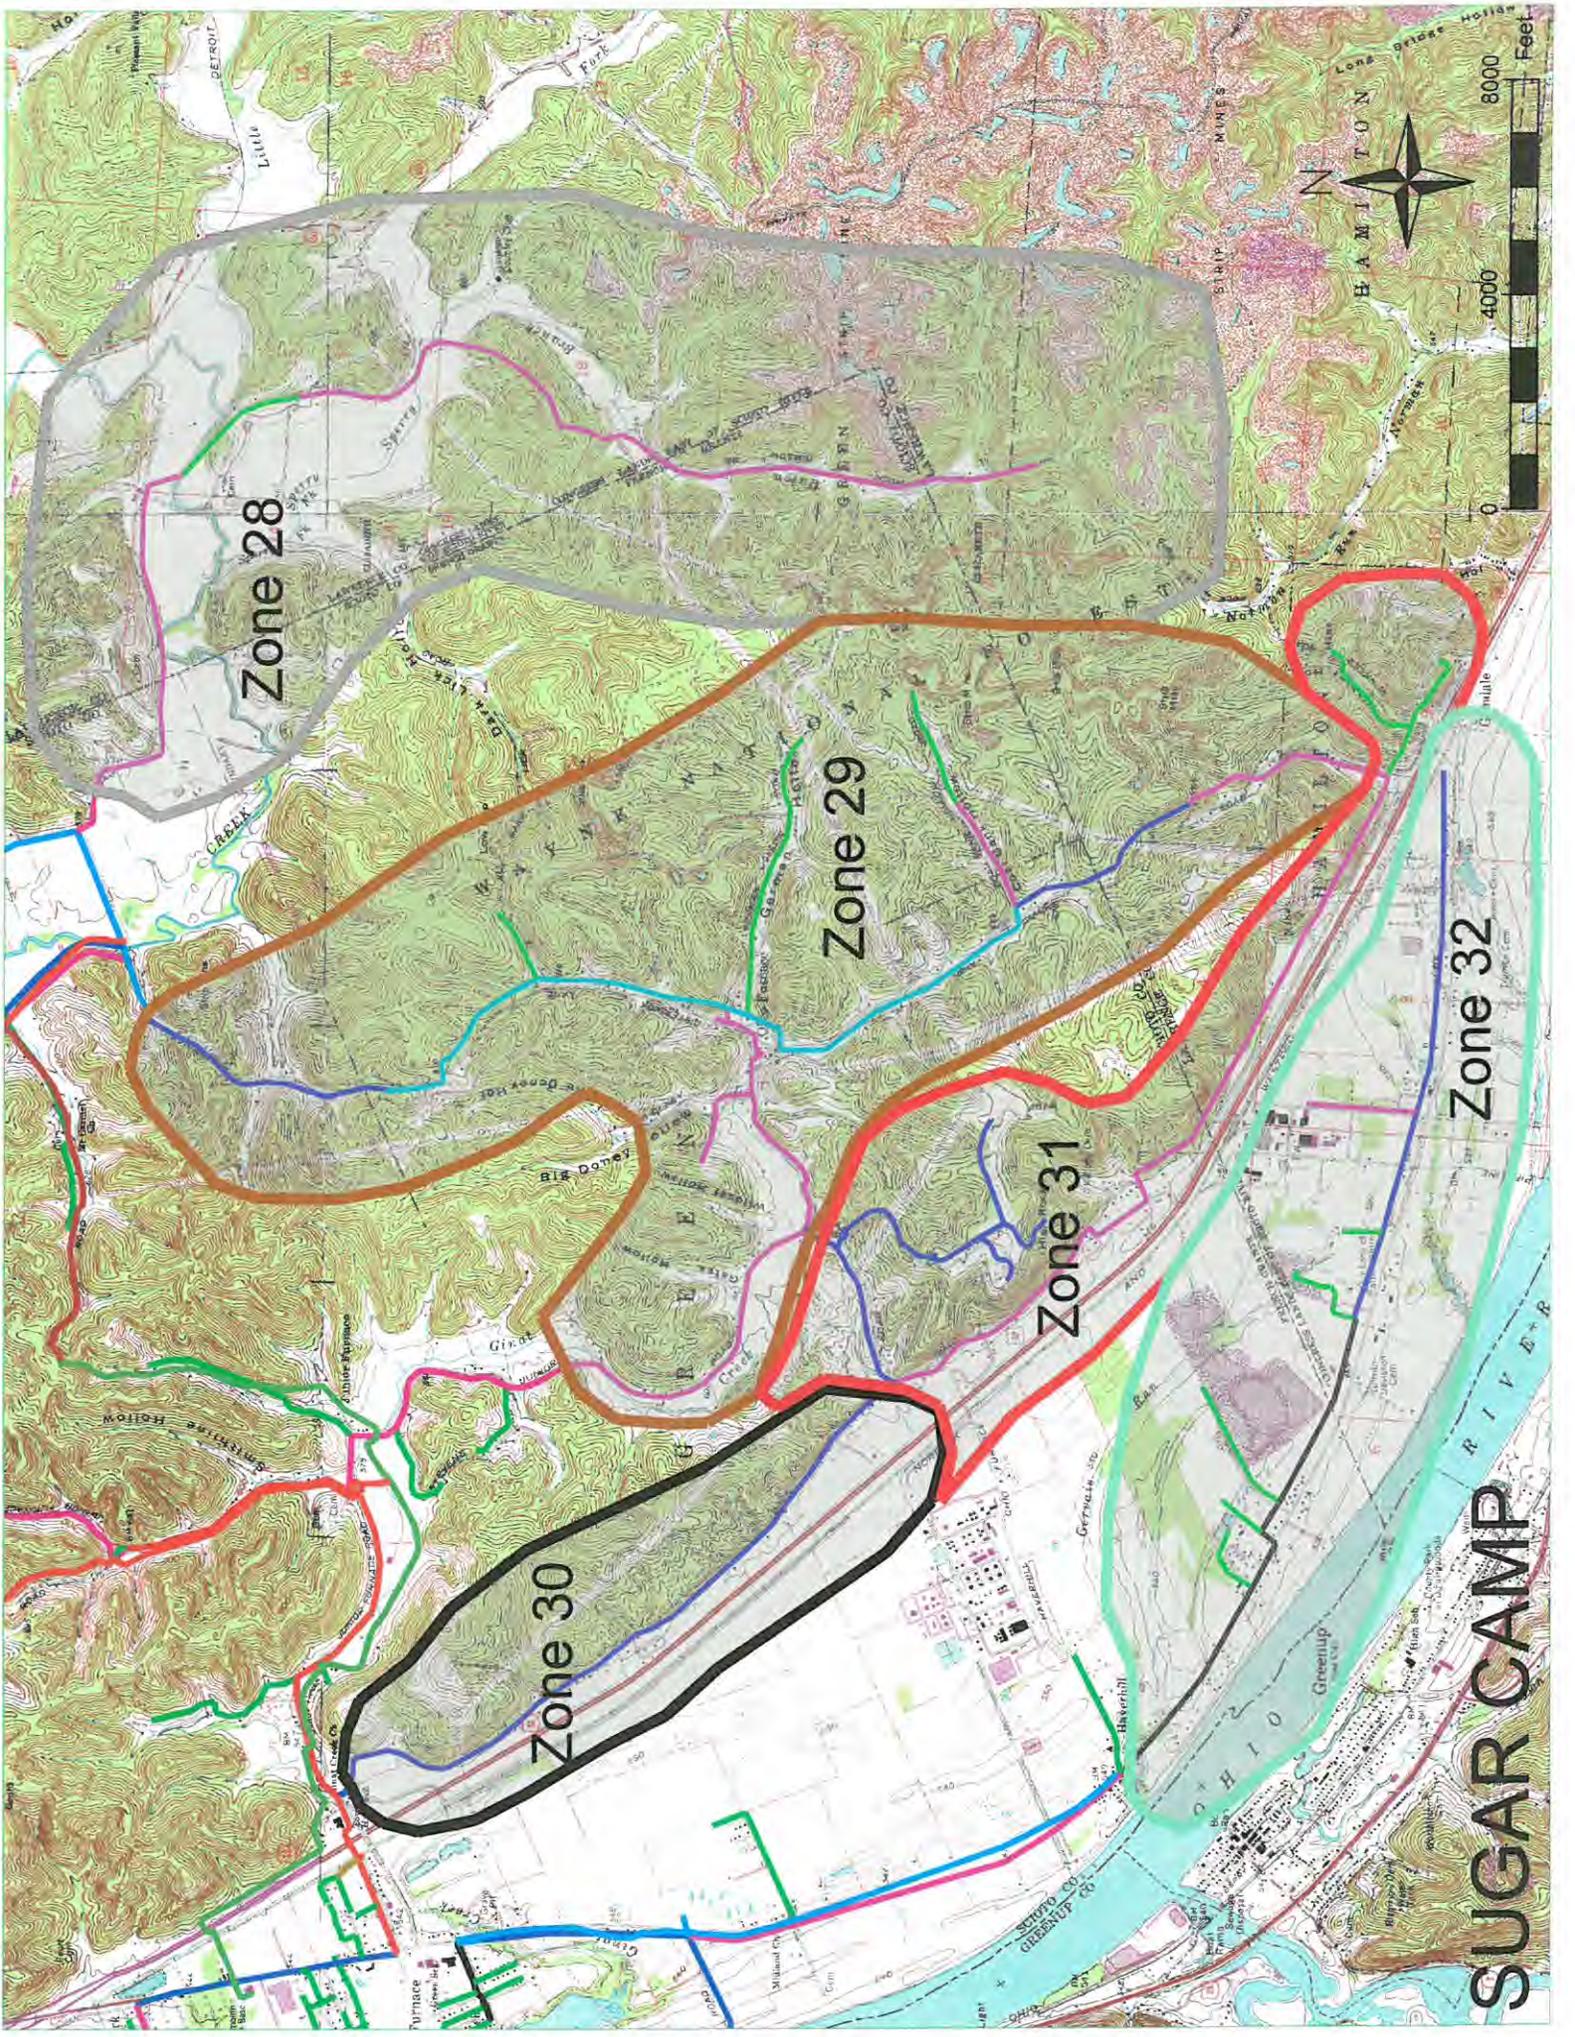

Zone 28

Zone 29


Zone 30

Zone 31

Zone 32

SUGAR CAMP



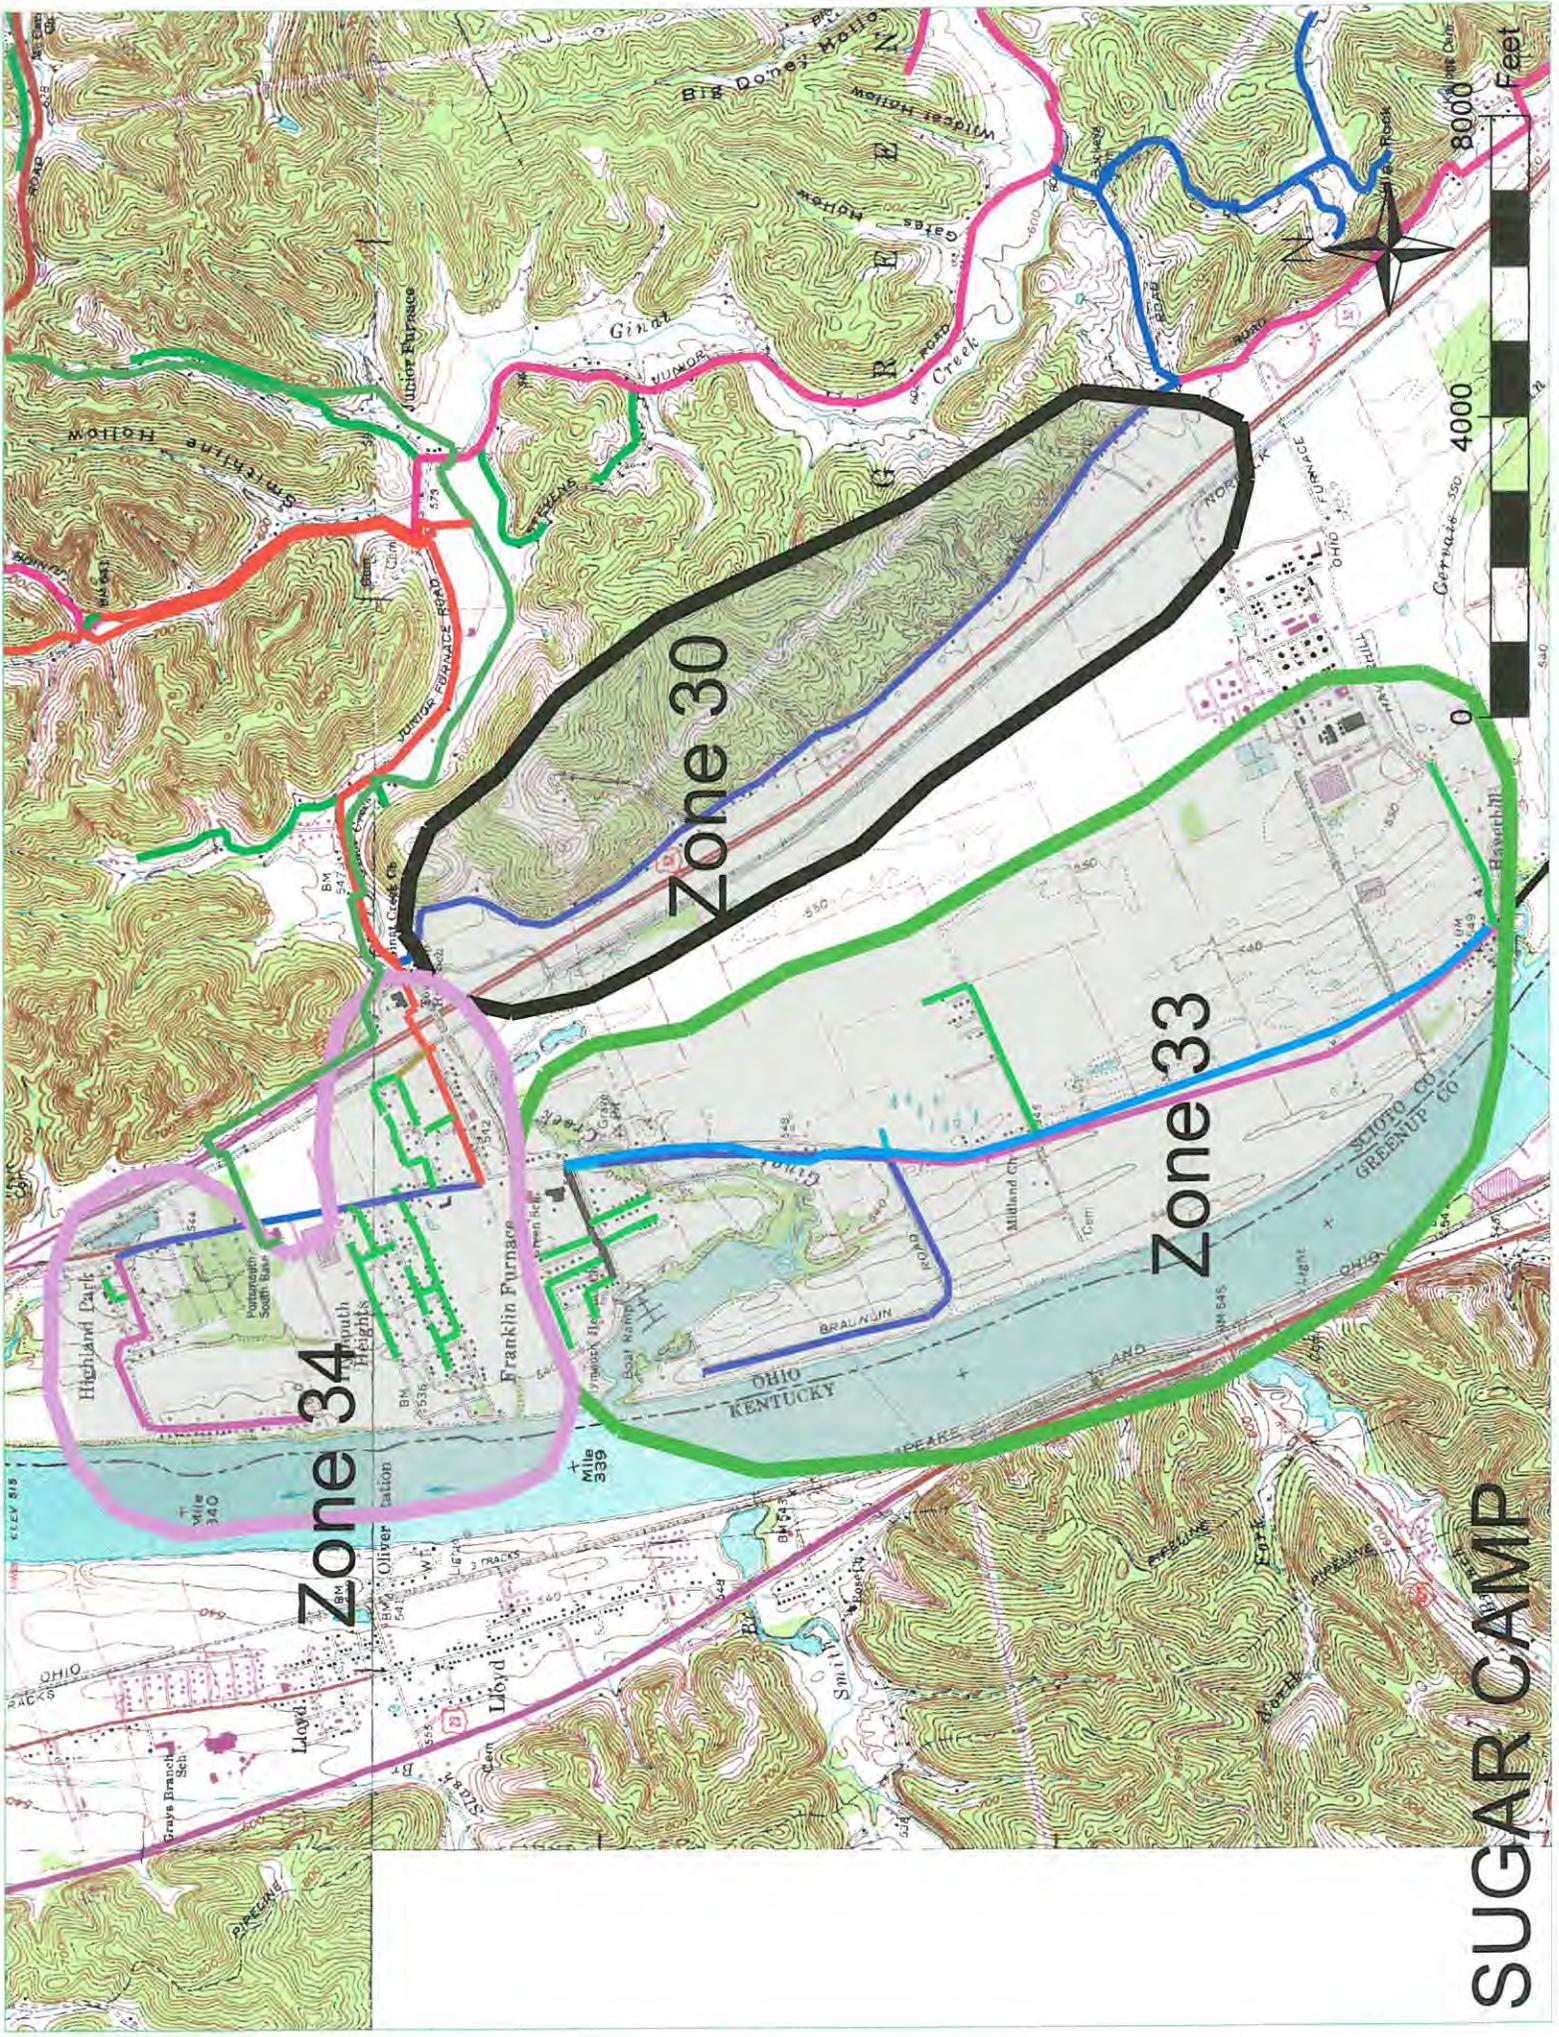

Zone 34

Zone 30

Zone 33

SUGAR CAMP