


All existing water lines are copper or PVC piping.

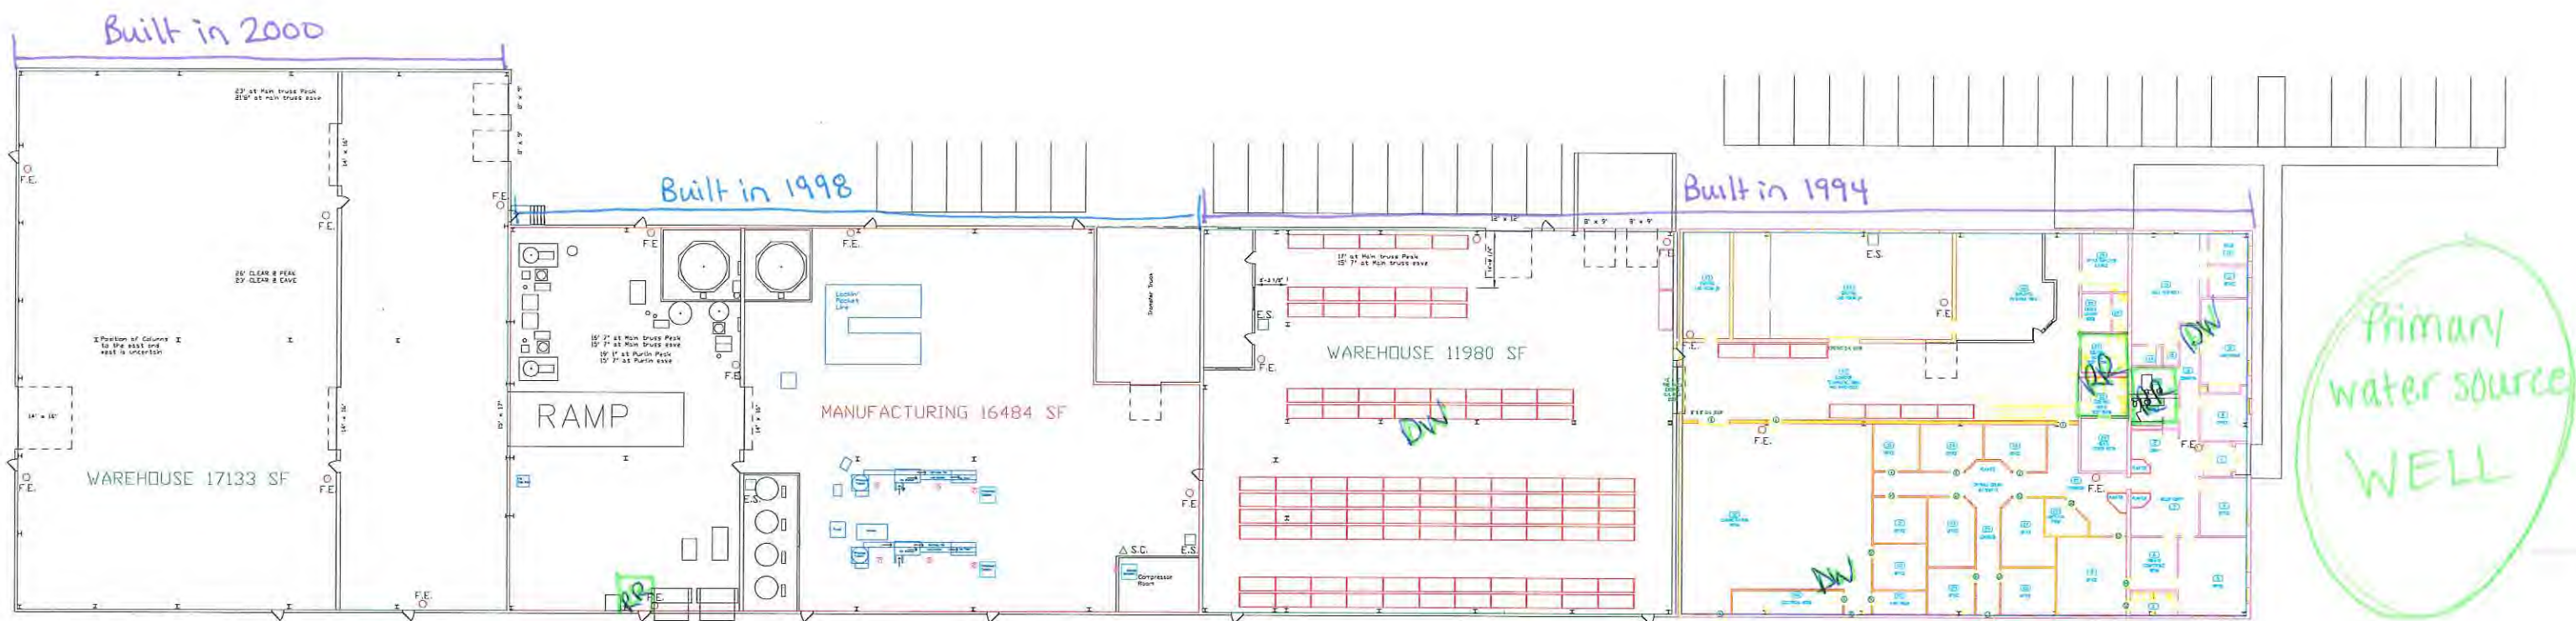

NOTES:

- 14378 SF OFFICE
- 29113 SF WAREHOUSE
- 16484 SF MANUFACTURING

County Sanitary Sewer - Well water

6" Concrete Floor
 All Electric Heat
 800 Amp; 480/277/208 Volt; 3 Phase; 4 Wire Electrical Service



- FIRE HYDRANT
- F.E. FIRE EXTINGUISHER
- EMERGENCY SPILL KIT
- HOSE HOUSE
- E.S. EYE WASH STATION and FIRST AID KIT
- EMERGENCY WEATHER ALERT SYSTEM
- × EMERGENCY RADIO
- S.S. SHOWER STATION
- △ SAFETY CABINET

RR - restroom
 DW - drinking water

Royal Adhesives and Sealants
 (Formerly Millenium Products)
 17340 Munn Rd
 Chagrin Falls, OH 44023
 Geauga County