

Lead Probability Map Narrative, Three Rivers Energy LLC

Three Rivers Energy LLC  
18137 County Road 271  
Coshocton, OH 43812  
Email: [erik.chaffer@threeriversenergyllc.com](mailto:erik.chaffer@threeriversenergyllc.com)  
Phone: 740 623 3070

PWS ID: OH1638412

All buildings and potable water distribution were constructed in 2007. All piping, fixtures and flux are at less than 8% lead. On site we have the following types of piping:


- PVC pipe = no chance of lead
- HDPE pipe = no chance of lead
- Galvanized Pipe = less than 8% lead
- Carbon Steel Pipe = less than 8% lead
- Copper Pipe = Less than 8% lead

Please see the legend on the site map for the color for each type of pipe.

The list of sampling points is:

<b>SMP ID*</b>	<b>Tap Location*</b>
LC201	Potable Water Plant
LC202	Admin Closet
LC203	Admin Kitchen
LC204	Admin Mens Restroom
LC205	MPB Mens Restroom

**Potable Water Building (POT)**

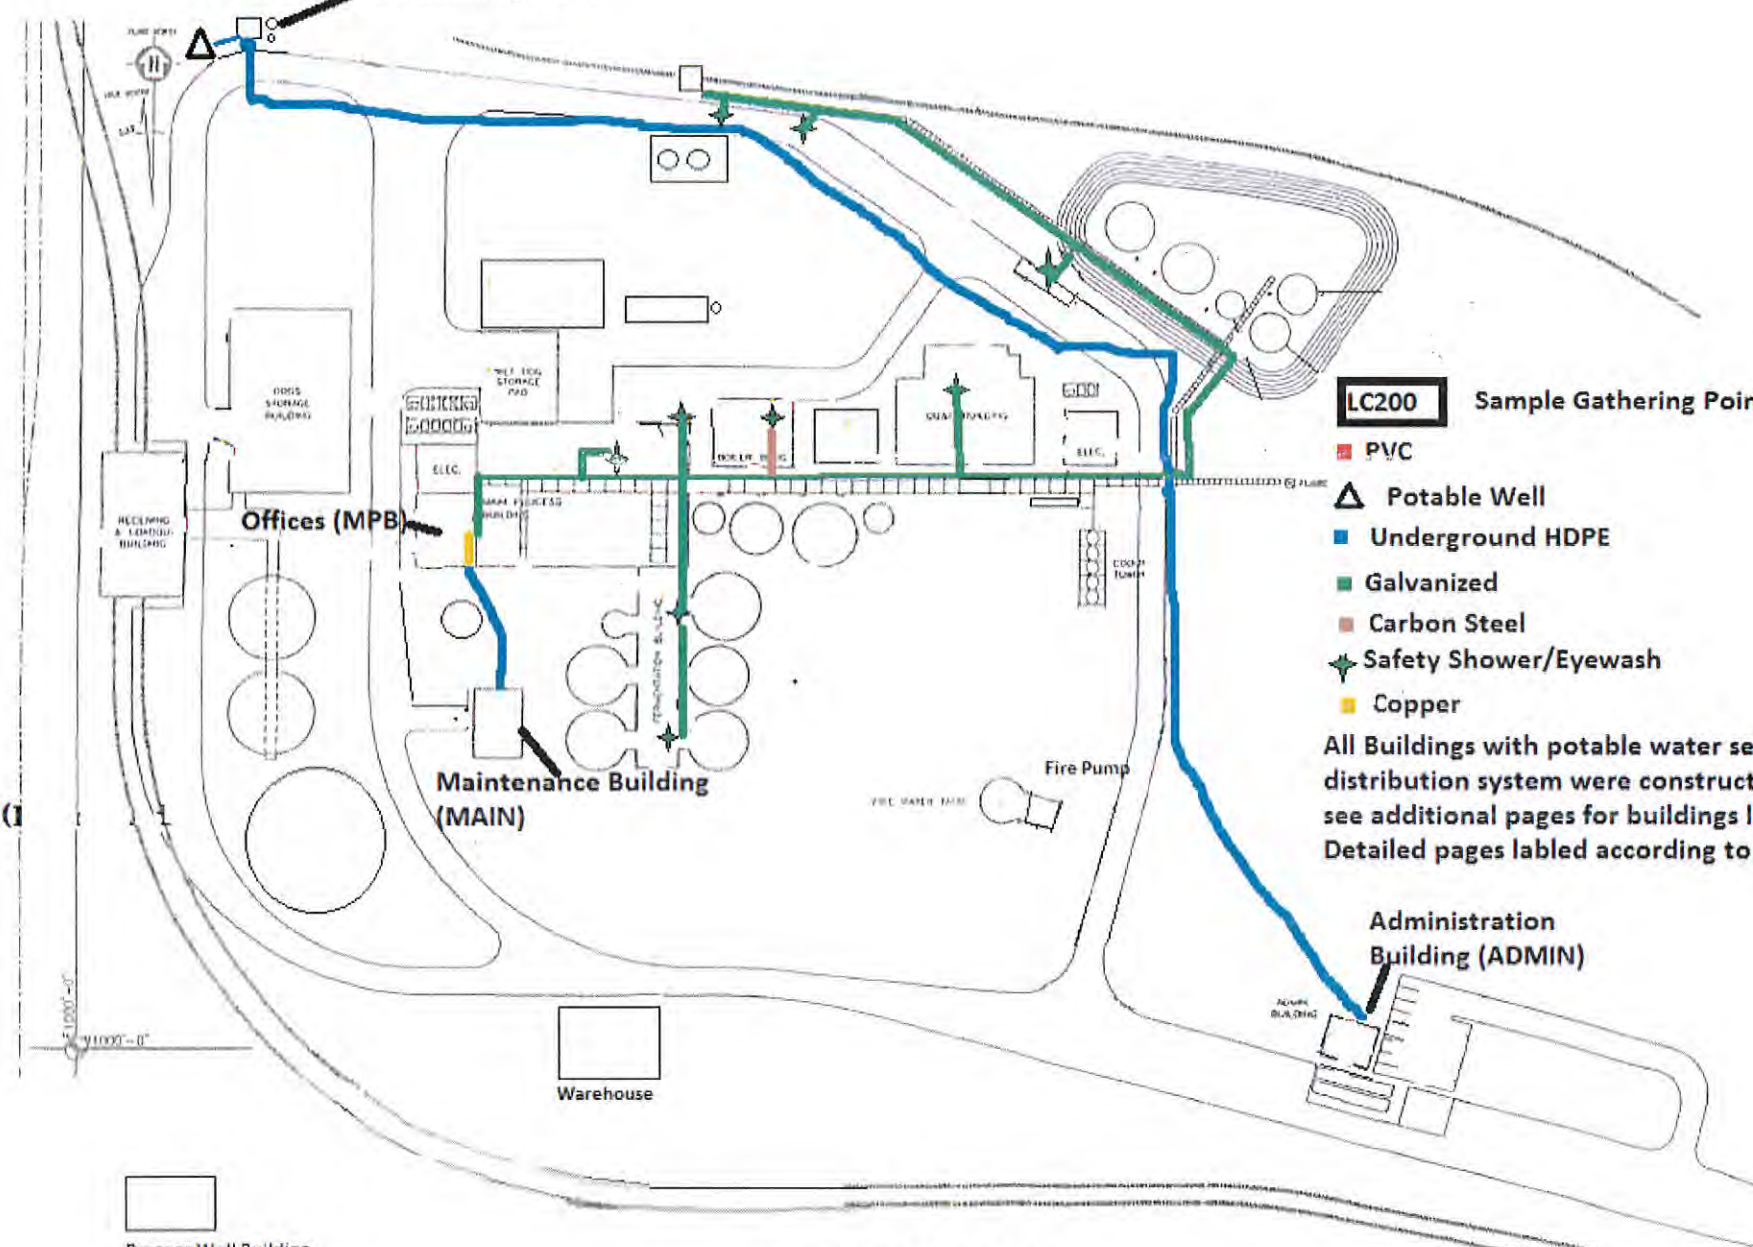

**LC200** Sample Gathering Point


- PVC
- ▲ Potable Well
- Underground HDPE
- Galvanized
- Carbon Steel
- ★ Safety Shower/Eyewash
- Copper

All Buildings with potable water service and the distribution system were constructed in 2007. Please see additional pages for buildings listed in bold. Detailed pages labeled according to parentheses

**Administration Building (ADMIN)**

**Three Rivers Energy LLC**  
 18137 County Road 271  
 Coshocton, OH 43812

Potable Water Building (POT)

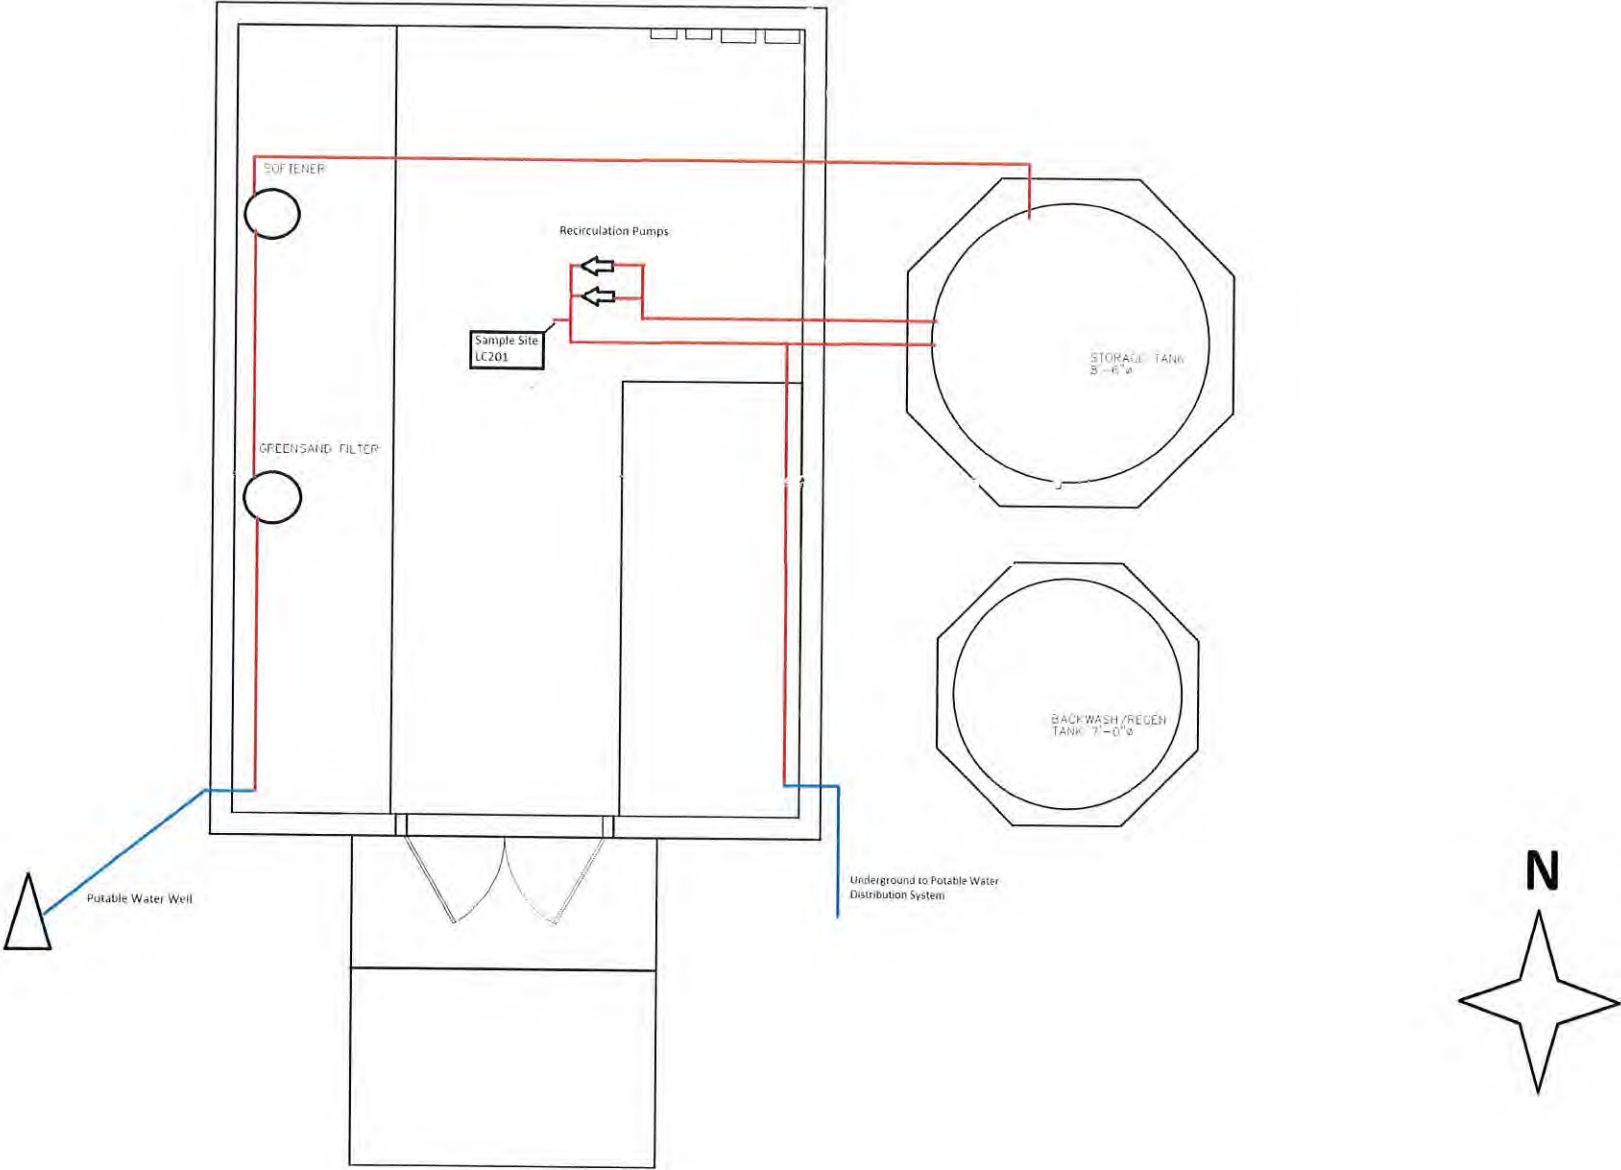


# Administration Building (Admin)



SCALE = 1/4" = 1'-0"



Offices (MPB) Three Rivers Energy LLC

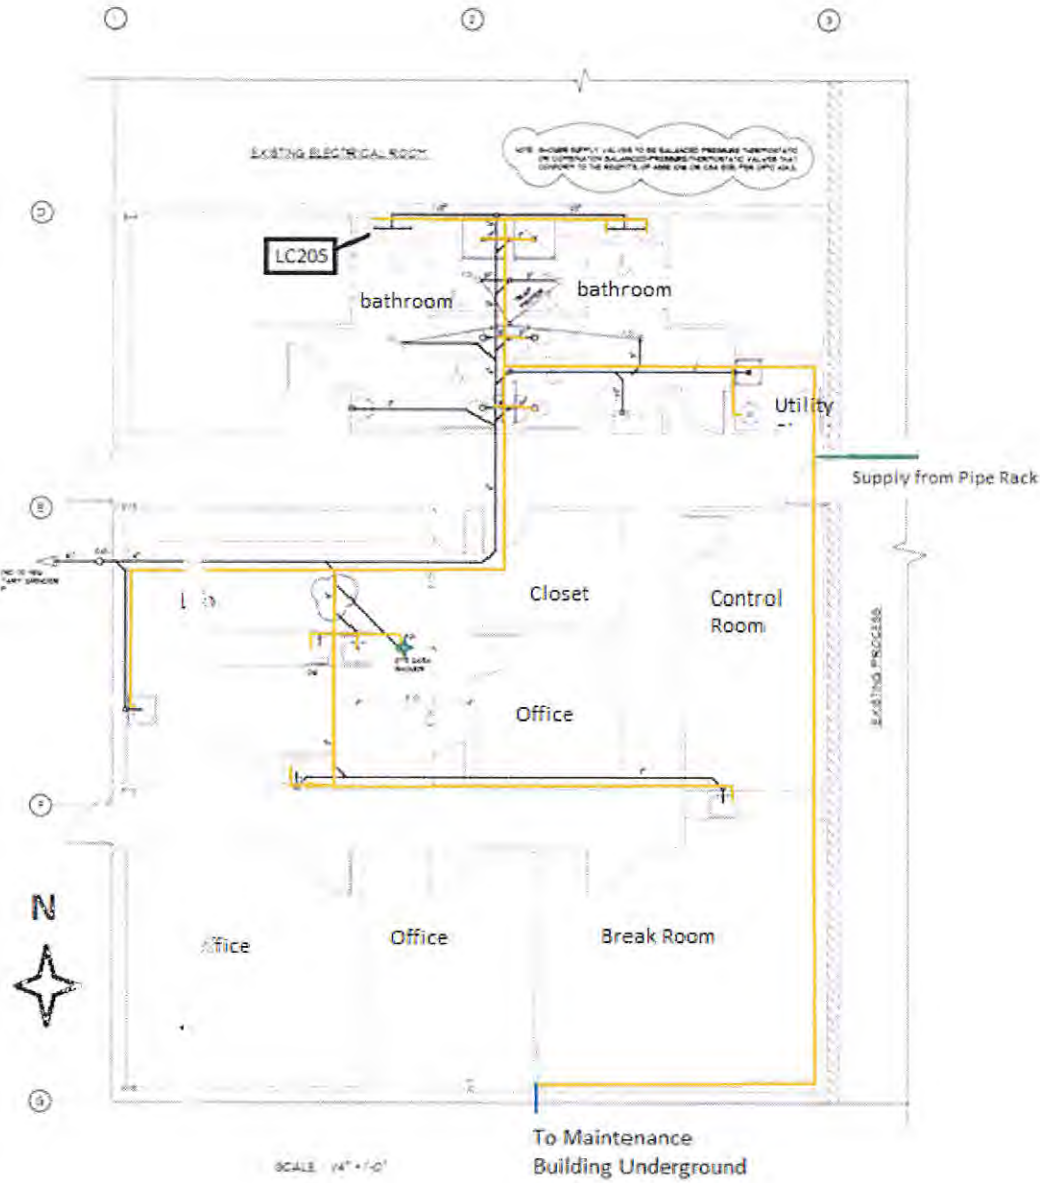

Three Rivers Energy Maintenance Shop (MAIN)

