


RE: ROCKFORD VILLAGE  
Report  
Drinking Water Program  
Mercer County  
PWS ID: OH5401112

**WATER BASE MAP**  
**VILLAGE OF ROCKFORD**  
**MERCER COUNTY, OHIO**

**RECEIVED**

**MAR 08 2017**

**DDAGW - NWDO**

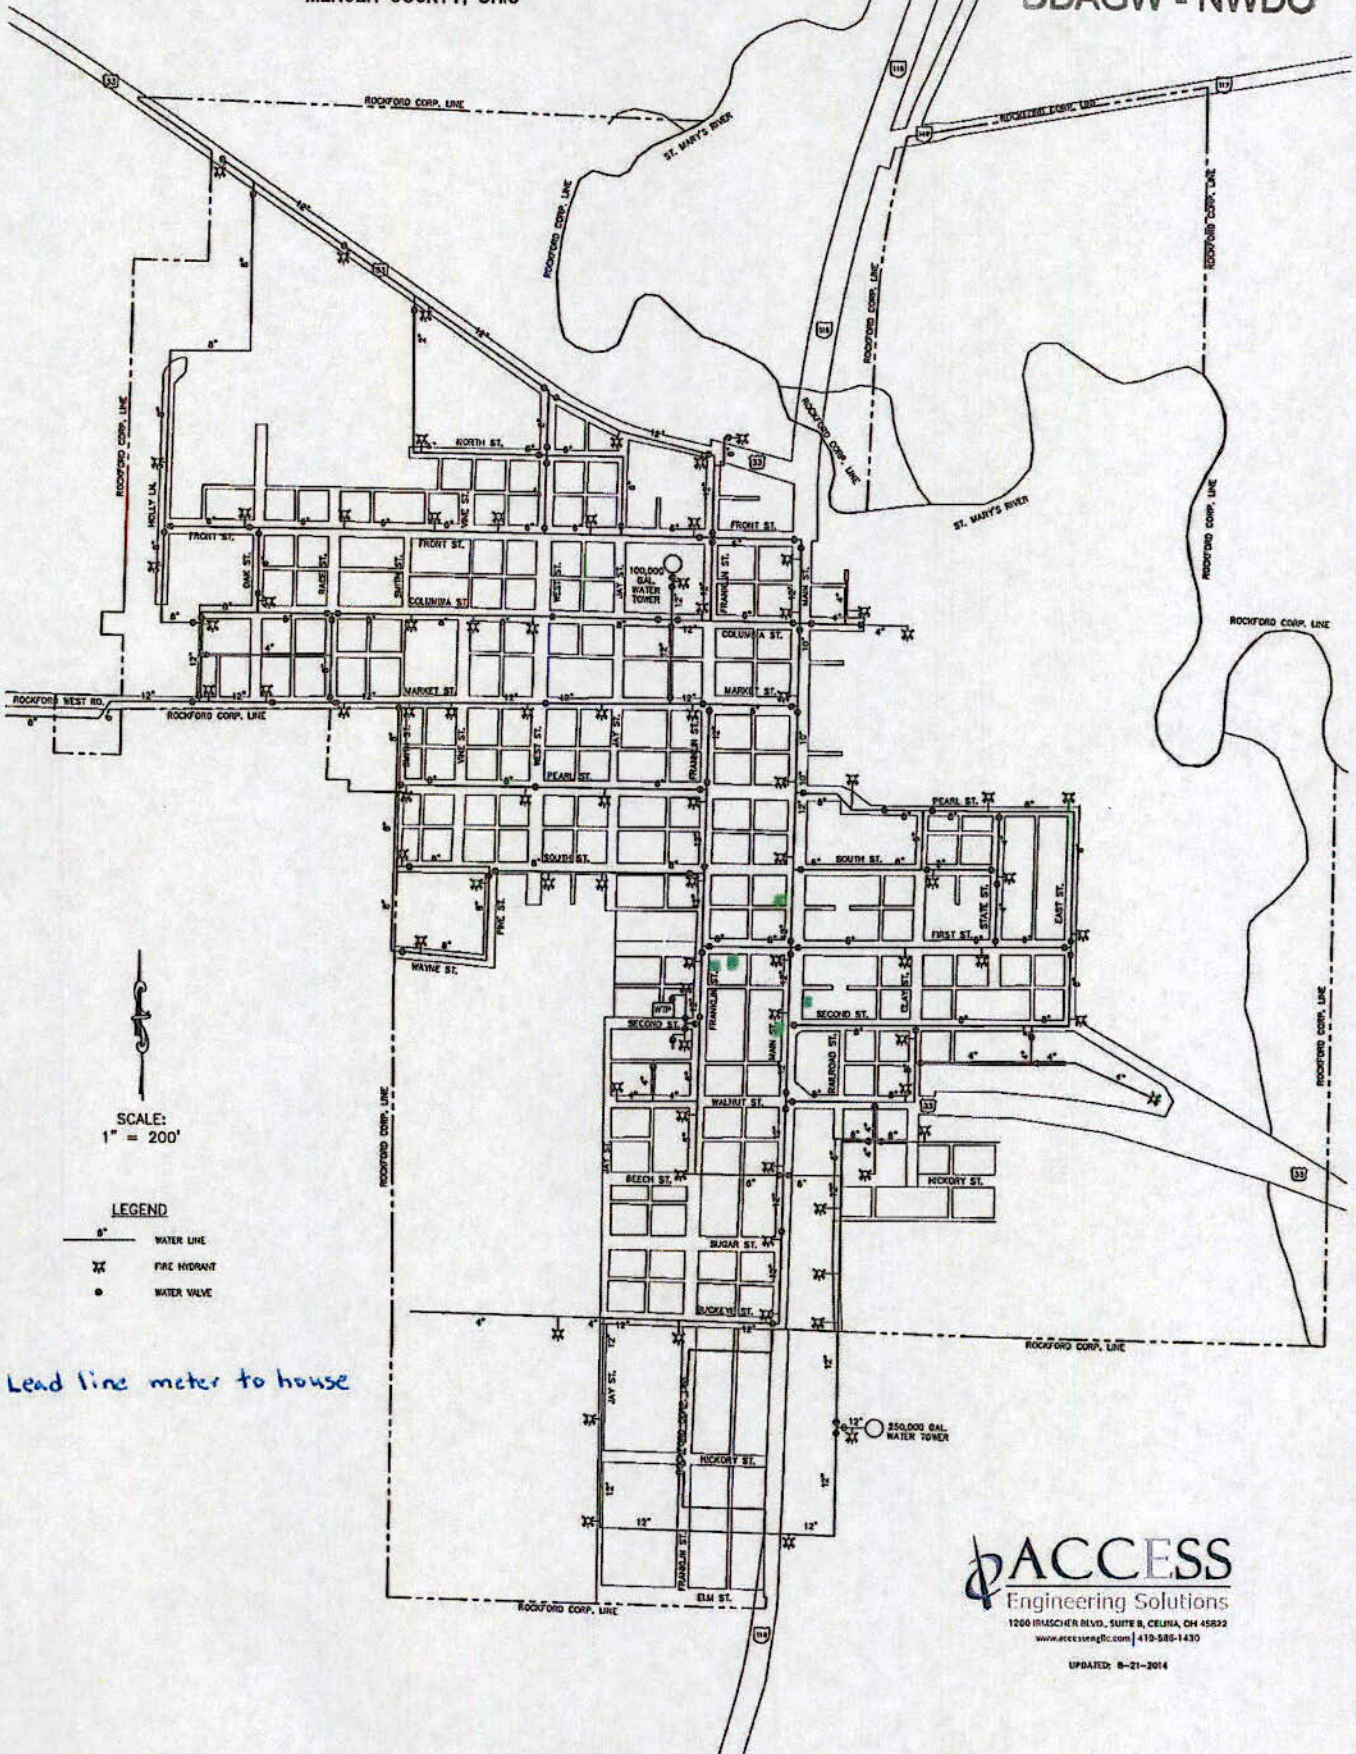

SCALE:  
 1" = 200'

**LEGEND**

- 8" WATER LINE
- XX FIRE HYDRANT
- WATER VALVE

**ACCESS**  
 Engineering Solutions

1200 IRASCHER BLVD, SUITE B, CELINA, OH 45822  
 www.accessengllc.com | 419-585-1430

UPDATED: 8-21-2014

RECEIVED

MAR 08 2017

VILLAGE OF ROCKFORD, MERCER COUNTY, OHIO  
DAGW - NWDO

## LEAD MAPPING NARRATIVE

**Buildings in Ohio built prior to 1998 or that use plumbing material or solder manufactured before 1998 may have materials with greater than 8% lead and are at a higher risk of contributing lead to the drinking water than materials manufactured after 1998. In addition, buildings built and plumbing materials manufactured after 2014 were required to have less than 0.25% lead by weight and have the lowest risk for contributing lead to the drinking water. It should be noted however that, although prohibited, some use of leaded solder or leaded components may have occurred after prohibitions became effective.**

In 2010-2011 the Village of Rockford replaced water mains and installed water meters and pits. Line type was recorded for each connection. The village has five homes that have lead lines from meter pits to house. These are located at 110 West First Street, 112 West First Street, 413 South Main Street, 406 South Main Street, and 305 South Main Street.