





York Elementary School

938 Stonecreek Road SW | New Philadelphia, OH 44663-7555
P 330.364.0770 | F 330.364.0773

PRINCIPAL
Jaclyn Smolinski
ADMINISTRATIVE
ASSISTANT
Tamra Wells

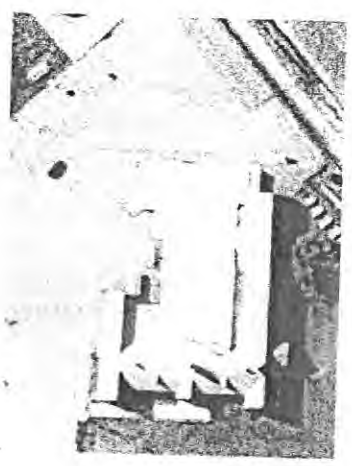

York Elementary 2016 - 2017

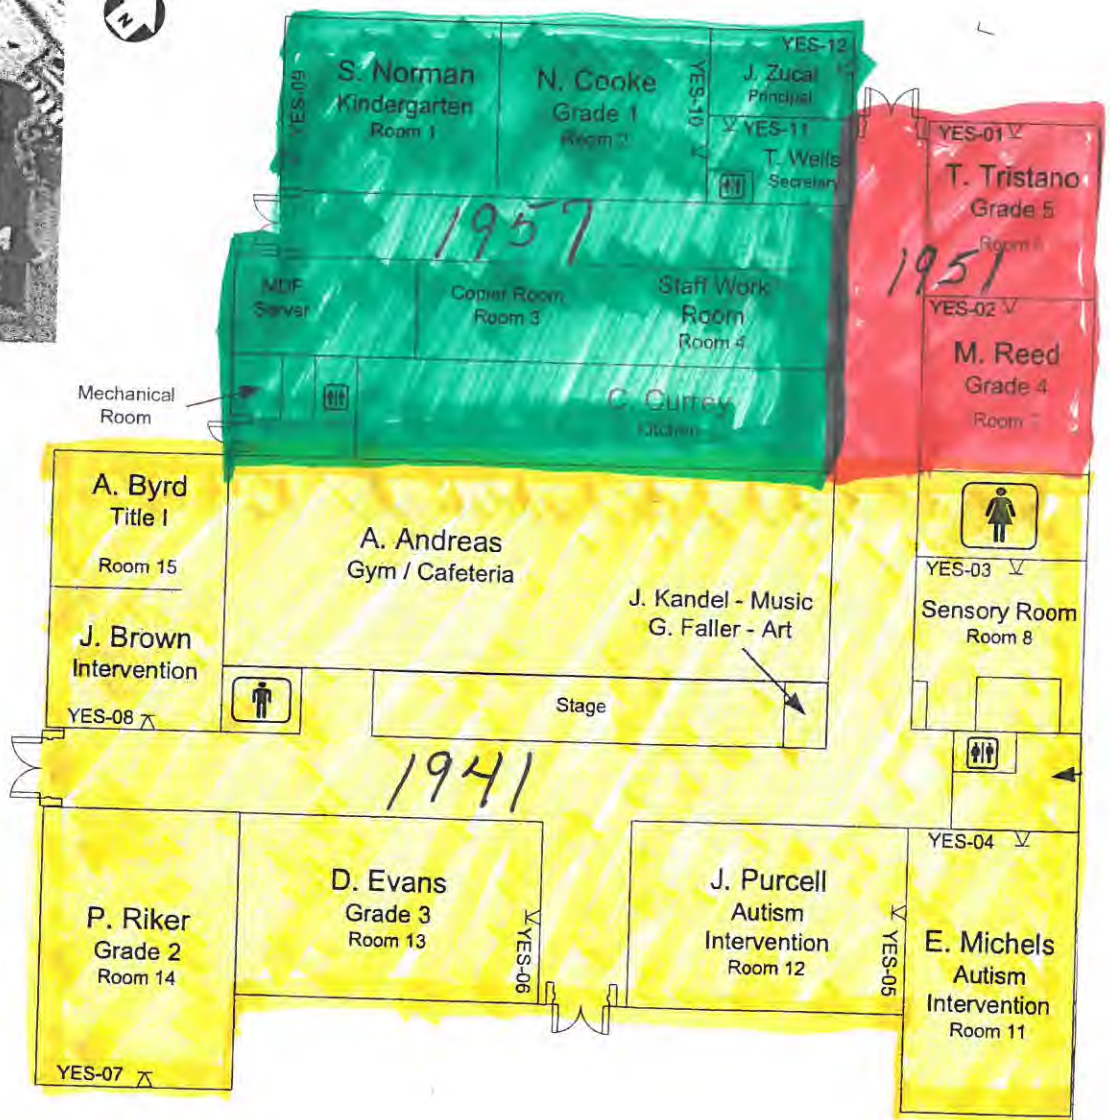



York Elementary School


938 Stonecreek Road SW | New Philadelphia, OH 44663-7555
P 330.364.0770 | F 330.364.0773


PRINCIPAL
Jaclyn Smolinski


ADMINISTRATIVE
ASSISTANT
Tamra Wells


1957 Addition


- C - Cold Water


 1/2" CO. 1/2" Copper Line (NO INFORMATION)


 HOT WATER TANK
(AGE UNKNOWN)


 Copper 90° LEAD UNKNOWN
(NO INFORMATION)

 Copper T LEAD UNKNOWN
(NO INFORMATION)


 1/2" CO. 1/2" Copper Line


 CLASSROOM Sink
Spikot (CENTRAL BRASS) 2015
Shut offs (UNKNOWN)


 Office Sink
Spikot (UNKNOWN)
Shut offs (UNKNOWN)


 Kitchen Restroom
Spikot (UNKNOWN)
Shut offs (UNKNOWN)

 Kitchen Restroom
Shop Sink Spikot (CENTRAL BRASS) 2015
NO Shut offs

 - Kitchen Sink
2- Spikots
(CENTRAL BRASS)
2015
Shut offs (UNKNOWN)

 - CLASS Room #1
Toilet
Flush-o-meter (UNKNOWN)


 - Office Restroom
Toilet
Flushometer (SLOAN) 2010

 - Kitchen Restroom
Toilet
Flushometer (SLOAN) 2010

(SMPID #4)

(SMPID #5)

5

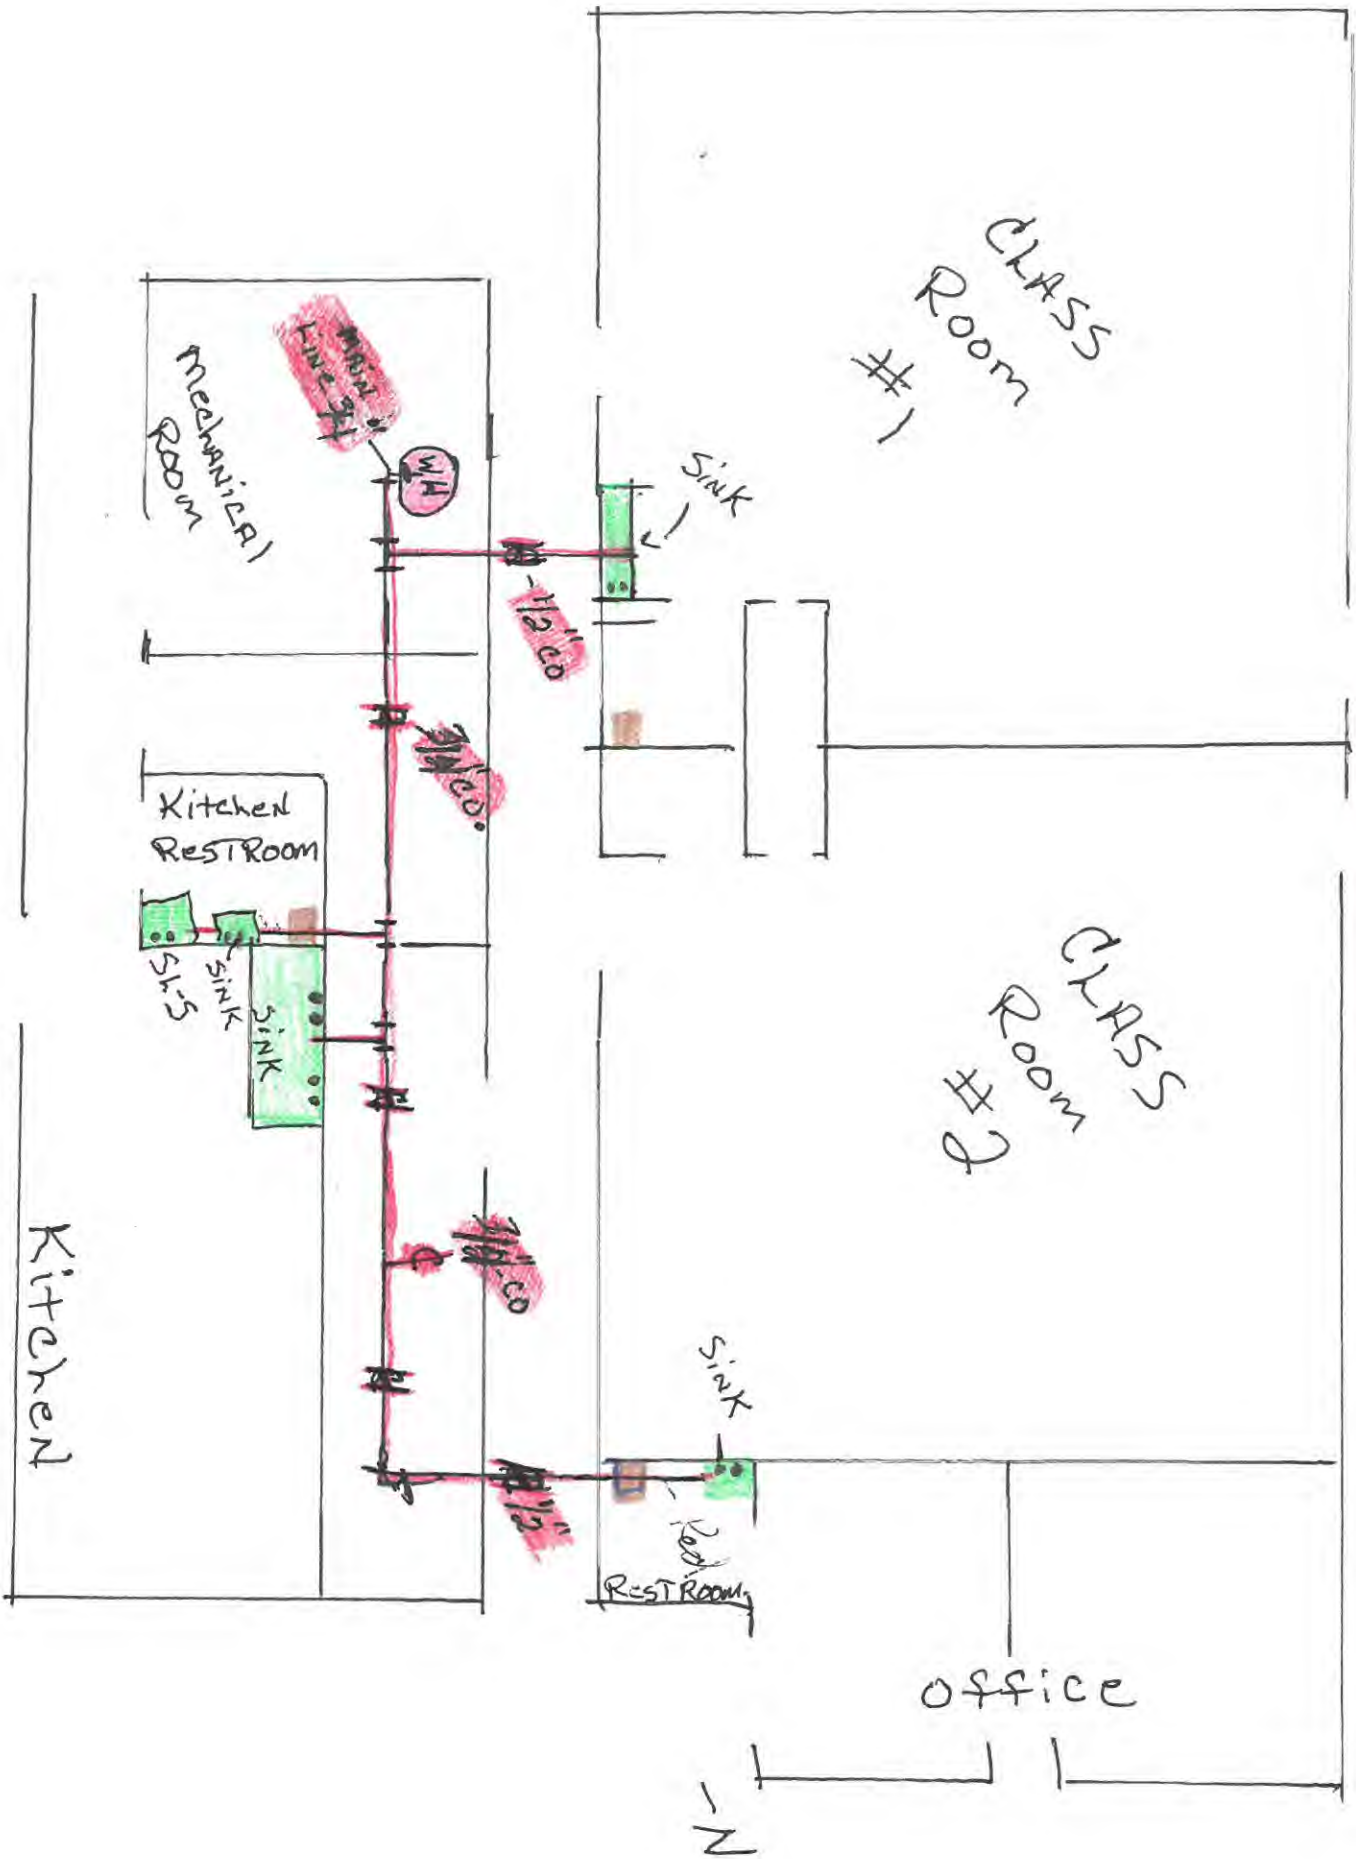

1957 ADDITION

3

3

Gym

Kitchen

Mechanical Room

Kitchen Rest Room

SINK SINK SINK

Rest Room

Office

CLASS Room #1

CLASS Room #2

N



York Elementary School

938 Stonecreek Road SW | New Philadelphia, OH 44663-7555
P 330.364.0770 | F 330.364.0773

PRINCIPAL
Jaclyn Smolinski

ADMINISTRATIVE
ASSISTANT
Tamra Wells

1957 Addition



HOT WATER



1/2" COPPER LINE (NO INFORMATION)



WATER HEATER (AGE UNKNOWN)
(NO INFORMATION)



3/4" COPPER LINE (MAIN)



KITCHEN SINK
2 SPIKOTS
CENTRAL BRASS
SHUT OFFS
(UNKNOWN)
(NO INFORMATION)



COPPER 90° (LEAD UNKNOWN)
(NO INFORMATION)



COPPER T (LEAD UNKNOWN)
(NO INFORMATION)



- CLASSROOM SINK
SPIKOT (CENTRAL BRASS) 2015
SHUT OFFS (UNKNOWN)



- OFFICE SINK
SPIKOT (UNKNOWN)
SHUT OFFS (UNKNOWN)



- KITCHEN RESTROOM
SPIKOT (UNKNOWN)
SHUT OFF (UNKNOWN)



- KITCHEN RESTROOM
SHOP SINK SPIKOT (CENTRAL BRASS) 2015
NO SHUT OFFS



York Elementary School

938 Stonecreek Road SW | New Philadelphia, OH 44663-7555
P 330.364.0770 | F 330.364.0773

PRINCIPAL
Jaclyn Smolinski

ADMINISTRATIVE
ASSISTANT
Tamra Wells

Basement

- Ⓟ Well - Pump
- 1 1/2" C - COLD Water to Kitchen
- 1 1/2" CO - Copper Line (NO INFORMATION) LEAD
- G - GALVANIZED WATER LINE (NO INFORMATION) LEAD
- Ⓢ - SPIKETS (NO INFORMATION) LEAD (AGE UNKNOWN)
- X - 2" Gate Valves
- Ⓢ - 1 1/2" Gate Valve
- 3/4" WATER Line (GALVANIZED)
FIRST FLOOR
SINK
Slop SINK
DRINKING
- Ⓢ - 2" Galvin Water Line
- GALVANIZED WATER Line
- Ⓢ - Water HEATER
- Ⓢ - 2 - 200 gal Water TANKS
Put in 1970
GALVANIZED IRON
- Ⓢ - SMPID #1




York Elementary School

938 Stonecreek Road SW | New Philadelphia, OH 44663-7555
P 330.364.0770 | F 330.364.0773

PRINCIPAL
Jaclyn Smolinski

ADMINISTRATIVE
ASSISTANT
Tamra Wells

Basement

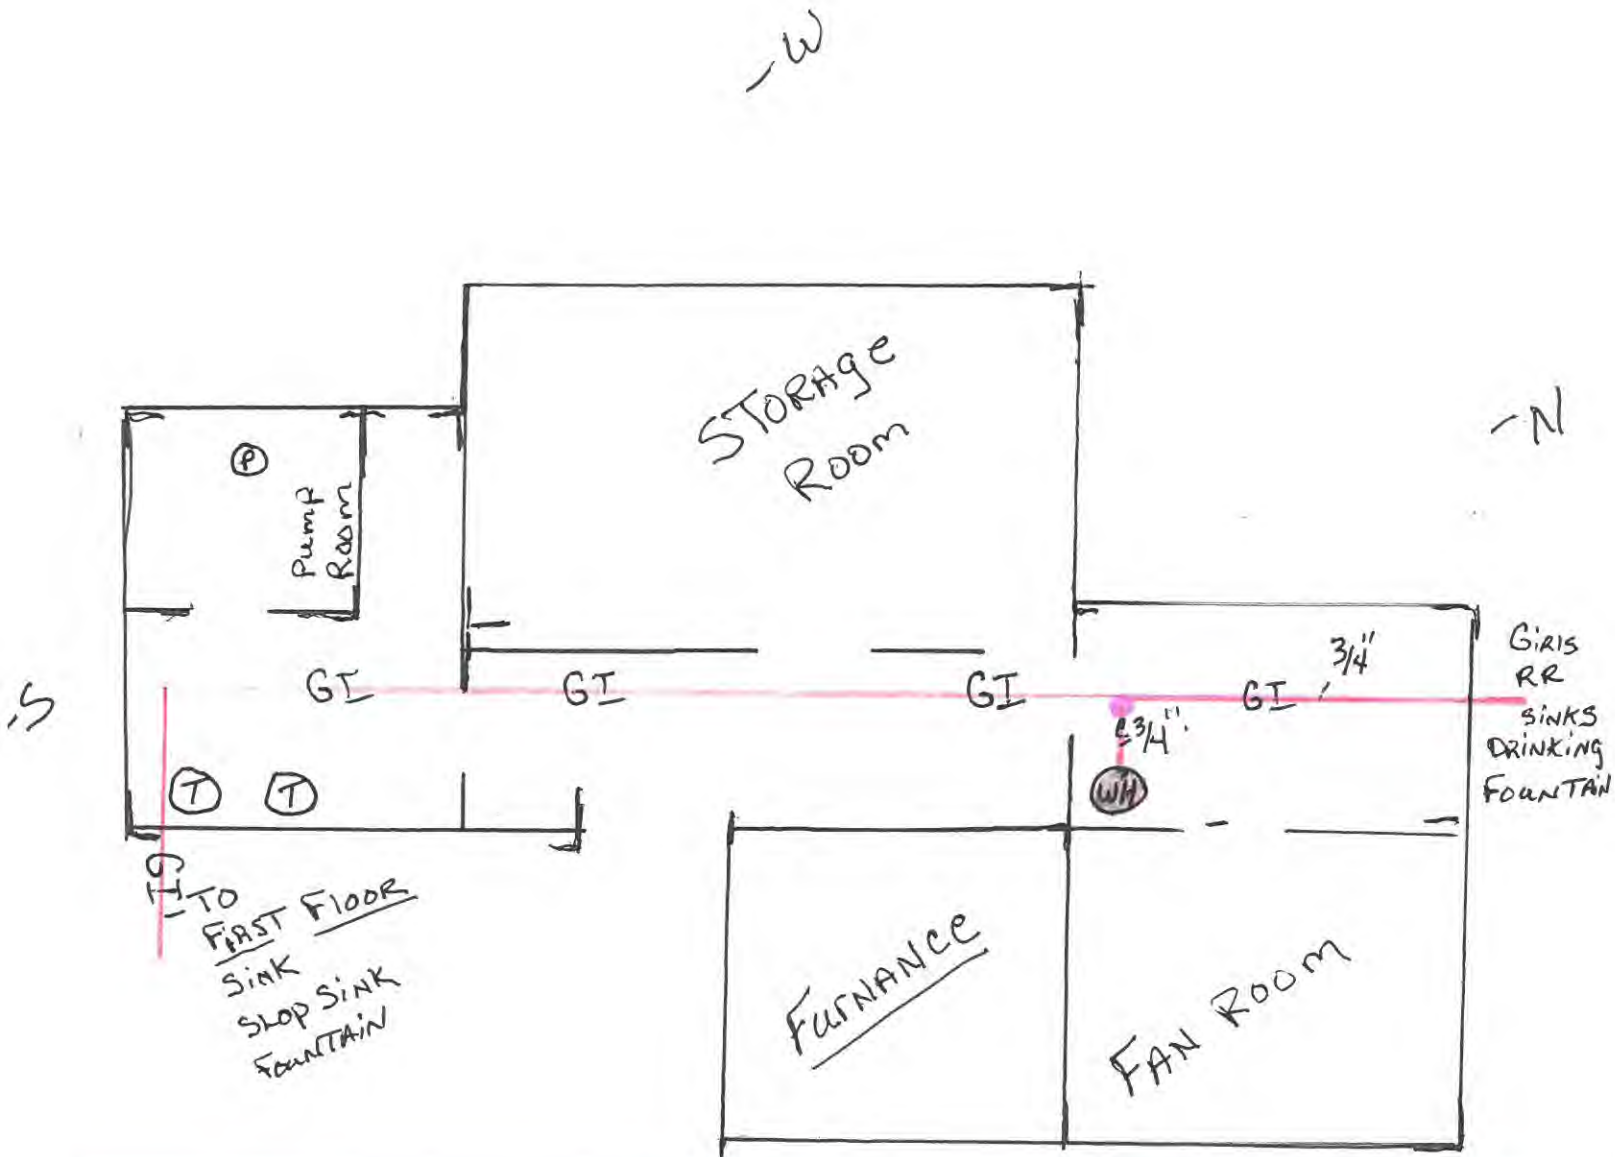



York Elementary School

938 Stonecreek Road SW | New Philadelphia, OH 44663-7555
P 330.364.0770 | F 330.364.0773

PRINCIPAL
Jaclyn Smolinski

ADMINISTRATIVE
ASSISTANT
Tamra Wells

Basement

- W



- E



York Elementary School

938 Stonecreek Road SW | New Philadelphia, OH 44663-7555
P 330.364.0770 | F 330.364.0773

PRINCIPAL
Jaclyn Smolinski

ADMINISTRATIVE
ASSISTANT
Tamra Wells

Basement

- HOT WATER
- ~~GI~~ HOT WATER GALVANIZED IRON (NO INFORMATION) LEAD
- ~~3/4"~~ 3/4" GALVANIZED IRON
- 3/4" BALL VALVE (NO INFORMATION) LEAD
- ~~C~~ 3/4" COPPER LINE (NO INFORMATION) LEAD
- Ⓢ WATER HEATER (NO INFORMATION) LEAD




York Elementary School

938 Stonecreek Road SW | New Philadelphia, OH 44663-7555
P 330.364.0770 | F 330.364.0773

PRINCIPAL
Jaclyn Smolinski

ADMINISTRATIVE
ASSISTANT
Tamra Wells


Boy's RestRoom cold

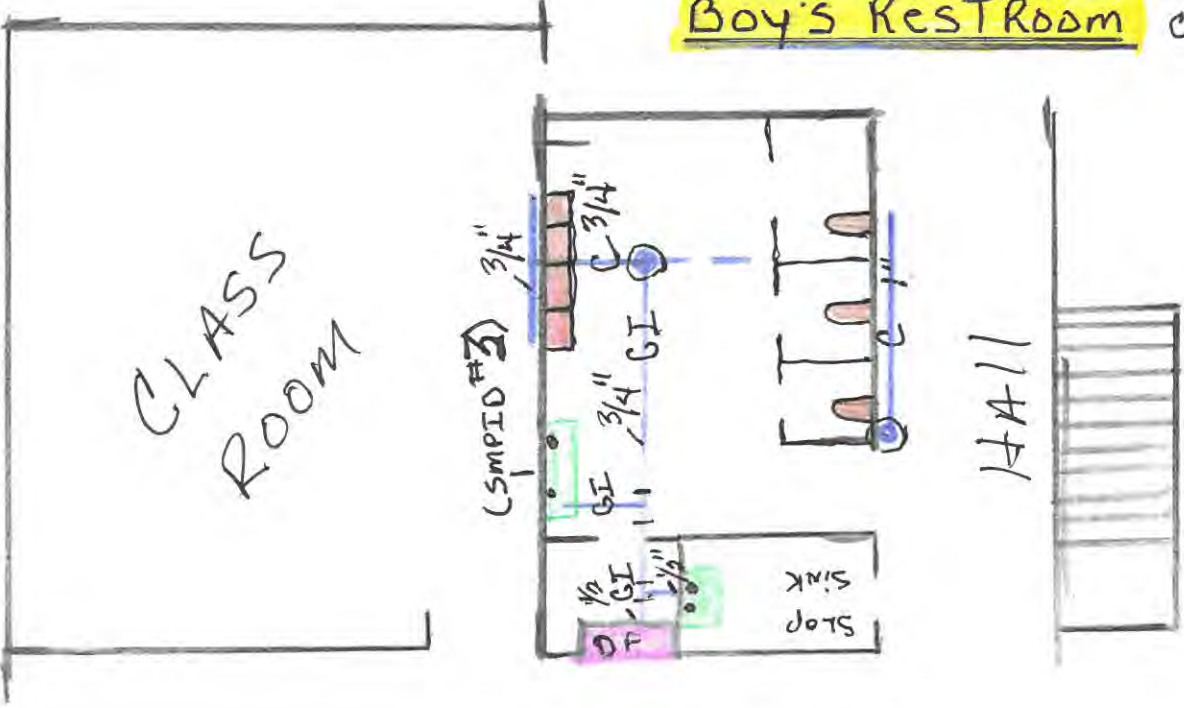

S

HALL

N

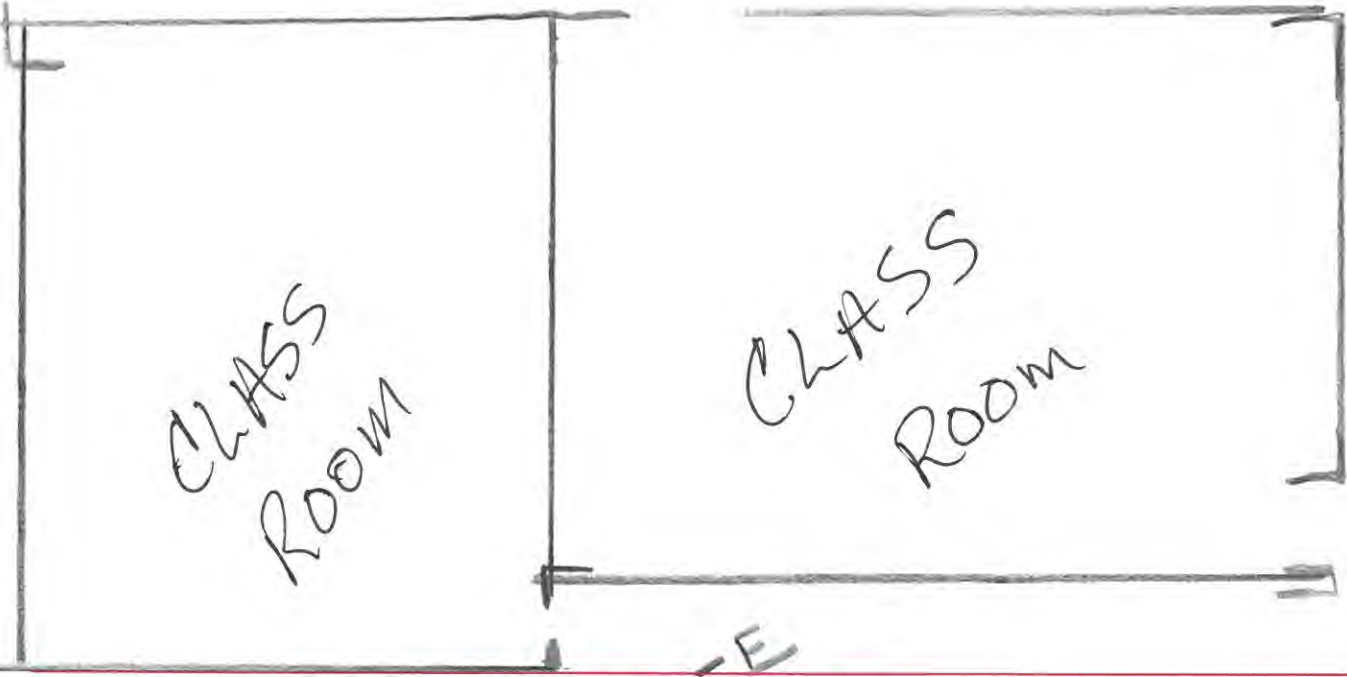

E












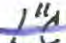
York Elementary School

938 Stonecreek Road SW | New Philadelphia, OH 44663-7555
P 330.364.0770 | F 330.364.0773

PRINCIPAL
Jaclyn Smolinski


ADMINISTRATIVE
ASSISTANT
Tamra Wells


Boy's Restroom cold

-  COLD WATER
-  GALVANIZED WATER LINE
(NO INFORMATION)
-  3/4" COPPER LINE (NO INFORMATION)
-  1/2" COPPER LINE (NO INFORMATION)
-  GALVANIZED IRON WATER LINE
(NO INFORMATION)
-  BATHROOM SINK (2010)
-  SHOP SINK
SPIKOT (NO INFORMATION)
NO SHUT OFFS
-  DRINKING FOUNTAIN (2015)
SHUT OFFS (NO INFORMATION)
-  TOILETS (2010) ^{SHUT OFF} (SLOANS)
-  1" COPPER LINE (2010)

Boy's Restroom

RENOVATION 2010
TOILETS, URINALS, SINK

 WATER LINE
FROM BASEMENT

 URINALS
3/4" SHUT OFFS
(2010)
SLOAN

(SMPID #3)




York Elementary School

938 Stonecreek Road SW | New Philadelphia, OH 44663-7555
P 330.364.0770 | F 330.364.0773

PRINCIPAL
Jaclyn Smolinski

ADMINISTRATIVE
ASSISTANT
Tamra Wells

Boy's Restroom Hot

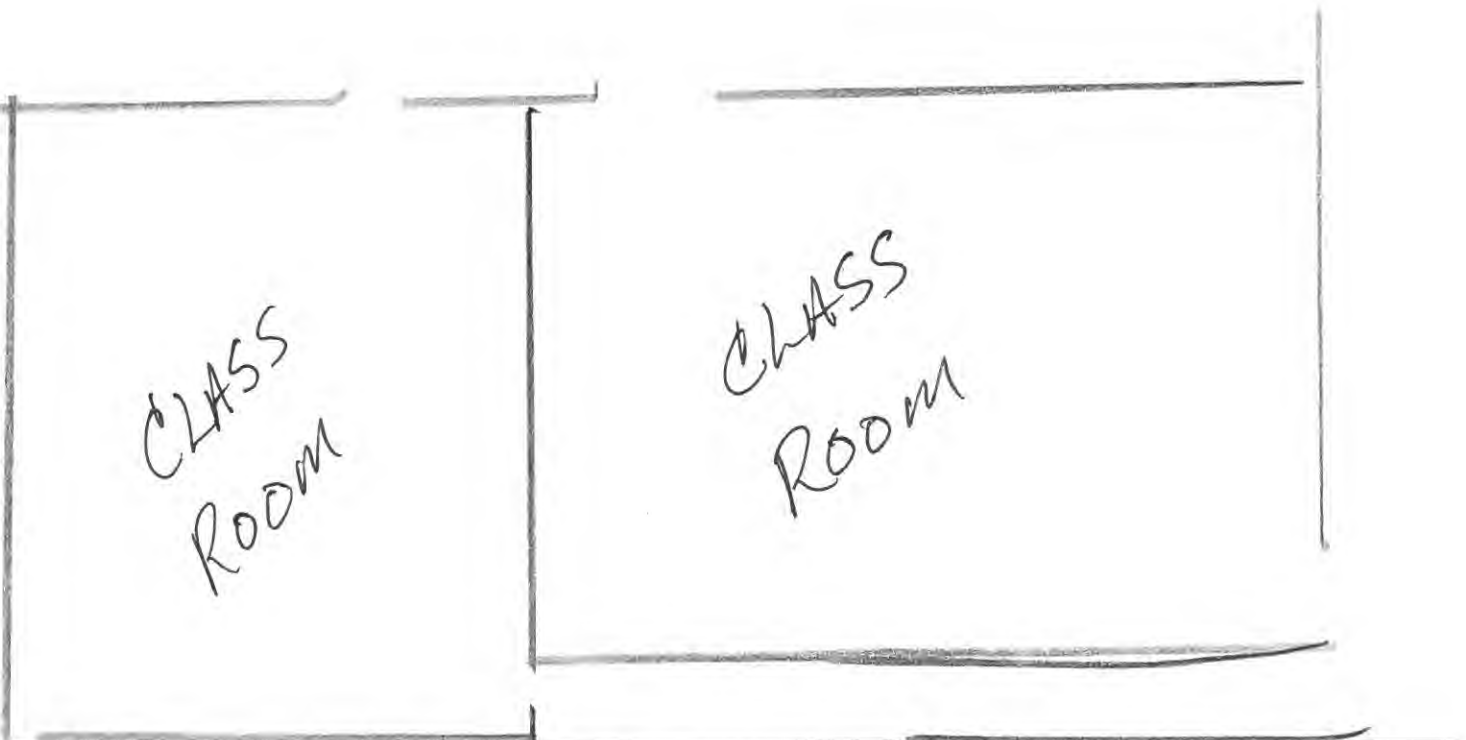










York Elementary School

938 Stonecreek Road SW | New Philadelphia, OH 44663-7555
P 330.364.0770 | F 330.364.0773

PRINCIPAL
Jaclyn Smolinski

ADMINISTRATIVE
ASSISTANT
Tamra Wells

Boy's Rest Room HOT

-  Hot Water
-  GALVANIZED IRON (NO INFORMATION)
-  3/4" GALVANIZED IRON (NO INFORMATION)
-  1/2" GALVANIZED IRON
(NO INFORMATION)
-  BATHROOM SINK (2010)
-  Shop Sink
Spikot (NO INFORMATION)
NO SHUT OFF
-  Hot Water from Basement




York Elementary School

938 Stonecreek Road SW | New Philadelphia, OH 44663-7555
P 330.364.0770 | F 330.364.0773

PRINCIPAL
Jaclyn Smolinski
ADMINISTRATIVE
ASSISTANT
Tamra Wells

GIRL'S RESTROOM HOT

W
1

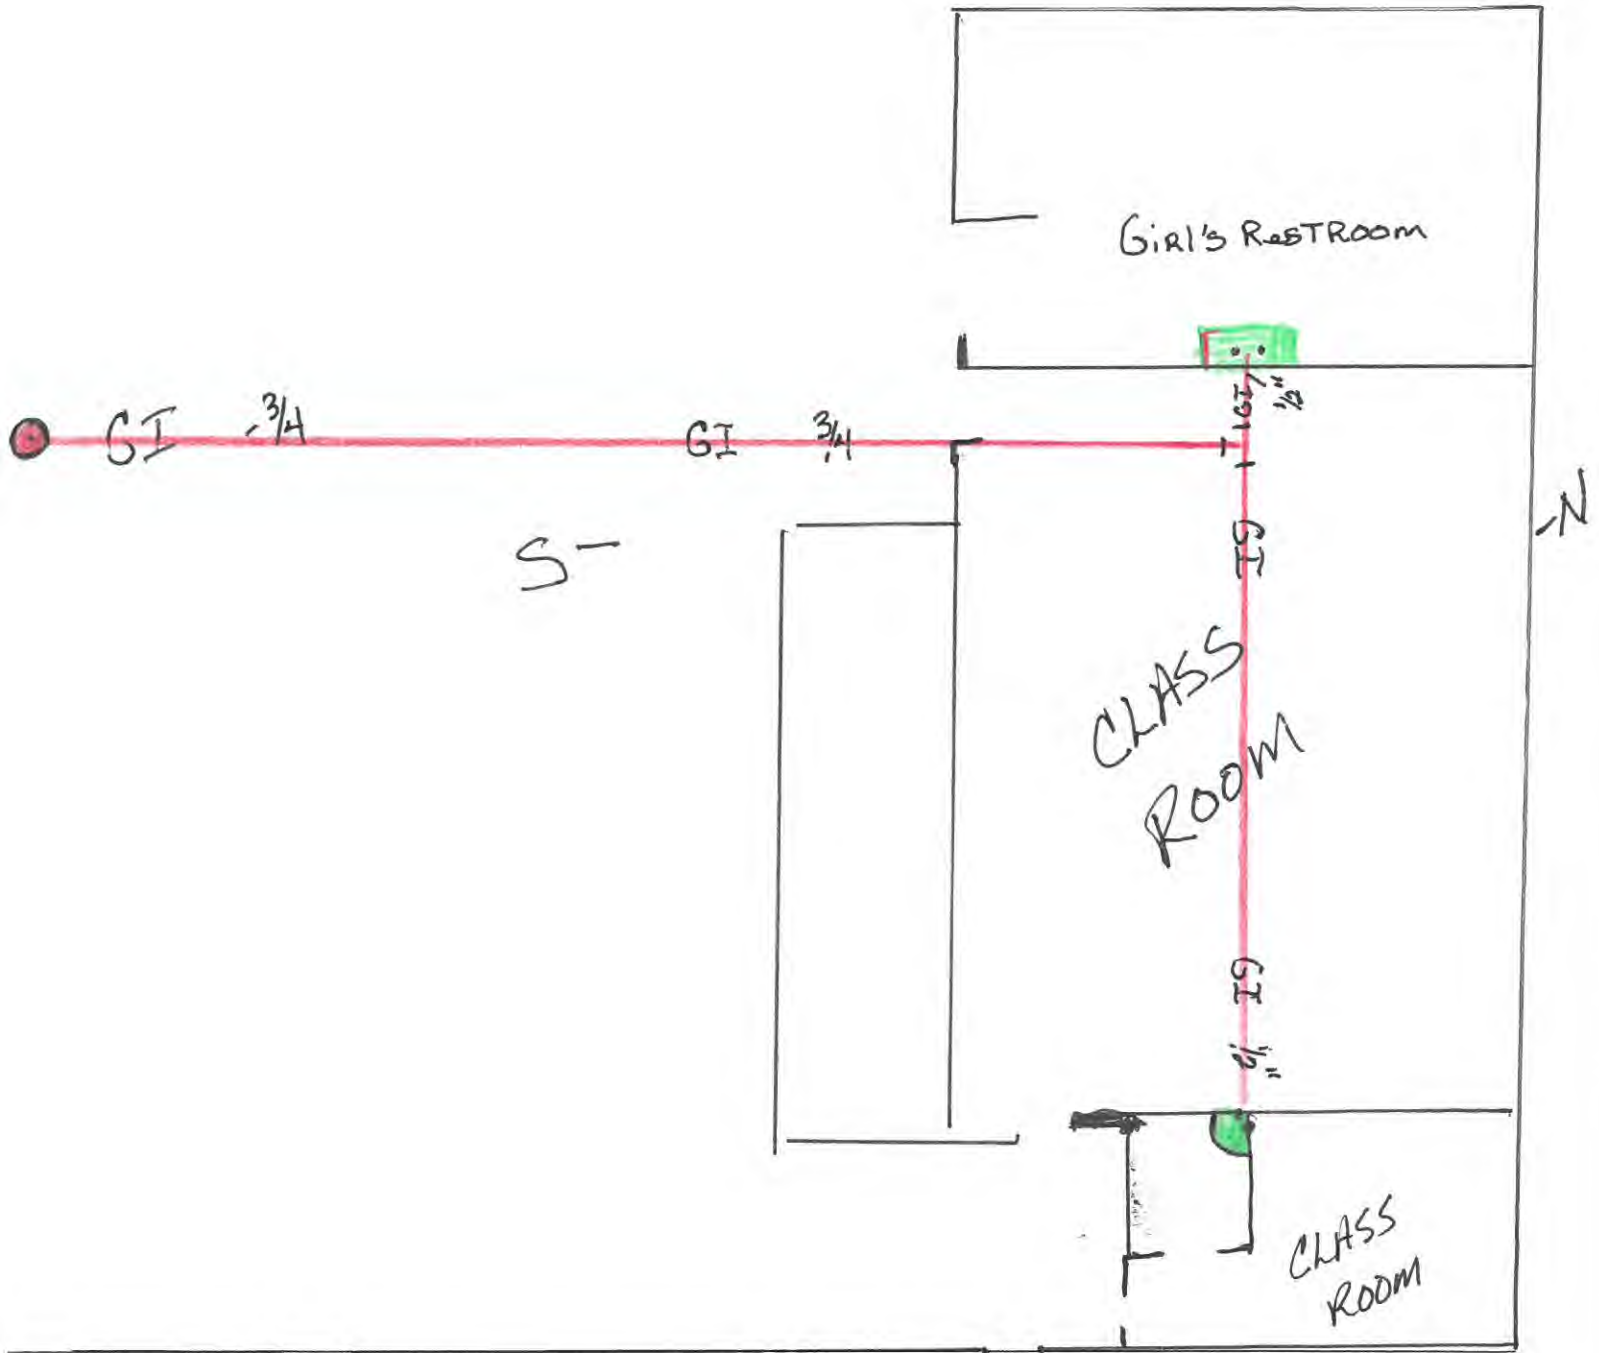



York Elementary School

938 Stonecreek Road SW | New Philadelphia, OH 44663-7555
P 330.364.0770 | F 330.364.0773

PRINCIPAL
Jaclyn Smolinski

ADMINISTRATIVE
ASSISTANT
Tamra Wells

Girl's Restroom HOT

— HOT WATER

~~GI~~ GALVANIZED IRON (NO INFORMATION)

~~3/4"~~ 3/4" GALVANIZED IRON (NO INFORMATION)

~~1/2"~~ 1/2" GALVANIZED IRON (NO INFORMATION)

● HOT WATER FROM BASEMENT

● SINK

1/2" SHUT OFF (NO INFORMATION)

SPiKOT (NO INFORMATION)




York Elementary School

938 Stonecreek Road SW | New Philadelphia, OH 44663-7555
P 330.364.0770 | F 330.364.0773

PRINCIPAL
Jaclyn Smolinski

ADMINISTRATIVE
ASSISTANT
Tamra Wells

Girl's Restroom cold - w

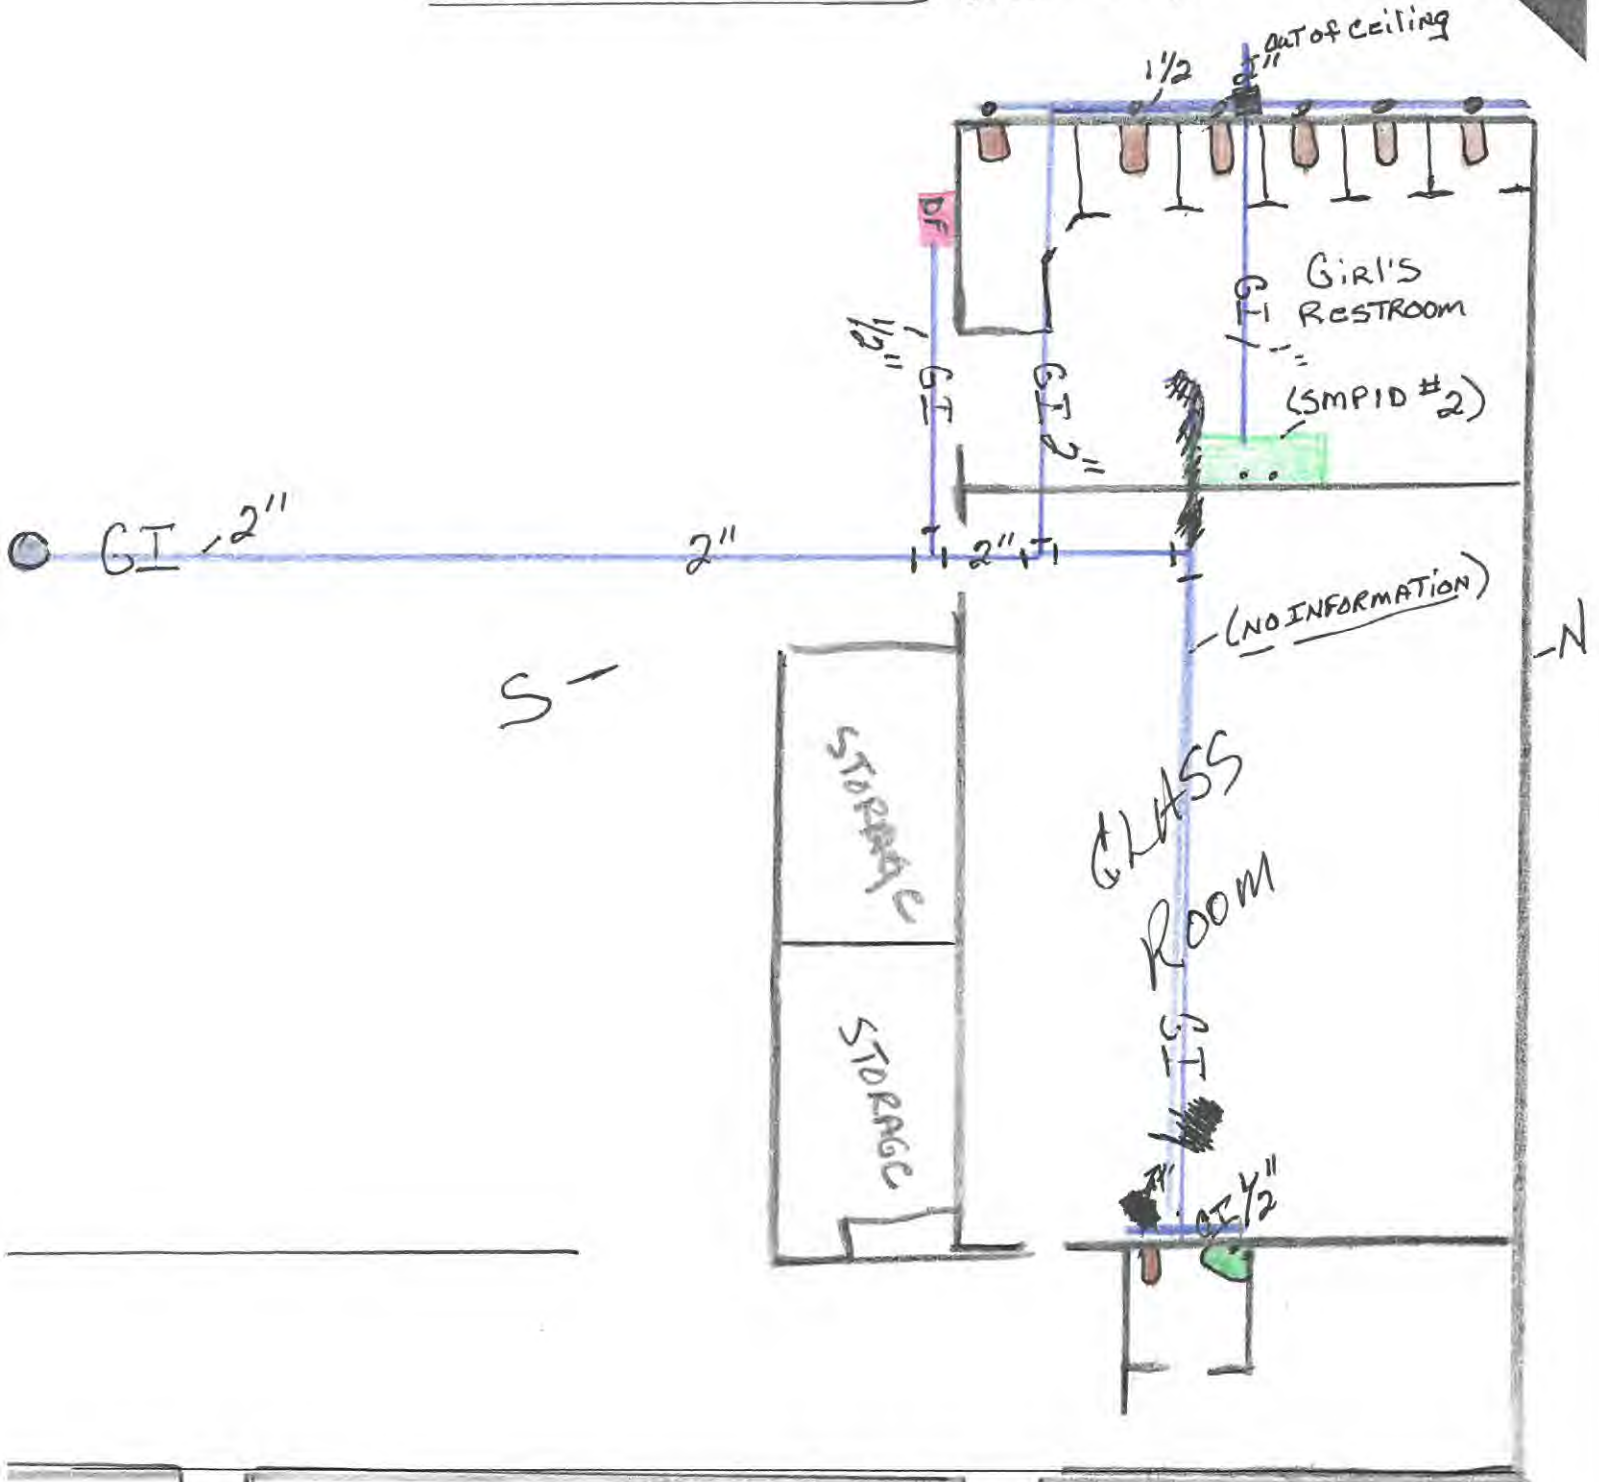



York Elementary School

938 Stonecreek Road SW | New Philadelphia, OH 44663-7555
P 330.364.0770 | F 330.364.0773

PRINCIPAL
Jaclyn Smolinski

ADMINISTRATIVE
ASSISTANT
Tamra Wells

Girl's Restroom cold

- - Coldwater Line
- GI - GALVANIZED IRON (NO INFORMATION)
- +T - T GALVANIZED IRON (NO INFORMATION)
- L - 90° GALVANIZED IRON (NO INFORMATION)
- DF - DRINKING FOUNTAIN (2015)
Shut off.
- .. - SINK (2010)
Shut off
- 1/2" - WATER Line ~~to~~ Toilets
1" Shut offs (2010)
- U - Toilets (2010)
- 1" - TO SINK from ceiling (NO INFORMATION) IN GIRL'S RR
- " - SINK (2010)
Shut off (NO INFORMATION)
- " - 2" Ball Valve to Toilets (2010)
MAIN LINE IN CEILING

*RENOVATION
Girl's Restroom
Toilets
SINK
STALLS
(2010)