

RE: GREEN MEADOW MHP-HANCOCK
CO


Report
Drinking Water Program
Hancock County
PWS ID: OH3200812

RECEIVED
MAR 08 2017
OHIO E.P.A.
N.W.D.O.

GREEN MEADOW MHP

CR 304 (OLD LINCOLN HWY)

N

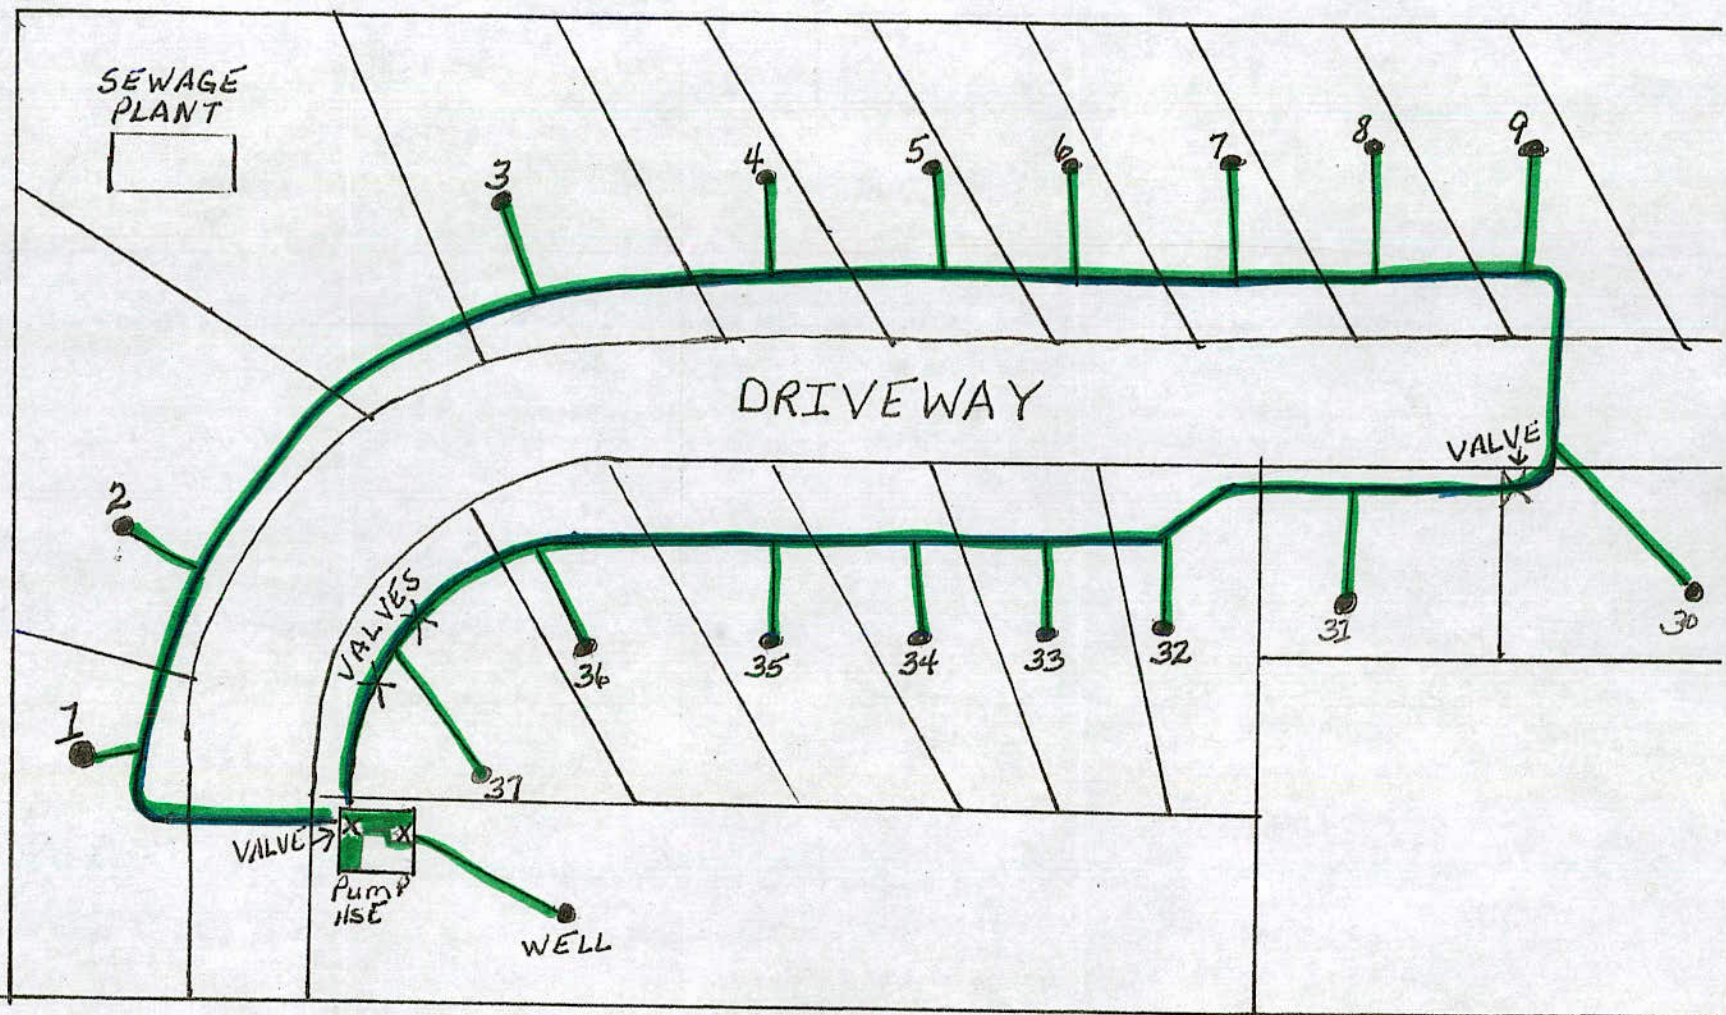

23135 SR 235 ADA, OH 45810

GREEN MEADOW MOBILE HOME PARK LEAD NARRATIVE

Submersible 1 horsepower Goulds pump to potable plastic well line to pump house

All plumbing lines in pump house PVC and plastic including pressure tank and iron treatment system except a brass check valve and shut off valves

All service lines in mobile home park are potable plastic (circa 1970) with brass connections and shut off valves:

Lot #1- to approximately 5' galvanized pipe pedestal to 1979 mobile home with PEX plumbing throughout

Lot #2- to approximately 5' galvanized pipe pedestal to 1987 mobile home with mixed PVC and PEX plumbing

Lot #3- to 1988 mobile home with PEX plumbing throughout

Lot #4- to 1987 mobile home with PEX plumbing throughout

Lot #5- to approximately 5' galvanized pipe pedestal to 1987 mobile home with PEX plumbing throughout

Lot #6- to 1989 mobile home with PEX plumbing throughout

Lot #7- to 1984 mobile home with Polypropylene plumbing throughout

Lot #8- to 1980 mobile home with PVC plumbing throughout

Lot #9- to 1969 mobile home with Copper plumbing with compression fittings throughout

Lot #30- to 1998 mobile home with Polypropylene plumbing to home and PEX plumbing throughout

Lot #31- to 1970 mobile home with Copper plumbing with compression fittings to home and mixed interior PVC and PEX plumbing.

Lot #32- to approximately 5' galvanized pipe pedestal to 1980 mobile home with Polypropylene plumbing to home and PEX plumbing throughout

Lot #33- to approximately 5' galvanized pipe pedestal to 1989 mobile home with Polypropylene plumbing throughout

Lot #34- to 1974 mobile home with PEX to home and PVC plumbing throughout

Lot #35- to 1993 mobile home with PVC plumbing throughout

Lot #36- to 2007 mobile home with PVC plumbing throughout

Lot #37- to 1975 mobile home with PVC plumbing throughout

Water samples are taken from the finished water spigot in the northeast corner of the pump house.

Lead and Copper samples are taken on a triennial schedule from a kitchen or bath sink or tub in mobile homes on Lots #1, 2, 4, 30, and 32

Lot #1- Michael and Lorie Buzard – (567)-293-0048

Lot #2 - Elizabeth Hardesty – (419)-302-1142

Lot #4 - James and Tamera Ward – (419)-672-1201

Lot #30 – Gary and Irene Guyton- (419)-634-0363

Lot #32 – Steve Roznowski – (419)-634-8947