


RECEIVED  
MAR 09 2017  
OHIO EPA NEDO



OVERALL: Orange Lake Water  
Entity: Orange Lake Water  
Doc Type: Report  
Doc Subtype: QA/QC  
Program: Trumbull  
County: OH  
Secondary ID: 7804512

**LAND DESIGN consultants**  
www.LDCinc.net  
ENGINEERS PLANNERS SURVEYORS  
9025 Osborne Drive, Mentor, Ohio 44060  
TEL (440) 255 8463 (440) 951-1AND  
FAX (440) 255 9575

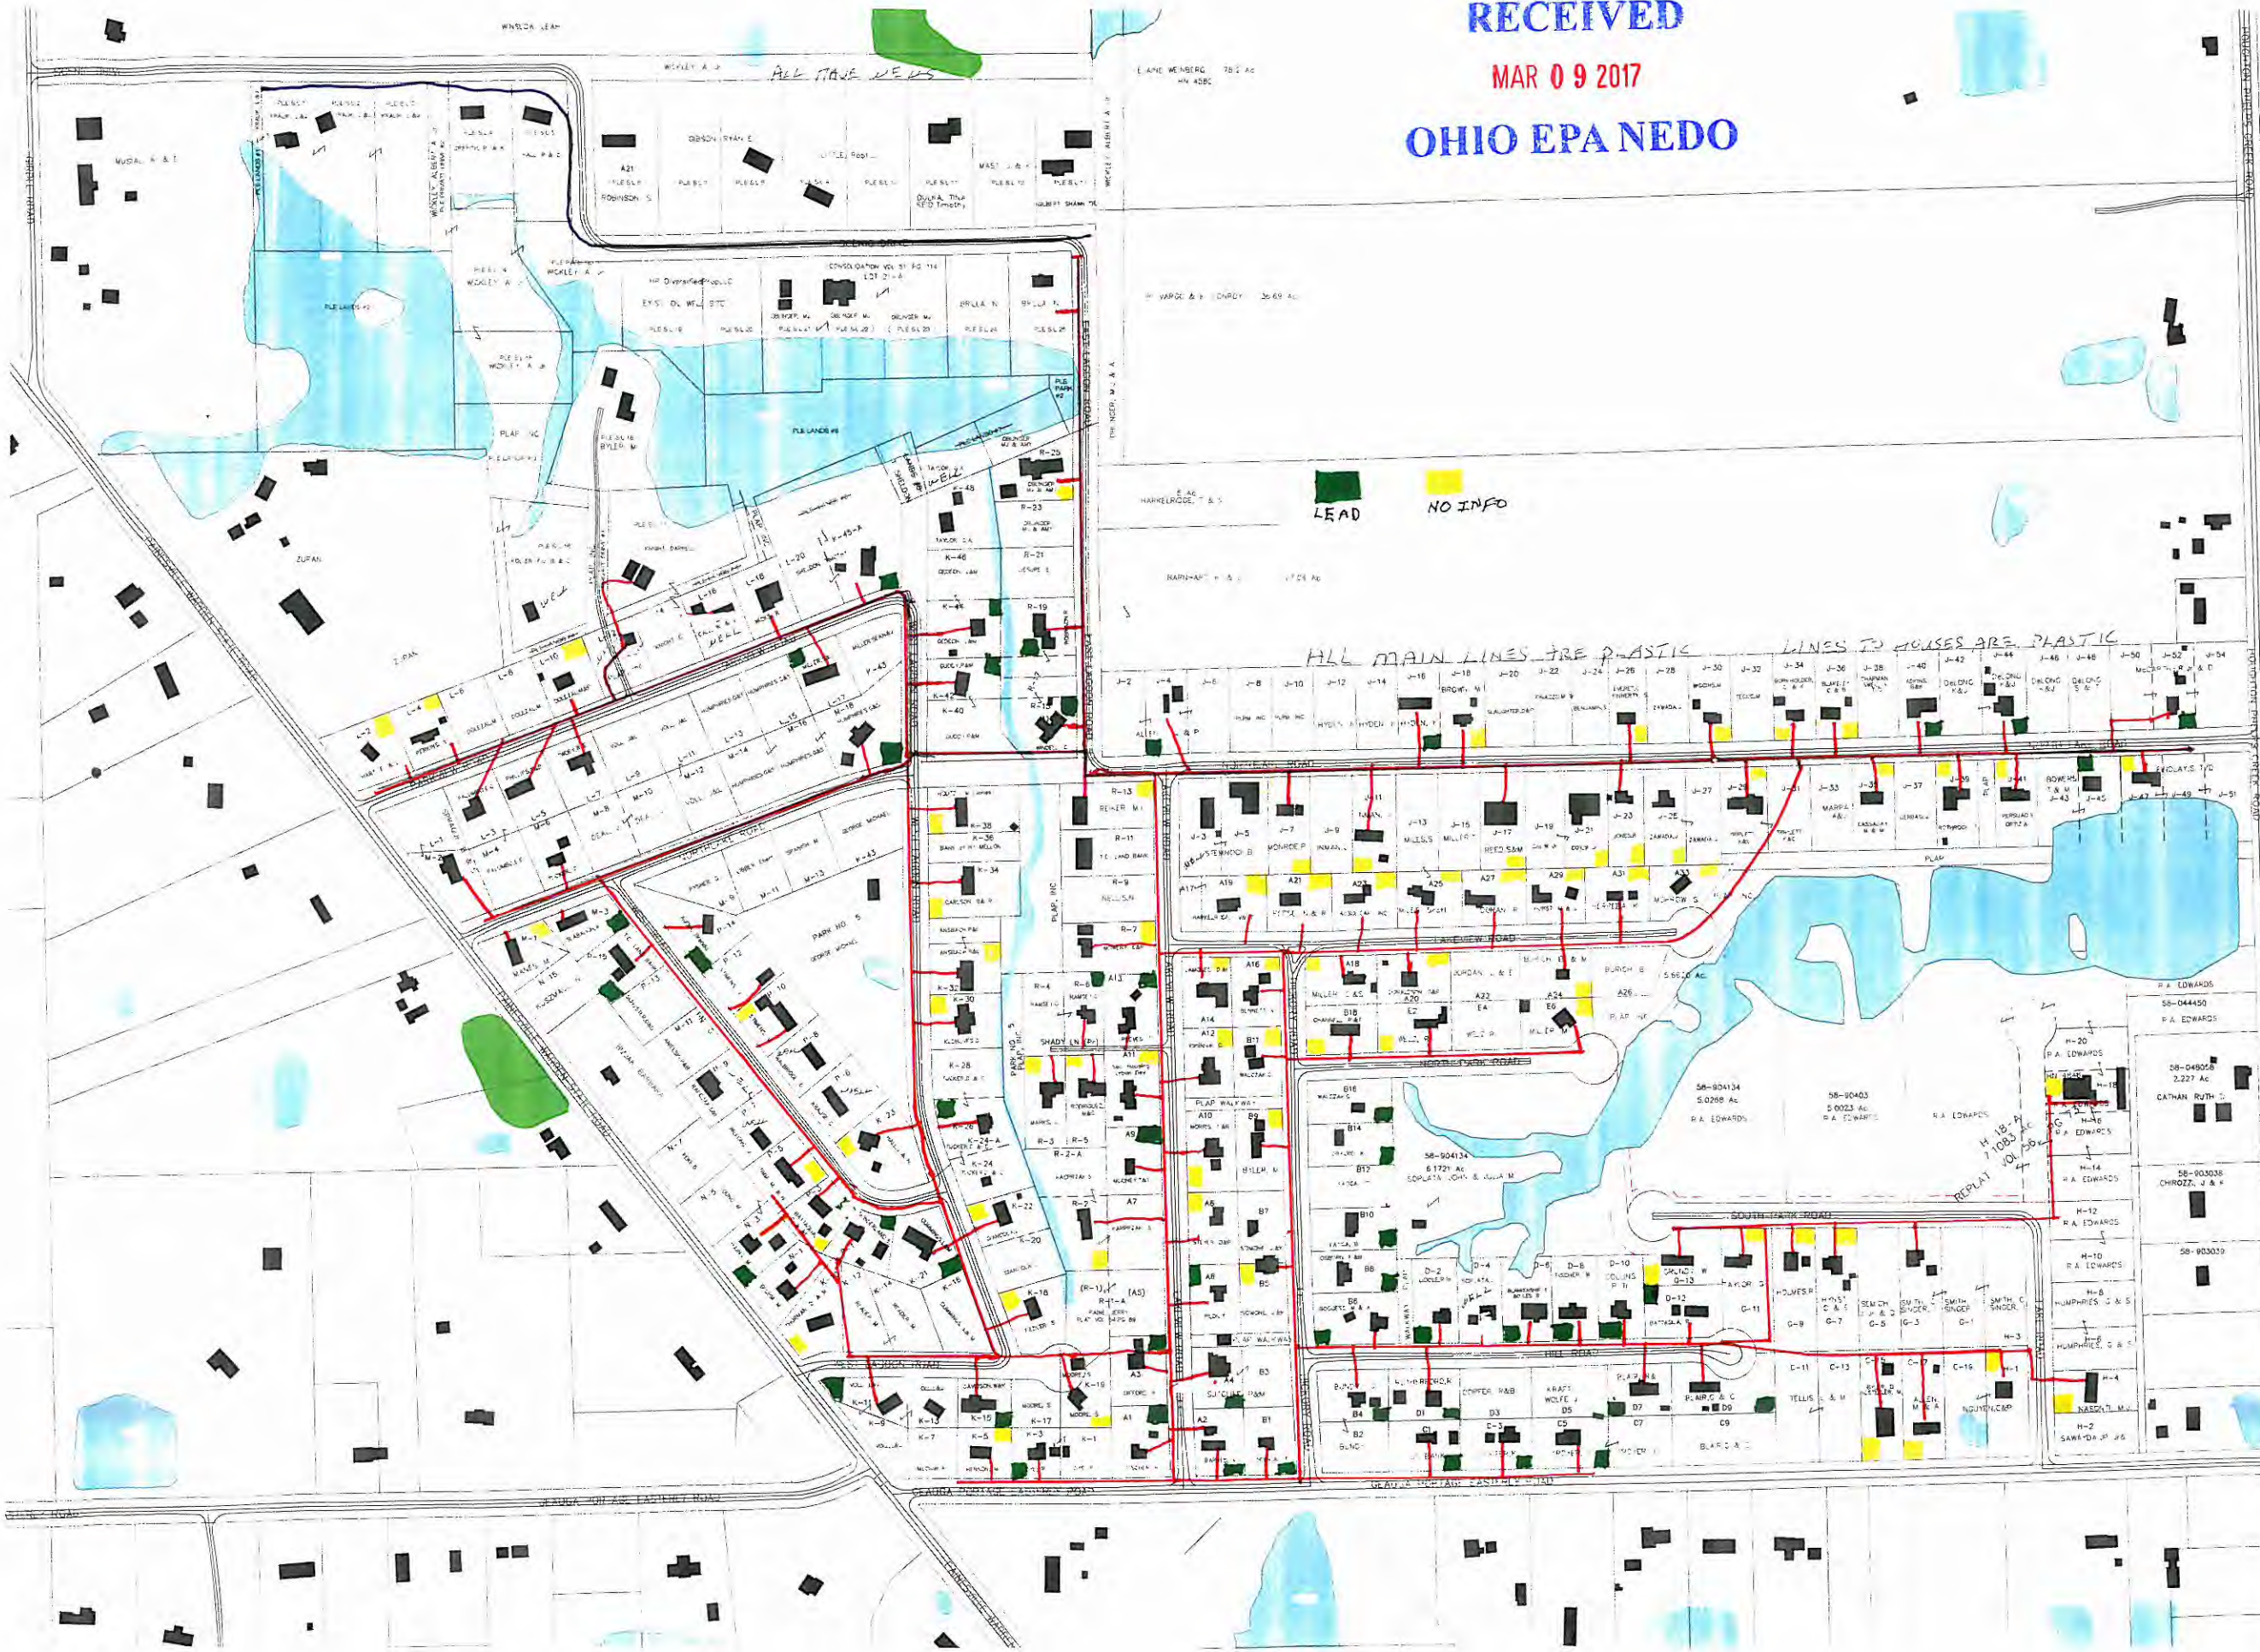

DATE 1/18/2017  
SCALE HOR 1"=150'  
VERT  
FILENAME Plalan Map  
COMPUTER C WCV  
TAB NAME Map

Plalan Lakes Development  
Topographic & Property  
West Farmington Twp - Trumbull Co. - Ohio