


# Villa Vista Mobile Home Park

PWS 4504312

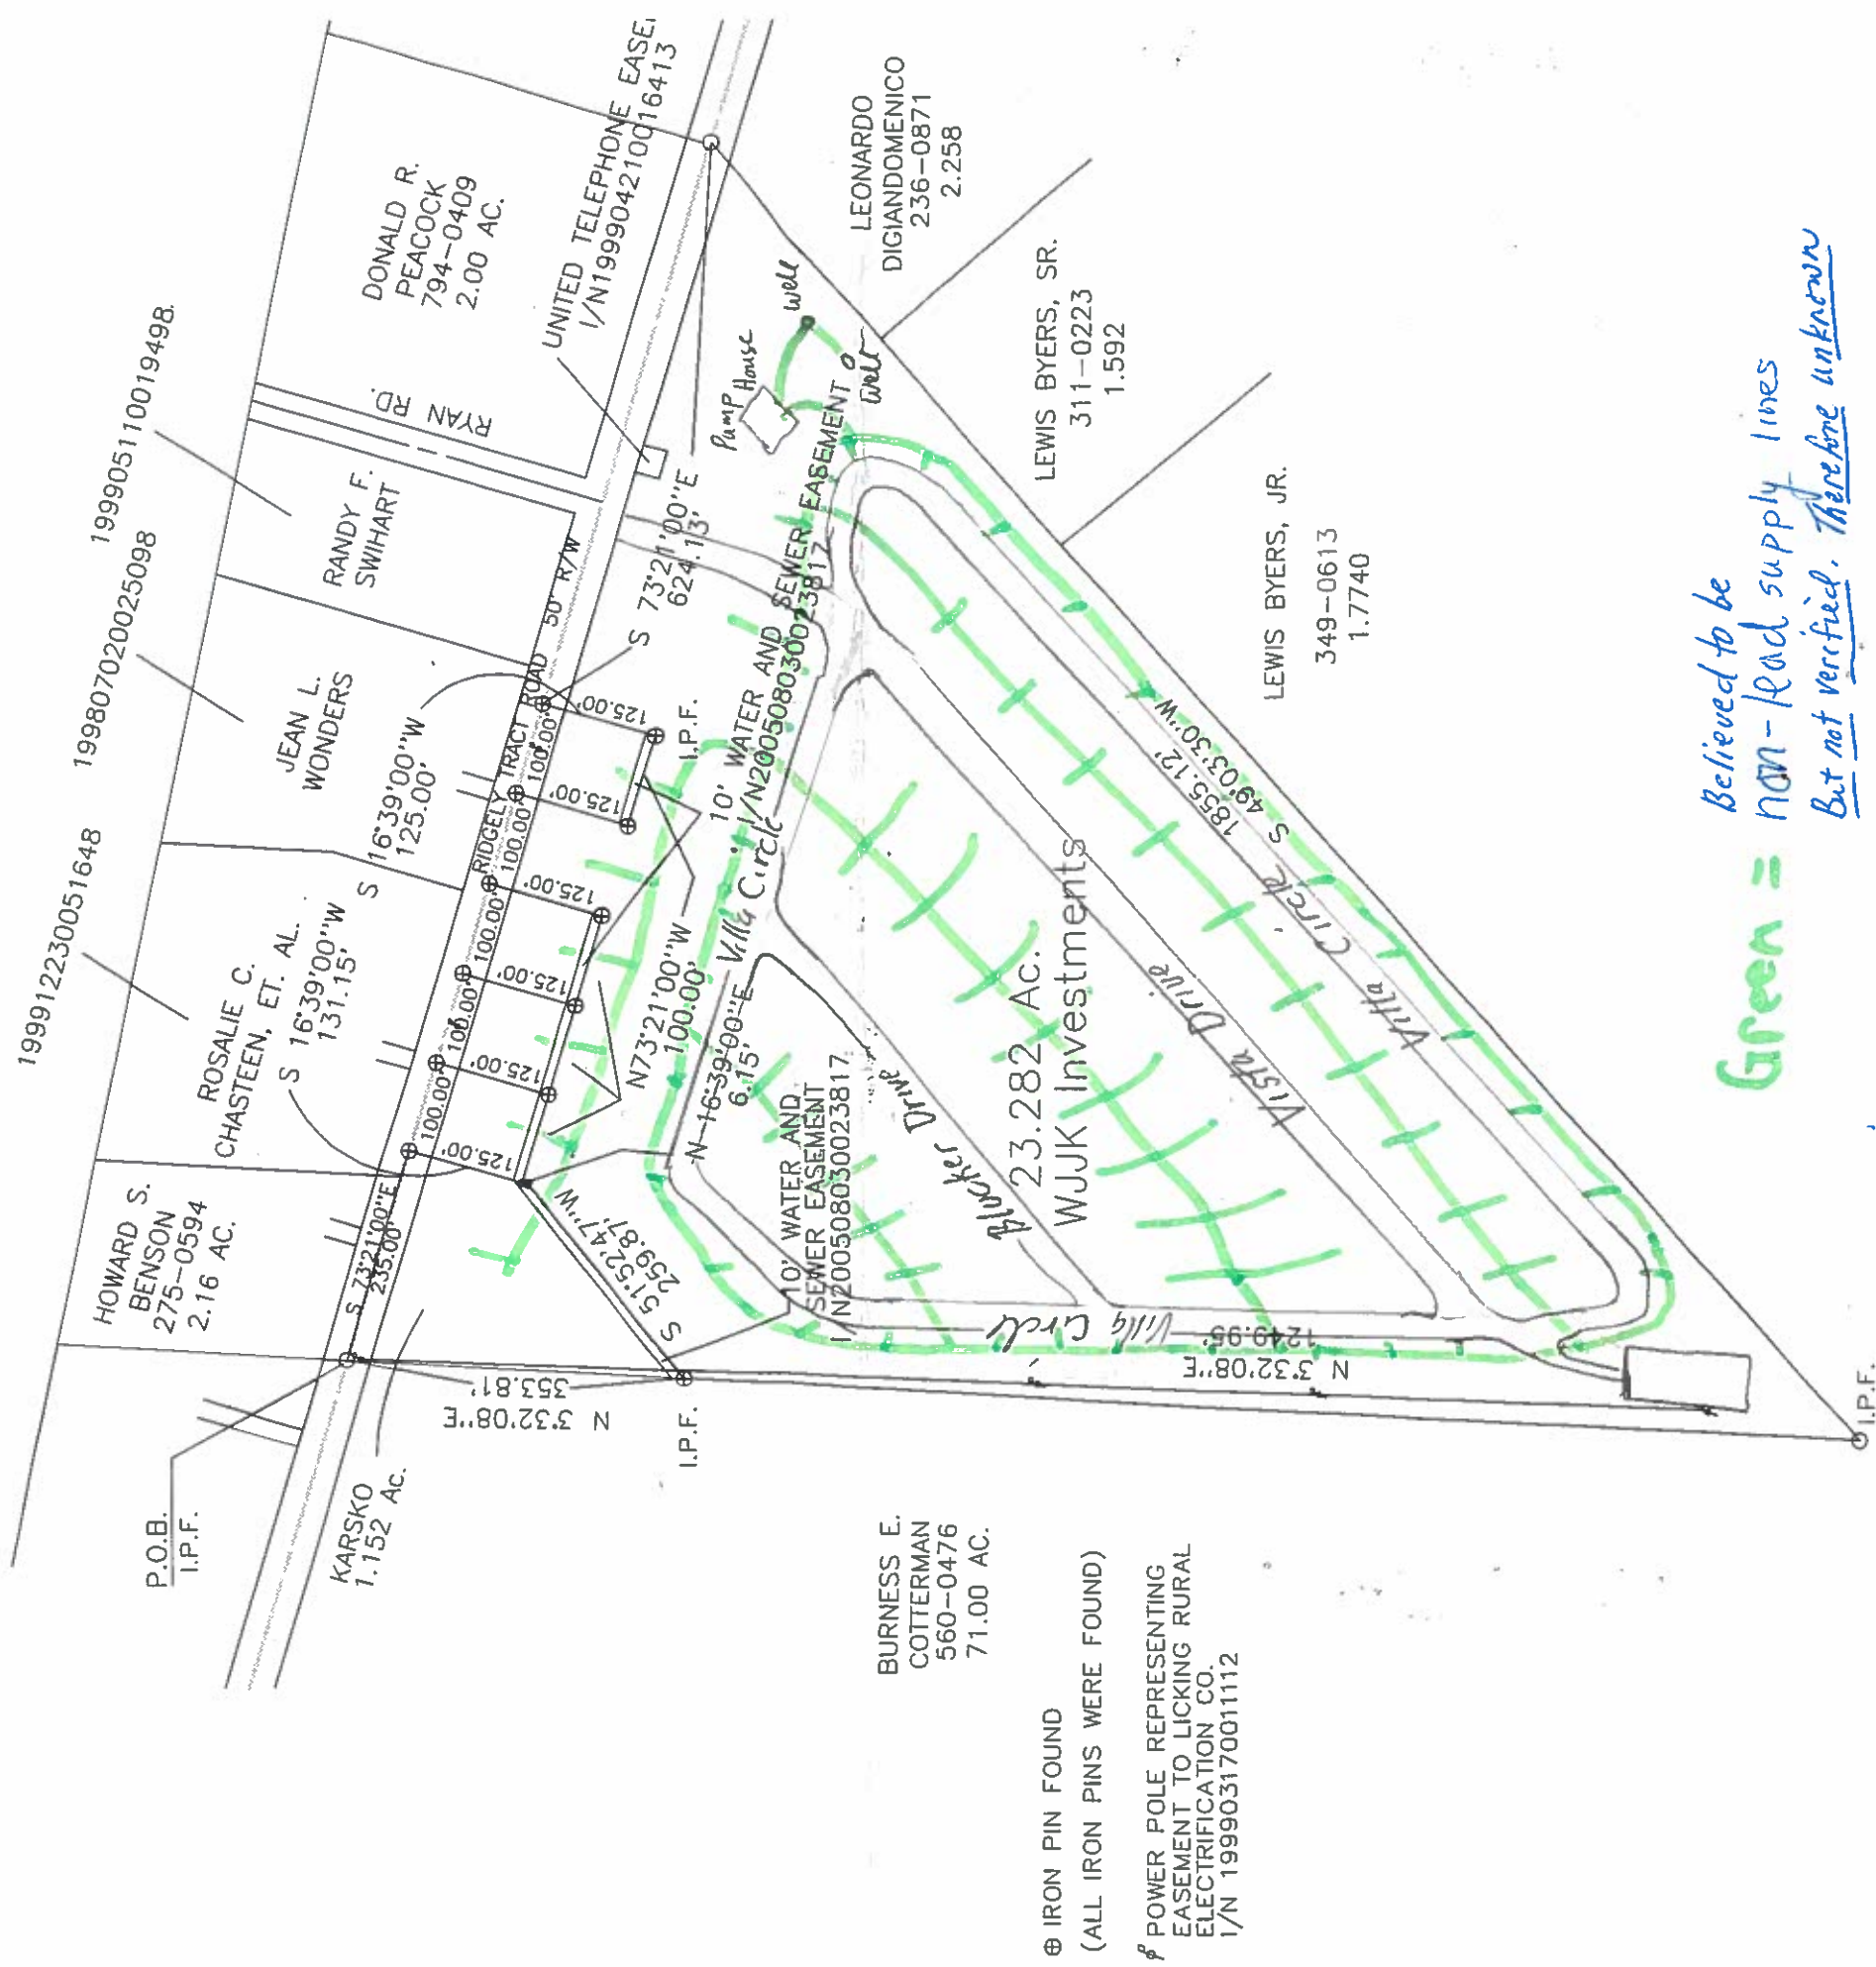

Joe Phelan Mar 9, 2017