




Google Earth

feet
km

4000
1



Harbor Hills Water System - North
Licking County

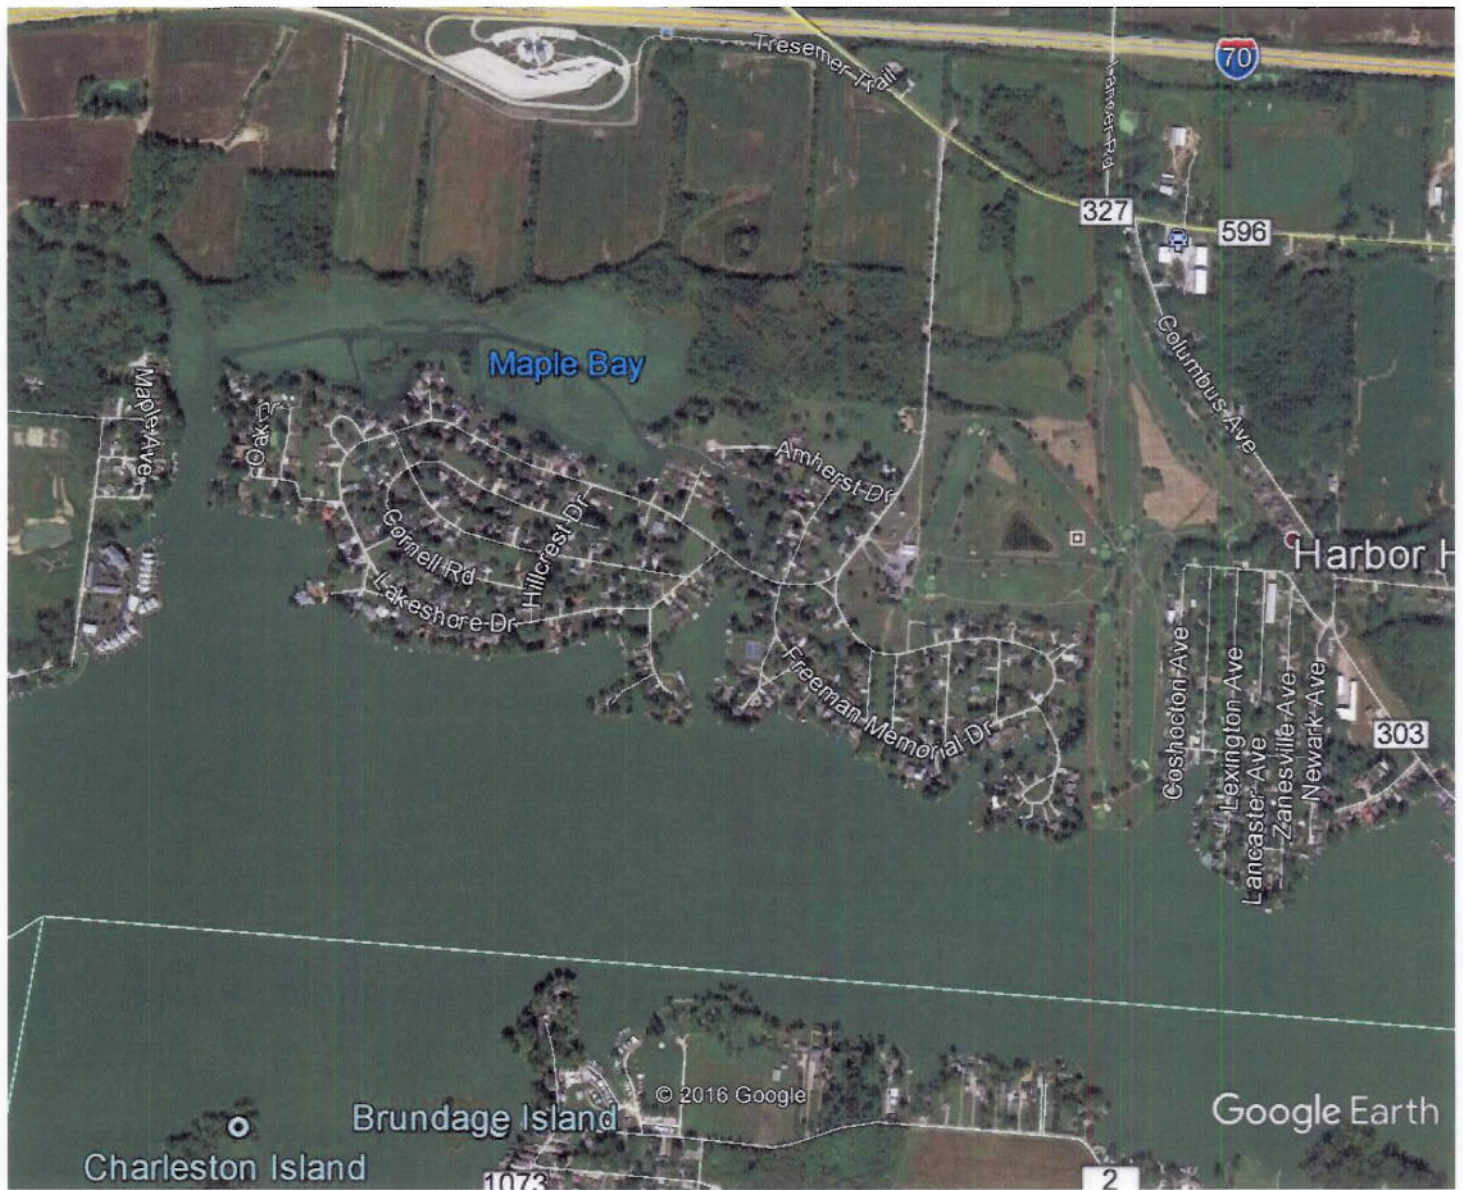

Google Earth

feet 4000
km 1



Harbor Hills Water System - South
Licking County

Lead Mapping Narrative

Tap Cards were used as primary reference for creating Lead mapping. When available the service line material listed on the tap card was used for the determination of whether service line is possible lead or not. If the material used for the service line was not listed on the tap card then the tap date was as a reference for whether the line is possible lead. If the structure was built before 1998 then it was assumed to have lead or lead solder. If the service line material was not listed and there was no date on tap card then it was color coded no information. Licking County will continue to update the mapping information when discovered by routine maintenance of lines and meter replacement.

Map Legend



Lead



Non-Lead



No Information




Licking County Tax Parcel Viewer





Licking County Tax Parcel Viewer

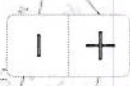



Licking County Tax Parcel Viewer

LOT NO 7



SEC NO 7







Licking County Tax Parcel Viewer





Licking County Tax Parcel Viewer

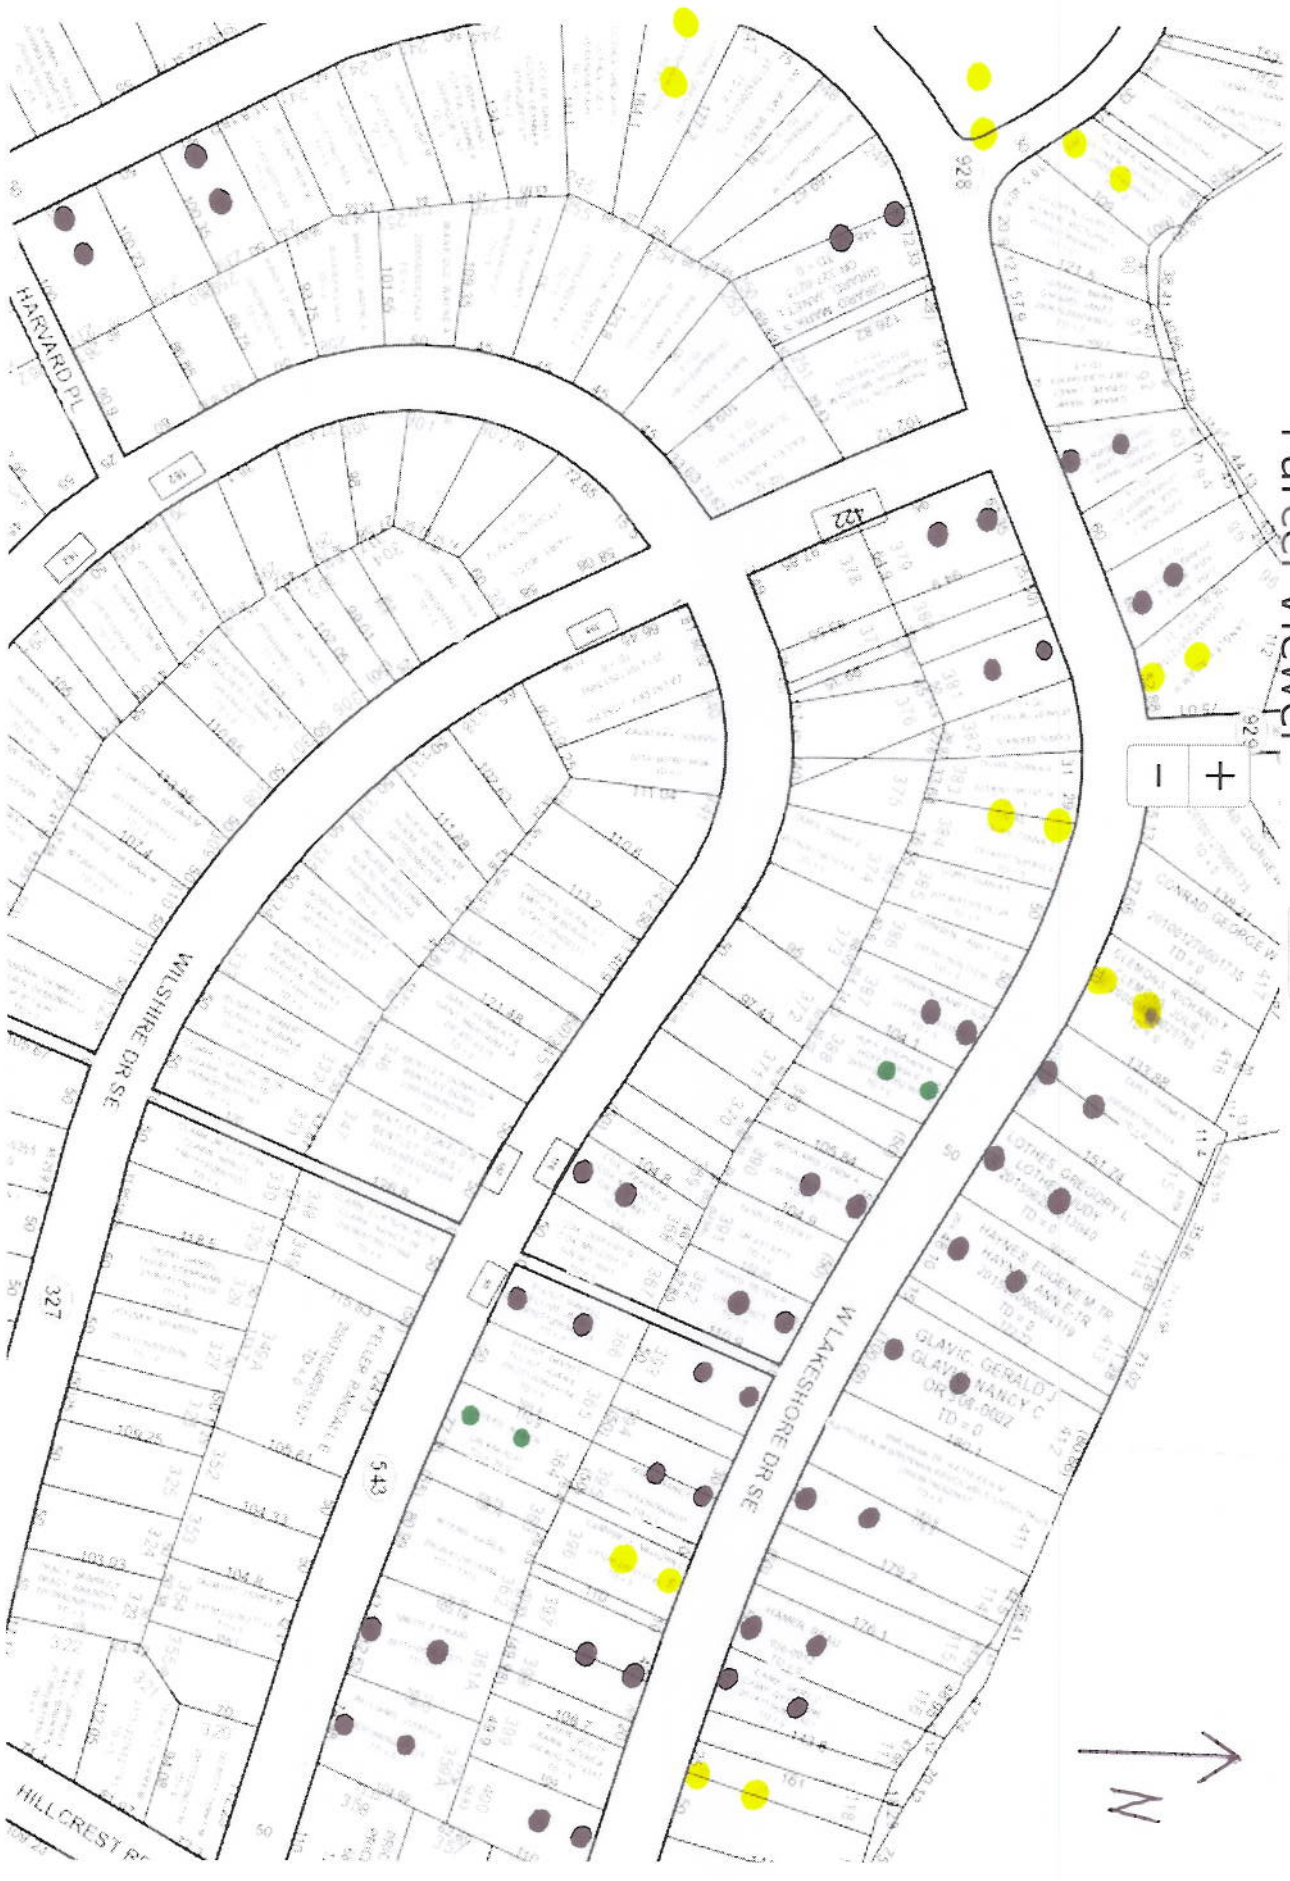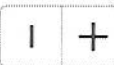



Licking County Tax Parcel Viewer



LC





Licking County Tax Parcel Viewer



40061260002579
ID = 0



GRAHAM CLAY P
GRAHAM-BRYANH
201212050026778 -
ID = 0




Licking County Tax Parcel Viewer





Licking County Tax Parcel Viewer

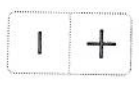

ASSOC.
457-0.482
TD # 0

RESERVE 50'





Licking County Tax Parcel Viewer



HARBOR HILLS COUNTRY CLUB INC.

612-0111
TD = 0



2






Licking County Tax Parcel Viewer



7




LOT NO 29
LOT NO 28

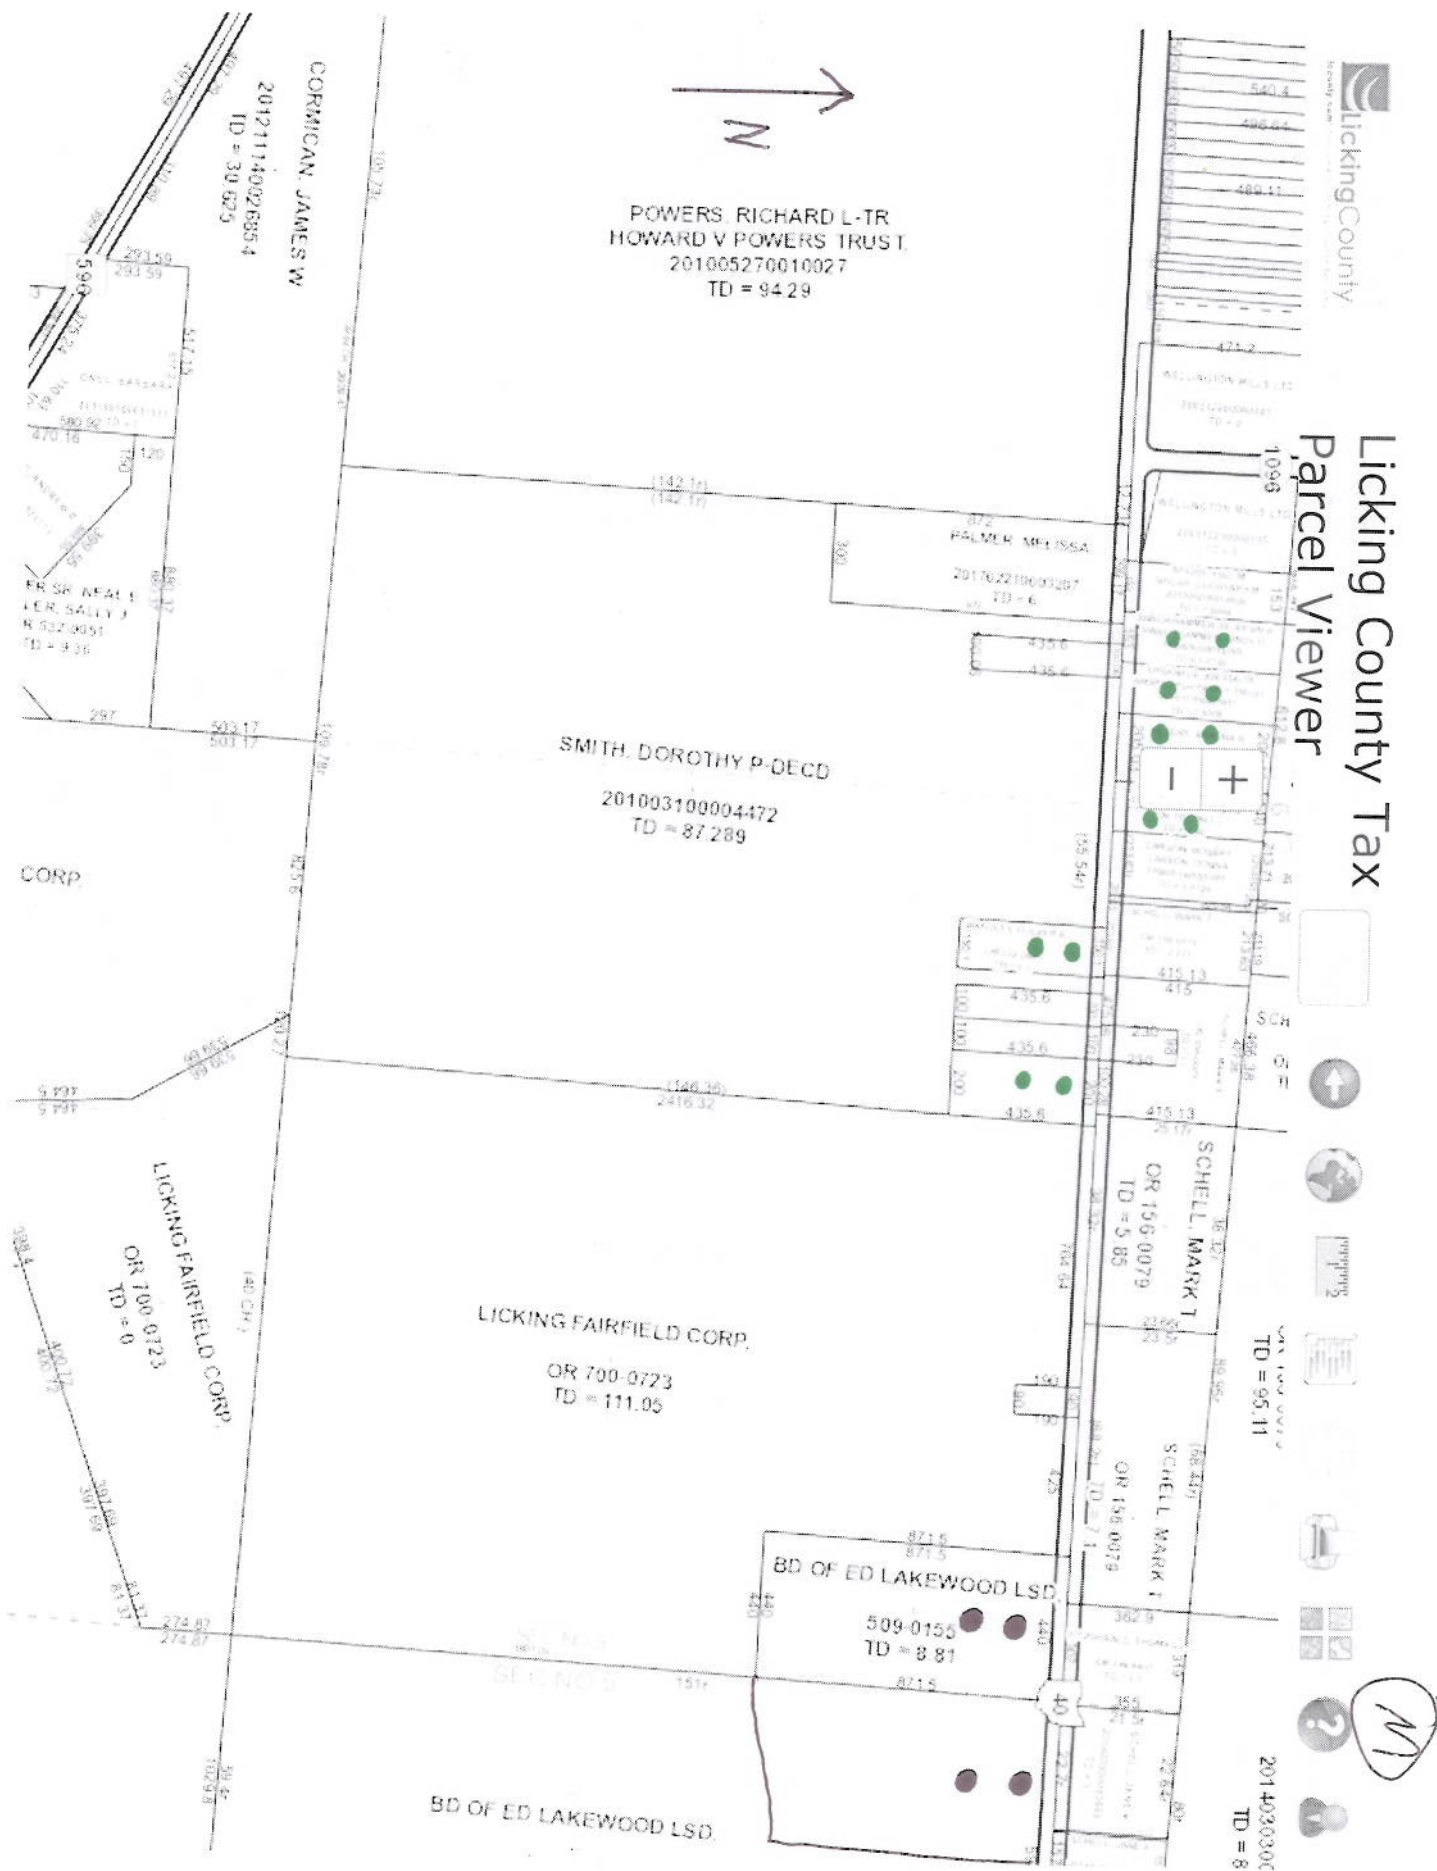



Licking County Tax Parcel Viewer

TD = 30.625

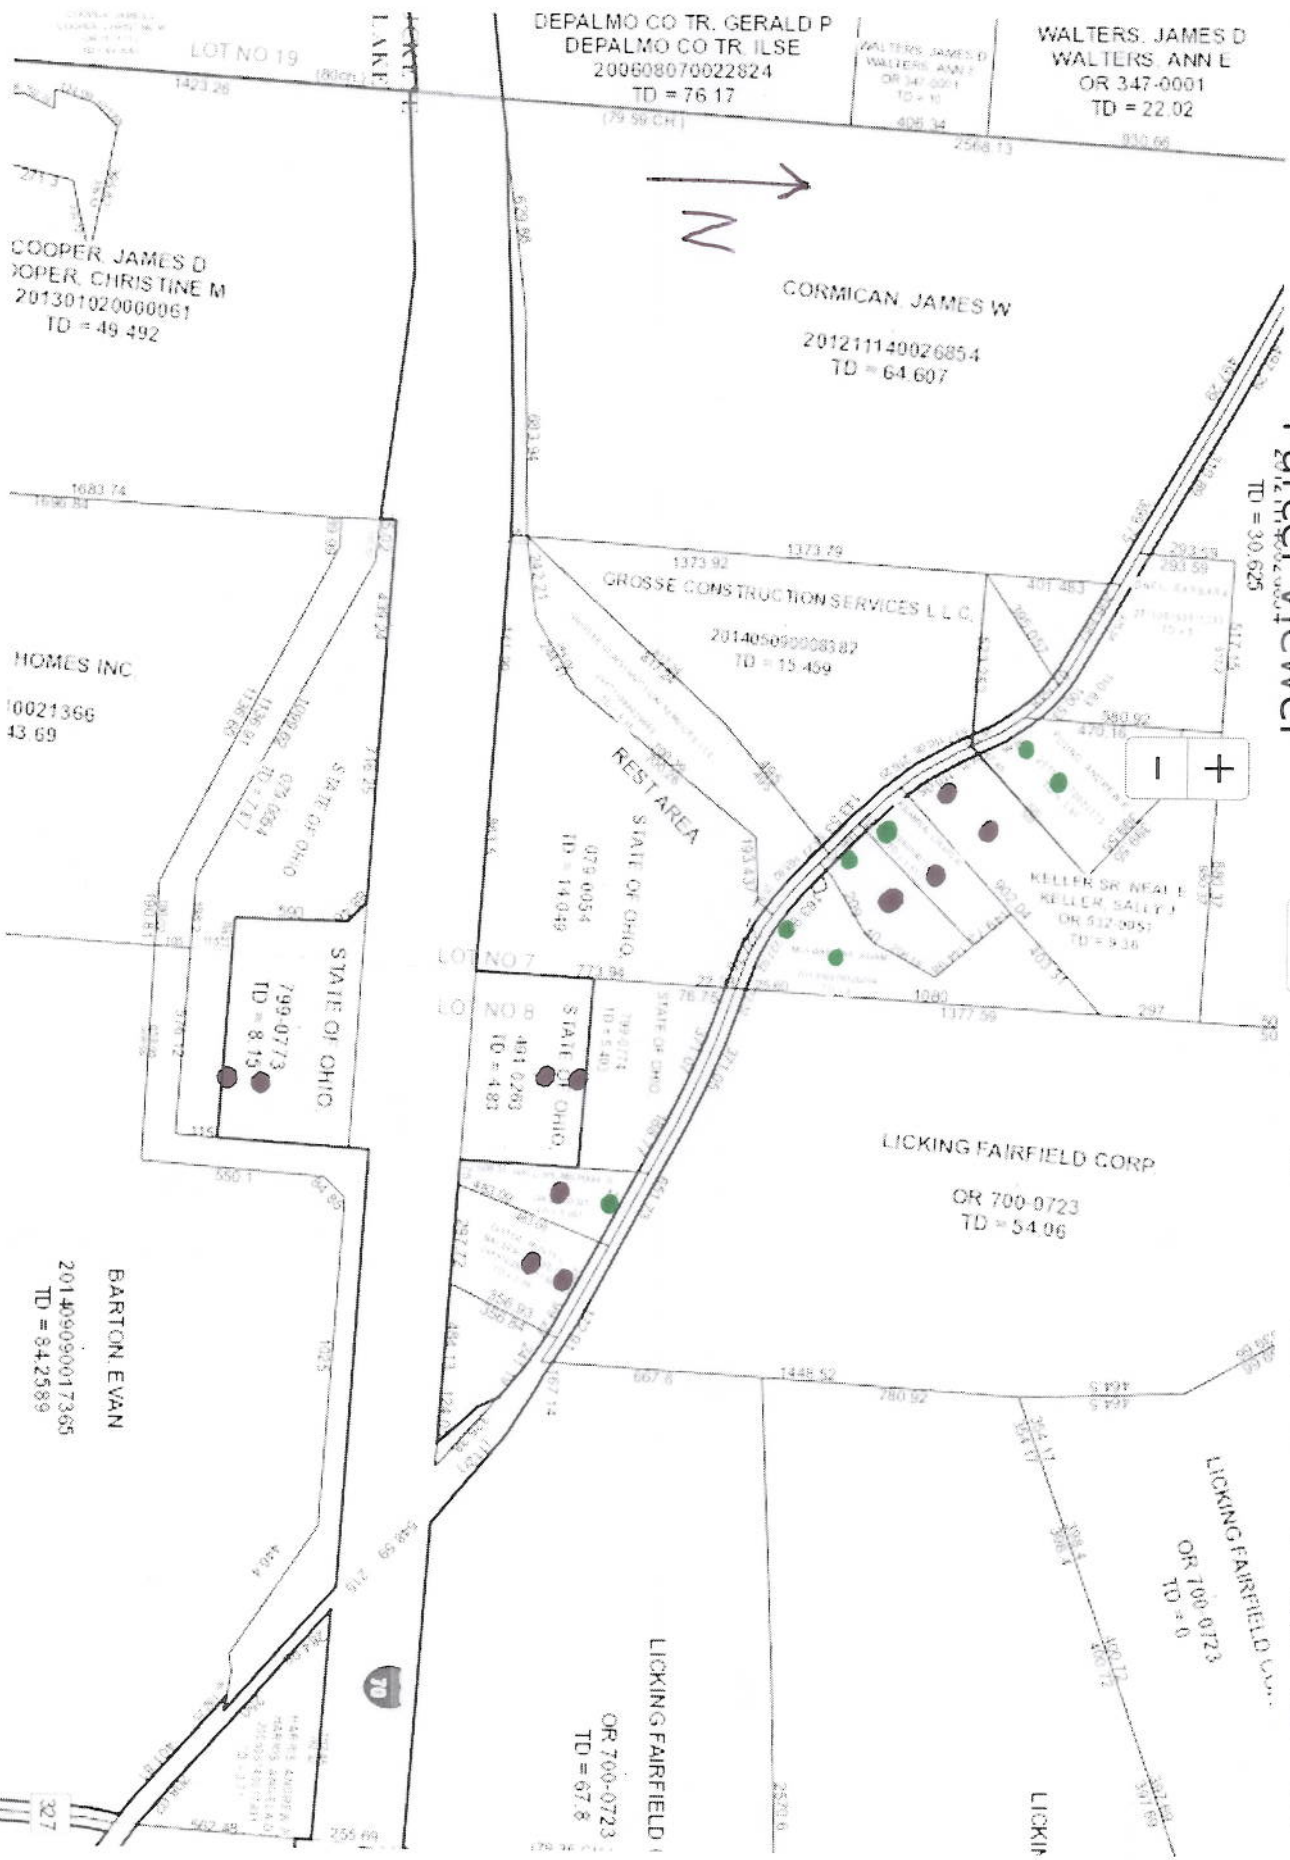




CALEWARTS, CAROLE

OR 313-0124
TD = 11.6


Licking County Tax Parcel Viewer



0

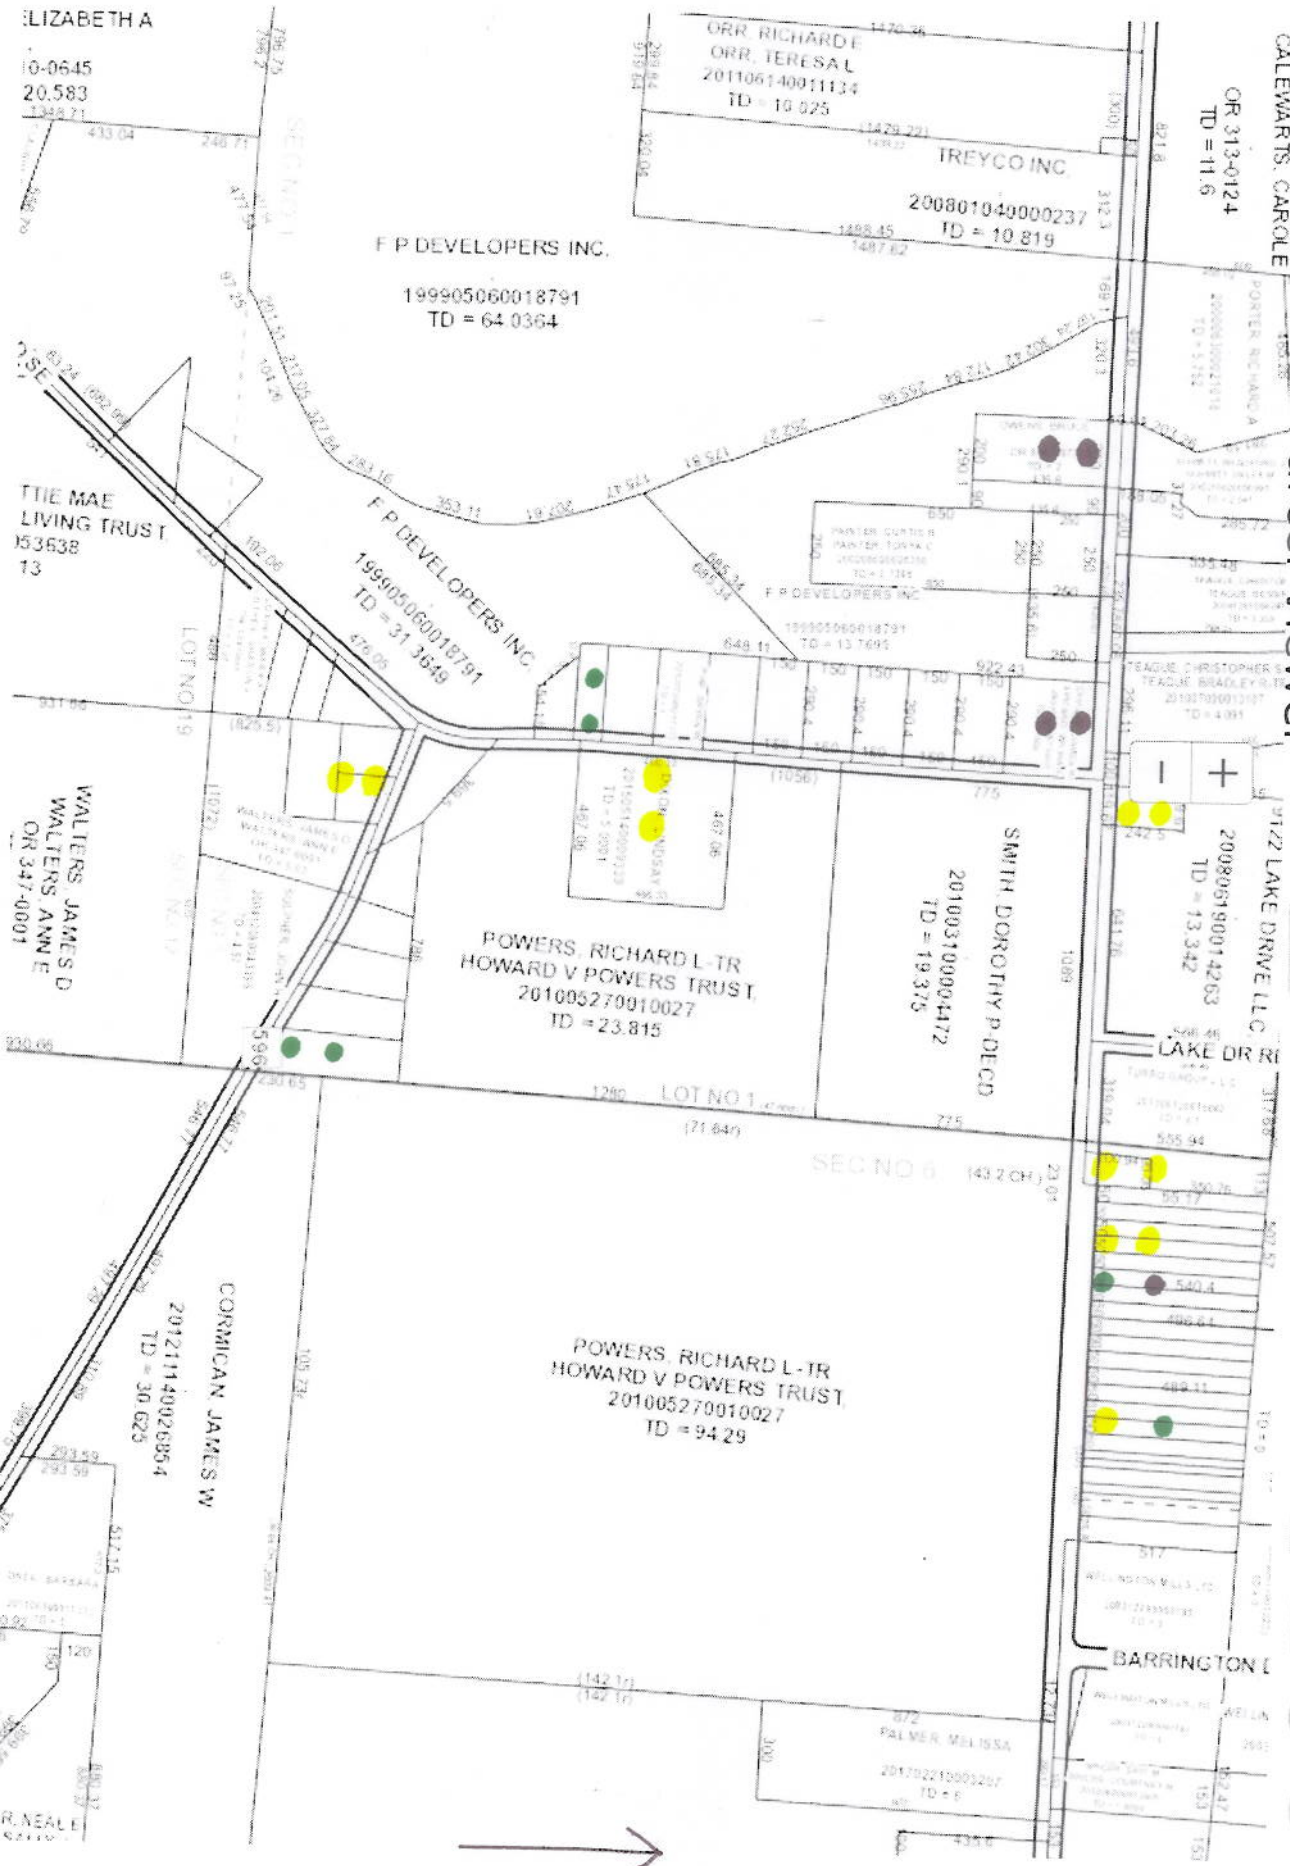


March 8, 2017

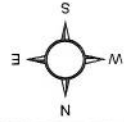


0 500 Feet
0.09 Miles

LICKING COUNTY TAX MAP

ISDEPT

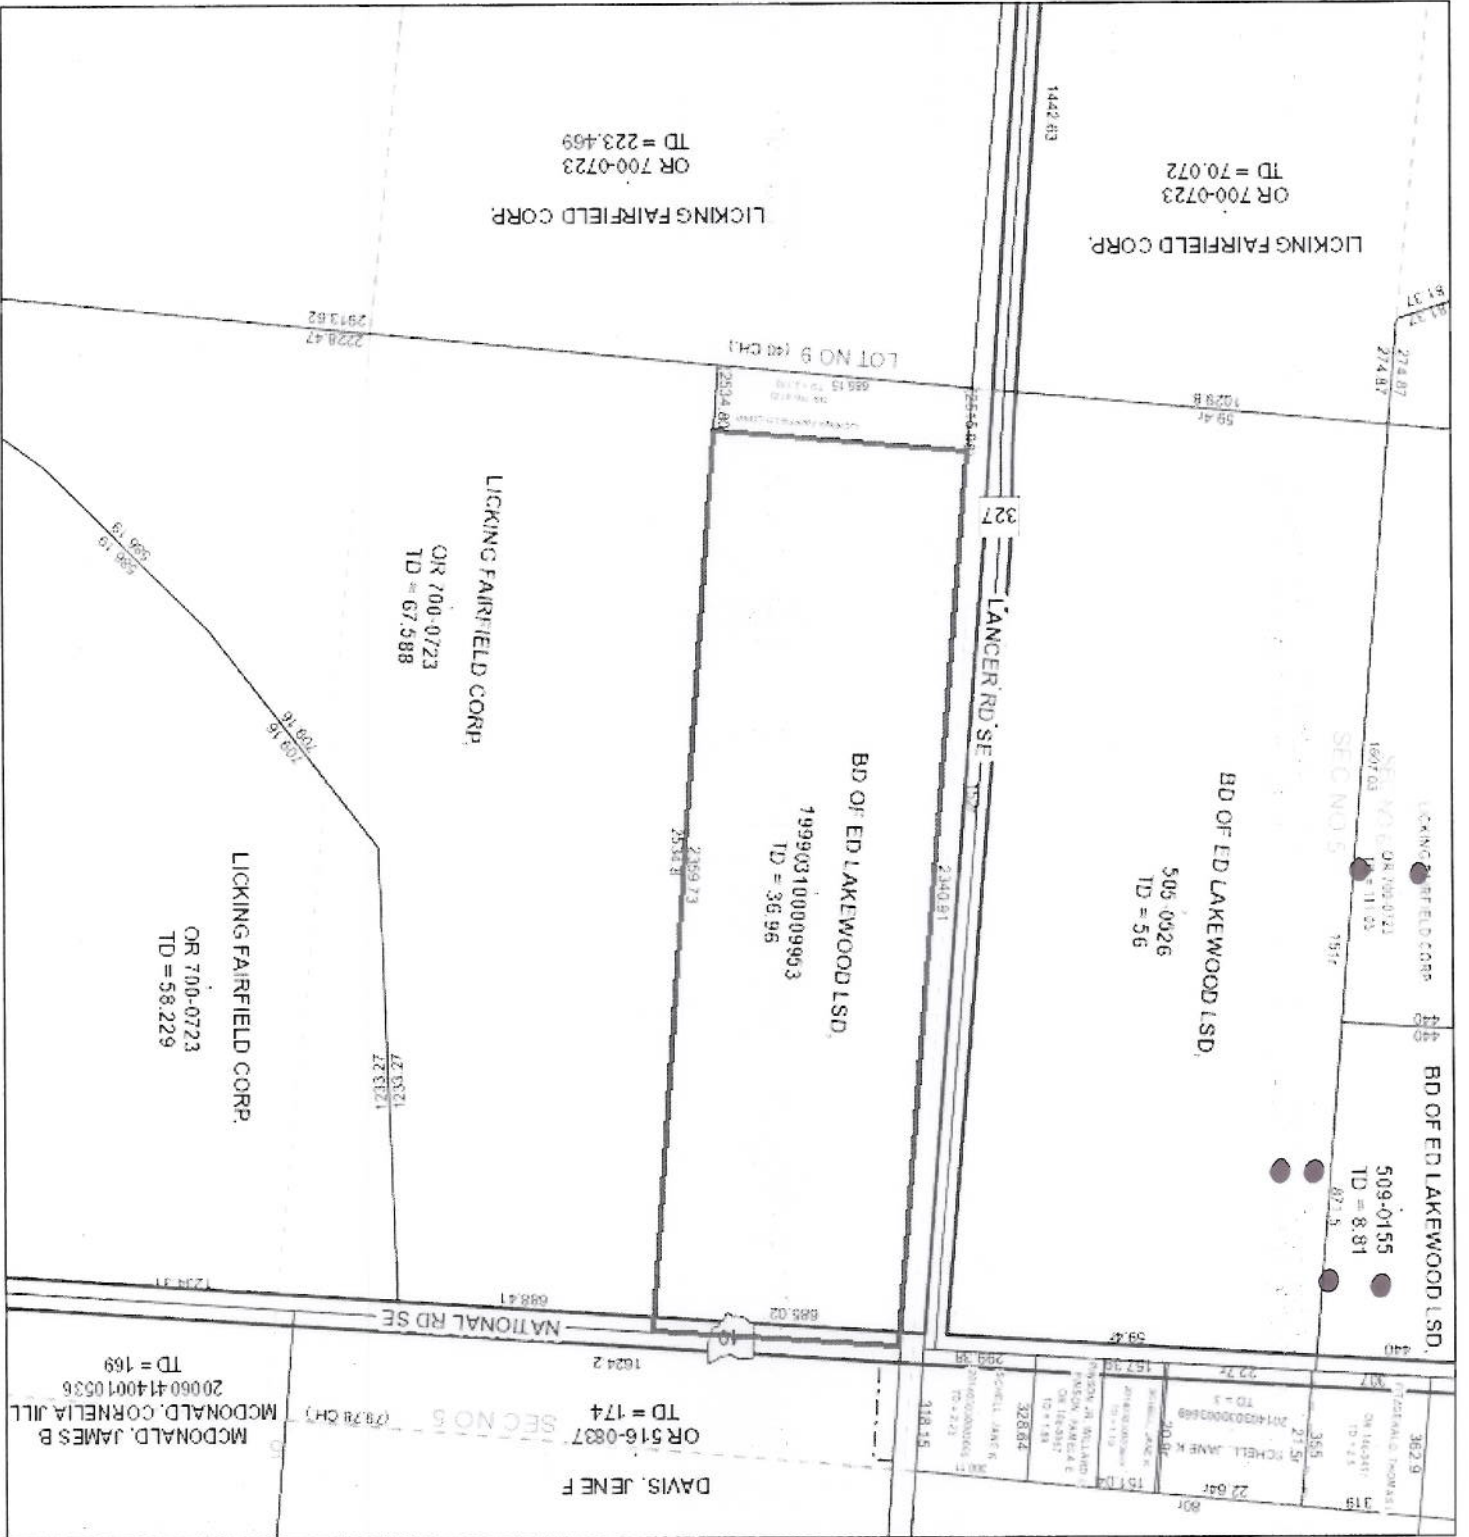

 



Licking County





Licking County

327

BUCKEYE LAKE

MAPLE BAY INVESTORS LLC.


201201030000070
TD = 28.034

HUNTS LANDING RD SE


950 BAYS



951

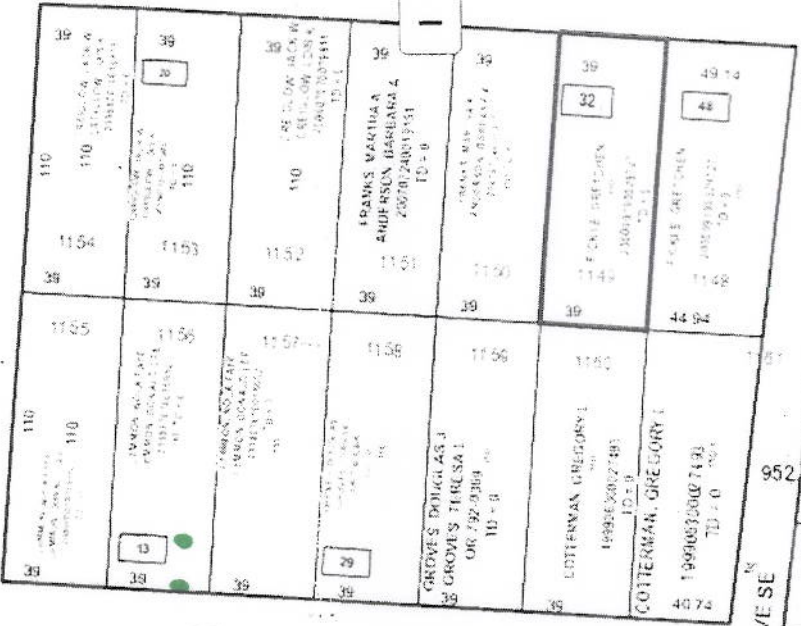


953 JULIA ST SE

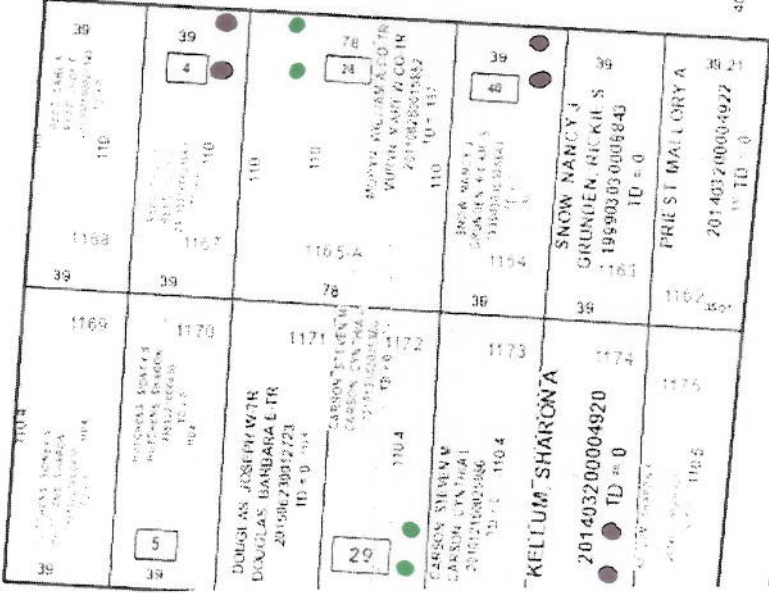



S MAPLE AVE SE

STEIN JUDY E
199806100021822
TD = 0

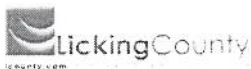

Licking County

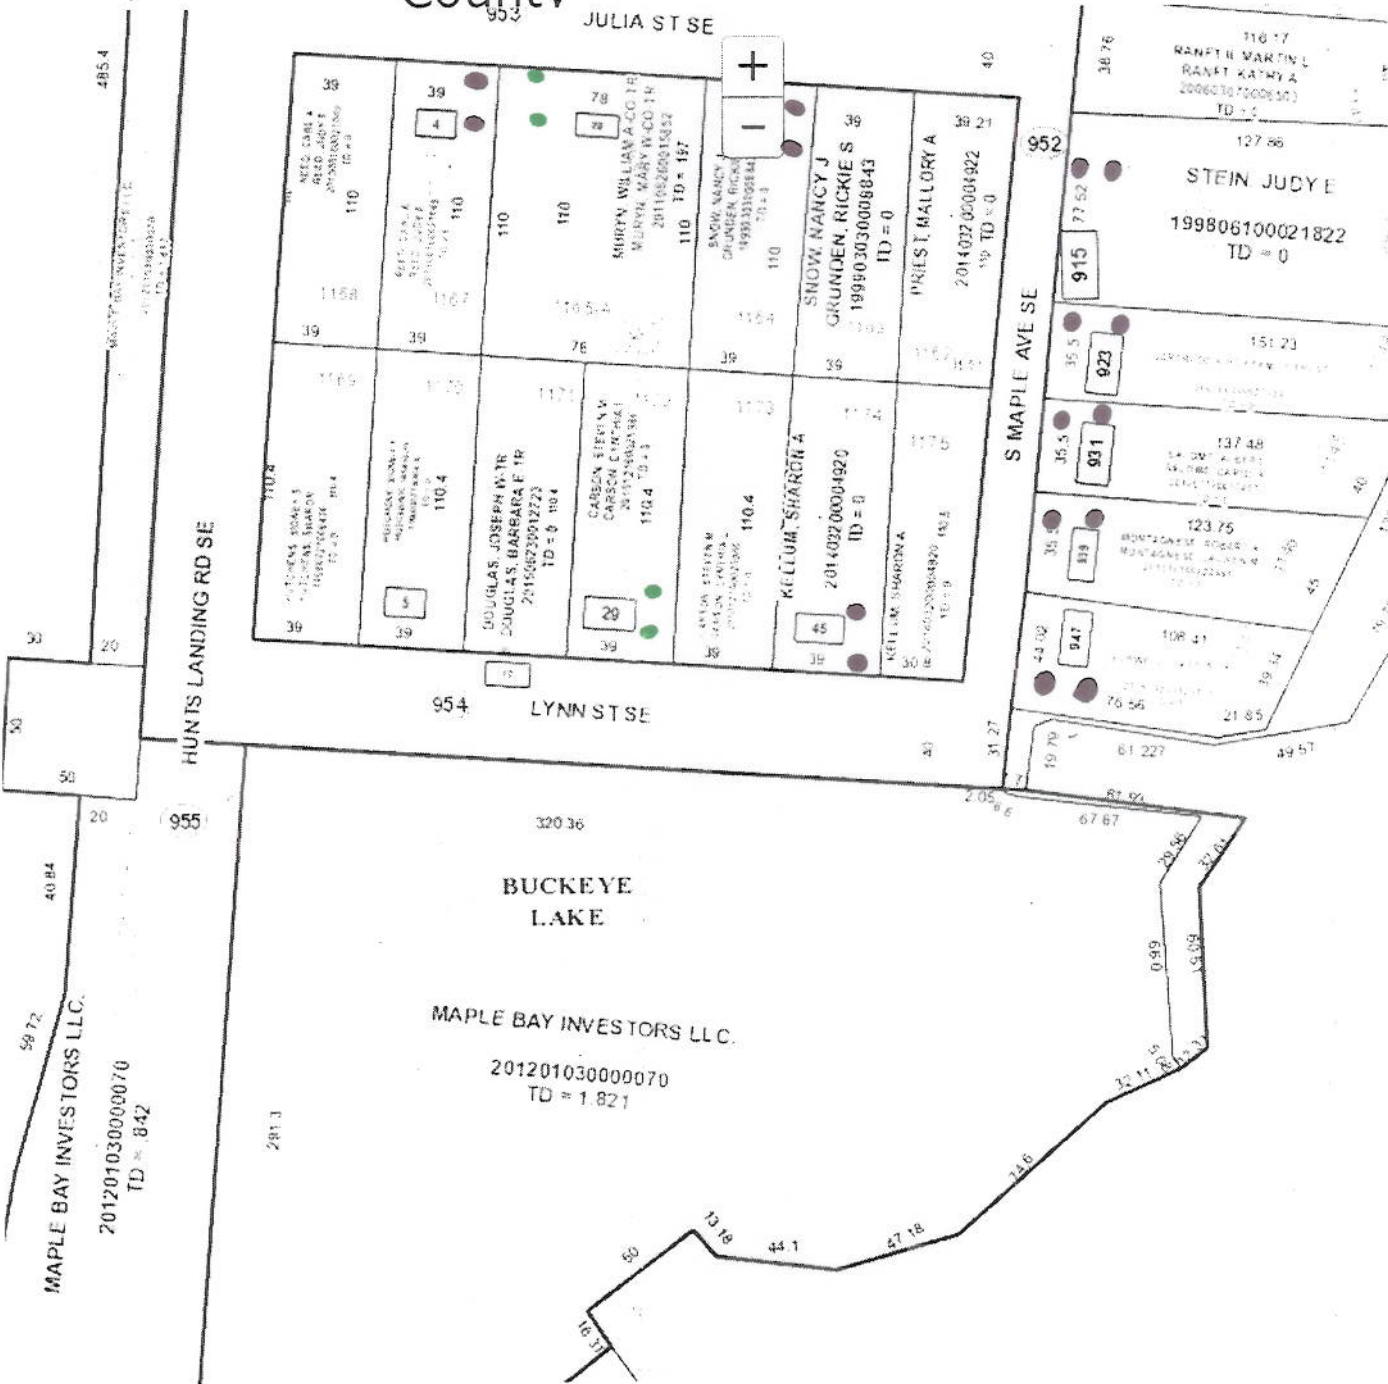

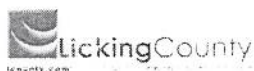

Licking County

