

A

B

C

D



E

F

Red Indicates homes built after January 1, 1983
Blue Indicates homes built prior to January 1, 1983

1
2
3
4
5
6
7
8
9
10
11

1
2
3
4
5
6
7
8
9
10
11

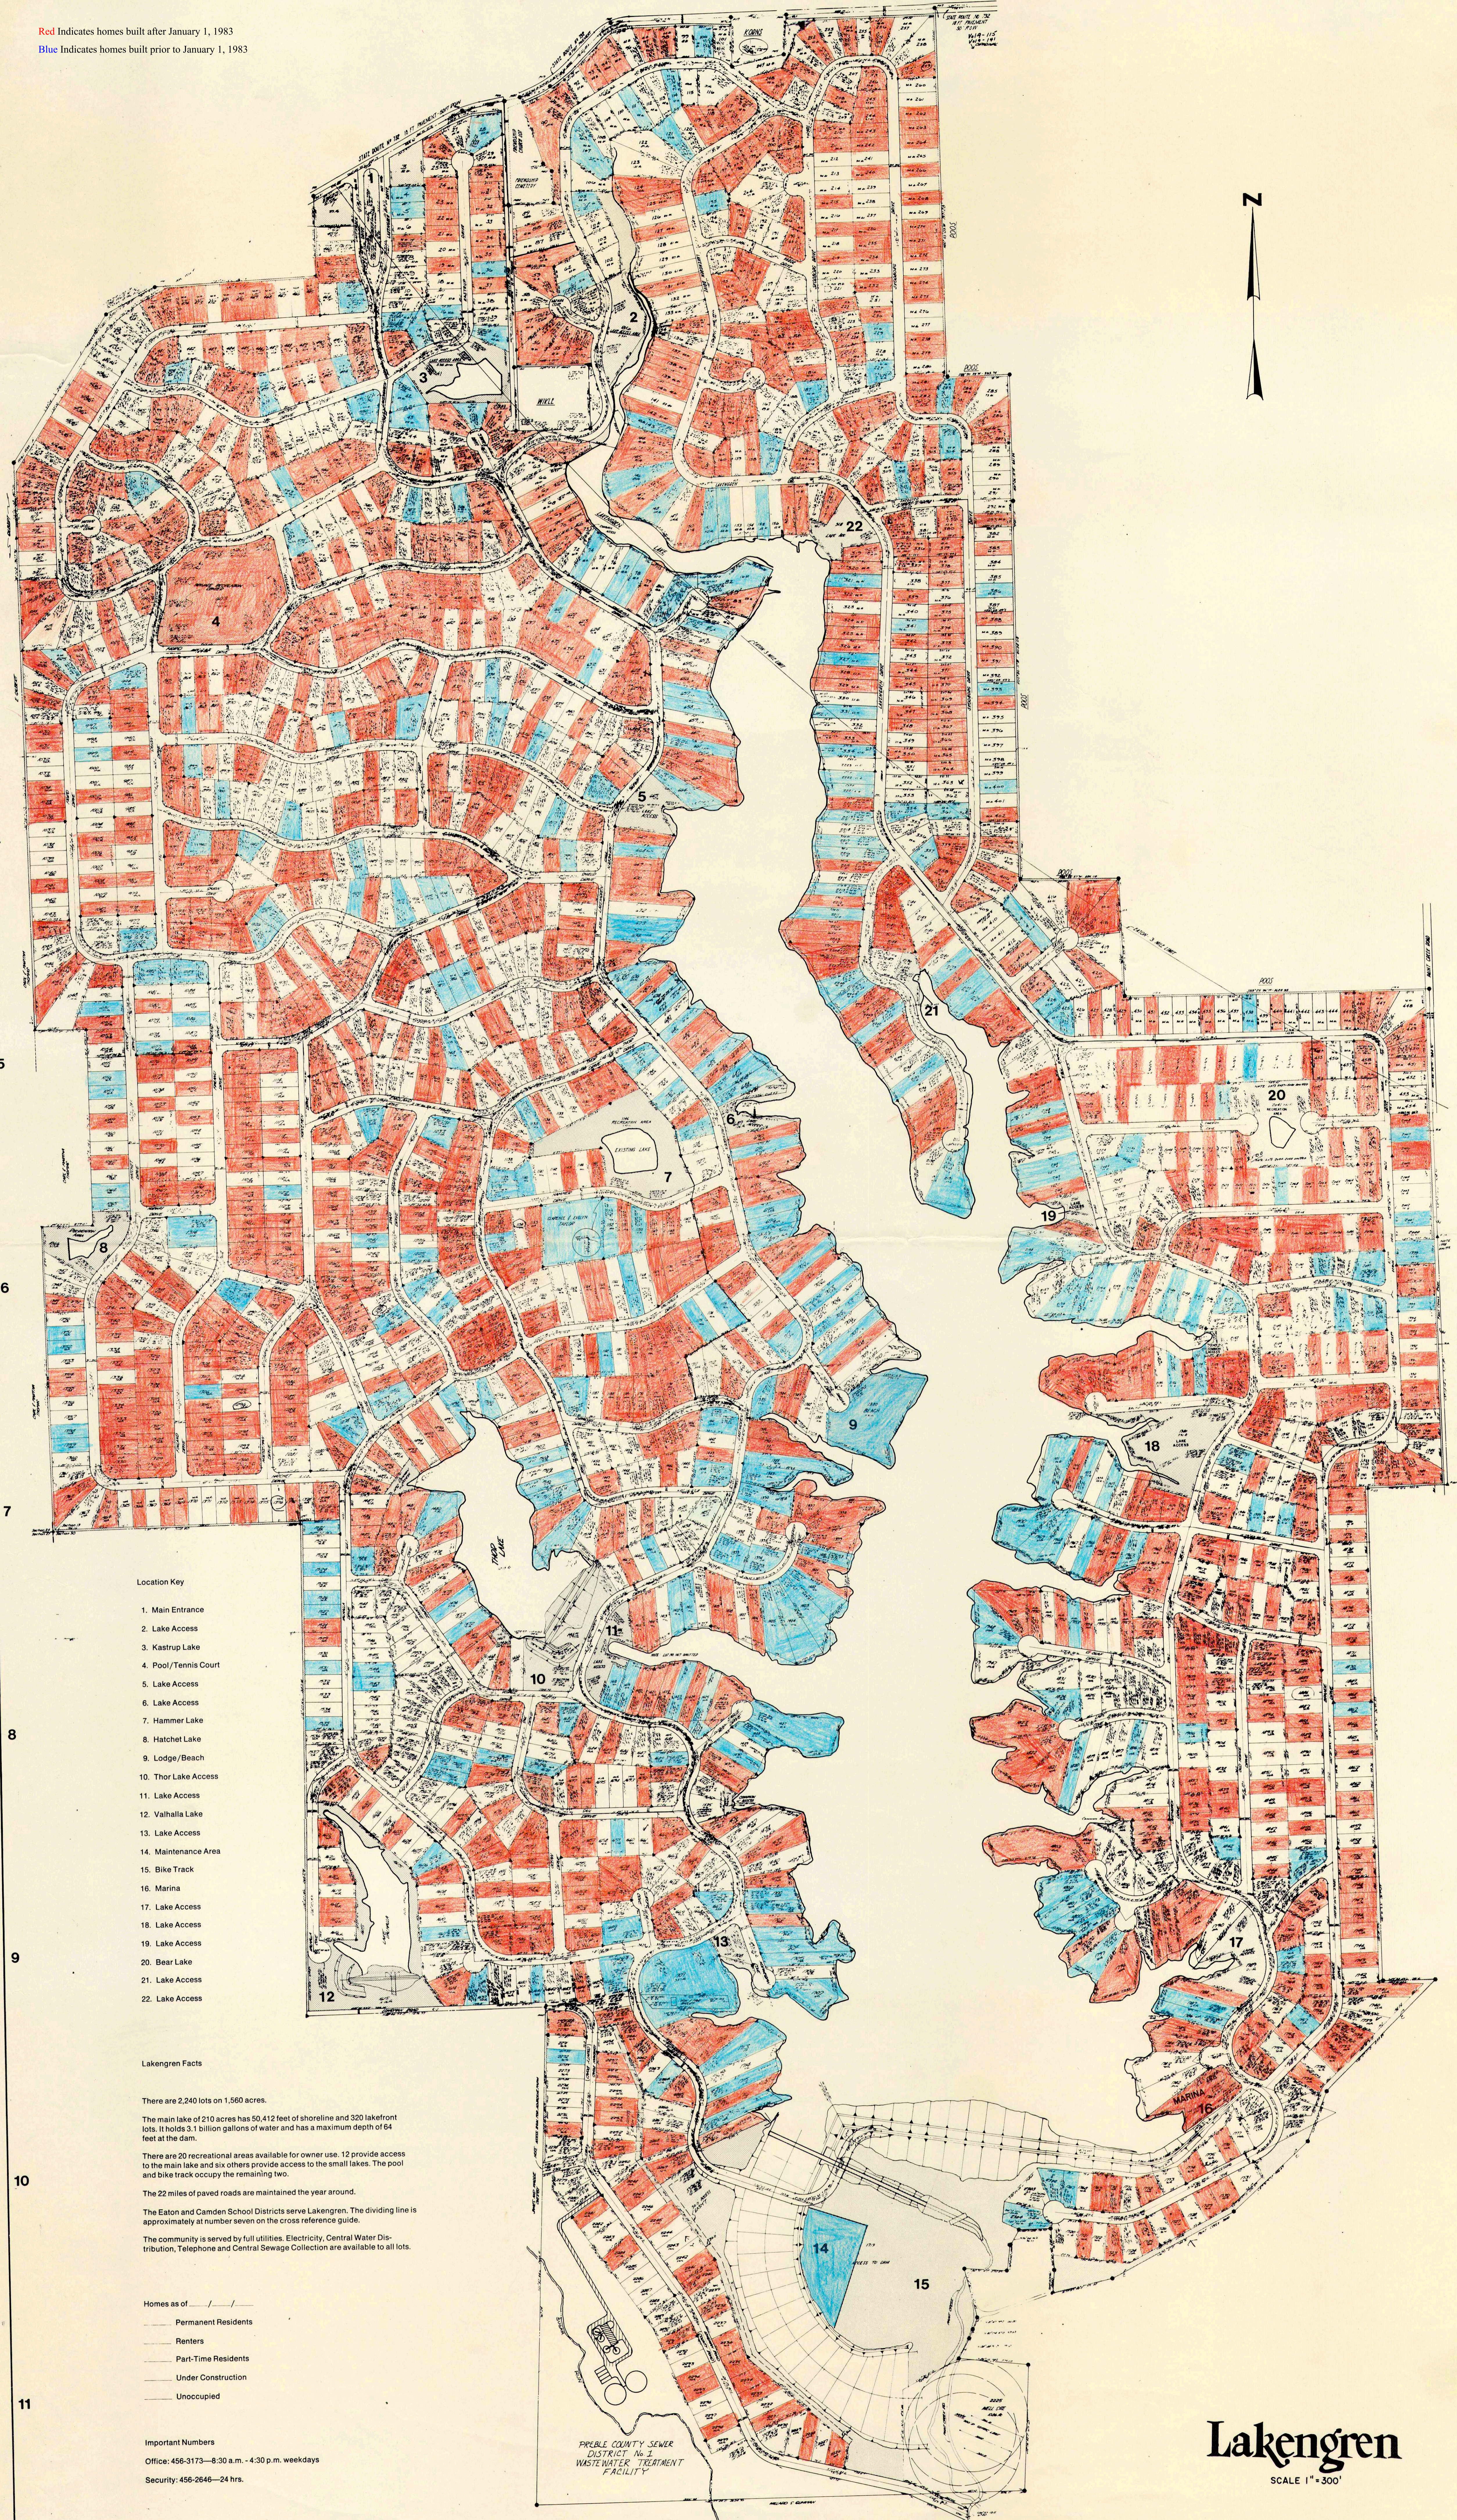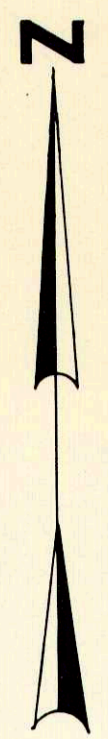

Location Key

- 1. Main Entrance
- 2. Lake Access
- 3. Kastrup Lake
- 4. Pool/Tennis Court
- 5. Lake Access
- 6. Lake Access
- 7. Hammer Lake
- 9. Lodge/Beach
- 10. Thor Lake Access
- 11. Lake Access
- 12. Valhalla Lake
- 13. Lake Access
- 14. Maintenance Area
- 15. Bike Track
- 16. Marina
- 17. Lake Access
- 18. Lake Access
- 19. Lake Access
- 20. Bear Lake
- 21. Lake Access
- 22. Lake Access

Lakengren Facts

There are 2,240 lots on 1,560 acres.
 The main lake of 210 acres has 50,412 feet of shoreline and 320 lakefront lots. It holds 3.1 billion gallons of water and has a maximum depth of 64 feet at the dam.
 There are 20 recreational areas available for owner use. 12 provide access to the main lake and six others provide access to the small lakes. The pool and bike track occupy the remaining two.
 The 22 miles of paved roads are maintained the year around.
 The Eaton and Camden School Districts serve Lakengren. The dividing line is approximately at number seven on the cross reference guide.
 The community is served by full utilities. Electricity, Central Water Distribution, Telephone and Central Sewage Collection are available to all lots.

Homes as of

- Permanent Residents
- Renters
- Part-Time Residents
- Under Construction
- Unoccupied

Important Numbers

Office: 456-3173—8:30 a.m.—4:30 p.m. weekdays
 Security: 456-2646—24 hrs.

PEBLE COUNTY SEWER
 WASTEWATER TREATMENT
 FACILITY

Lakengren

SCALE 1" = 300'

A

B

C

D

E

F



Date: 3/3/2017

To: Mark Verbsky, OEPA
From: Alan Stobaugh, General Manager
Subject: Lead mapping for Lakengren Water Authority PWS ID# OH6800712

The Lakengren Water Authority (LWA) is a Community Water System that services the residential subdivision of Lakengren. We are located in Preble County and serve a population of approximately 2,900 people.

As of this date, we have 1,386 service connections. With the exception of a club house, pool, marina and fire station, the remainder of the customers served by the LWA are single family residences.

The entire subdivision is comprised of mixed aged residences. There are three houses that were existing prior to the development of the subdivision. The remaining homes were built after 1964. Therefore the entire subdivision has the potential to contain plumbing with lead solder and fixtures that contain some level lead.

Because it is practically impossible to determine the lead content of an installed fixture, fitting or pipe, it should be assumed that the manufacture or installation date is the primary indicator of the lead content. Therefore, the characteristics of buildings and piping solder or fixtures would be buildings in Ohio built prior to 1998 or that use plumbing material or solder manufactured before 1998 may have materials with greater than 8% lead and are at a higher risk of contributing lead to the drinking water than materials manufactured after 1998. In addition, buildings built and plumbing materials manufactured after 2014 were required to have less than 0.25% lead by weight and have the lowest risk for contributing lead to the drinking water. It should be noted however that, although prohibited, some use of leaded solder or leaded components may have occurred after the prohibitions became effective."

There are NO Lead service connections or private service lines within our water system. (No Tier 1 or Tier 2 sites)

Sincerely,

Alan Stobaugh
General Manager


VERIFICATION FORM FOR COMMUNITY PUBLIC WATER SYSTEMS CLAIMING NO LEAD SERVICE LINES

Systems must also submit a report to the director containing at least both of the following: (1) The applicable map with narrative, and (2) A list of sampling locations used to collect samples as required by Ohio Revised Code (ORC) Section 6109.121 and any rules adopted thereunder, including contact information for the owner and occupant of each sampling site.

Should a water system determine no lead service lines exist in their distribution system, they must provide information stating they reviewed, at the minimum, historical permit records and local ordinances, distribution maintenance records and information pertaining to installation dates or materials for all services lines. This information must be verified below.

I HEREBY CERTIFY THAT THE FOLLOWING METHOD(S) WERE USED TO DETERMINE NO LEAD SERVICE LINES EXIST IN THIS WATER SYSTEM'S DISTRIBUTION SYSTEM, AS REQUIRED BY ORC 6109.121(F):

LEAD SERVICE LINE VERIFICATION
<p>This PWS states they have no lead service lines and has reviewed the following information (select one or more of the following):</p> <ul style="list-style-type: none"> <input type="checkbox"/> Historical permit records and/or local ordinances <input checked="" type="checkbox"/> Distribution maintenance records (i.e. meter replacement, waterline break repairs) <input type="checkbox"/> Information pertaining to installation dates for all service lines (i.e. after 1986 when lead services lines were banned) <input checked="" type="checkbox"/> Service line material of all service lines is known (i.e. all service lines are known to be PVC)


 Signature of Responsible Person 3/31/2017 Date
Alan T. Sebaugh General Manager
 Printed Name and Title of Responsible Person

PWS NAME: LAKENS REN WATER AUTHORITY
 PWS ID: OH 6800712
 COUNTY: PREBIE

<p>For Ohio EPA use only:</p> <p>Date Verification Rec'd: _____</p>
--