

Lead Mapping

PIONEER PLASTICS  
3330 MASSILLIOM RD  
AKRON OHIO 44319

330 896 2356

OH 7786112  
FACILITY ID 7759002

William L. ROTH Sr  
OPERATOR

John M. ROTH + SONS INC  
DBA Mr Dependable pump  
6200 MANCHESTER RD  
NEW FRANKLIN OHIO 44216

330 882 4111

FAX 330 882-6778

Cell 330 819 9638


E. MAIL Mr Dependable pump © SBC Global-Net



Pioneer Plastic  
Ground Floor  
3330 Nassi/1101 Rd  
Akron, Ohio 44319

3308962356

JM

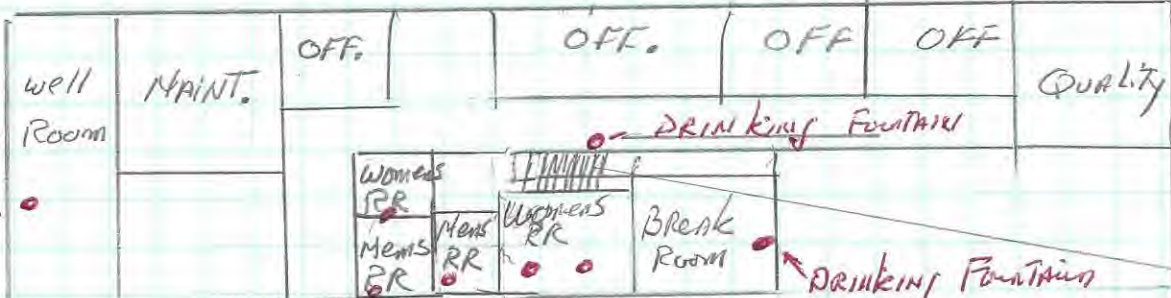

Holding AREA + Press Room

• DRINKING FOUNTAIN OR SINK

This AREA HAS water  
BUT, all water is Non potabbe  
+ Potable + Not Potable water  
Sepelate systems

WHSE #1 #2 #3



Pioneer Plastics 330 896 2356  
3330 Massillon Rd  
Akron, Ohio 44319

Top Floor Office only

Office	Office	Office	Office
RR Ladies ○	RR Mens ○		Balcony

○ Sink

plumbing copper-lead unknown  
Did have ○ lead issue when upper  
offices were NOT Flushed or  
used Regularly Non Rec. Elsewhere.