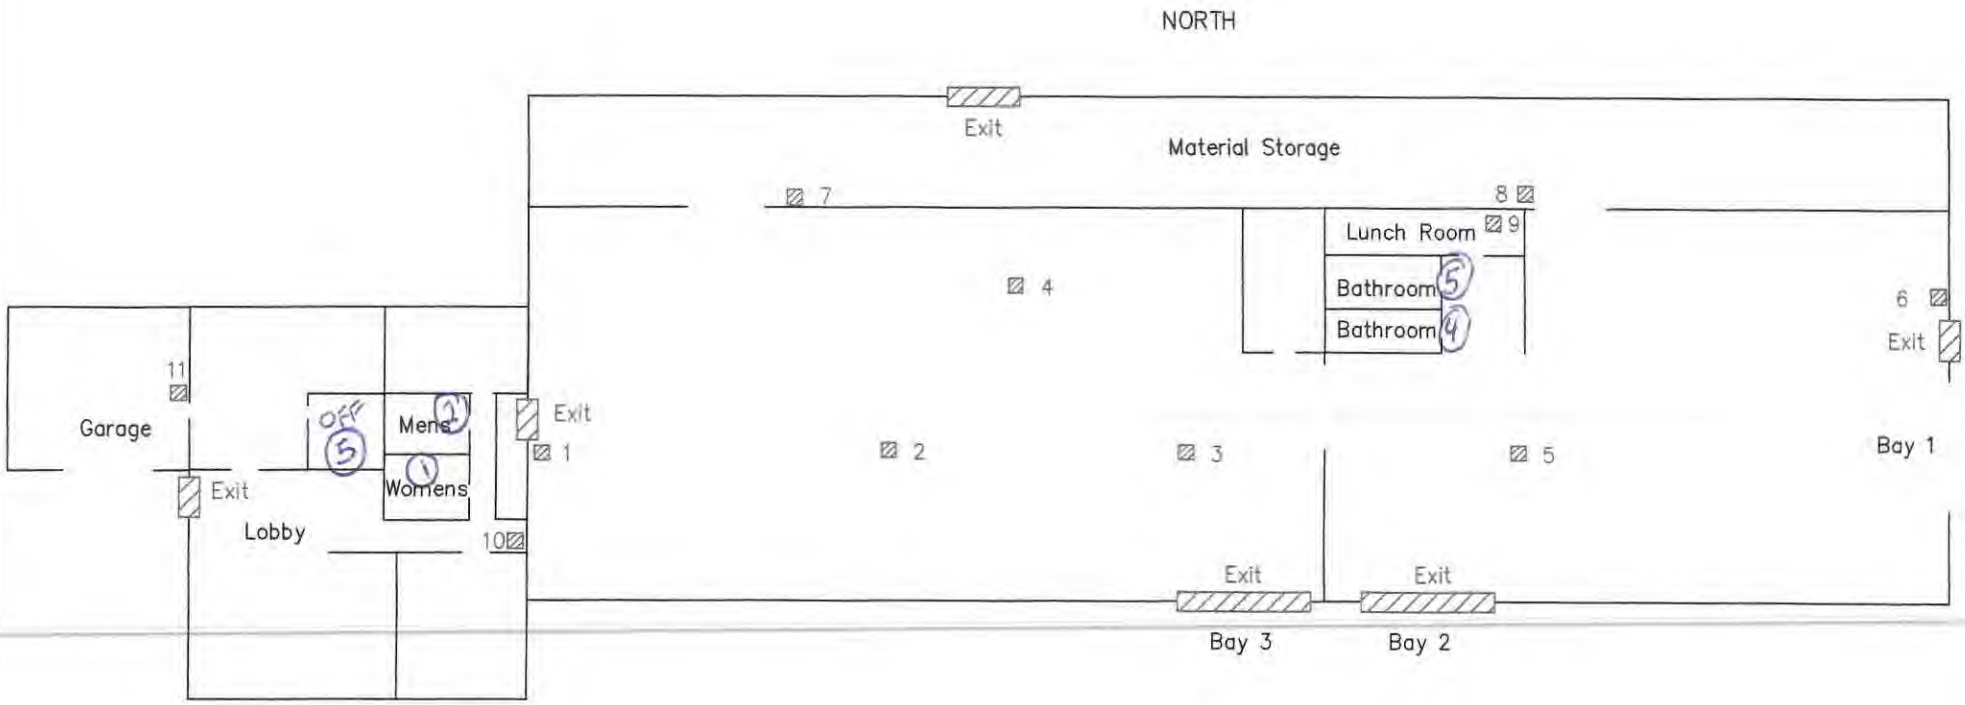

1. LC 201
2. LC 202
3. L. C 203
4. LC 204
5. LC 205

LEGEND	
Exit	
Fire Extinguisher	

FIRE EXT. & EXITS			
SCOTT MOLDERS INC.			
KENT, OHIO 44240			
drawn by	DATE 7/24/14	SCALE FULL	S.M.I. SHOP NUM.
SHEET NO. 1 OF 1	SHRINK		