

Lead Mapping

MAYFAIR Christian School  
2350 GRAYBILL ROAD  
UNIONTOWN, Ohio 44685  
330 896-3184

OH 7780112

Facility ID 7758970

William L. Roth Sr  
OPERATOR

John M. Roth + Sons Inc.  
DBA Mr Dependable Pump-  
6200 MANCHESTER RD.  
New Franklin, Ohio 44216

330 882 4111

Fax 330 882 6778

Cell 330 819 9638


E. Mail Mr Dependable Pump @ SBC Global . Net

V.N.

to Sink Suitable For TESTING

# Mayfair Christian School

Well ←

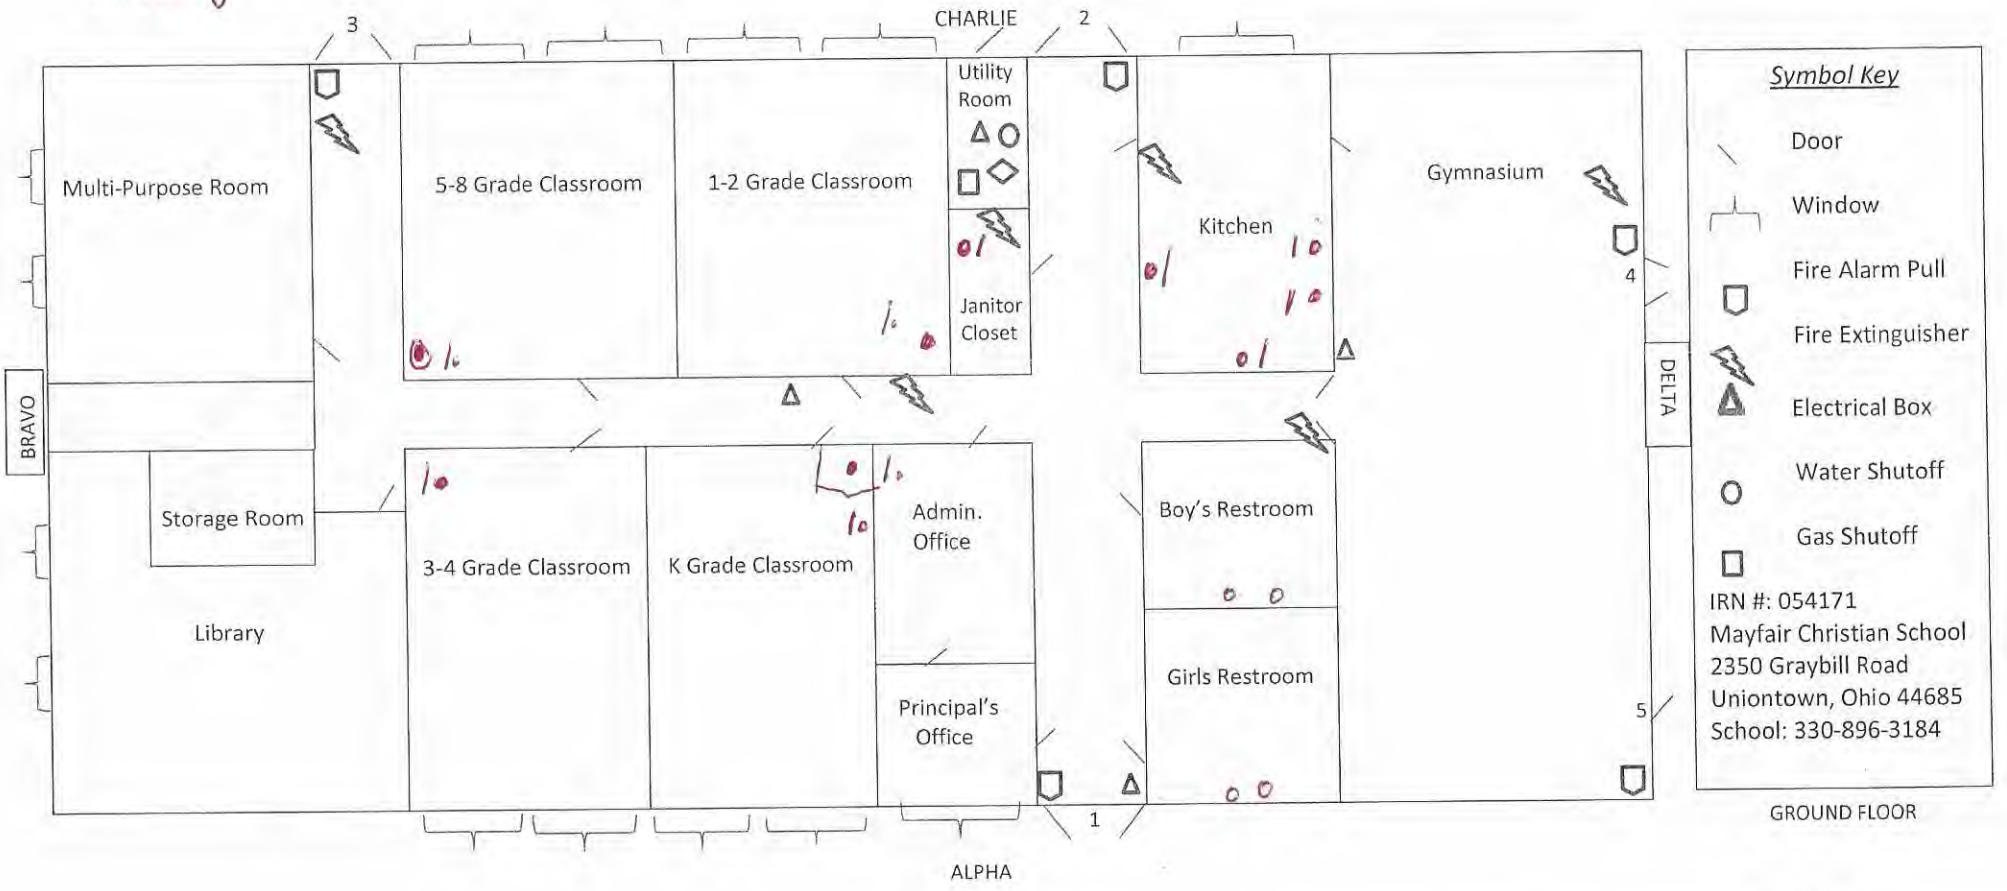

**Symbol Key**

- Door
- Window
- Fire Alarm Pull
- Fire Extinguisher
- Electrical Box
- Water Shutoff
- Gas Shutoff

IRN #: 054171  
 Mayfair Christian School  
 2350 Graybill Road  
 Uniontown, Ohio 44685  
 School: 330-896-3184

GROUND FLOOR

North ↘

Graybill Road