


NOTE:

- — FIRE HYDRANT
- — WELL
- * — TEST SITES

- * — SECRET LADIES R.R.
- * — W.C.C.C. Rm. 114
- * — W.C.C.C. Rm. 120

- * — W.C.C.C. Rm. 126
- * — W.C.C.C. AUTUMN CTR.

Wayne County Care Center Report DDAGW Wayne OH8504212 02/07/17

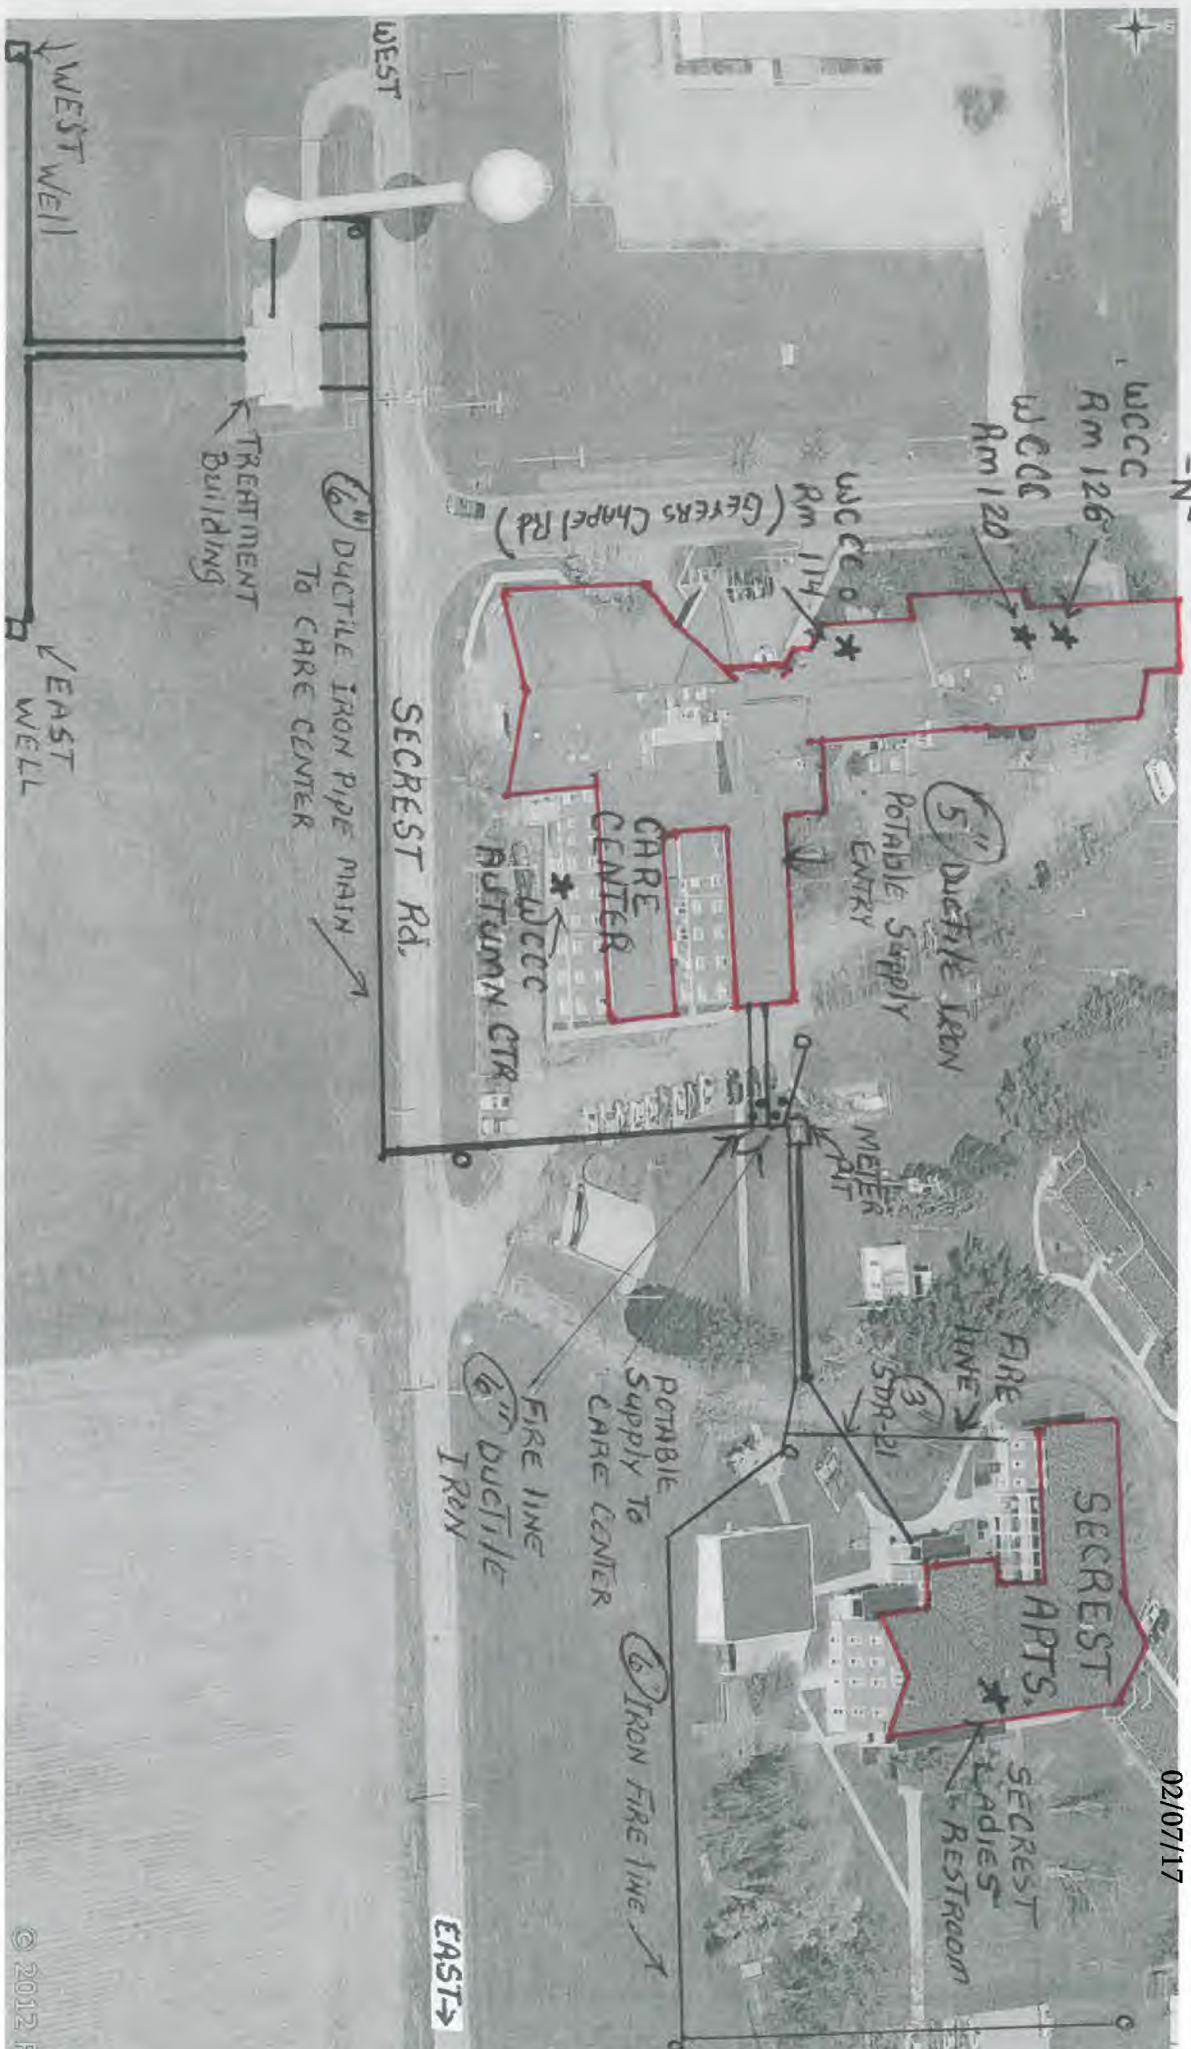

-S-