

APPROVED BY:

PLANNING COMMISSION

Leah N. Vance, Jr. May 20, 1973
CHAIRMAN DATE

Charles Hunter May 20, 1973
SECRETARY DATE

COUNCIL

Harmon Lee Miller May 8, 1973
MAYOR (Acting) DATE

Marjorie Hall May 8, 1973
CLERK DATE

VILLAGE

of

PHILLIPSBURG

OFFICIAL

HOUSE NUMBERING

PLAN

ORDINANCE NO. 518
PASSED MAY 13, 1975




SCALE IN FEET
0 200 400 600 800

PREPARED BY

DONALD R. BOWMAN
CIVIL ENGINEER & SURVEYOR
R. R. BOX 268A
BROOKVILLE, OHIO 45309

3/11/74	
5/25/79	Add Number
DATE	CHARACTER
REVISIONS	

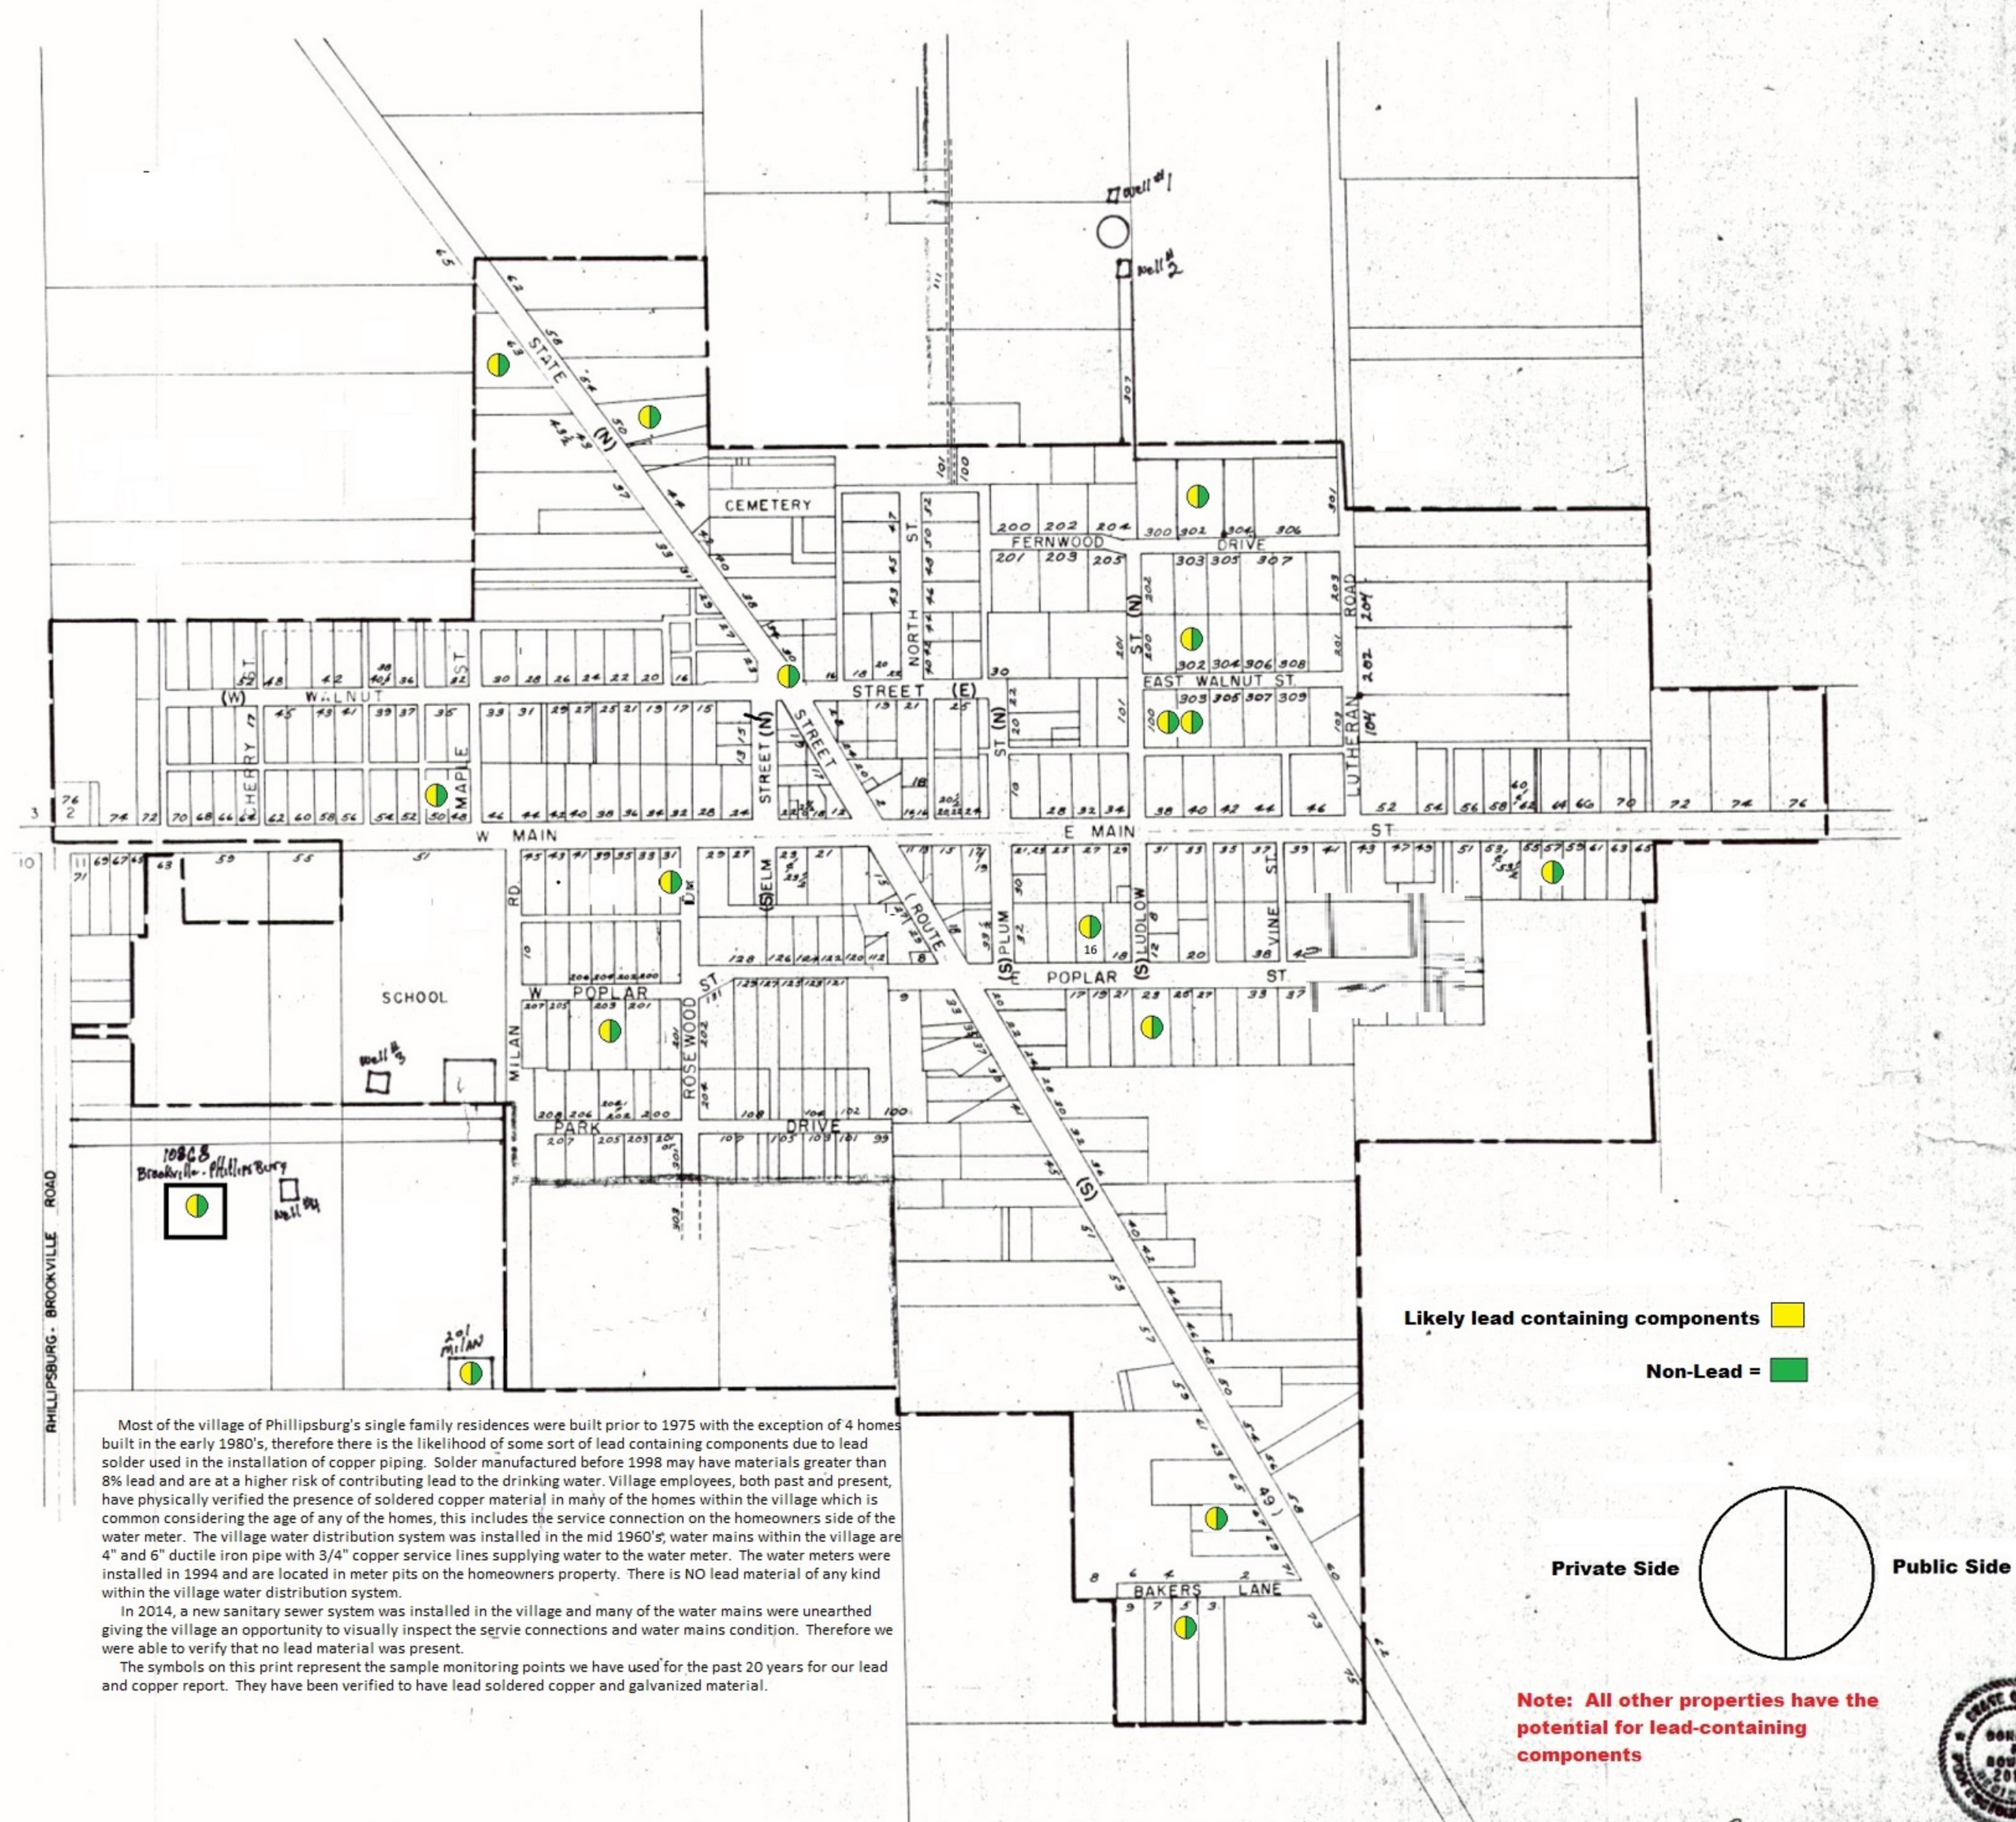

Likely lead containing components

Non-Lead =

Private Side

Public Side

Note: All other properties have the potential for lead-containing components

Donald R. Bowman

DONALD R. BOWMAN
REGISTERED ENGINEER NO. 20,138



**VERIFICATION FORM FOR COMMUNITY PUBLIC WATER SYSTEMS
CLAIMING NO LEAD SERVICE LINES**

The owner or operator of all community public water systems must identify and map areas of their distribution system that are known or are likely to contain lead service lines. Systems must submit a copy of the applicable map to the Ohio Department of Health and the Ohio Department of Job and Family Services. Systems must also submit a report to the director containing at least both of the following: (1) The applicable map with narrative, and (2) A list of sampling locations used to collect samples as required by Ohio Revised Code (ORC) Section 6109.121 and any rules adopted thereunder, including contact information for the owner and occupant of each sampling site.

Should a water system determine no lead service lines exist in their distribution system, they must provide information stating they reviewed, at the minimum, historical permit records and local ordinances, distribution maintenance records and information pertaining to installation dates or materials for all services lines. This information must be verified below.

I HEREBY CERTIFY THAT THE FOLLOWING METHOD(S) WERE USED TO DETERMINE NO LEAD SERVICE LINES EXIST IN THIS WATER SYSTEM'S DISTRIBUTION SYSTEM, AS REQUIRED BY :
ORC 6109.121(F):

LEAD SERVICE LINE VERIFICATION
<p>This PWS states they have no lead service lines and has reviewed the following information (select one or more of the following):</p> <ul style="list-style-type: none"><input type="checkbox"/> Historical permit records and/or local ordinances<input type="checkbox"/> Distribution maintenance records (i.e. meter replacement, waterline break repairs)<input type="checkbox"/> Information pertaining to installation dates for all service lines (i.e. after 1986 when lead services lines were banned)<input checked="" type="checkbox"/> Service line material of all service lines is known (i.e. all service lines are known to be PVC)

 March 5, 2017

Signature of Responsible Person Date

Mark Myers OPERATOR OF RECORD

Printed Name and Title of Responsible Person

PWS NAME: Village of Phillipsburg
PWS ID: OH 5702112
COUNTY: Montgomery

For Ohio EPA use only:

Date Verification Rec'd: _____