


— Copper



- Poly Line
- Copper Line
- Water Well

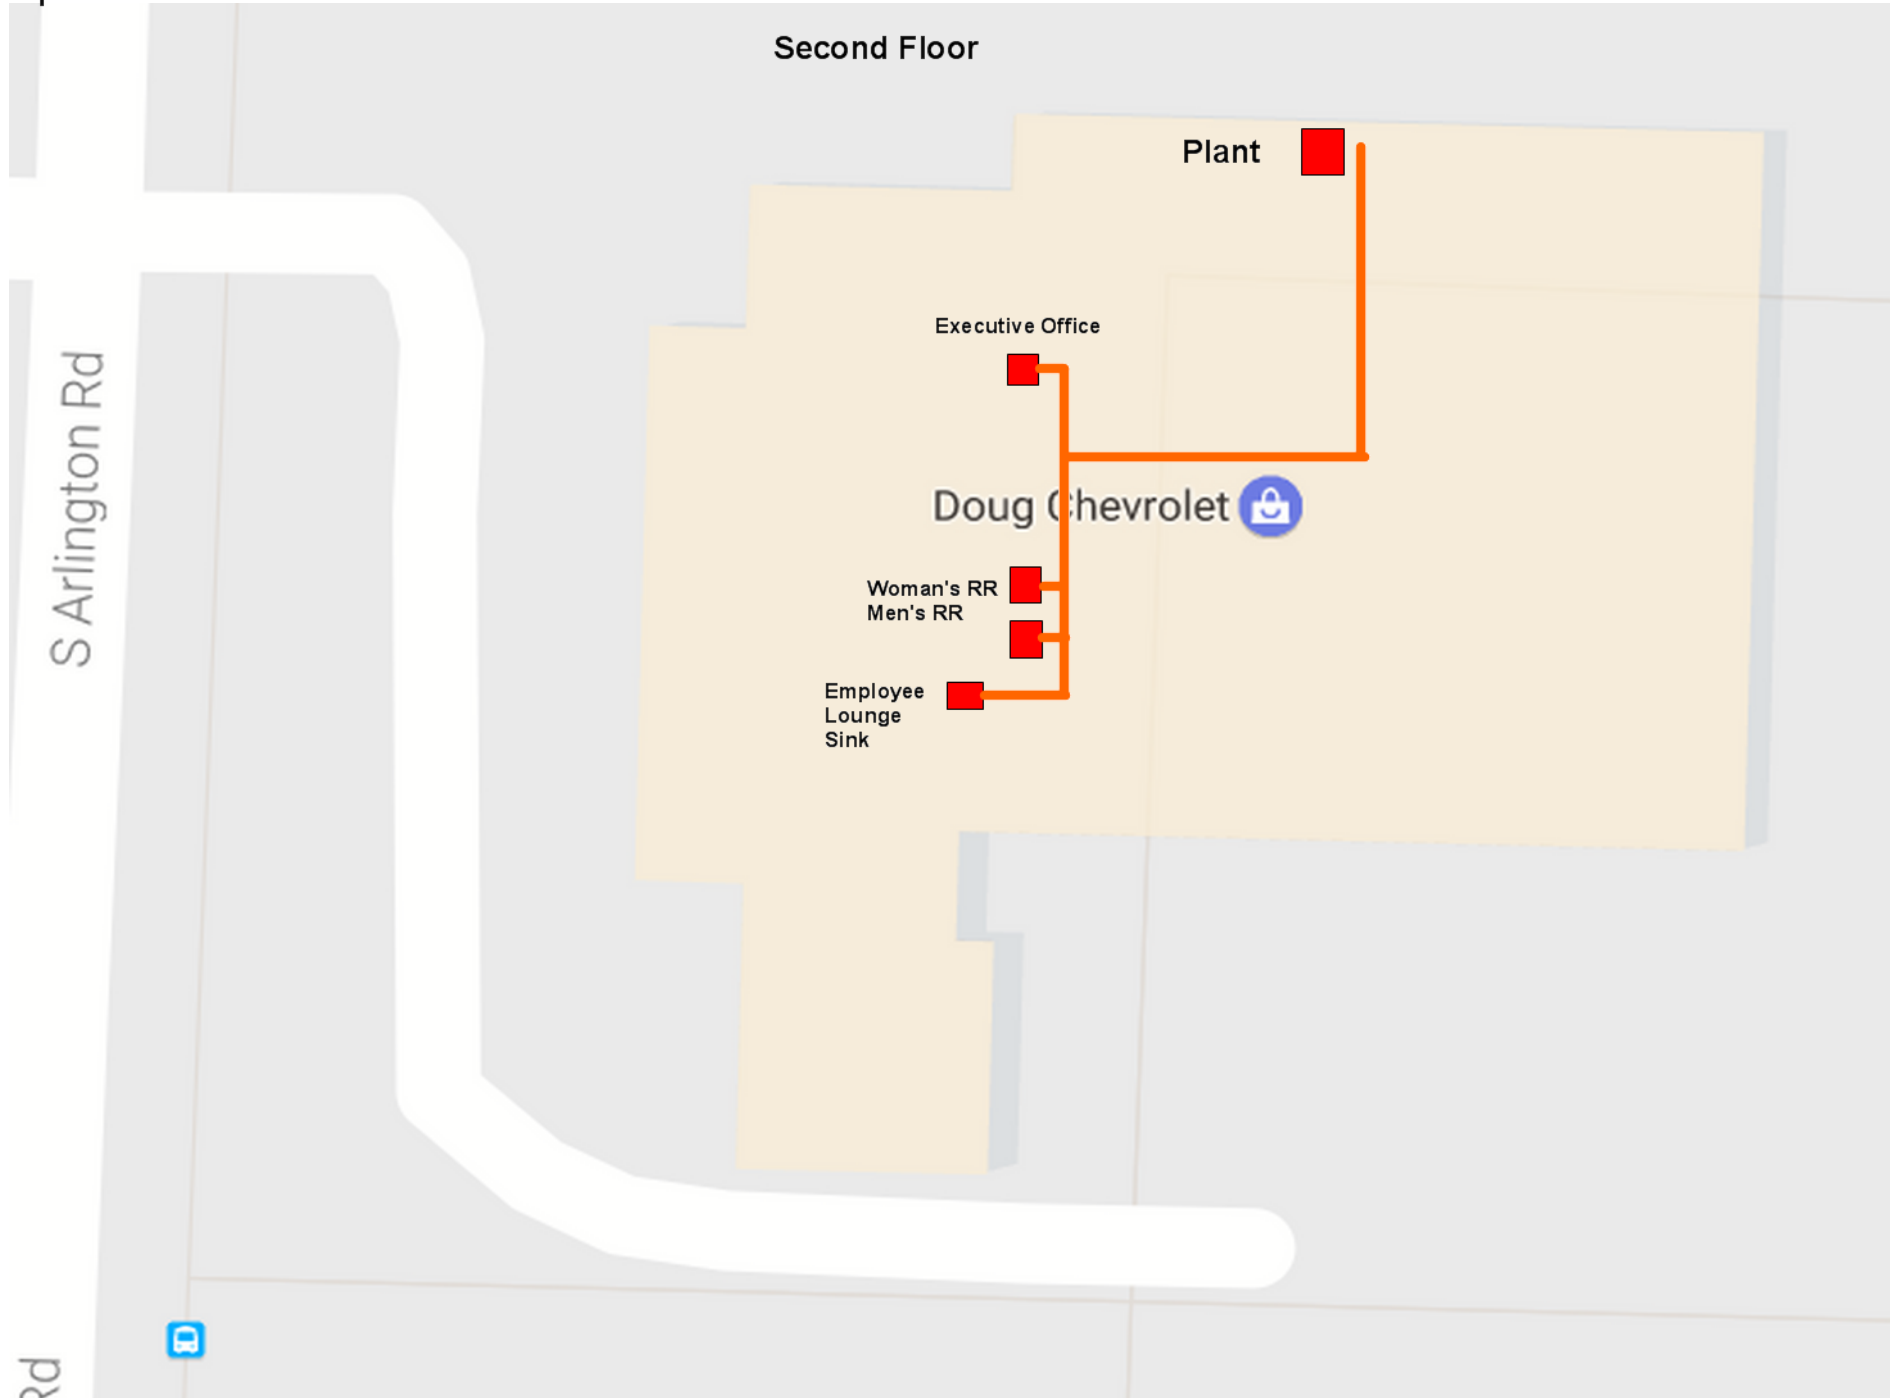