

Pine Mill Ridge 2 PWS - OH7707212  
 Plumbing and Distribution Mapping  
 Prepared 2017 by Brandon Mantel / Donamarc

Note: 4 Digit Year below buildings indicate year constructed.



Water Well




Water Plant



Poly Pipe



Copper Piping

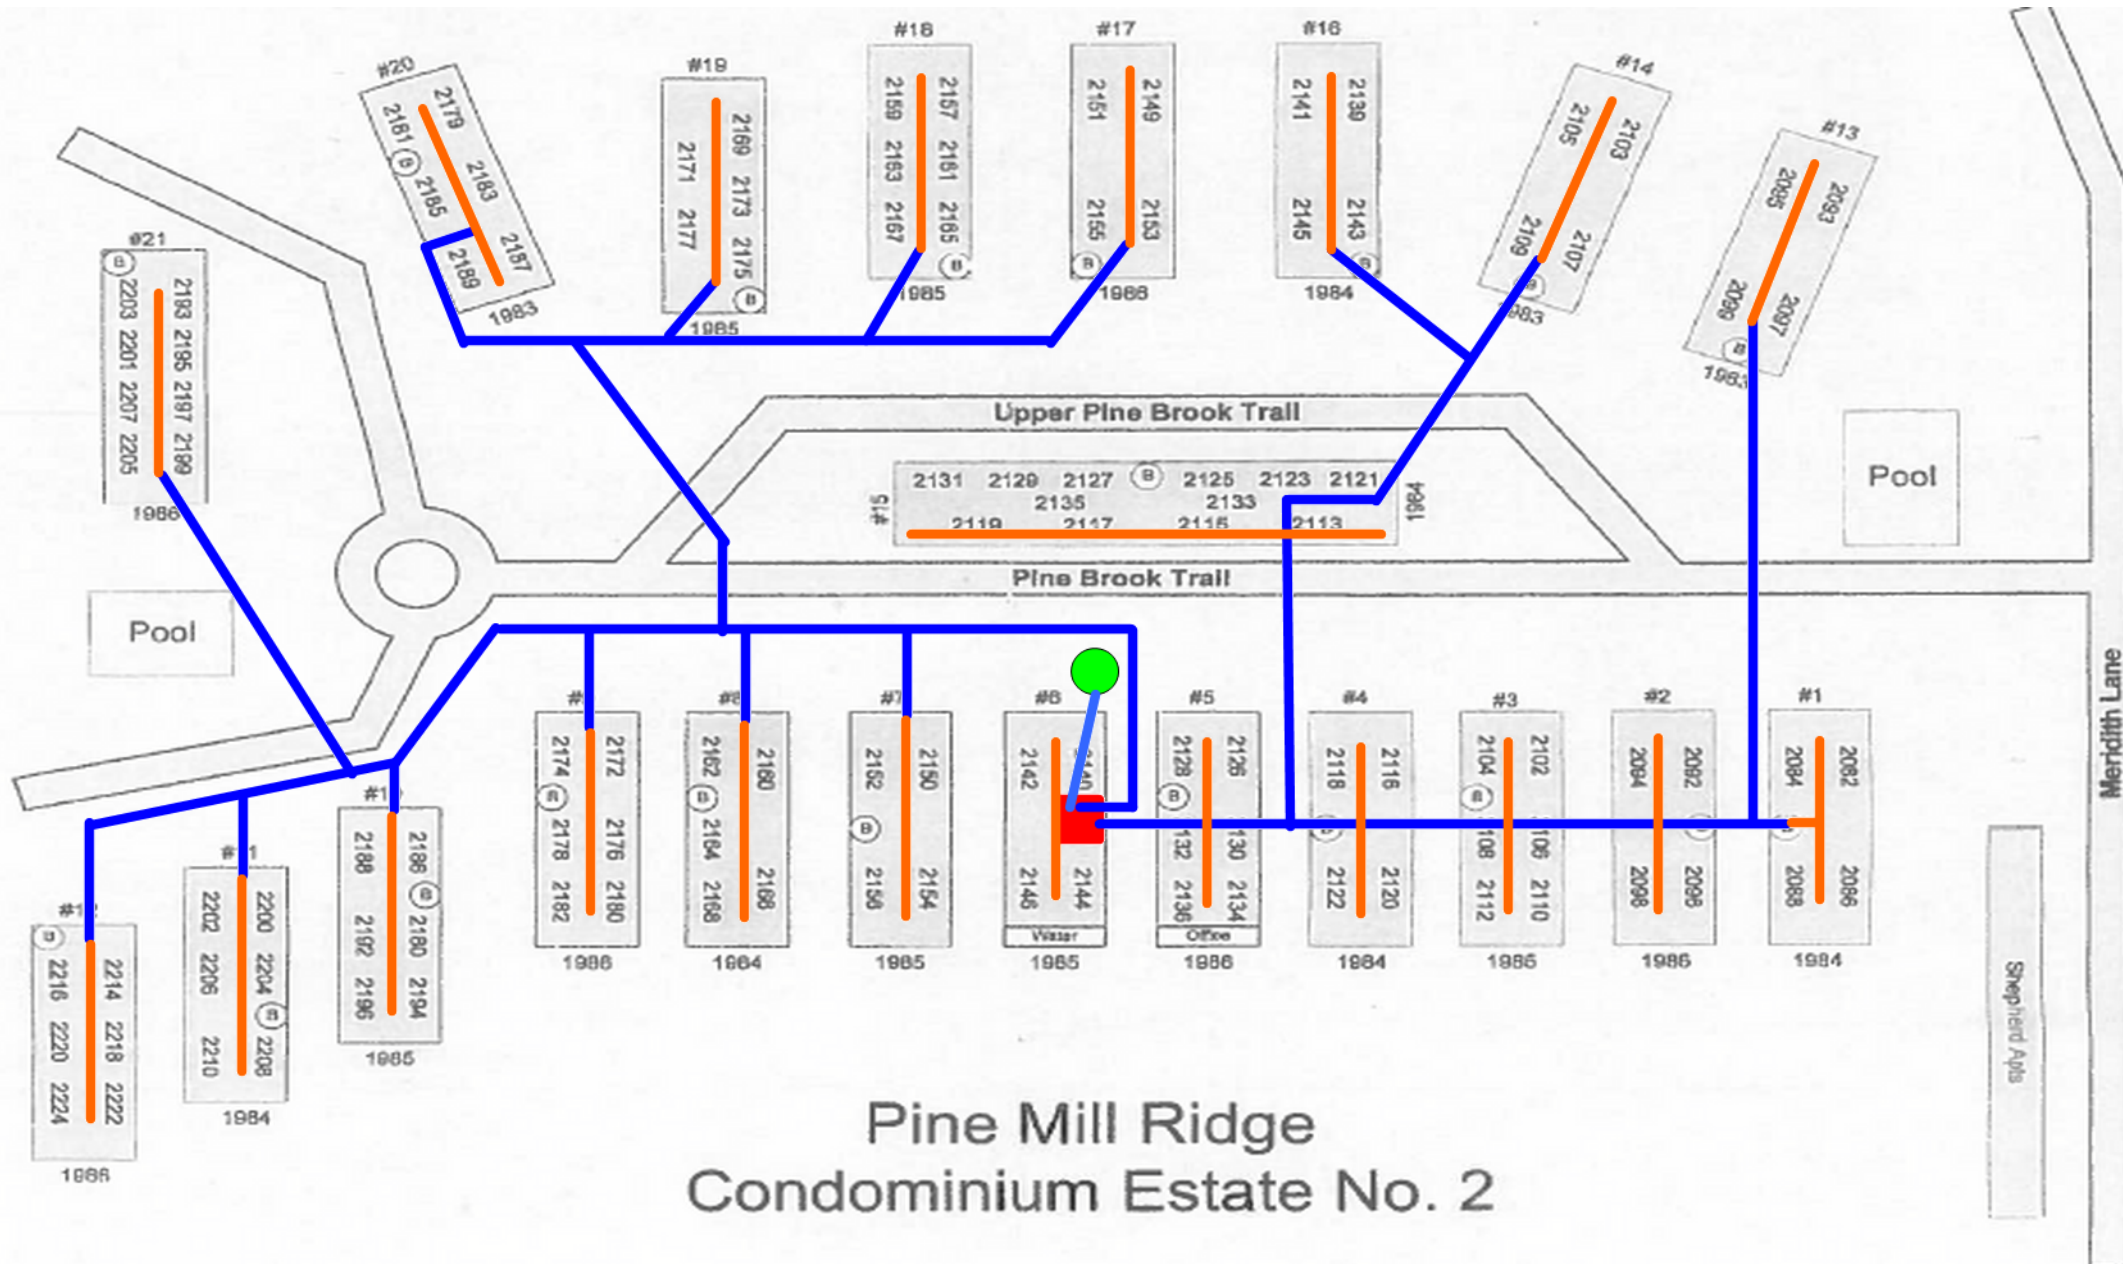

Pine Mill Ridge  
 Condominium Estate No. 2