RE: HILLSDALE HIGH SCHOOL
Report
Drinking Water Program
Ashland County
PWS ID: OH0339012

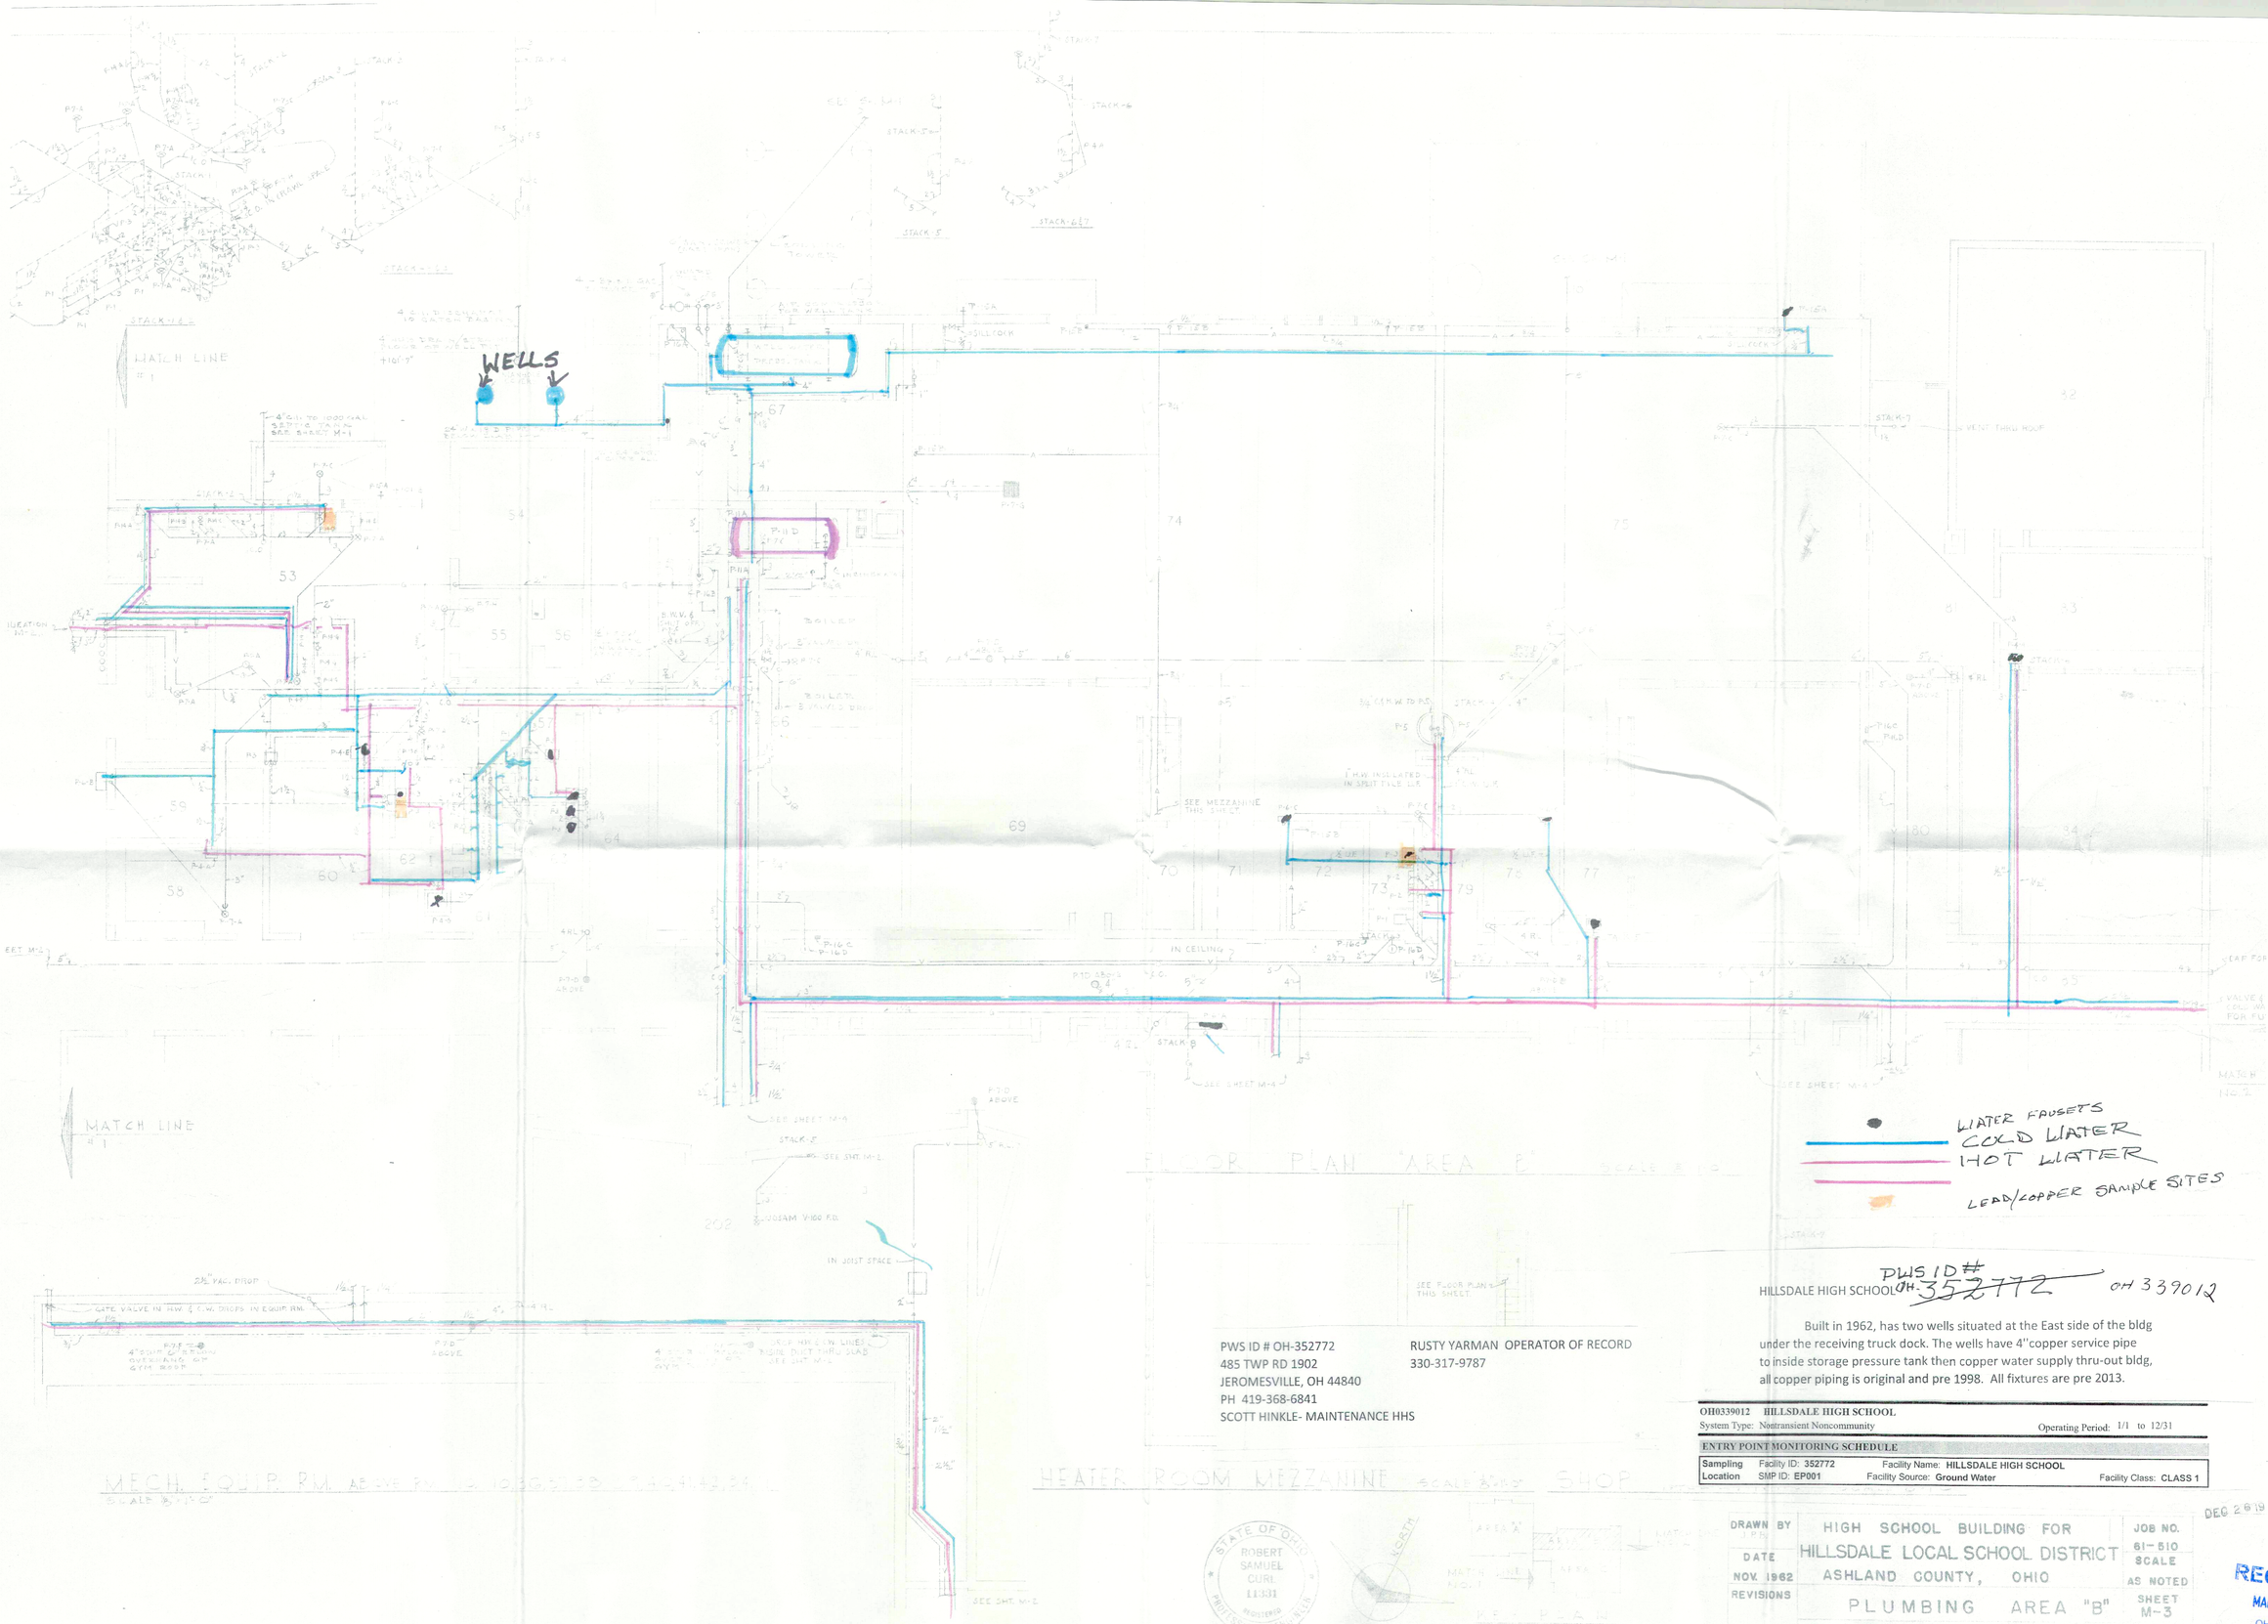

HILLSDALE HIGH SCHOOL PWS ID # ~~OH-352772~~ OH 339012

Built in 1962, has two wells situated at the East side of the bldg under the receiving truck dock. The wells have 4''copper service pipe to inside storage pressure tank then copper water supply thru-out bldg, all copper piping is original and pre 1998. All fixtures are pre 2013.

PWS ID # OH-352772
485 TWP RD 1902
JEROMESVILLE, OH 44840
PH 419-368-6841
SCOTT HINKLE- MAINTENANCE HHS

RUSTY YARMAN OPERATOR OF RECORD
330-317-9787

OH0339012 HILLSDALE HIGH SCHOOL			
System Type: Nontransient Noncommunity		Operating Period: 1/1 to 12/31	
ENTRY POINT MONITORING SCHEDULE			
Sampling Location	Facility ID: 352772	Facility Name: HILLSDALE HIGH SCHOOL	
	SMP ID: EP001	Facility Source: Ground Water	Facility Class: CLASS 1

STATE OF OHIO ROBERT SAMUEL CURL 11331 REGISTERED PROFESSIONAL ENGINEER

DRAWN BY	HIGH SCHOOL BUILDING FOR	JOB NO.
DATE	HILLSDALE LOCAL SCHOOL DISTRICT	61-510 SCALE
NOV. 1962	ASHLAND COUNTY, OHIO	AS NOTED
REVISIONS	PLUMBING AREA "B"	SHEET M-3
	MARR — KNAPP — CRAWFIS REG. ARCHITECTS	OF
	NEW PHILADELPHIA, O. MANSFIELD, O.	9

DEC 28 19

RECEIVED
MAR 08 2017
OHIO E.P.A.
N.W.D.O.

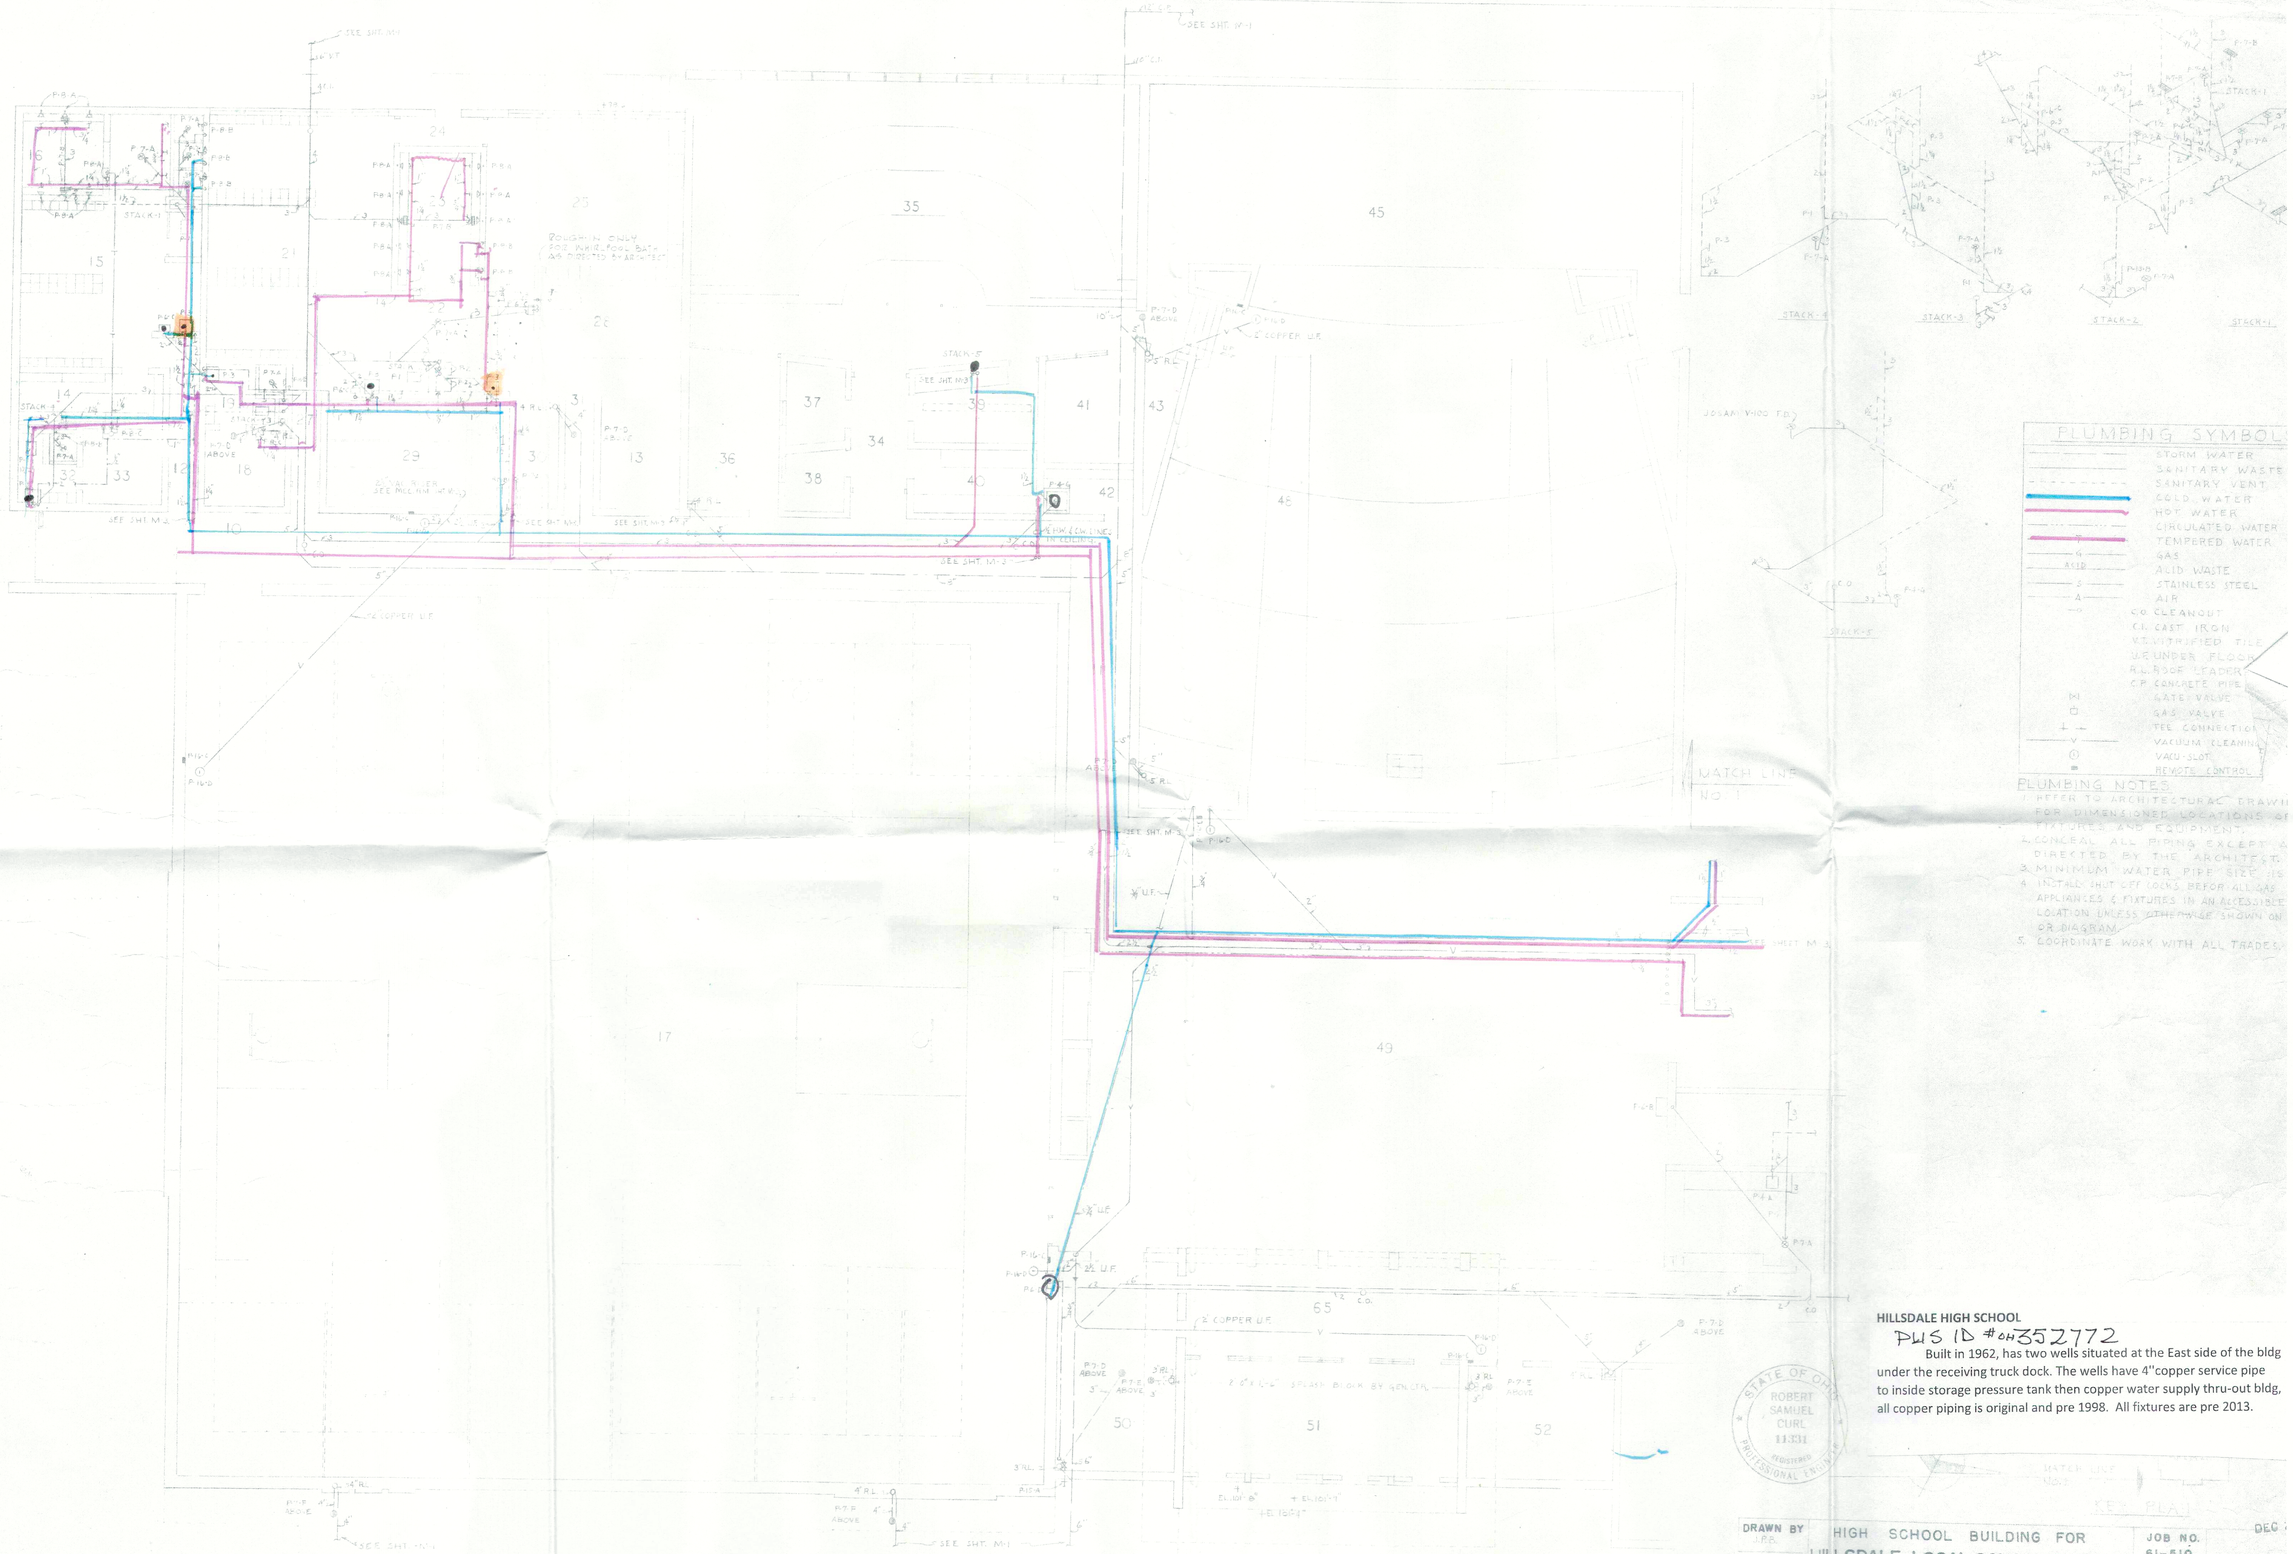

HILLSDALE HIGH SCHOOL

PWS ID #OH352772

Built in 1962, has two wells situated at the East side of the bldg under the receiving truck dock. The wells have 4"copper service pipe to inside storage pressure tank then copper water supply thru-out bldg, all copper piping is original and pre 1998. All fixtures are pre 2013.

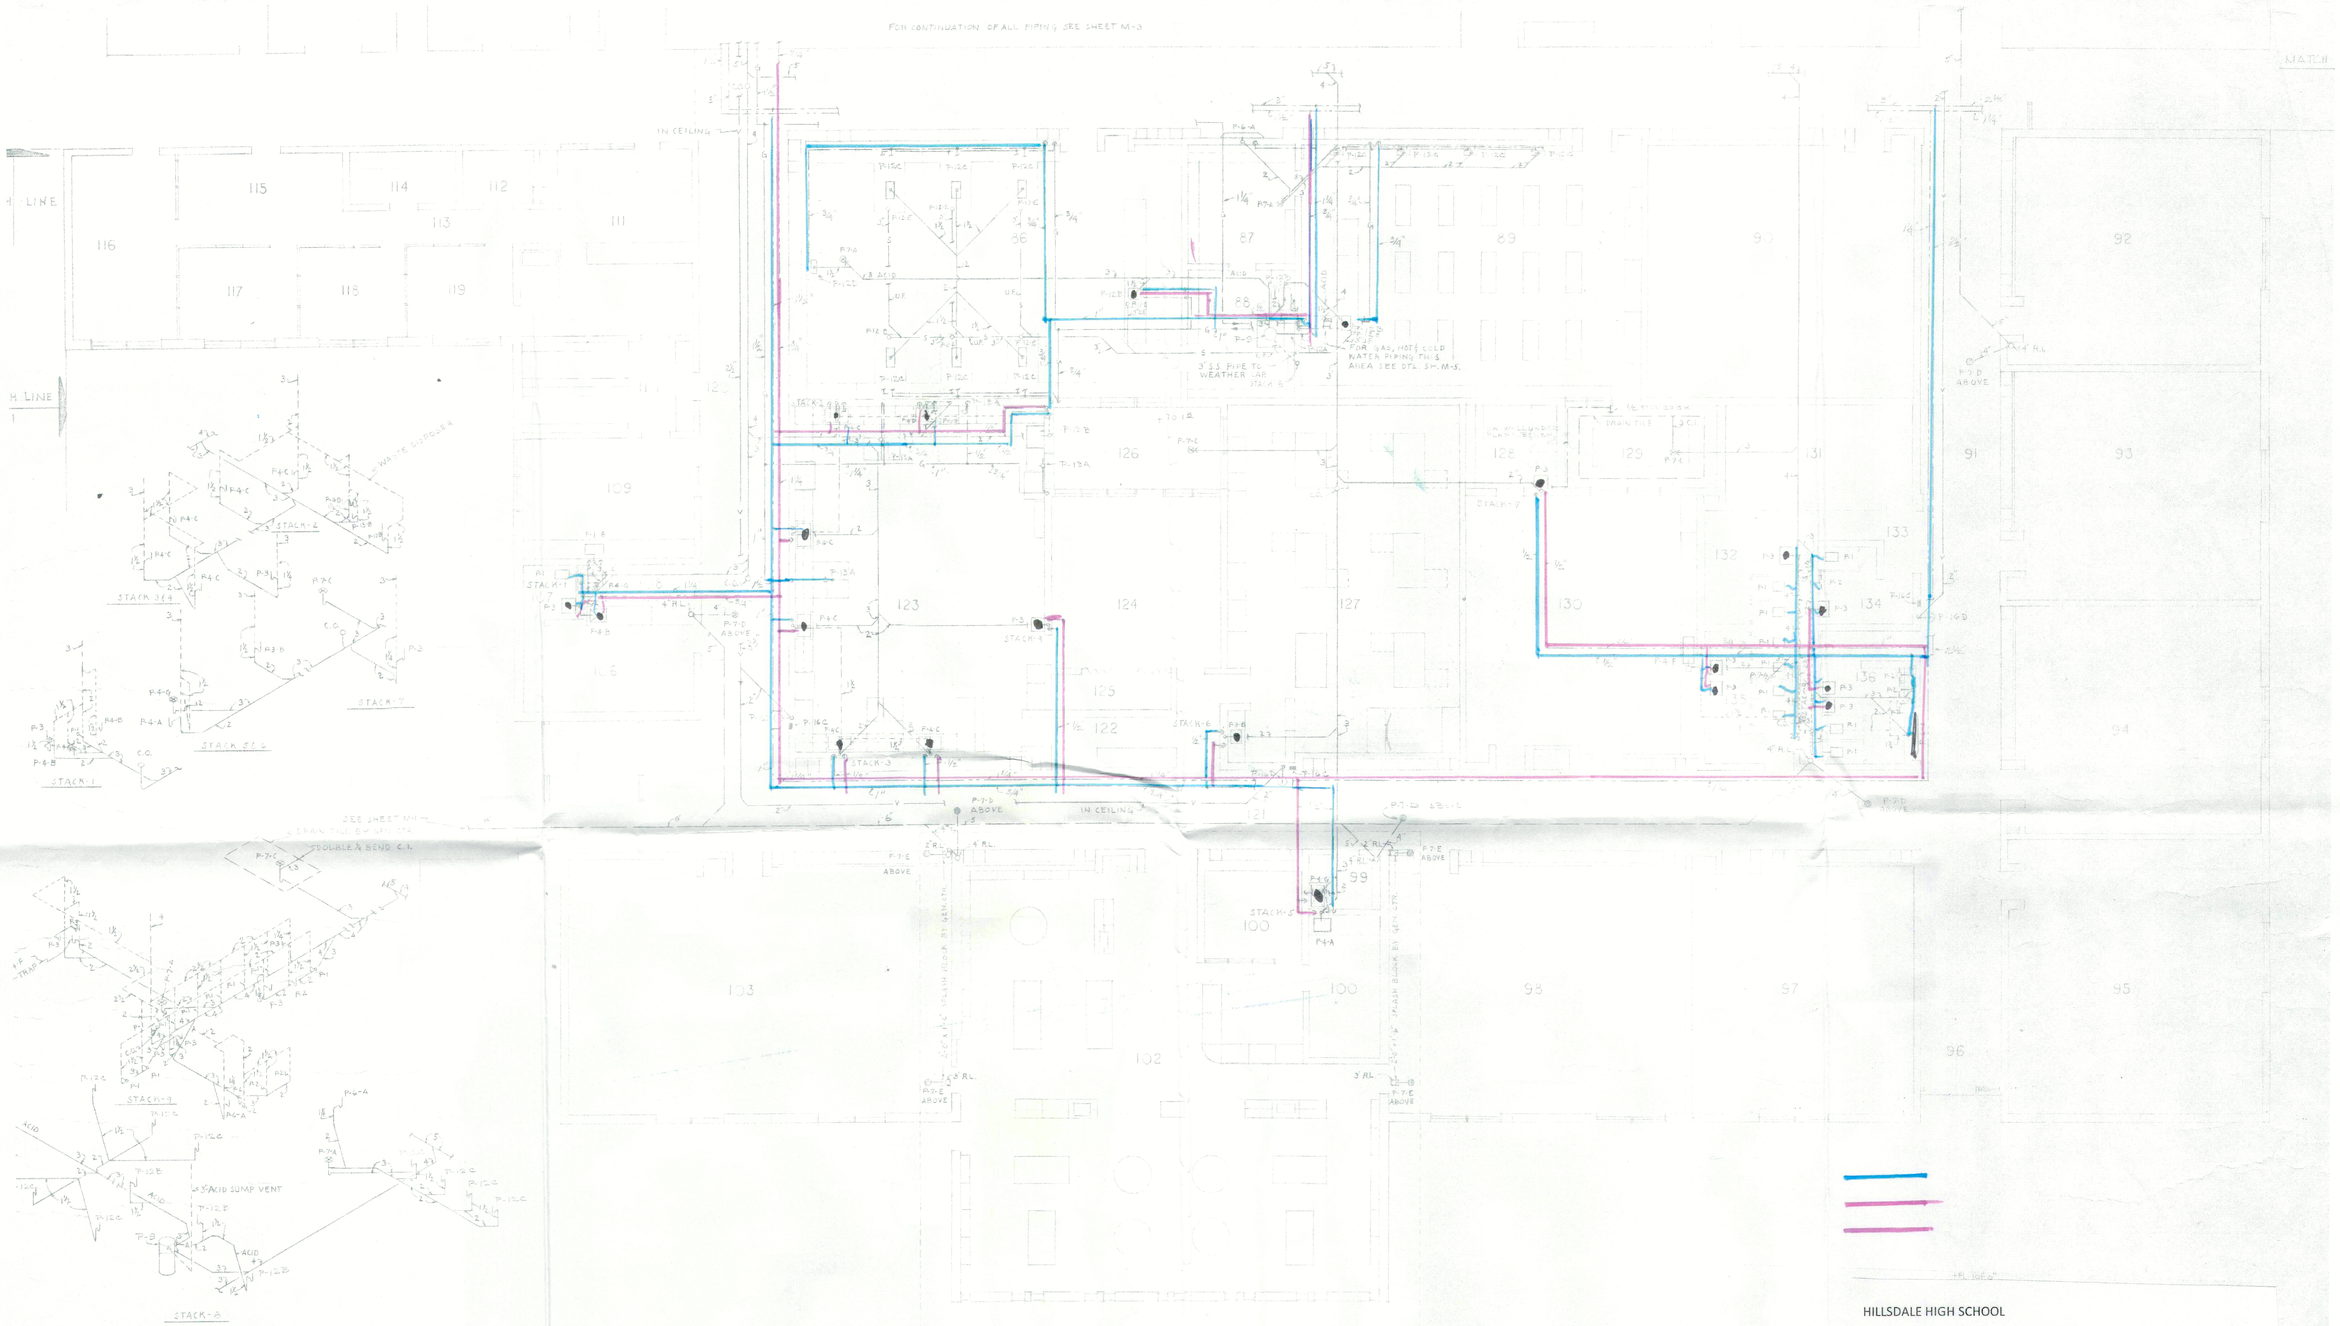

FLOOR PLAN "AREA C" SCALE 1/8" = 1'-0"

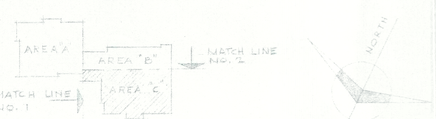

KEY PLAN

HILLSDALE HIGH SCHOOL

Built in 1962, has two wells situated at the East side of the bldg under the receiving truck dock. The wells have 4"copper service pipe to inside storage pressure tank then copper water supply thru-out bldg, all copper piping is original and pre 1998. All fixtures are pre 2013.

STATE OF OHIO ROBERT SAMUEL CUPP 11831 REGISTERED PROFESSIONAL ENGINEER

DRAWN BY J.A.B.	HIGH SCHOOL BUILDING FOR	JOB NO. 61-510
DATE NOV. 1962	HILLSDALE LOCAL SCHOOL DISTRICT	SCALE AS NOTI
REVISIONS	ASHLAND COUNTY, OHIO	
	PLUMBING AREA "C"	SHEET M-4
	MARR — KNAPP — CRAWFIS REG. ARCHITECTS	OF
	NEW PHILADELPHIA, O. MANSFIELD, O.	9