

1ST FLOOR

Nur 2

18-2 yrs

HOT+COLD TO 2nd FLOOR

WATER TANK

WATER HEATER

WATER TANK
HOT

Softeners

ADULT RESTROOM

Playroom

Nur 1

HAND WASH

Kitchen




WATER TANK

Office

ALL WATER lines are copper and soldered
All Faucets ARE Brass and believed to be Reduced Lead.

FRONT ENTRANCE

S. MAIN ST.

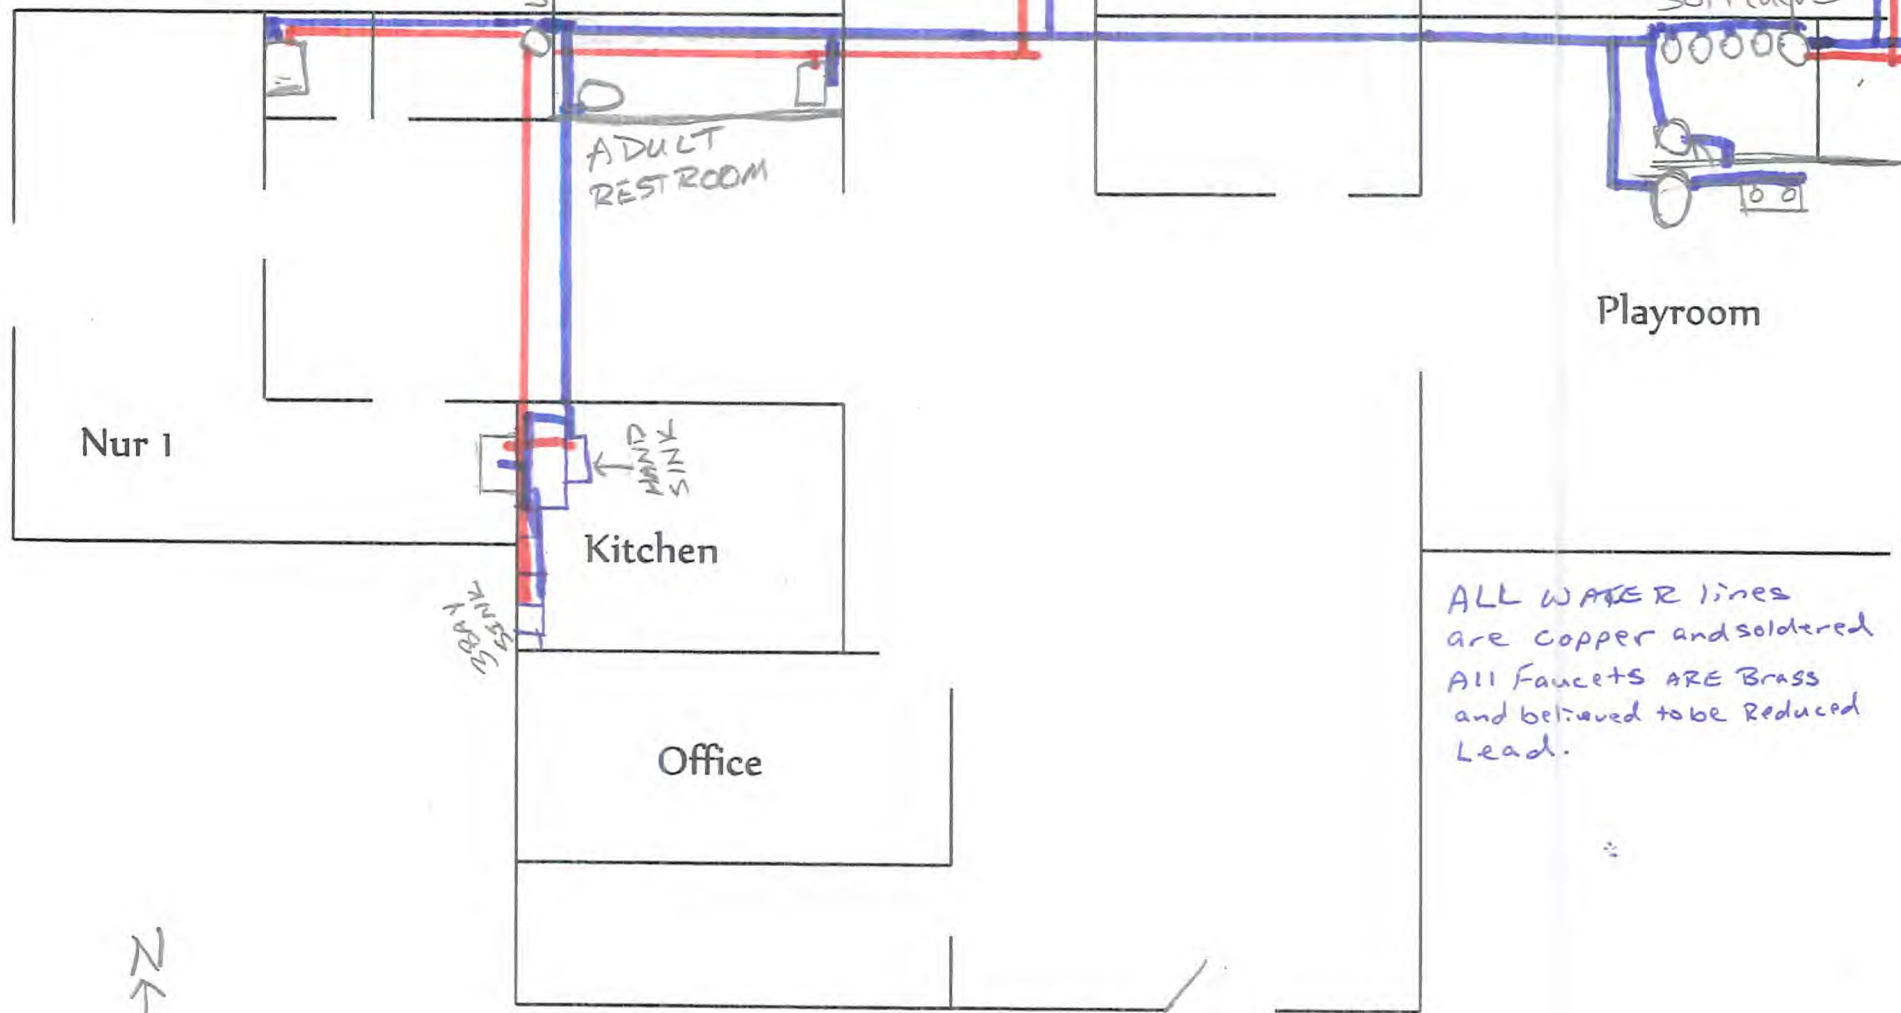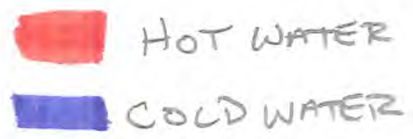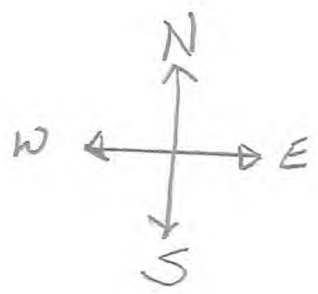

1st Floor

