


From the kitchen, exit through the north door, turn left and go out the west exterior door toward the playground OR exit the east door through the preschool classroom, exit through the east exterior door and proceed around the building to the playground.

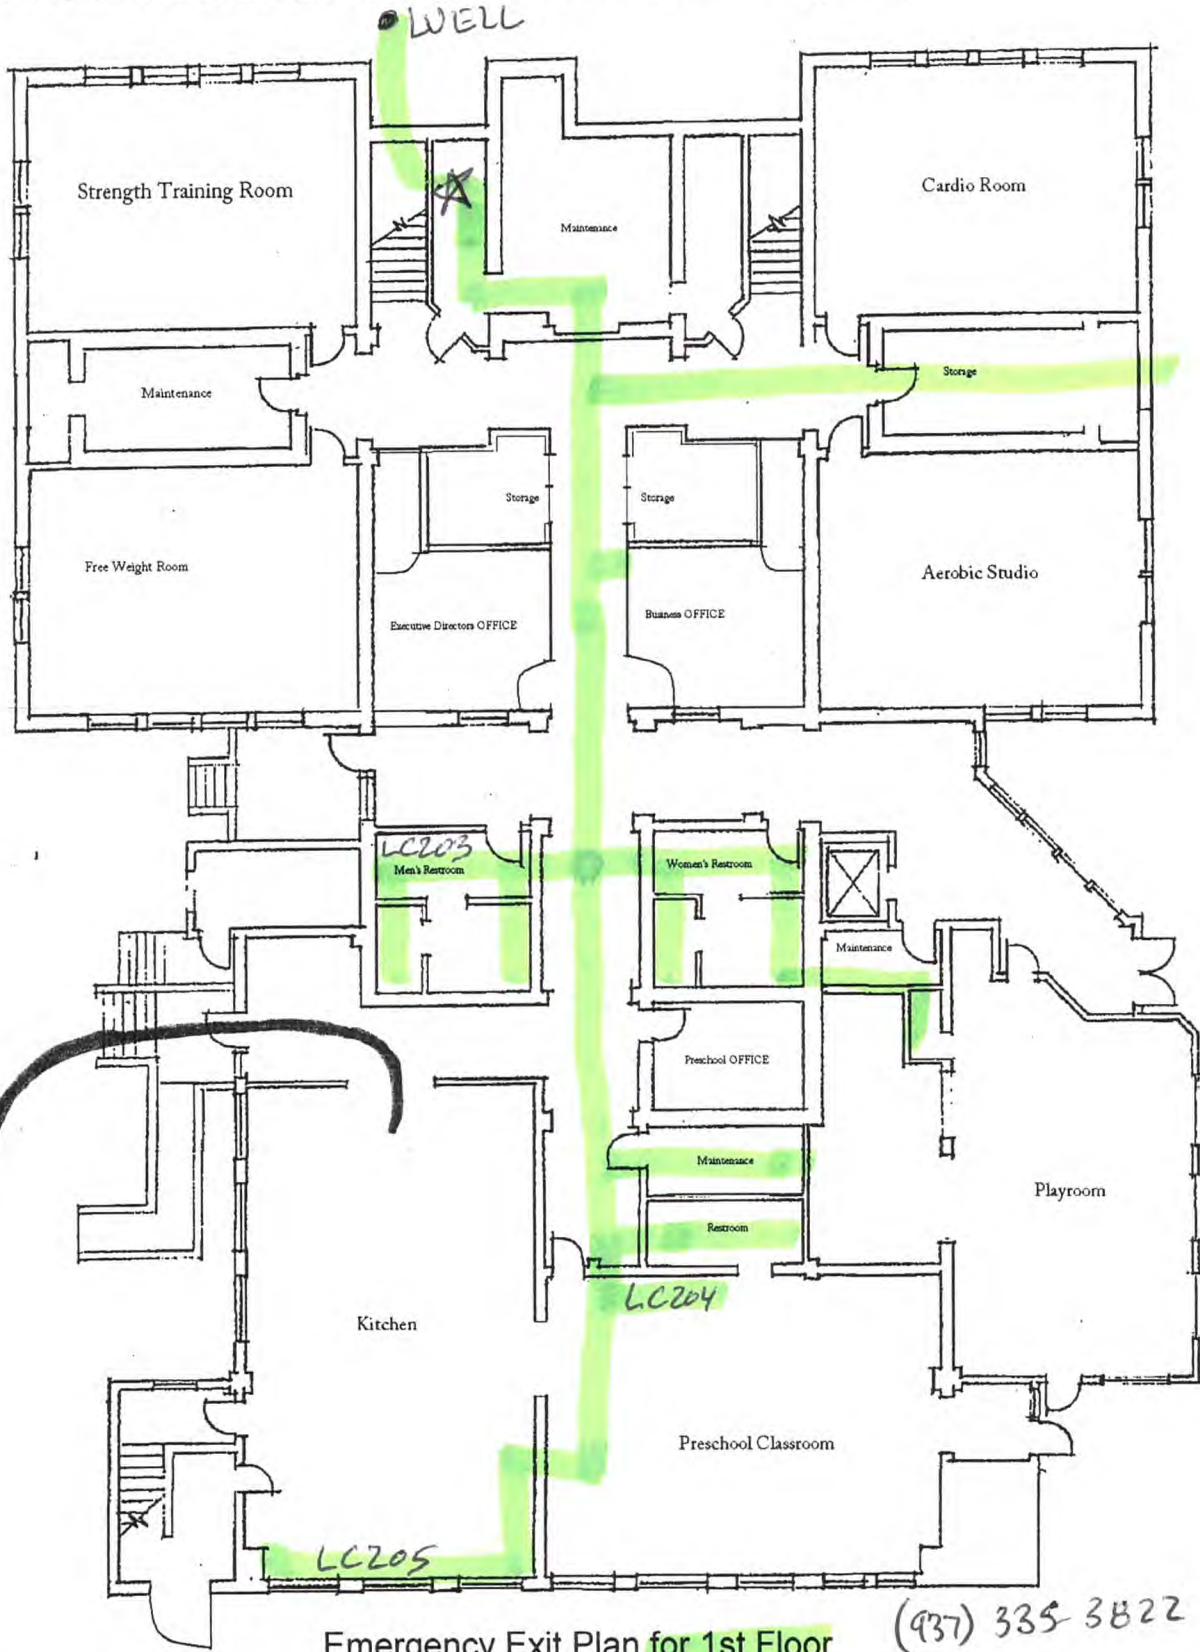

Emergency Exit Plan for 1st Floor (937) 335-3822


OH 5537712
 ELijah's Township CC
 5760 Walnut Grove - Clark Co. Rd.
 Troy, OH 45373 MIAMI COUNTY

★ Entry Point - plastic

01/20/2012

NORTH
↓

PARKING LOT

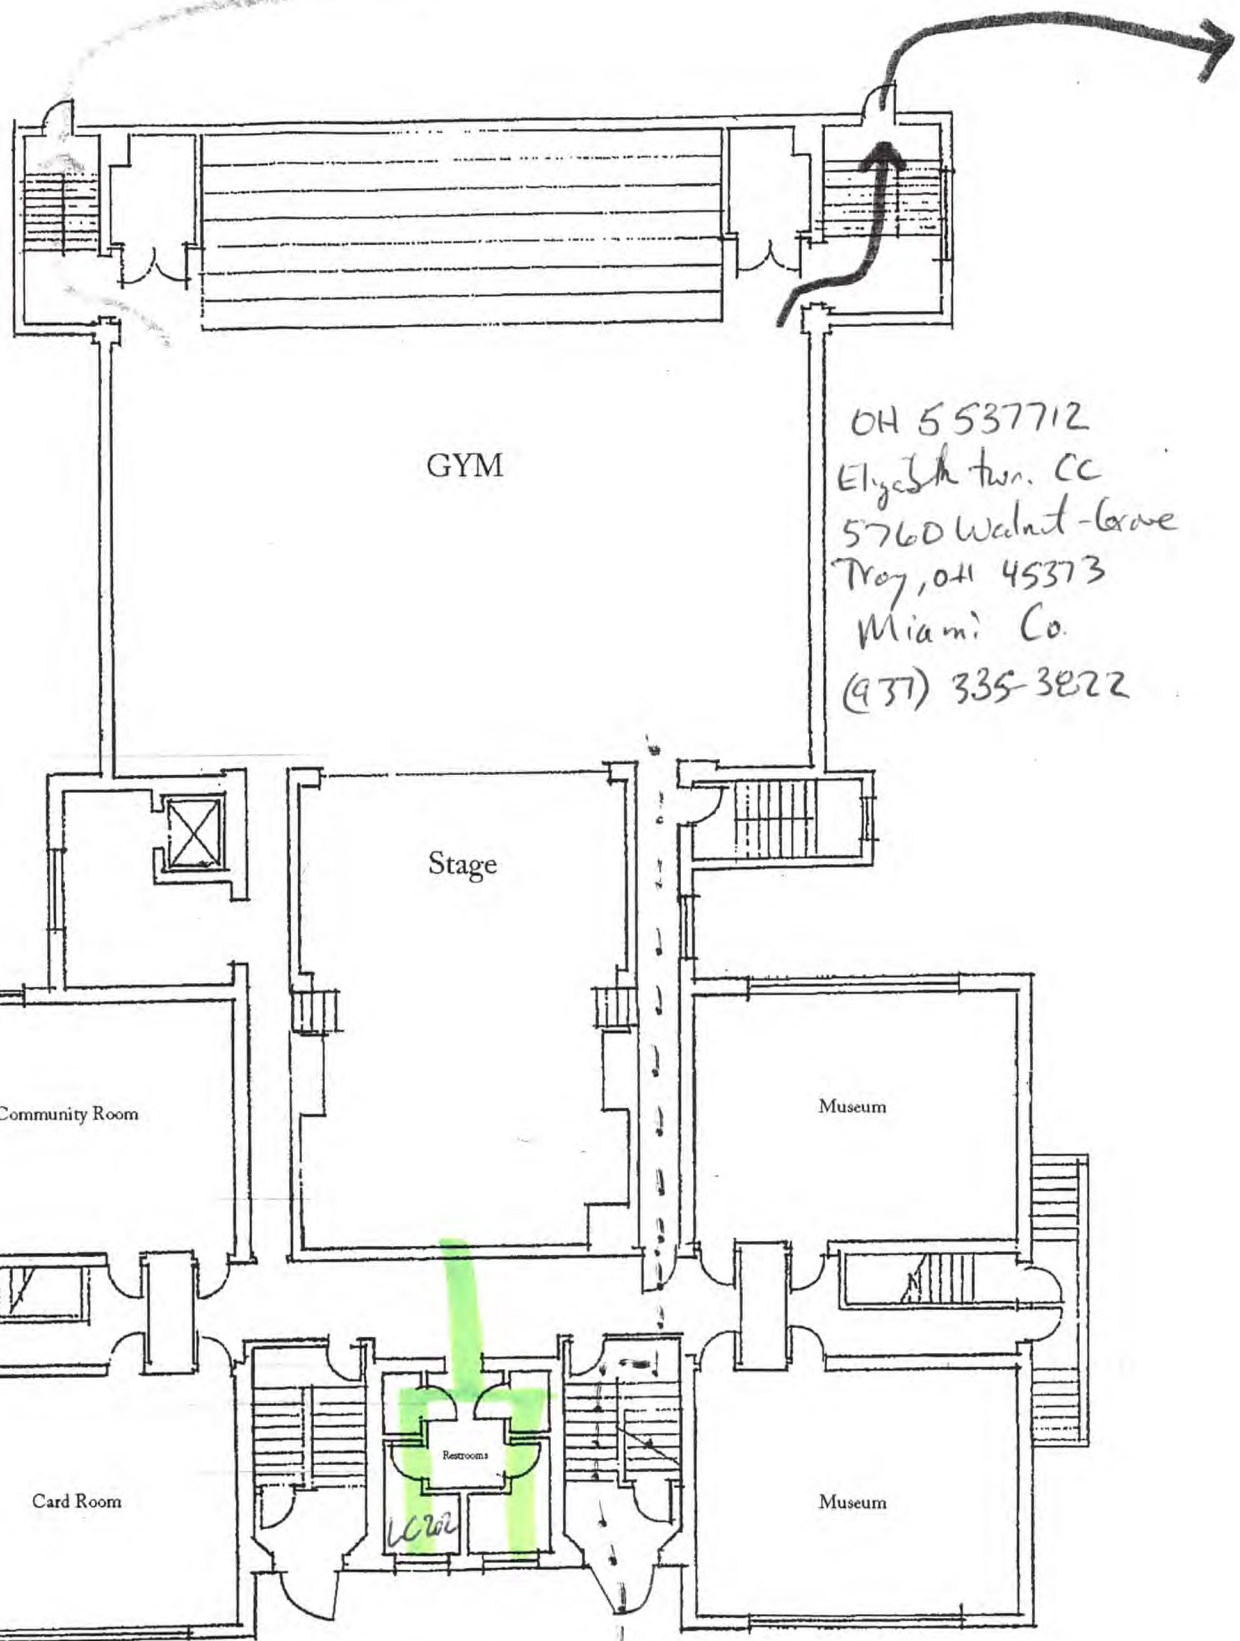

OH 5537712
5760 Walnut-Grove
Troy, OH 45373
Miami Co.
(937) 335-3822

Emergency Exit Plan for 2nd Floor

1st Floor

From the gym, exit through the west fire exit door, down the stairs, and to the playground OR exit through the east fire exit door, down the stairs, and to the playground.

Extreme Weather



(937) 335-3822
Elizabeth Township CC
5760 Walnut Grove Road
Troy, OH 45373

OH 553712

Miam. Co.

PARKING LOT

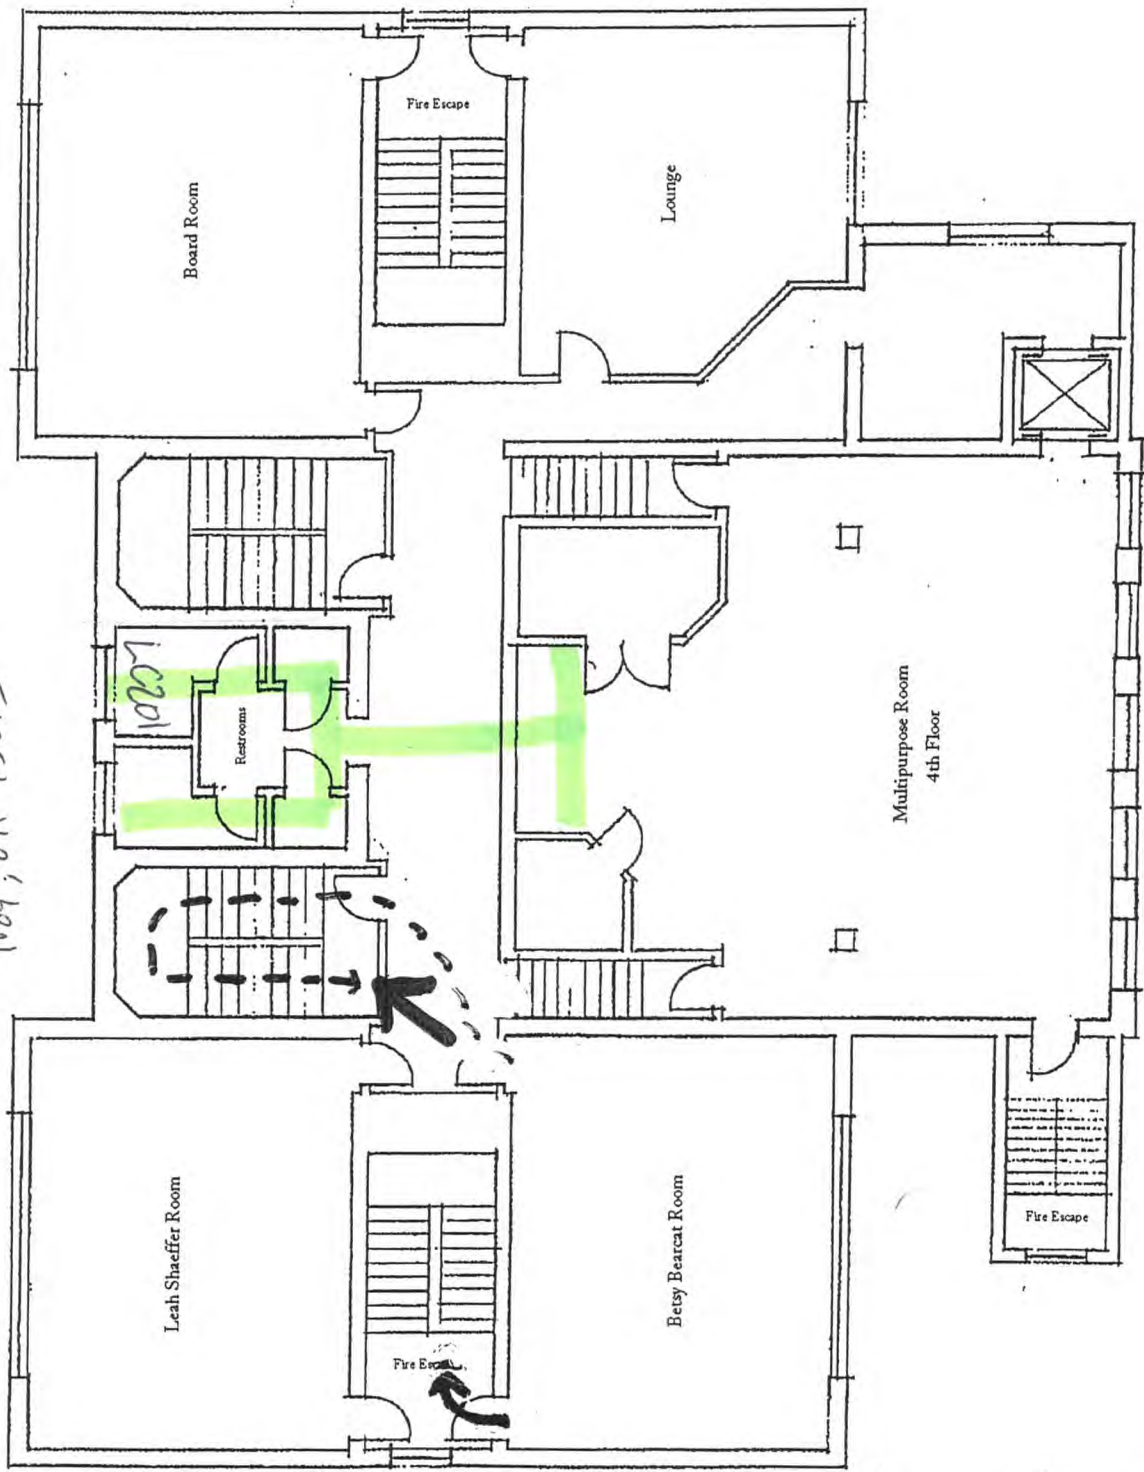

Emergency Exit Plan for 3rd and 4th Floors

From the third floor, school age room, exit through the main doorway and proceed down the stairs to the first floor, where you will exit at front of the building. Proceed left around the building to meet on the playground OR exit through the north door into the fire escape stairwell and proceed through the west exterior doors to the playground.

- All hot & cold water run parallel except water fountains

NORTH
↑