

Google Maps 3825 OH-589



Imagery ©2017 Google, Map data ©2017 Google 200 ft


2011

CONSTRUCTED 2011

WELCOME TO MIAMI EAST HIGH SCHOOL

DUCTILE IRON
WATER SERVICE
MAIN ENTRANCE

KITCHEN
LC 219

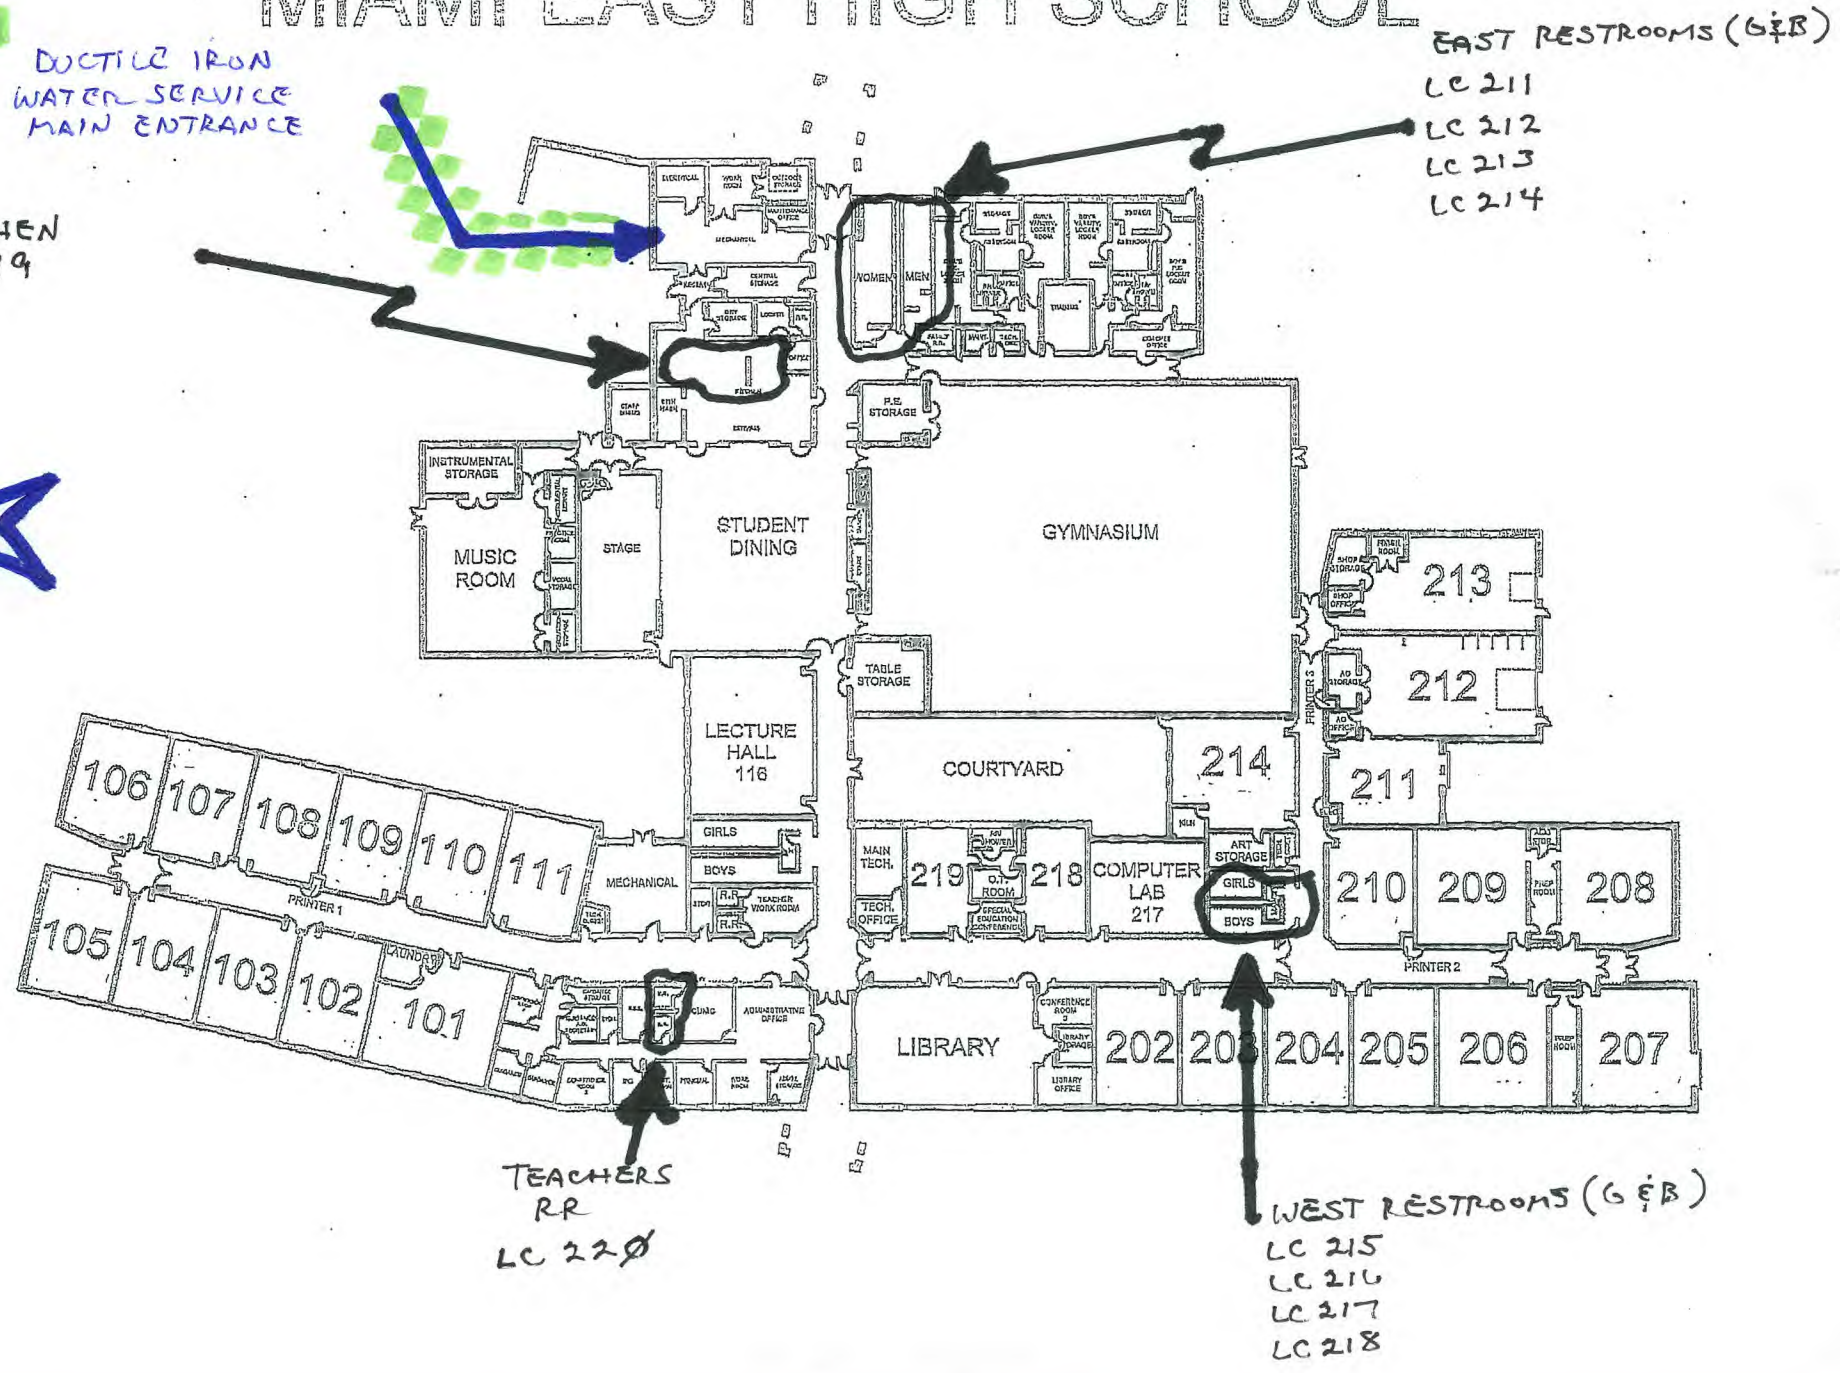

CONSTRUCTED 2004

WEST RESTROOMS (GIRLS & BOYS)

LC 209

2210

EAST RESTROOMS (GIB)

CC 201

LC 202

LC 204

LC 206

LC 208

KITCHEN

LC 20.3

LC 205

LC 207

DUCTILE IRON
WATER SERVICE MAIN
ENTRANCE

Miami East
Pre K - 8


Back

Entry
from Buses

Girls	Boys
Locker Room	Locker Room

J. H.
Playground

N 

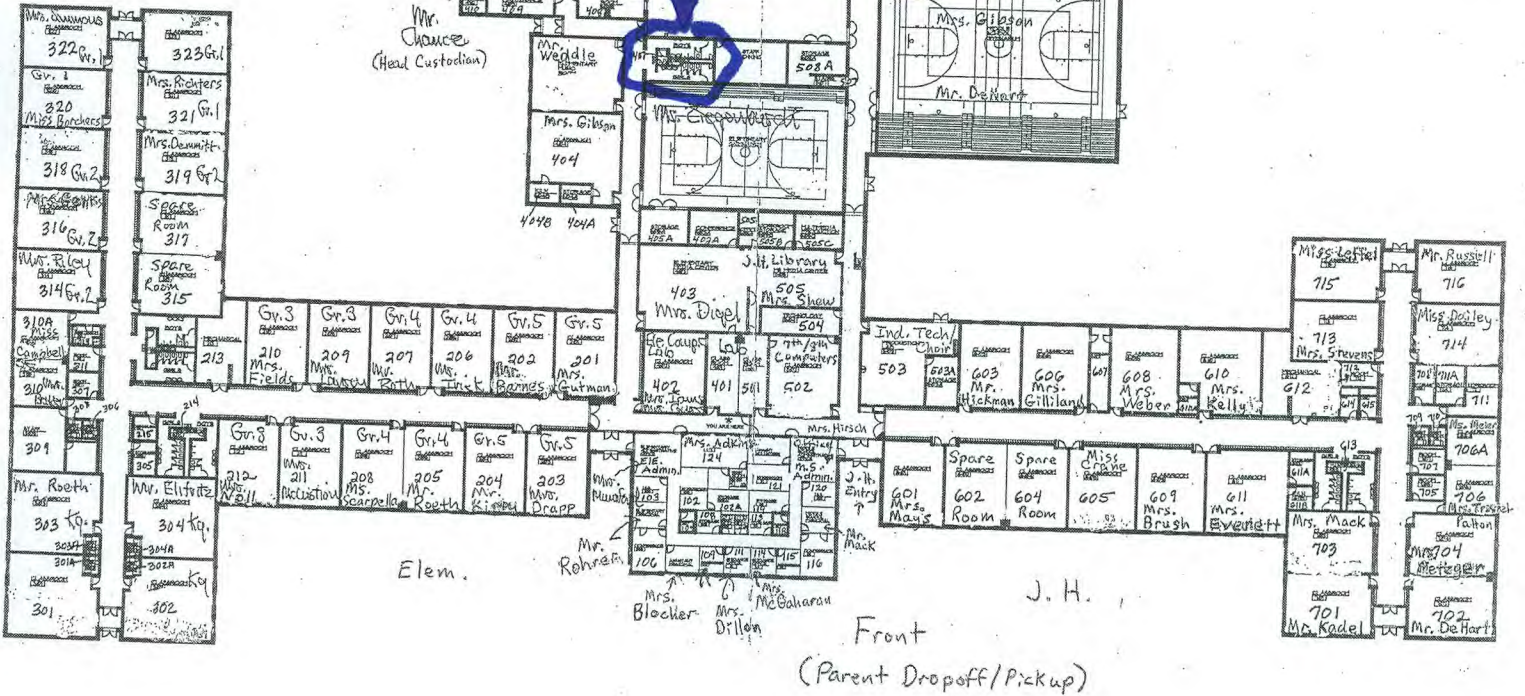

MIAMI EAST K-8

MIAMI EAST LOCAL SCHOOL SYSTEM

Miami East Local Schools are located east of SR 589 and north of SR 55, Casstown, Ohio 45312. The Miami East Local School building K-8 was completed and placed in service in 2004. The Miami East Local School High School building was completed and placed in service in 2011. Both buildings are single floor buildings. Water distribution service lines are ductile iron entering the buildings at the mechanical/boiler rooms. Copper branch plumbing lines and galvanized pipe serve the building and the solder used on these copper lines were the post 1998 lead free (low lead) variety. Fixtures in the building were built after 1998 and may contain a low lead level.