



Wrena, LLC, 265 Lightner Road, Tipp City, OH 45371
 (937) 667-4403
 OH5548012

We are unable to determine the exact entrance point of the water service line into the building. We believe that it is underground, so the exact material content is unknown.

All buildings were built prior to 1998. Unable to determine the lead content of installed fixtures, fittings or pipe. Most service lines are hidden behind walls. Assuming that because the building were built before 1998 they may have materials with greater than 8% lead.

The yellow squares indicate the locations of faucets located inside the buildings. All faucets have been replaced with plastic fixtures.

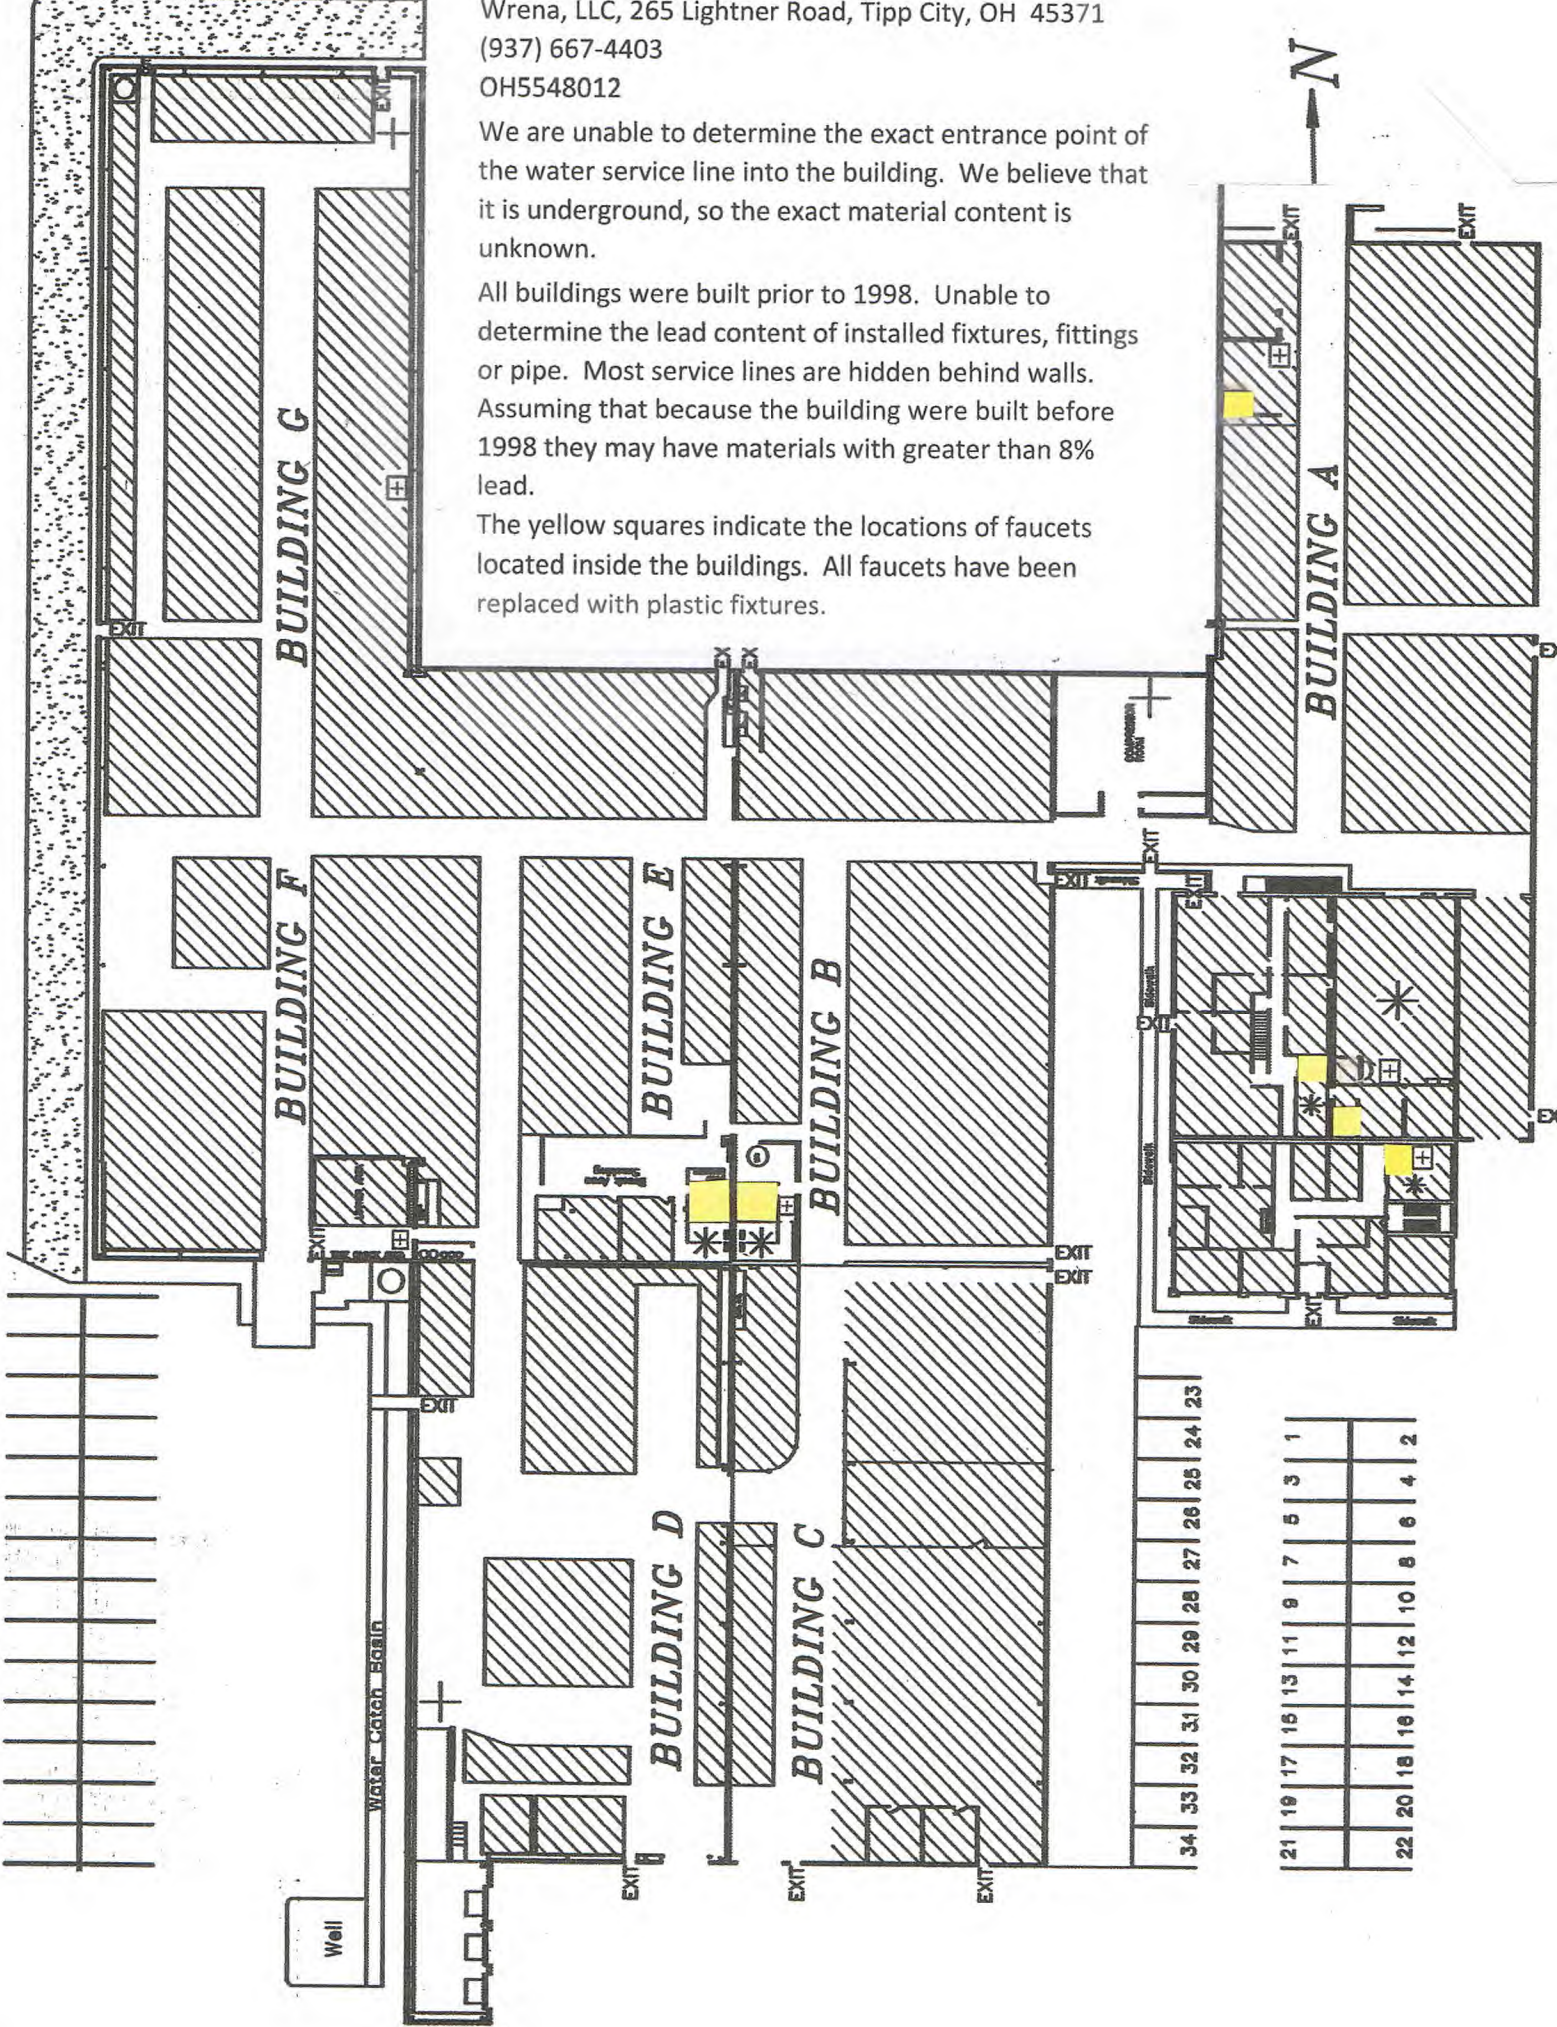

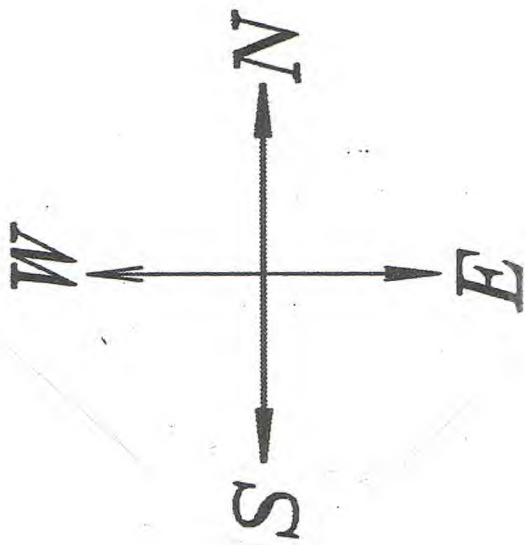

Wrena, LLC, 265 Lightner Road, Tipp City, OH 45371
(937) 667-4403
OH5548012

We are unable to determine the exact entrance point of the water service line into the building. We believe that it is underground, so the exact material content is unknown.

All buildings were built prior to 1998. Unable to determine the lead content of installed fixtures, fittings or pipe. Most service lines are hidden behind walls. Assuming that because the building were built before 1998 they may have materials with greater than 8% lead.

The yellow squares indicate the locations of faucets located inside the buildings. All faucets have been replaced with plastic fixtures.

