


London Correctional Institution and Madison Correctional Institution Water Lines

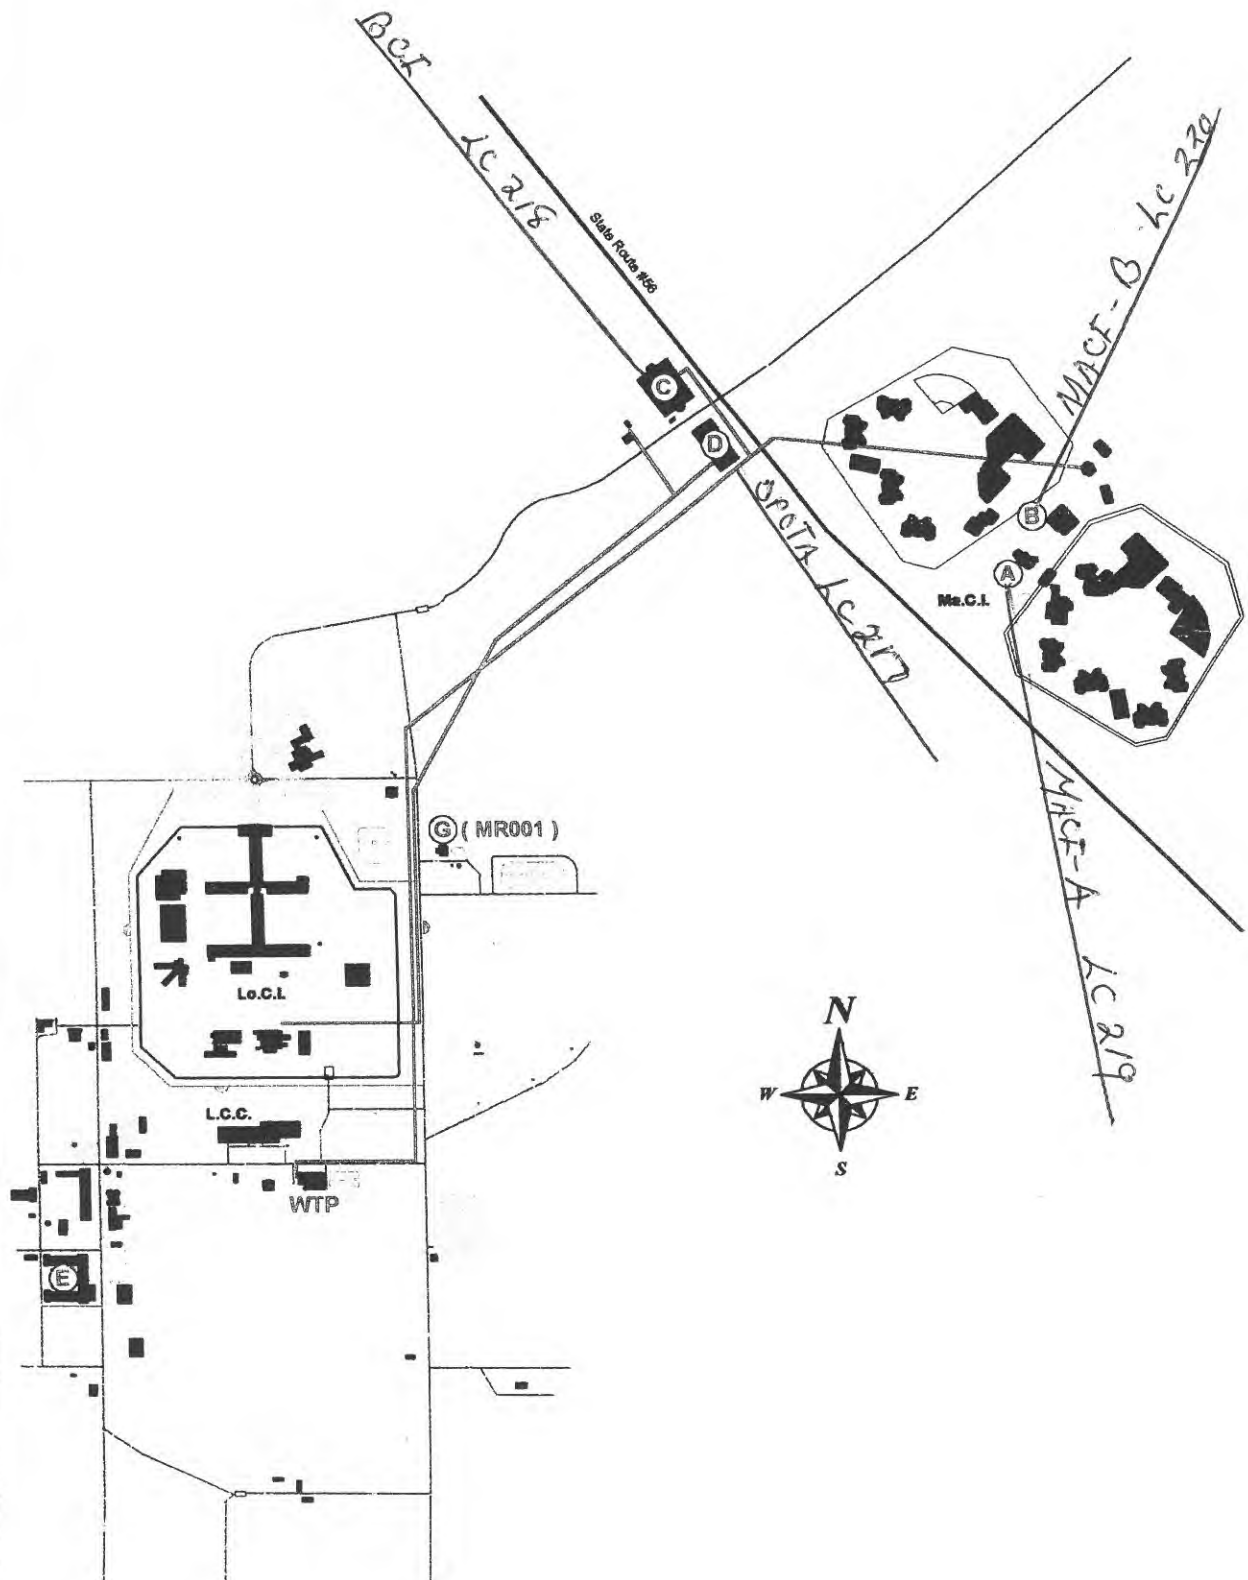

LEAD AND COPPER SAMPLE MONITORING REPORT

ODRC-LONDON CORRECTIONAL

PWS: OH4901012

FACILITY ID: DS1 SMP ID: DS000

POPULATION 6,000 AVERAGE SERVED


20 SAMPLE SITES REQUIRED

ADDRESS: LoCI, 1580 St. Rt. 56, London, Ohio 43140	# ID OH4901012	LOCATION Madison County	INTERIOR PIPING	SERVICE LINES	TIER 1,2,3 or Other	STRUCTURE
--	-------------------	-------------------------------	--------------------	------------------	---------------------------	-----------

LoCI 1580 St. Rt. 56	LC201	Dairy Barn--R	CuPb<P83	Ductile	Other	BLDG
LoCI 1580 St. Rt. 56	LC202	Farm--R	Culf	Ductile	Other	BLDG
LoCI 1580 St. Rt. 56	Lc203	Grainery--R	CuPb<83	Ductile	Other	BLDG
LoCI 1580 St. Rt. 56	LC204	Water Plant--R	Culf	Ductile	Other	BLDG
LoCI 1580 St. Rt. 56	LC205	Sewer Plant--R	CuPb<83	Ductile	Other	BLDG
LoCI 1580 St. Rt. 56	LC206	A-3 Dorm--R	CuPb<83	Ductile	Other	BLDG
LoCI 1580 St. Rt. 56	LC207	D-1 Dorm--R	CuPb<83	Ductile	Other	BLDG
LoCI 1580 St. Rt. 56	LC208	LoCI Adm.--R	CuPb<83	Ductile	Other	BLDG
LoCI 1580 St. Rt. 56	LC209	Steel Shed--R	CuPb<83	Ductile	Other	BLDG
LoCI 1580 St. Rt. 56	LC210	Garage--R	CuPb<83	Ductile	Other	BLDG
LoCI 1580 St. Rt. 56	LC211	Powerhouse--R	CuPb<83	Ductile	Other	BLDG
LoCI 1580 St. Rt. 56	LC212	Brush Factory--R	CuPb<83	Ductile	Other	BLDG
LoCI 1580 St. Rt. 56	LC213	Recreation--R	Culf	PVC	Other	BLDG
LoCI 1580 St. Rt. 56	LC214	LoCI Kitchen--R	Culf	PVC	Other	BLDG
LoCI 1580 St. Rt. 56	LC215	Maintenance Dept--R	CuPb<83	Ductile	Other	BLDG
LoCI 1580 St. Rt. 56	LC216	Best Practice--R	CuPb<83	Ductile	Other	BLDG
LoCI 1580 St. Rt. 56	LC217	Opota--R	Culf	Ductile	Other	BLDG
LoCI 1580 St. Rt. 56	LC218	BCI	CuPb<83	Ductile	Other	BLDG
LoCI 1580 St. Rt. 56	LC219	MaCI-A--R	Culf	PVC	Other	BLDG
LoCI 1580 St. Rt. 56	LC220	MaCI-B--R	Culf	PVC	Other	BLDG

1. Two Sites: Bureau of Criminal Investigation (BCI) LC218 and Ohio Police Officer Training Academy (OPOTA) LC217 have Water Softeners within their systems.
2. Seven Sites have Interior Piping that are copper piping with lead free connections: LoCI Farm (LC202), Water Plant LC204), LoCI Recreation Building (LC213), LoCI Kitchen (LC214), OPOTA (LC217), Madison Correctional Institution: (MaCI-A LC219) and (MaCI-B LC220).
3. There are 16 ductile service lines and 4 PVC service lines.
4. Maps of site locations included.

Submitted By:

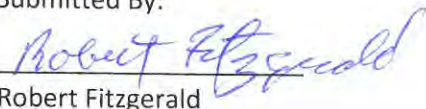
Robert Fitzgerald
Treatment Plant Operations Manager
London Correctional Institution
1580 State Route 56
London, Ohio 43140

Cell: (740) 919-1647
Inst: (740) 852-2454
robert.fitzgerald@odrc.state.oh.us



**VERIFICATION FORM FOR COMMUNITY PUBLIC WATER SYSTEMS
CLAIMING NO LEAD SERVICE LINES**

The owner or operator of all community public water systems must identify and map areas of their distribution system that are known or are likely to contain lead service lines. Systems must submit a copy of the applicable map to the Ohio Department of Health and the Ohio Department of Job and Family Services. Systems must also submit a report to the director containing at least both of the following: (1) The applicable map with narrative, and (2) A list of sampling locations used to collect samples as required by Ohio Revised Code (ORC) Section 6109.121 and any rules adopted thereunder, including contact information for the owner and occupant of each sampling site.

Should a water system determine no lead service lines exist in their distribution system, they must provide information stating they reviewed, at the minimum, historical permit records and local ordinances, distribution maintenance records and information pertaining to installation dates or materials for all services lines. This information must be verified below.

I HEREBY CERTIFY THAT THE FOLLOWING METHOD(S) WERE USED TO DETERMINE NO LEAD SERVICE LINES EXIST IN THIS WATER SYSTEM'S DISTRIBUTION SYSTEM, AS REQUIRED BY ORC 6109.121(F):

LEAD SERVICE LINE VERIFICATION
<p>This PWS states they have no lead service lines and has reviewed the following information (select one or more of the following):</p> <ul style="list-style-type: none"> <input type="checkbox"/> Historical permit records and/or local ordinances <input type="checkbox"/> Distribution maintenance records (i.e. meter replacement, waterline break repairs) <input type="checkbox"/> Information pertaining to installation dates for all service lines (i.e. after 1986 when lead services lines were banned) <input checked="" type="checkbox"/> Service line material of all service lines is known (i.e. all service lines are known to be PVC)

Robert Fitzgerald

Signature of Responsible Person

03-08-2017

Date

PWS NAME: *ONEC Levee Correctional*

PWS ID: *OH 4901012*

COUNTY: *Madison*

Robert Fitzgerald, Treatment Plant Operations Manager

Printed Name and Title of Responsible Person

For Ohio EPA use only:

Date Verification Rec'd:

3/9/17 KAA