




# Madison-Plains Junior High School



ALPHA

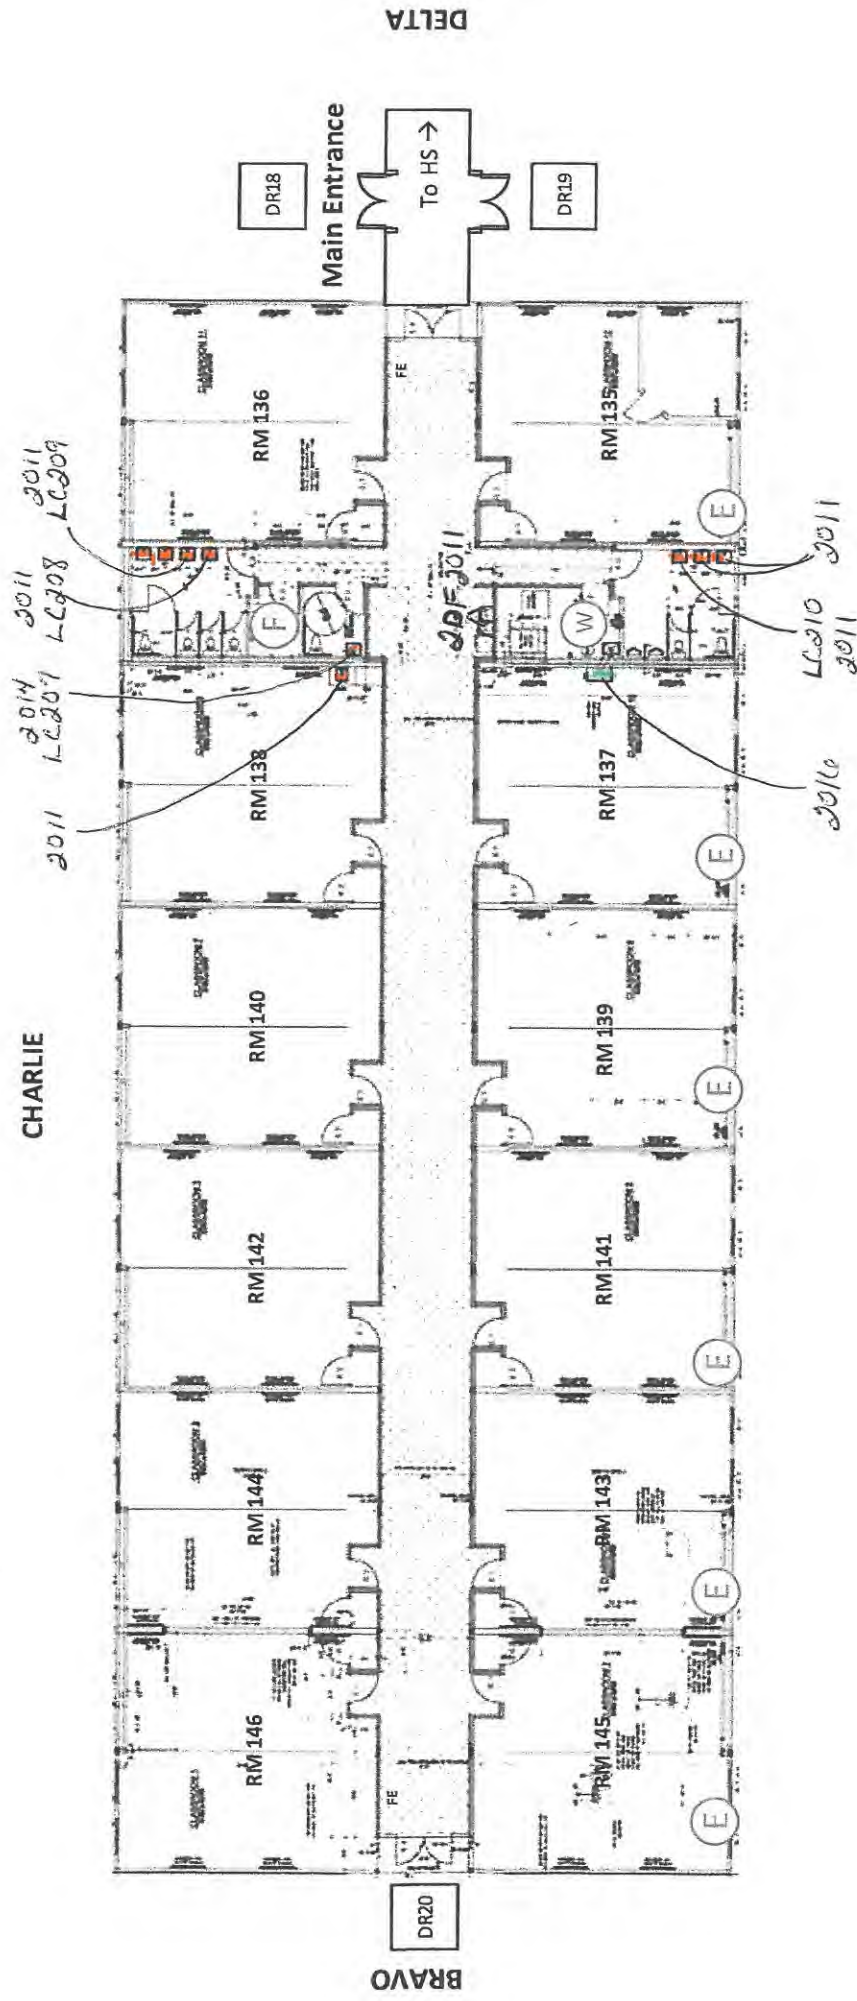