

RE: Northern Ohio Rural Water – SE District
Report
Drinking Water Program
Huron County
PWS ID: OH3946612

**VERIFICATION FORM FOR COMMUNITY PUBLIC WATER SYSTEMS
CLAIMING NO LEAD SERVICE LINES**

The owner or operator of all community public water systems must identify and map areas of their distribution system that are known or are likely to contain lead service lines. Systems must submit a copy of the applicable map to the Ohio Department of Health and the Ohio Department of Job and Family Services. Systems must also submit a report to the director containing at least both of the following: (1) The applicable map with narrative, and (2) A list of sampling locations used to collect samples as required by Ohio Revised Code (ORC) Section 6109.121 and any rules adopted thereunder, including contact information for the owner and occupant of each sampling site.

Should a water system determine no lead service lines exist in their distribution system, they must provide information stating they reviewed, at the minimum, historical permit records and local ordinances, distribution maintenance records and information pertaining to installation dates or materials for all services lines. This information must be verified below.

I HEREBY CERTIFY THAT THE FOLLOWING METHOD(S) WERE USED TO DETERMINE NO LEAD SERVICE LINES EXIST IN THIS WATER SYSTEM'S DISTRIBUTION SYSTEM, AS REQUIRED BY ORC 6109.121(F):

LEAD SERVICE LINE VERIFICATION
<p>This PWS states they have no lead service lines and has reviewed the following information (select one or more of the following):</p> <ul style="list-style-type: none"> <input type="checkbox"/> Historical permit records and/or local ordinances <input type="checkbox"/> Distribution maintenance records (i.e. meter replacement, waterline break repairs) <input type="checkbox"/> Information pertaining to installation dates for all service lines (i.e. after 1986 when lead services lines were banned) <input checked="" type="checkbox"/> Service line material of all service lines is known (i.e. all service lines are known to be PVC)

<i>Bryan Puder</i>	3-7-17
Signature of Responsible Person	Date
Bryan Puder	Distribution Superintendent
Printed Name and Title of Responsible Person	

Northern Ohio Rural Water	
PWS NAME:	Southeast District
PWS ID:	OH 3946612
COUNTY:	Huron

<p><u>For Ohio EPA use only:</u></p> <p>Date Verification Rec'd: _____</p>

RECEIVED

MAR 07 2017

DDAGW - NWDO

March 6, 2017



**Northern Ohio Rural Water Southeast District
OH3946612**

**Description of buildings served by the water system likely to contain
lead solder**

The construction of Northern Ohio Rural Water Southeast water system began in 2004.

There are no lead service lines in the Northern Ohio Rural Water Southeast system.

Since there are no lead service lines in the water system Northern Ohio Rural Water has worked on trying to identify what material the customer's service line and indoor plumbing was made of.

In January of 2017 Northern Ohio Rural Water included a lead survey in all customer bills. The survey asked the age of their home, if their indoor plumbing was copper pipes with lead solder installed before 1983, or installed after 1982, if they had plastic, galvanized or plex plumbing. It also asked what material the service line was from the road to their house and if they had a filter on their water line.

This information gathered is plotted on the map indicating home/buildings with copper plumbing with lead solder before 1983 and copper plumbing with lead solder after 1982.

Buildings in Ohio built prior to 1989 or that use plumbing material or solder manufactured before 1998 may have materials with greater than 8% lead and are at a higher risk of contributing lead to the drinking water than materials manufactured after 1998. In addition, buildings built and plumbing materials manufactured after 2014 were required to have less than 0.25% lead by weight and have the lowest risk for contributing lead to drinking water. It should be noted however that, although prohibited, some use of leaded solder or leaded components may have occurred after the prohibitions became effective.

Bryan Puder

Distribution Superintendent
Northern Ohio Rural Water




RECEIVED

MAR 07 2017

DDAGW - NWDO

Northern Ohio Rural Water SE District Lead Map Public Water System OH3946612

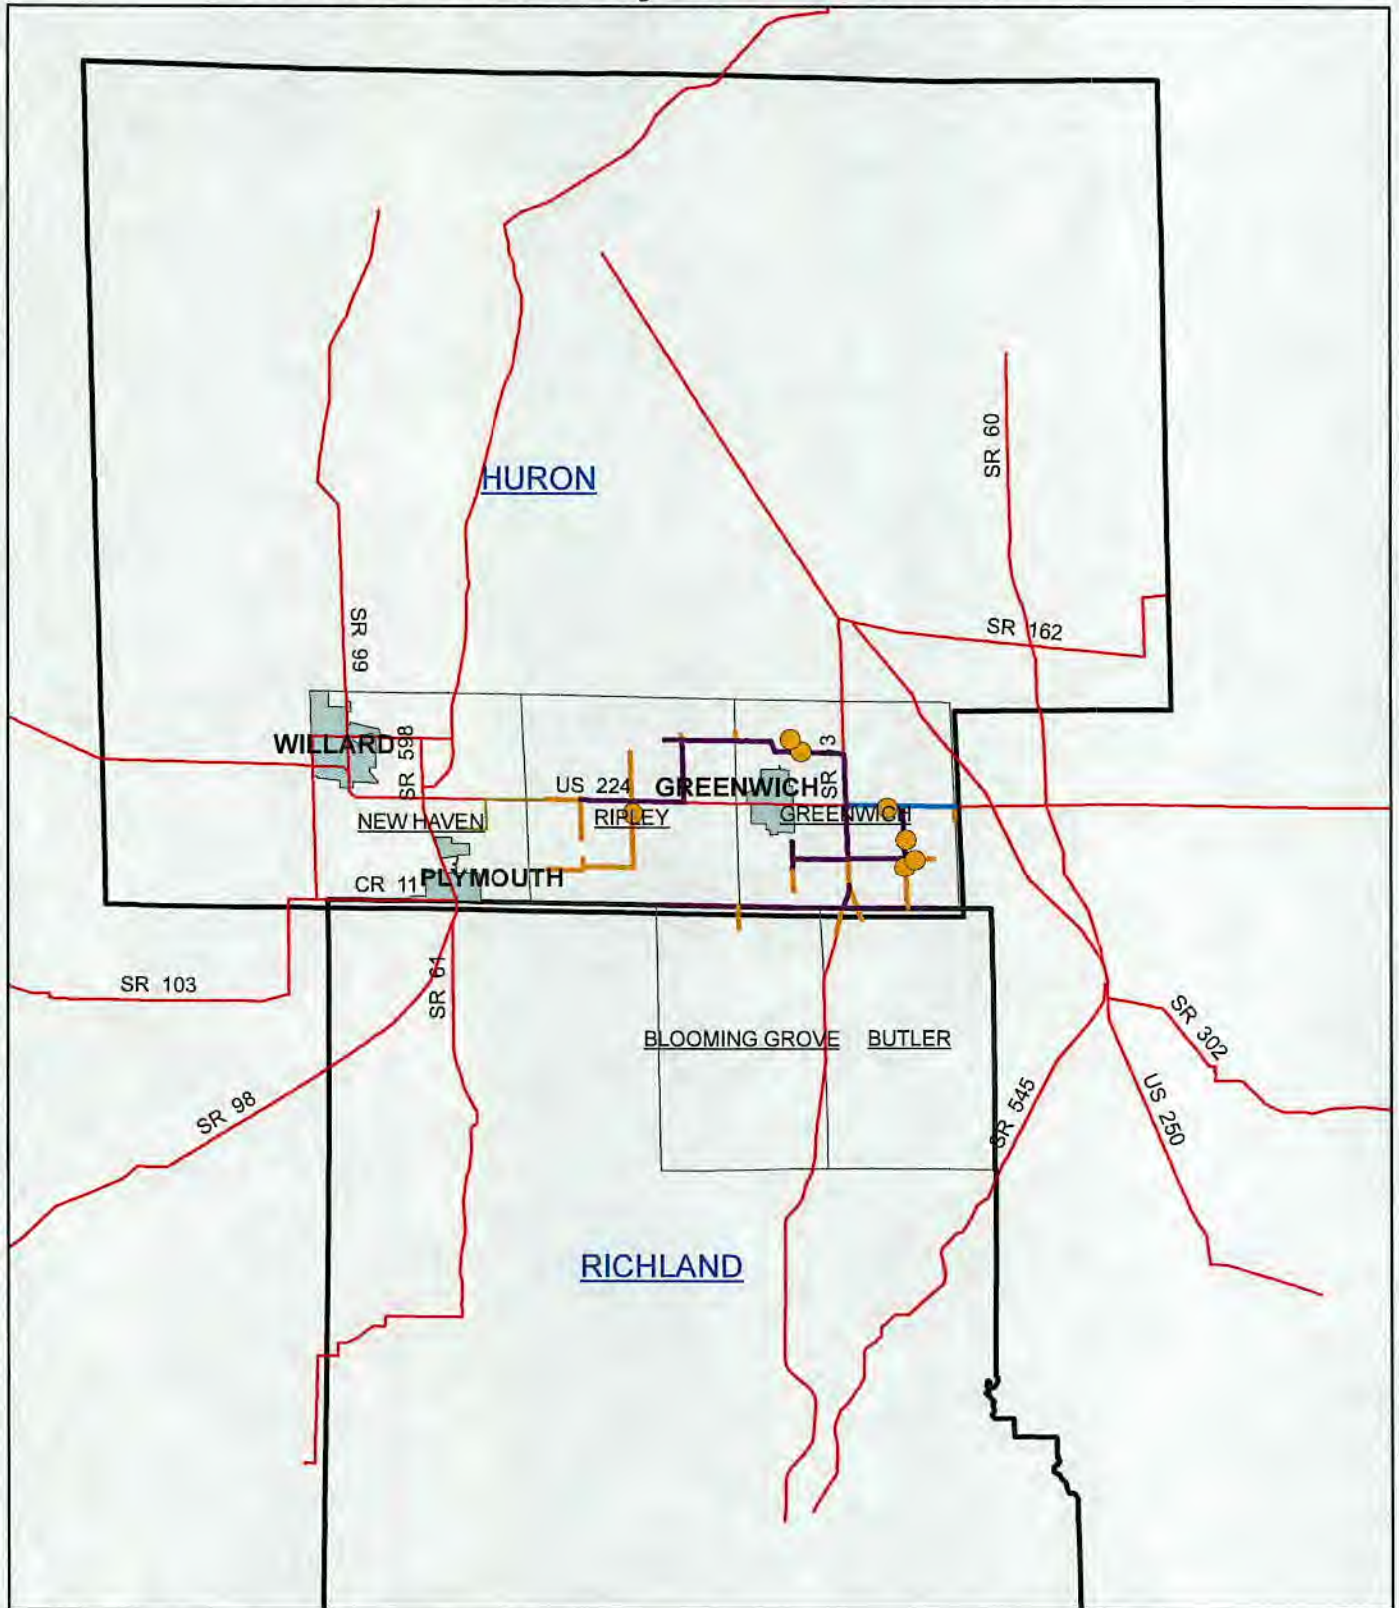

Lead_Survey

Tier

- LeadCopper > 1982
- LeadCopper < 1983

RECEIVED

MAR 08 2017

DDAGW - NWDO

