




"Because it is practically impossible to determine the lead content of an installed fixture, fitting or pipe, it should be assumed that the manufacture or installation date is the primary indicator of the lead content. Therefore, the characteristics of buildings and piping solder or fixtures would be buildings built prior to 1998 or that use plumbing material or solder manufactured before 1998 may have materials with greater than 8% lead and are at a higher risk of contributing lead to the drinking water than materials manufactured after 1998. In addition, buildings built and plumbing materials manufactured after 2014 were required to have less than 0.25% lead by weight and have the lowest risk for contributing lead to the drinking water. It should be noted however that, although prohibited, some use of leaded solder or leaded components may have occurred after the prohibitions became effective."

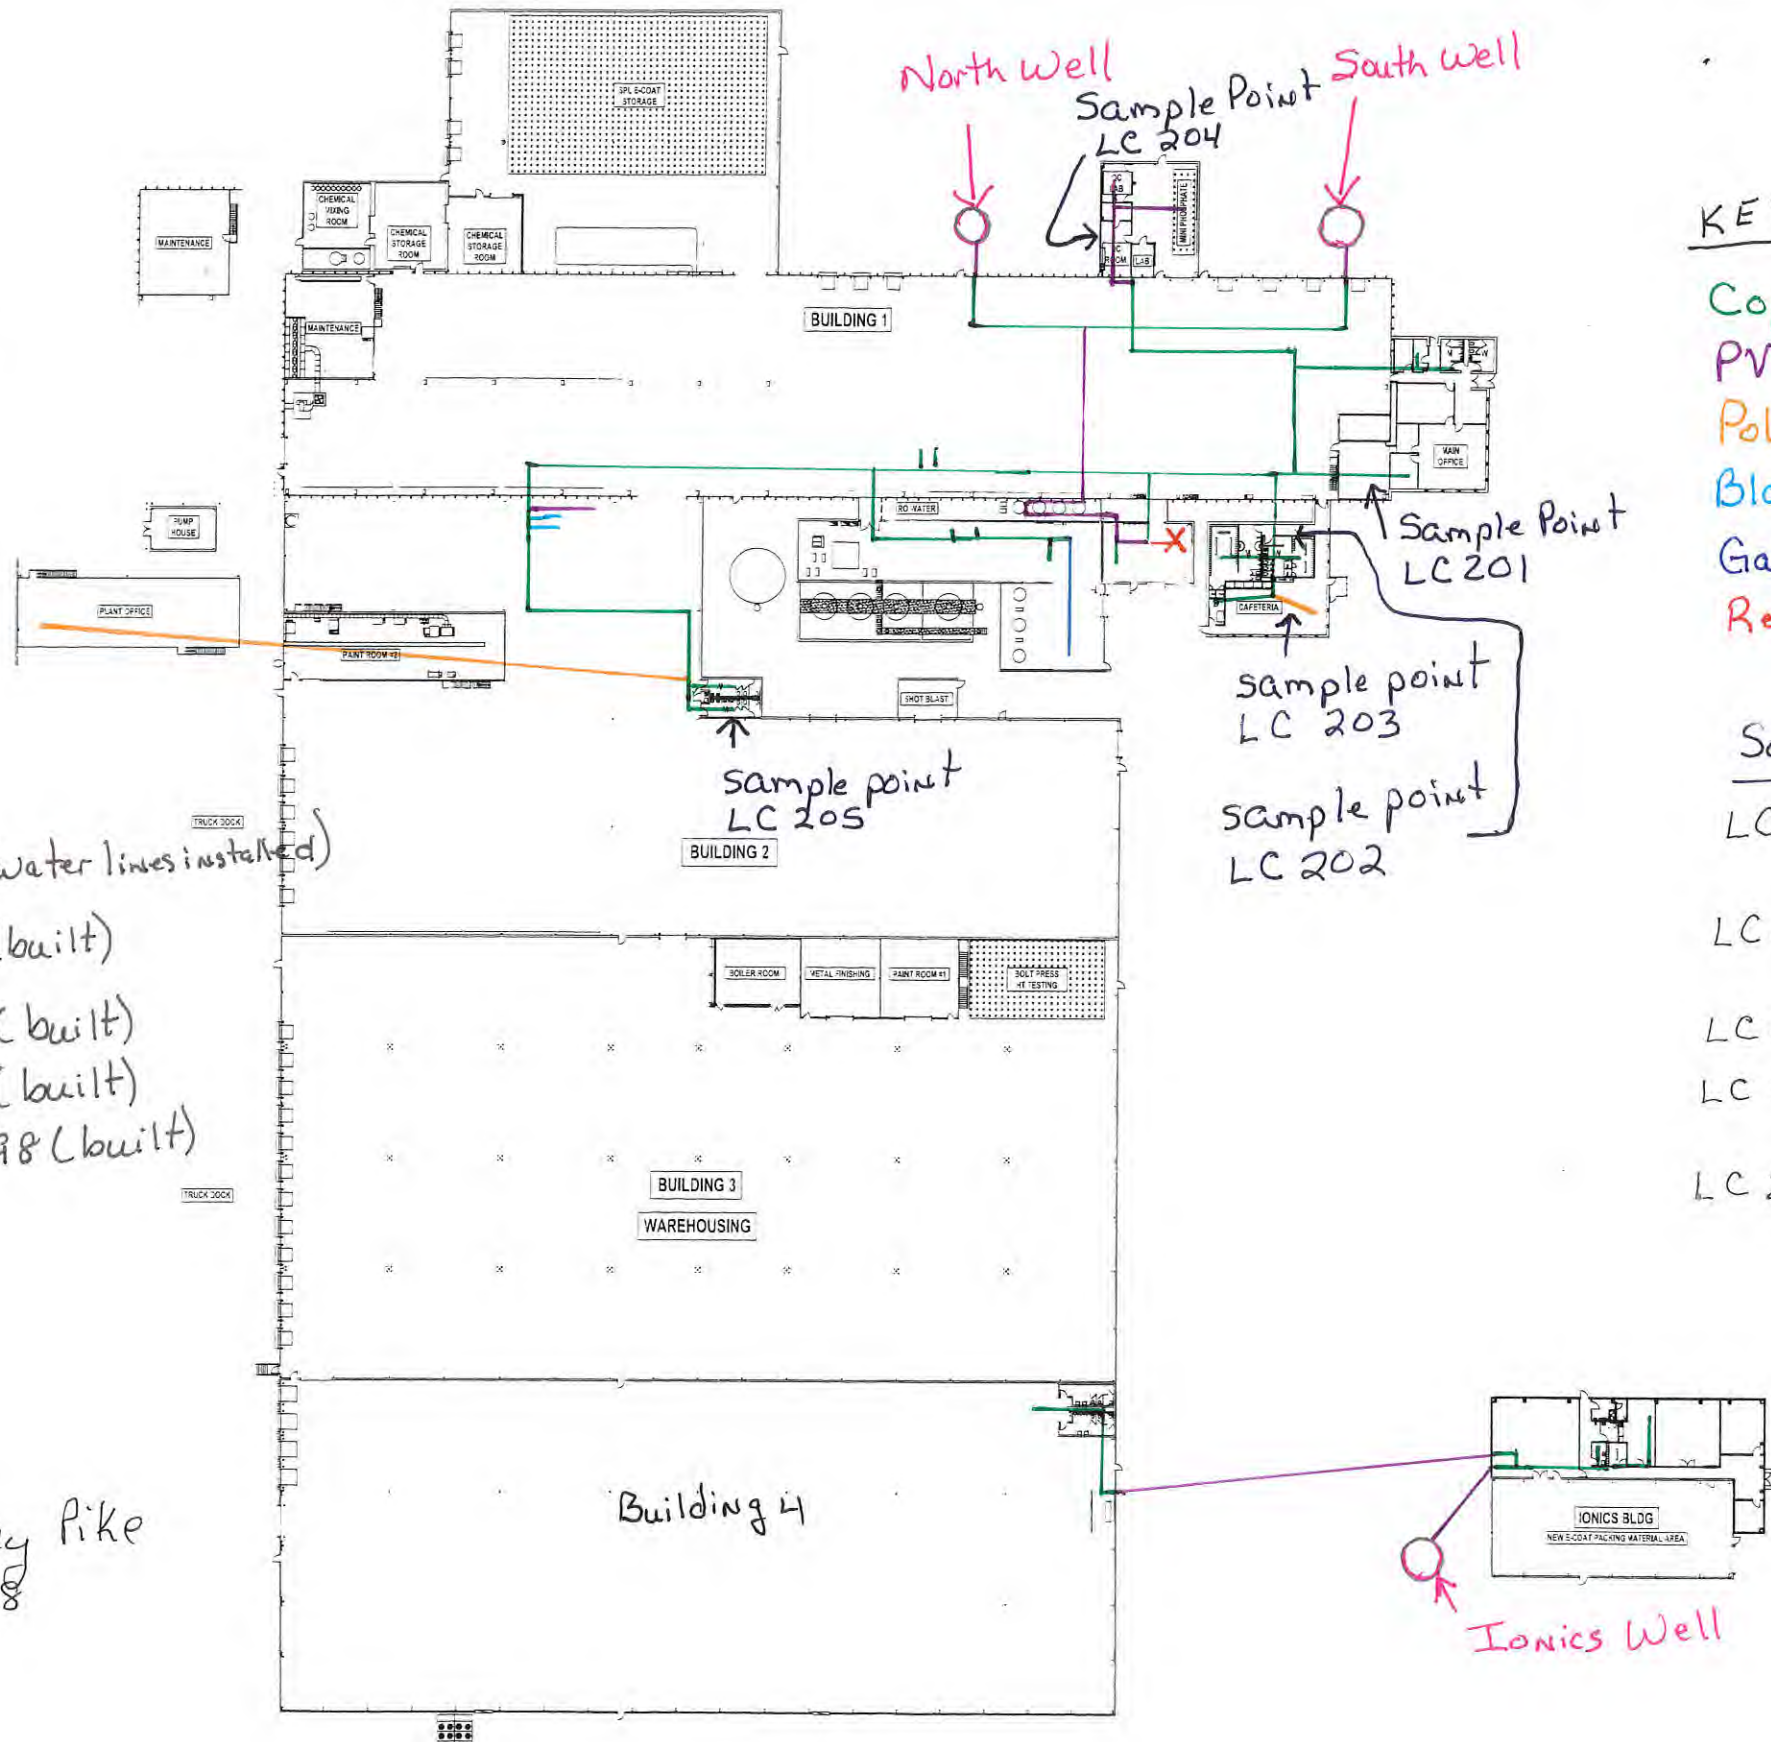

KEY:
Copper Line
PVC Line
Poly Tube Line
Black Iron Line
Galvanized Line
Red "X" to process water

Sample Points:
LC 201 - Conference Room
LC 202 - Water Fountain
LC 203 - Cafe Sink
LC 204 - QC Lab Sink
LC 205 - Men's RR Building II Sink

Buildings:
Building 1: 1987 (water lines installed)
Building 2: 1998 (built)
Building 3: 2004 (built)
Building 4: 2016 (built)
Ionics Building: 1998 (built)

Parker Trutec
4795 Upper Valley Pike
Urbana, OH 43078
2-28-17