

RE: OHIO CITY VILLAGE
Report
Drinking Water Program
Van Wert County
PWS ID: OH8100412

LINCOLNVIEW LOCAL SCHOOLS

Jeff Krugh
P.O. Box 248
Ohio City, Ohio
45874
Phone: 419-203-1183
E-mail:
ocutilities@onlyinternet.net

Re: Lead Mapping For The Village of
Ohio City

3/6/2017

To: Jill Schiefer (OEPA)

Here is Ohio City's Lead mapping.

Feel free to contact me about this matter at any time.

Sincerely,

Jeff Krugh
Village Administrator

RECEIVED
MAR 08 2017
OHIO E.P.A.
N.W.D.O.

VILLAGE OF OHIO CITY, OHIO
 WATER DISTRIBUTION MAP
 SE QUADRANT

MAP LEGEND

DISTRIBUTION LINES, VALVES


- 12" MAIN LINE, VALVE
- 10" MAIN LINE, VALVE
- 8" MAIN LINE, VALVE
- 6" MAIN LINE, VALVE
- 4" MAIN LINE, VALVE

TRANSMISSION LINES, VALVES

- 8" LINE, VALVE
- 4" LINE, VALVE

OTHER SYMBOLS

- HYDRANT
- VALVE

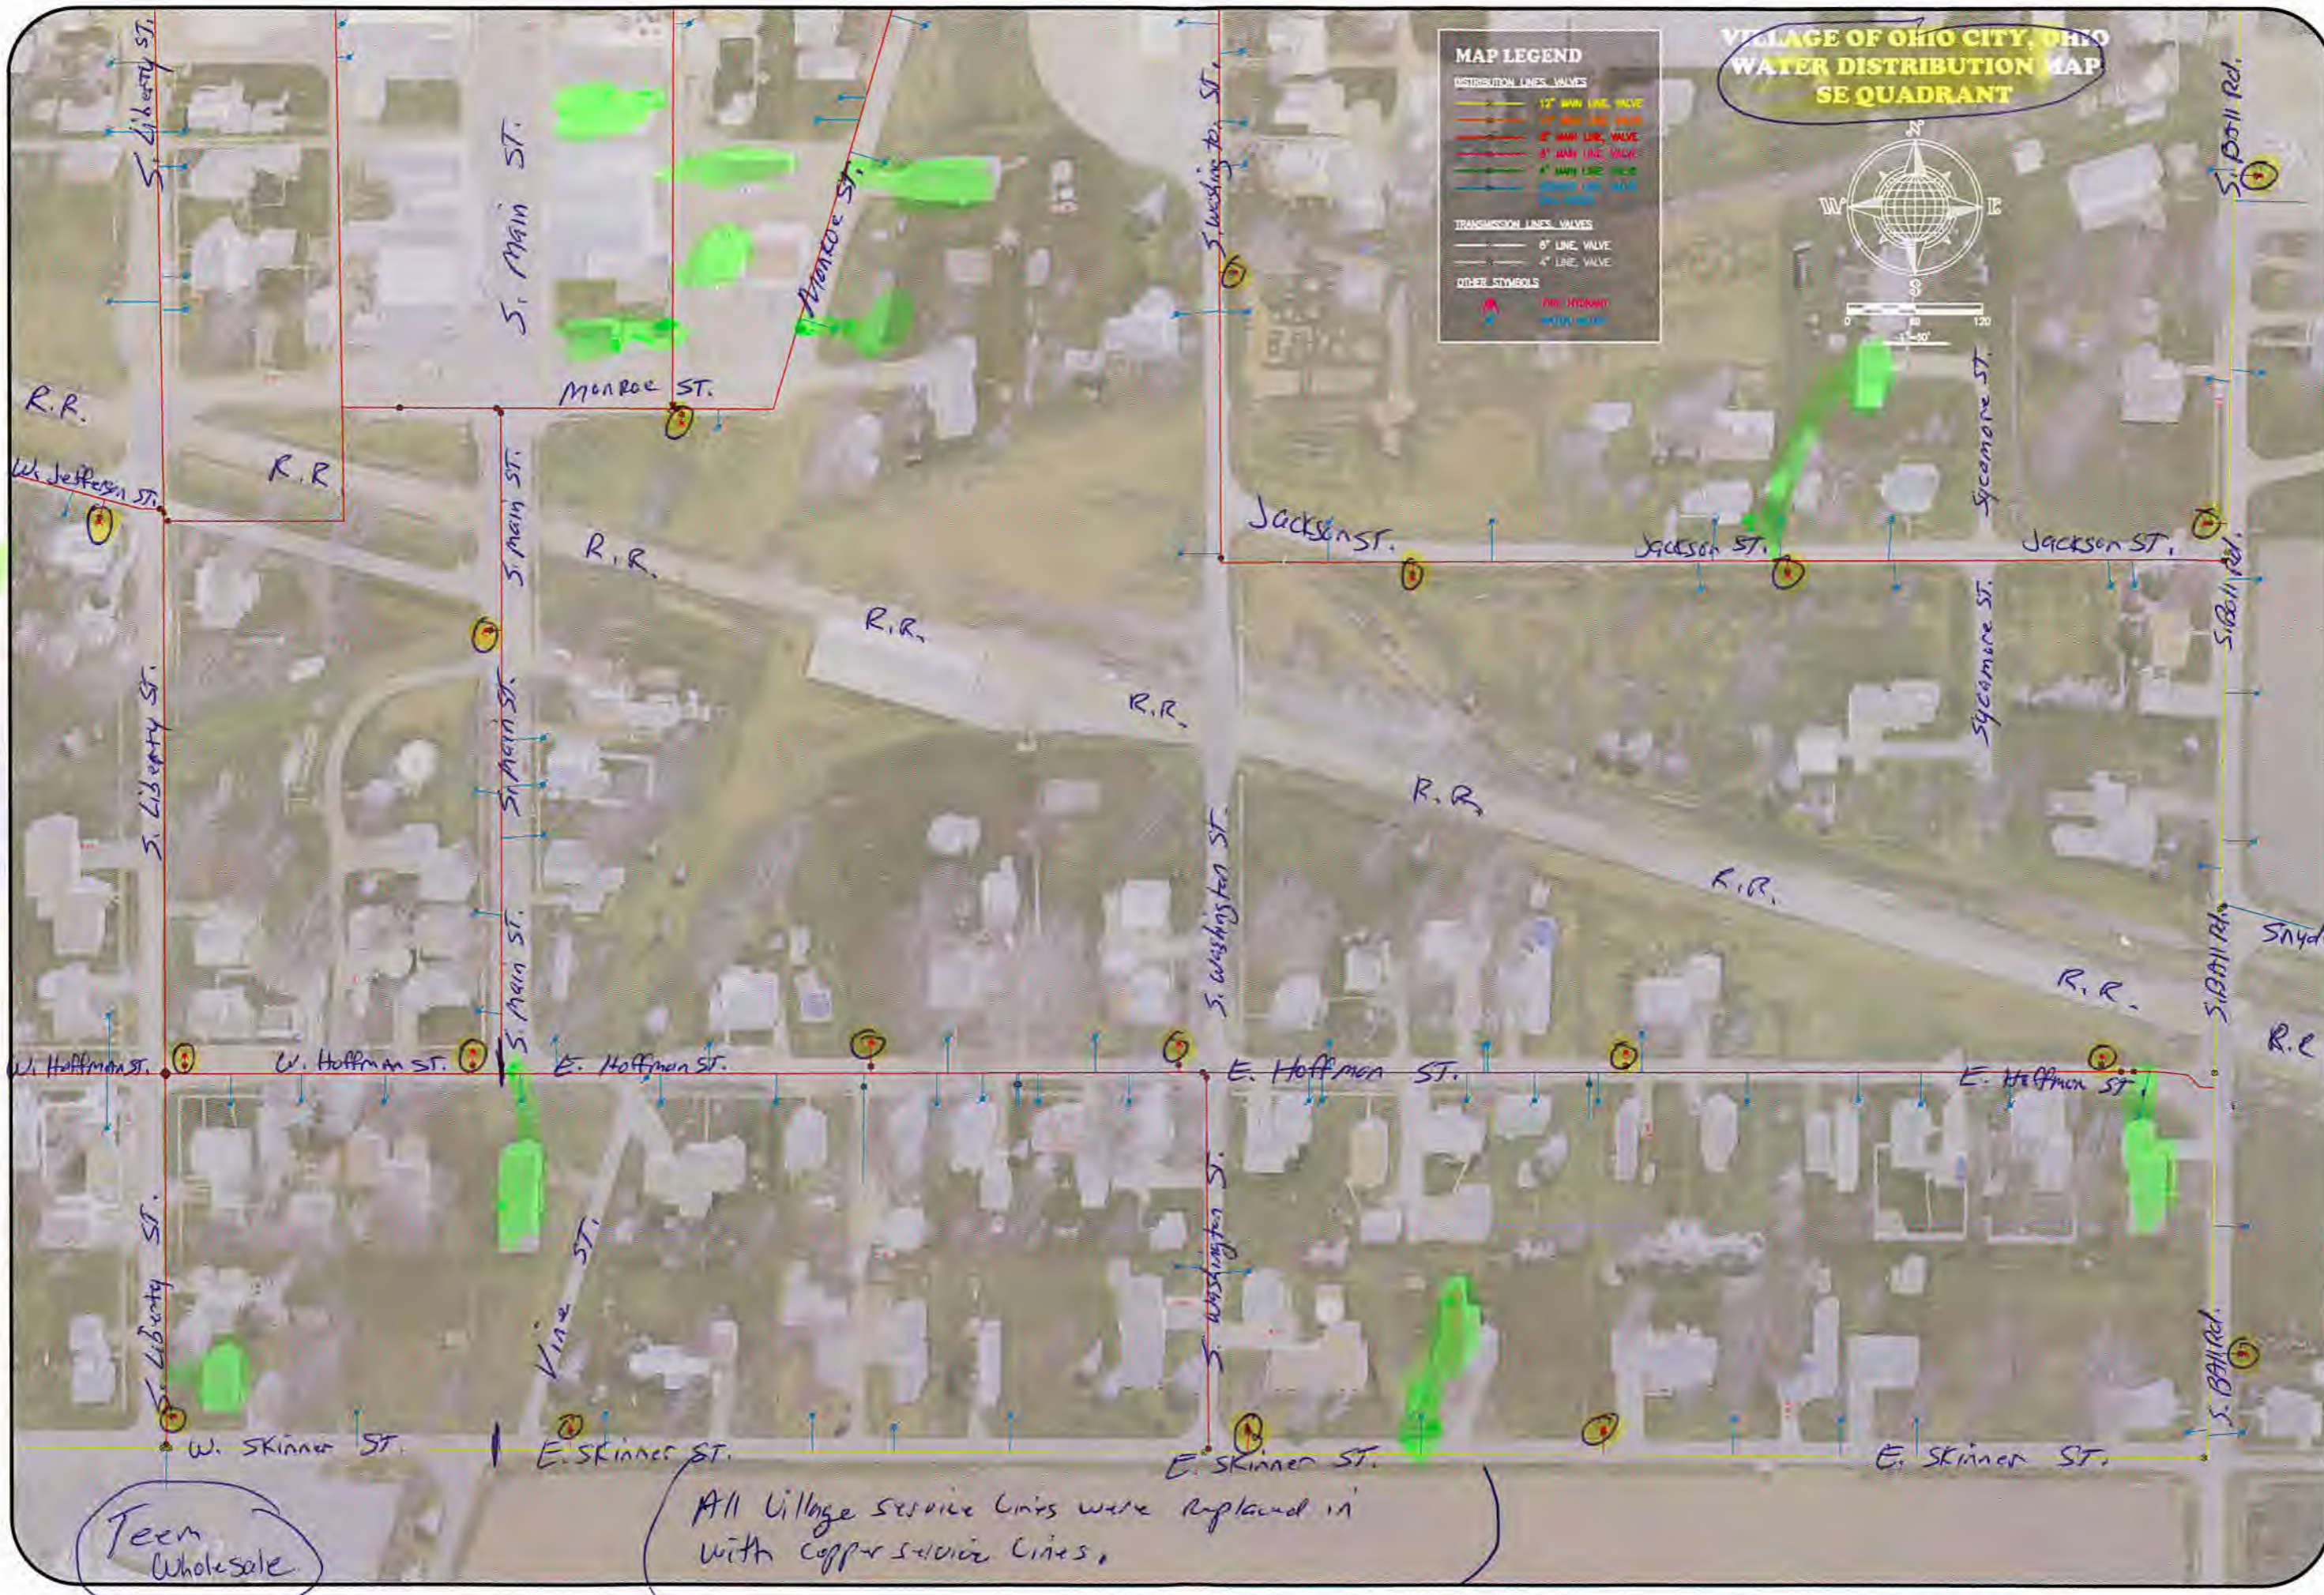

N
 ↑

N
 ↑

Eckhart
 Plastics
 EAST

↑
 Lead
 Pipe
 Service
 Lines
 &
 Plumbing
 &
 Built
 After
 1996

W
 W
 W
 T
 P

Snyder Rd

S
 ↓

Teen
 Wholesale

All Village service lines were replaced in
 with copper service lines.

VILLAGE OF OHIO CITY, OHIO
 WATER DISTRIBUTION MAP
 SW QUADRANT

MAP LEGEND

DISTRIBUTION LINES, VALVES

- 12" MAIN LINE, VALVE
- 10" MAIN LINE, VALVE
- 8" MAIN LINE, VALVE
- 6" MAIN LINE, VALVE
- 4" MAIN LINE, VALVE
- 3" MAIN LINE, VALVE
- 2" MAIN LINE, VALVE

TRANSMISSION LINES, VALVES

- 8" LINE, VALVE
- 4" LINE, VALVE

OTHER SYMBOLS

- FIRE HYDRANT
- WATER METER



All Village Service Lines were replaced with copper service lines in


Old School House

Lutheran church

Water Plant

Team Wholesale

Lead Free Service Lines & Plumbing Built After 1996

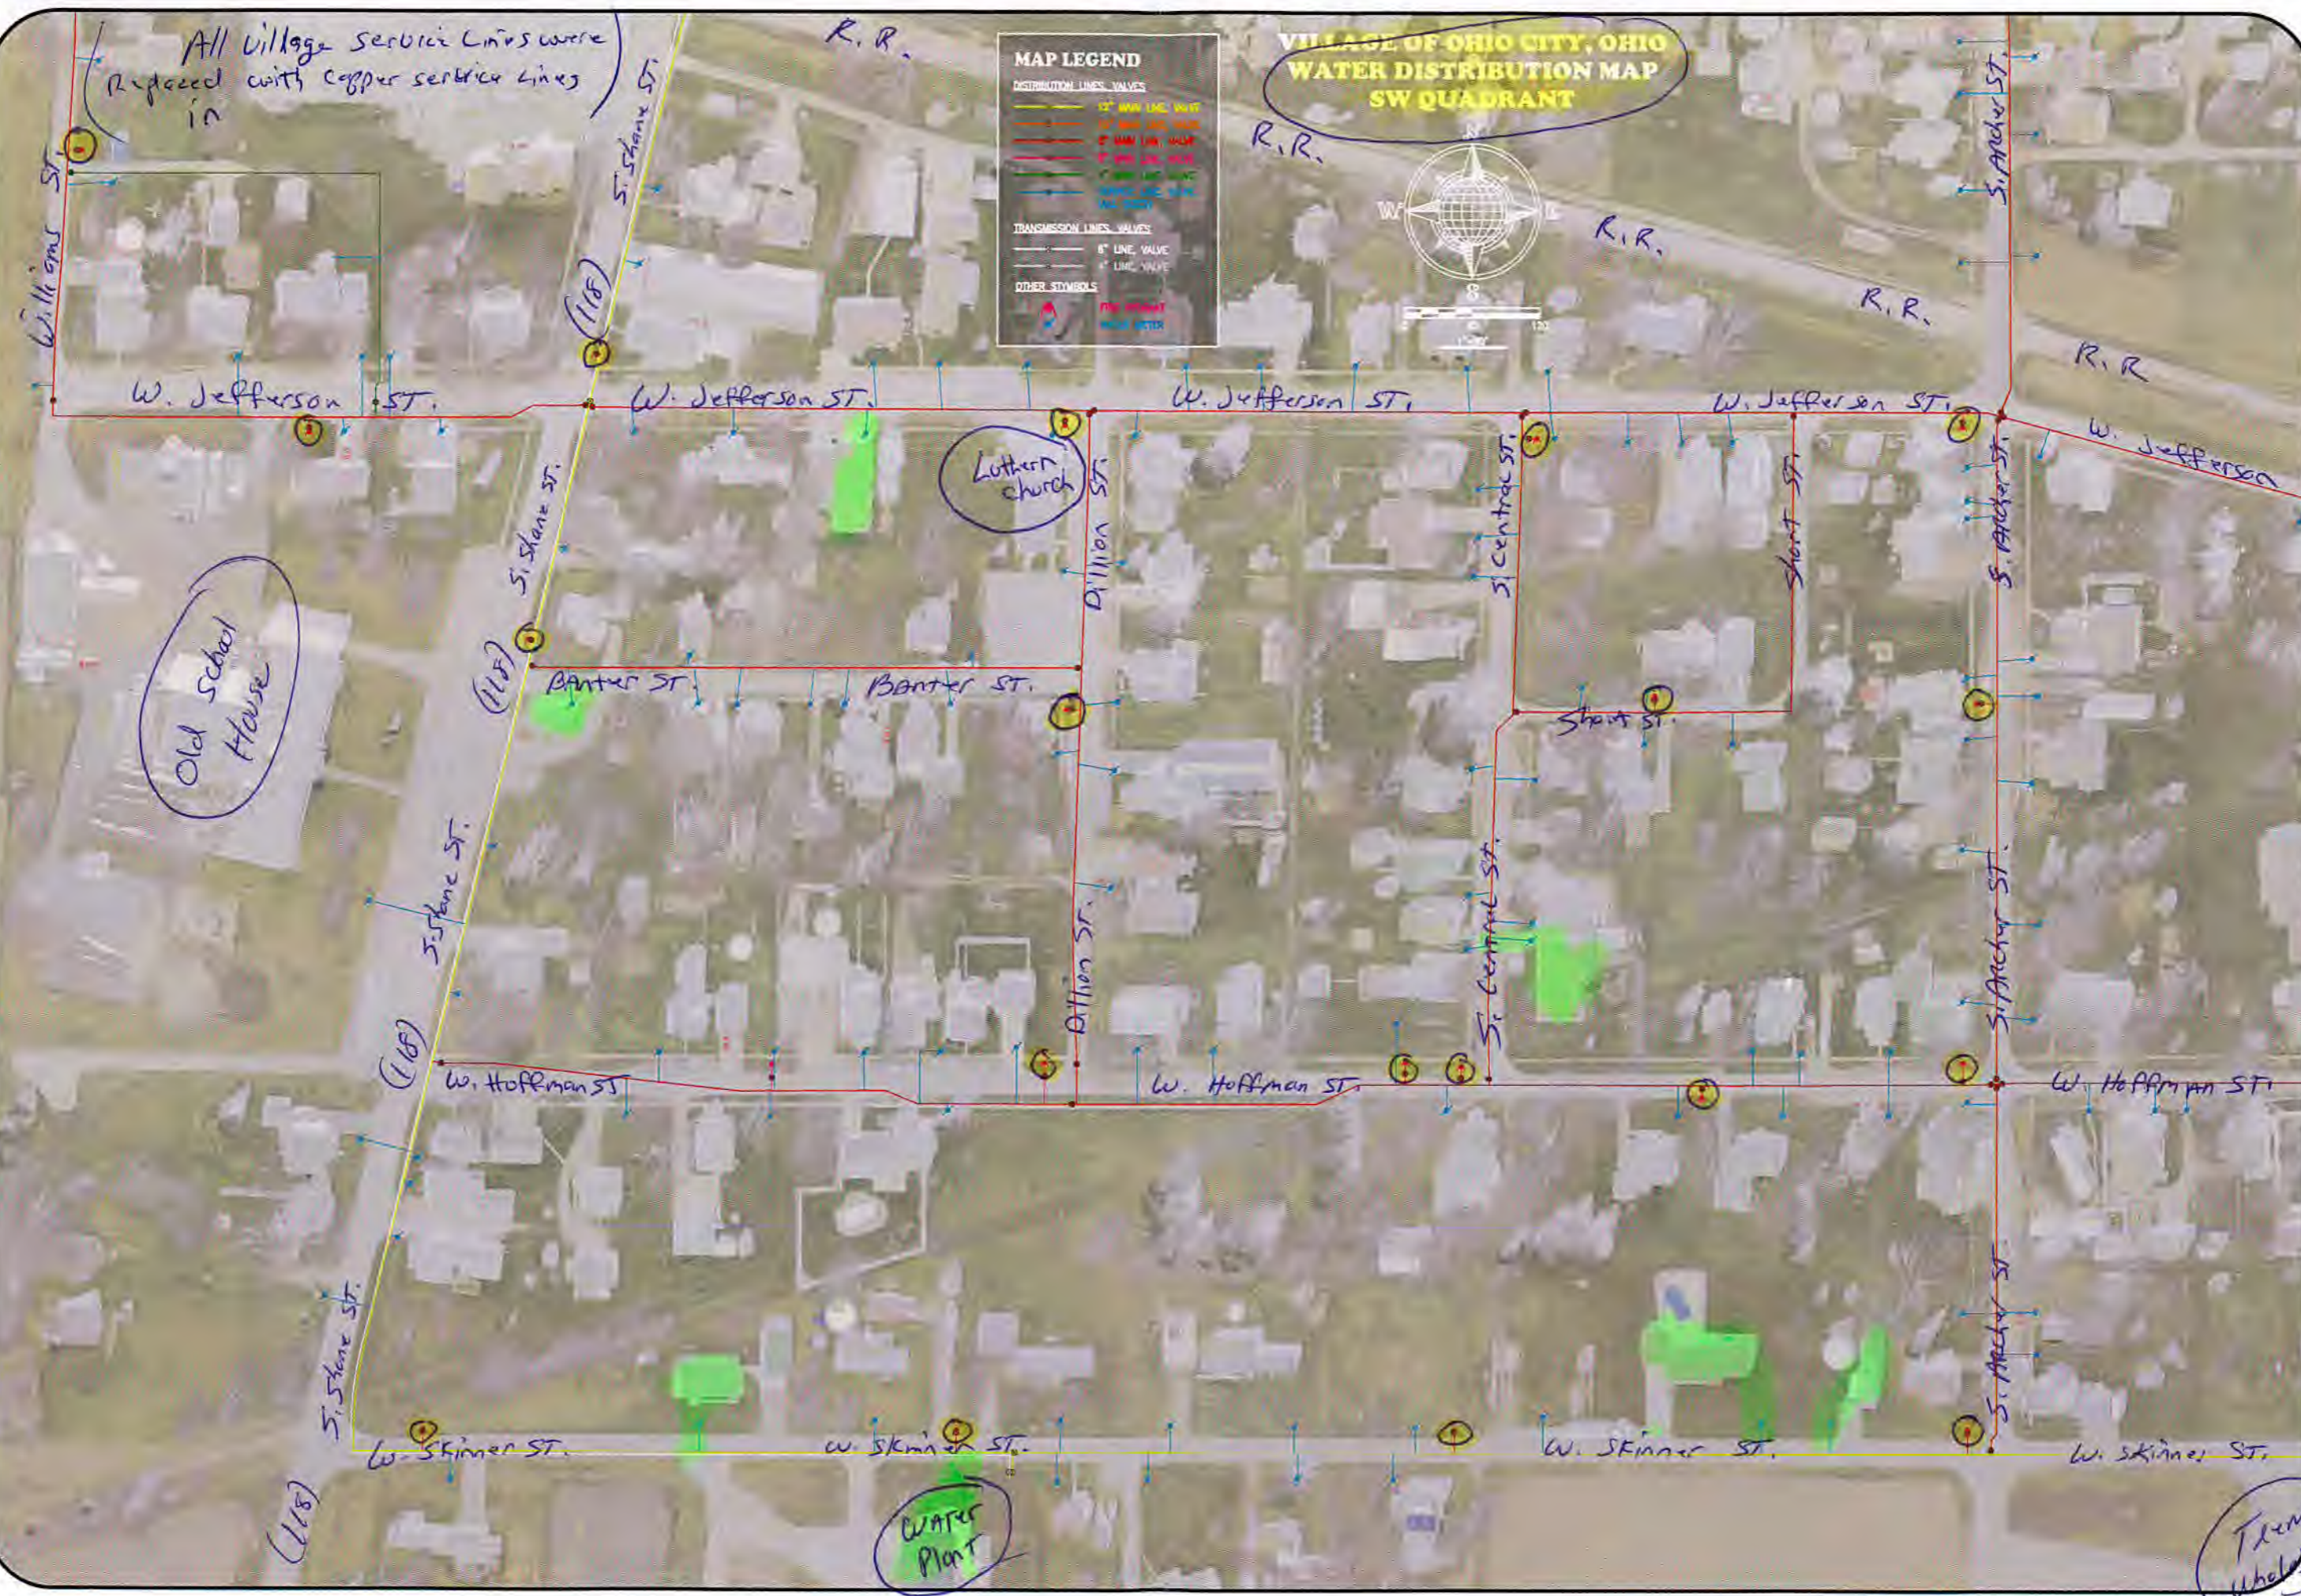

VILLAGE OF OHIO CITY, OHIO
WATER DISTRIBUTION MAP
NW QUADRANT

MAP LEGEND

DISTRIBUTION LINES, VALVES

- 12" MAIN LINE VALVE
- 10" MAIN LINE VALVE
- 8" MAIN LINE VALVE
- 6" MAIN LINE VALVE
- 4" MAIN LINE VALVE
- SERVICE LINE VALVE (1/2" - 2")

TRANSMISSION LINES, VALVES

- 6" LINE VALVE
- 4" LINE VALVE


OTHER SYMBOLS

- FIRE HYDRANT
- WATER METER



All Village Service Lines were Replaced in
with Copper service Lines.

(Heath DOT)

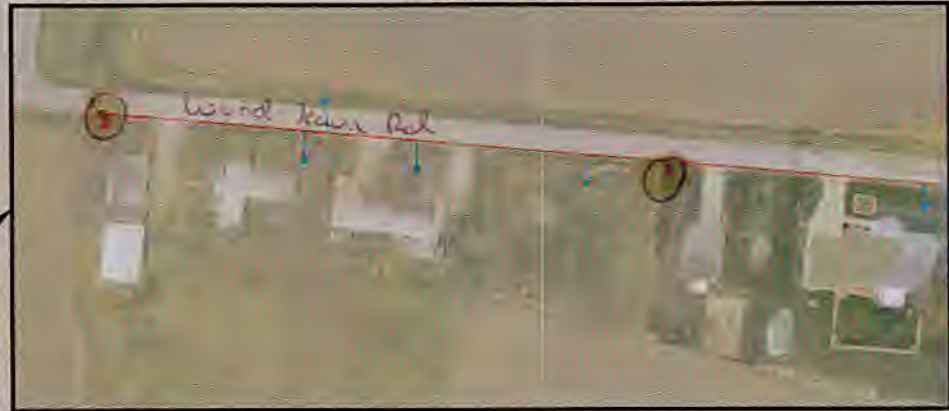

Cemetery

Lead Free Service Lines & Plumbing Built After 1996

RECEIVED
MAR 18 2017
OHIO E.P.A.
N.W.D.O.



S

S



VILLAGE OF OHIO CITY, OHIO
 WATER DISTRIBUTION MAP
 NE QUADRANT

MAP LEGEND

DISTRIBUTION LINES, VALVES

- 12" MAIN LINE, VALVE
- 10" MAIN LINE, VALVE
- 8" MAIN LINE, VALVE
- 6" MAIN LINE, VALVE
- 4" MAIN LINE, VALVE
- SERVICE LINE, VALVE (ALL SIZES)

TRANSMISSION LINES, VALVES

- 8" LINE, VALVE
- 4" LINE, VALVE

OTHER SYMBOLS

- THE HYDRANT
- WATER METER



(All Village Service Lines were Replaced in with copper service lines.)

↑
 Lead Free
 Service
 Lines
 &
 Plumbing
 &
 Built
 After
 1996

Trailer Park

