


RE: GREEN ACRES MHP
Report
Drinking Water Program
Ashland County
PWS ID: OH0300512

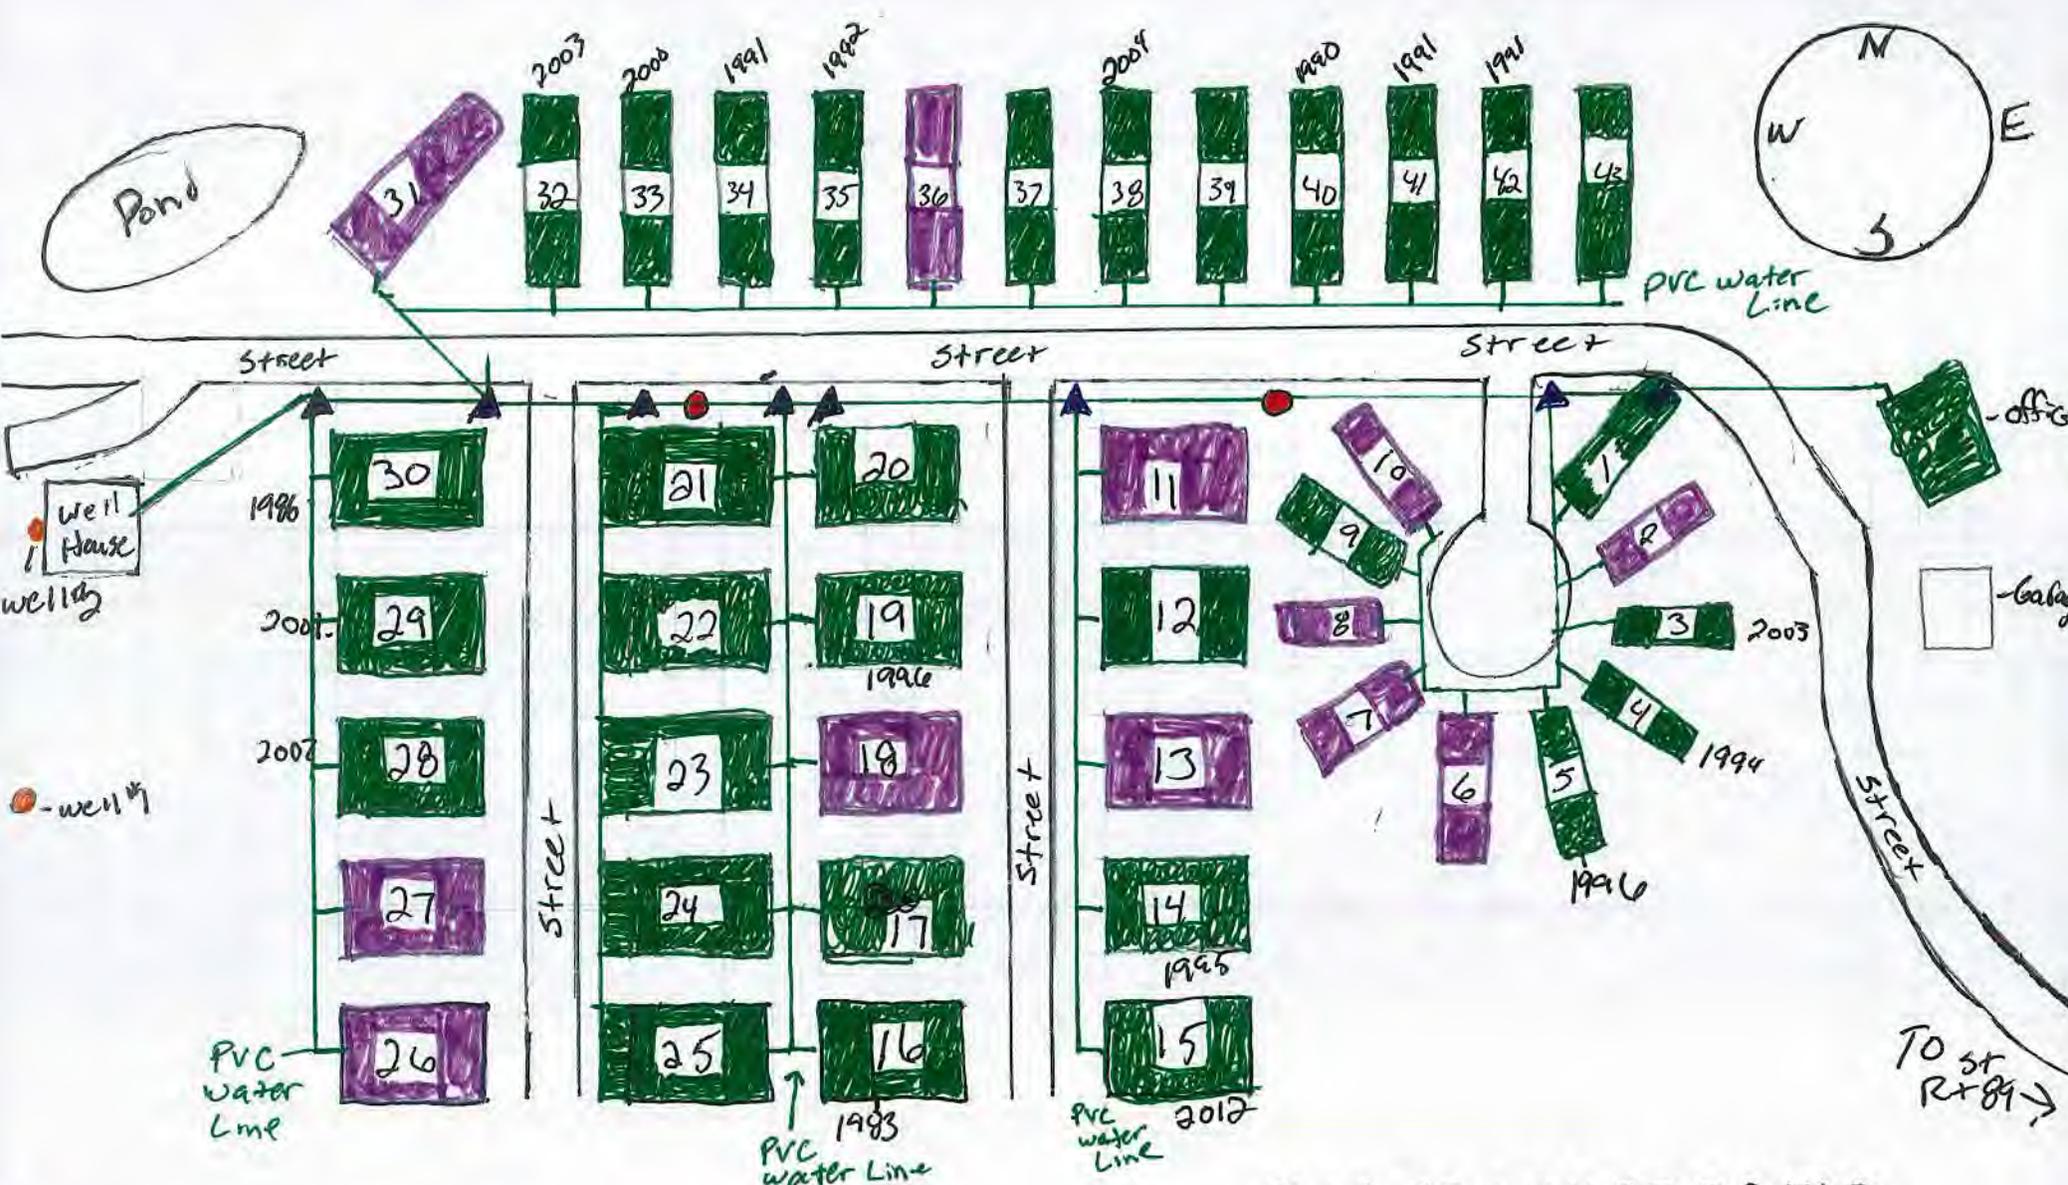

- Non Lead (PVC)
- Possible Lead
- Unknown
- Fire hydrant
- Shut offs

PWS ID: OH0300512
 Green Acres MHP
 1346 St. Rt 89
 Ashland, OH 44805



Green Acres Mobile Home Park

Google Earth

Google Earth

feet
meters

