



# Indian Lake Rehabilitation Center

February 22, 2017

RECEIVED  
OHIO EPA  
MAR 08 2017  
MAR 08 2017  
Southwest District  
District


Ohio EPA District  
Southwest District Office  
401 East Fifth Street  
Dayton, OH 45402

Attached please find the Mapping Lead Plumbing and Fixtures for Individual Buildings for the address of **Indian Lake Healthcare Group, LLC dba/Indian Lake Rehabilitation Center, located on 14442 State Route 33 West, Lakeview, OH 43331. (937)843-4929.**

**PSW ID = 4602612 STU # = 4655707**


The age of faucets and fixtures of manufacturing is unknown to our knowledge, as the age is an extended time past; it is likely to have Lead Solder.


We have included the color map as follows:


Lead = 


Hot Water = 

No Lead = 

Cold Water = 

No Information = 

Return = 

Water Entrance Point = 

Please contact the Director of Maintenance at (937)843-4929 if there are any questions or if further information is required.

Sincerely,



Robin Funk  
Director of Maintenance

\*Enclosure

RECEIVED  
OHIO EPA  
MAR 08 2017

Southwest District

### VERIFICATION FORM FOR COMMUNITY PUBLIC WATER SYSTEMS CLAIMING NO LEAD SERVICE LINES

The owner or operator of all community public water systems must identify and map areas of their distribution system that are known or are likely to contain lead service lines. Systems must submit a copy of the applicable map to the Ohio Department of Health and the Ohio Department of Job and Family Services. Systems must also submit a report to the director containing at least both of the following: (1) The applicable map with narrative, and (2) A list of sampling locations used to collect samples as required by Ohio Revised Code (ORC) Section 6109.121 and any rules adopted thereunder, including contact information for the owner and occupant of each sampling site.

Should a water system determine no lead service lines exist in their distribution system, they must provide information stating they reviewed, at the minimum, historical permit records and local ordinances, distribution maintenance records and information pertaining to installation dates or materials for all services lines. This information must be verified below.

I HEREBY CERTIFY THAT THE FOLLOWING METHOD(S) WERE USED TO DETERMINE NO LEAD SERVICE LINES EXIST IN THIS WATER SYSTEM'S DISTRIBUTION SYSTEM, AS REQUIRED BY ORC 6109.121(F):

LEAD SERVICE LINE VERIFICATION	
<p><b>This PWS states they have no lead service lines and has reviewed the following information (select one or more of the following):</b></p> <ul style="list-style-type: none"> <li><input type="checkbox"/> Historical permit records and/or local ordinances</li> <li><input type="checkbox"/> Distribution maintenance records (i.e. meter replacement, waterline break repairs)</li> <li><input type="checkbox"/> Information pertaining to installation dates for all service lines (i.e. after 1986 when lead services lines were banned)</li> <li><input checked="" type="checkbox"/> Service line material of all service lines is known (i.e. all service lines are known to be PVC)</li> </ul>	

Debra Sawyer      2-27-17  
 Signature of Responsible Person      Date

Debra Sawyer Administrator  
 Printed Name and Title of Responsible Person

PWS NAME: INDIAN LAKE Rehab.  
 PWS ID: OH 4602612  
 COUNTY: LOGAN

<p><b>For Ohio EPA use only:</b></p> <p>Date Verification Rec'd: _____</p>
--

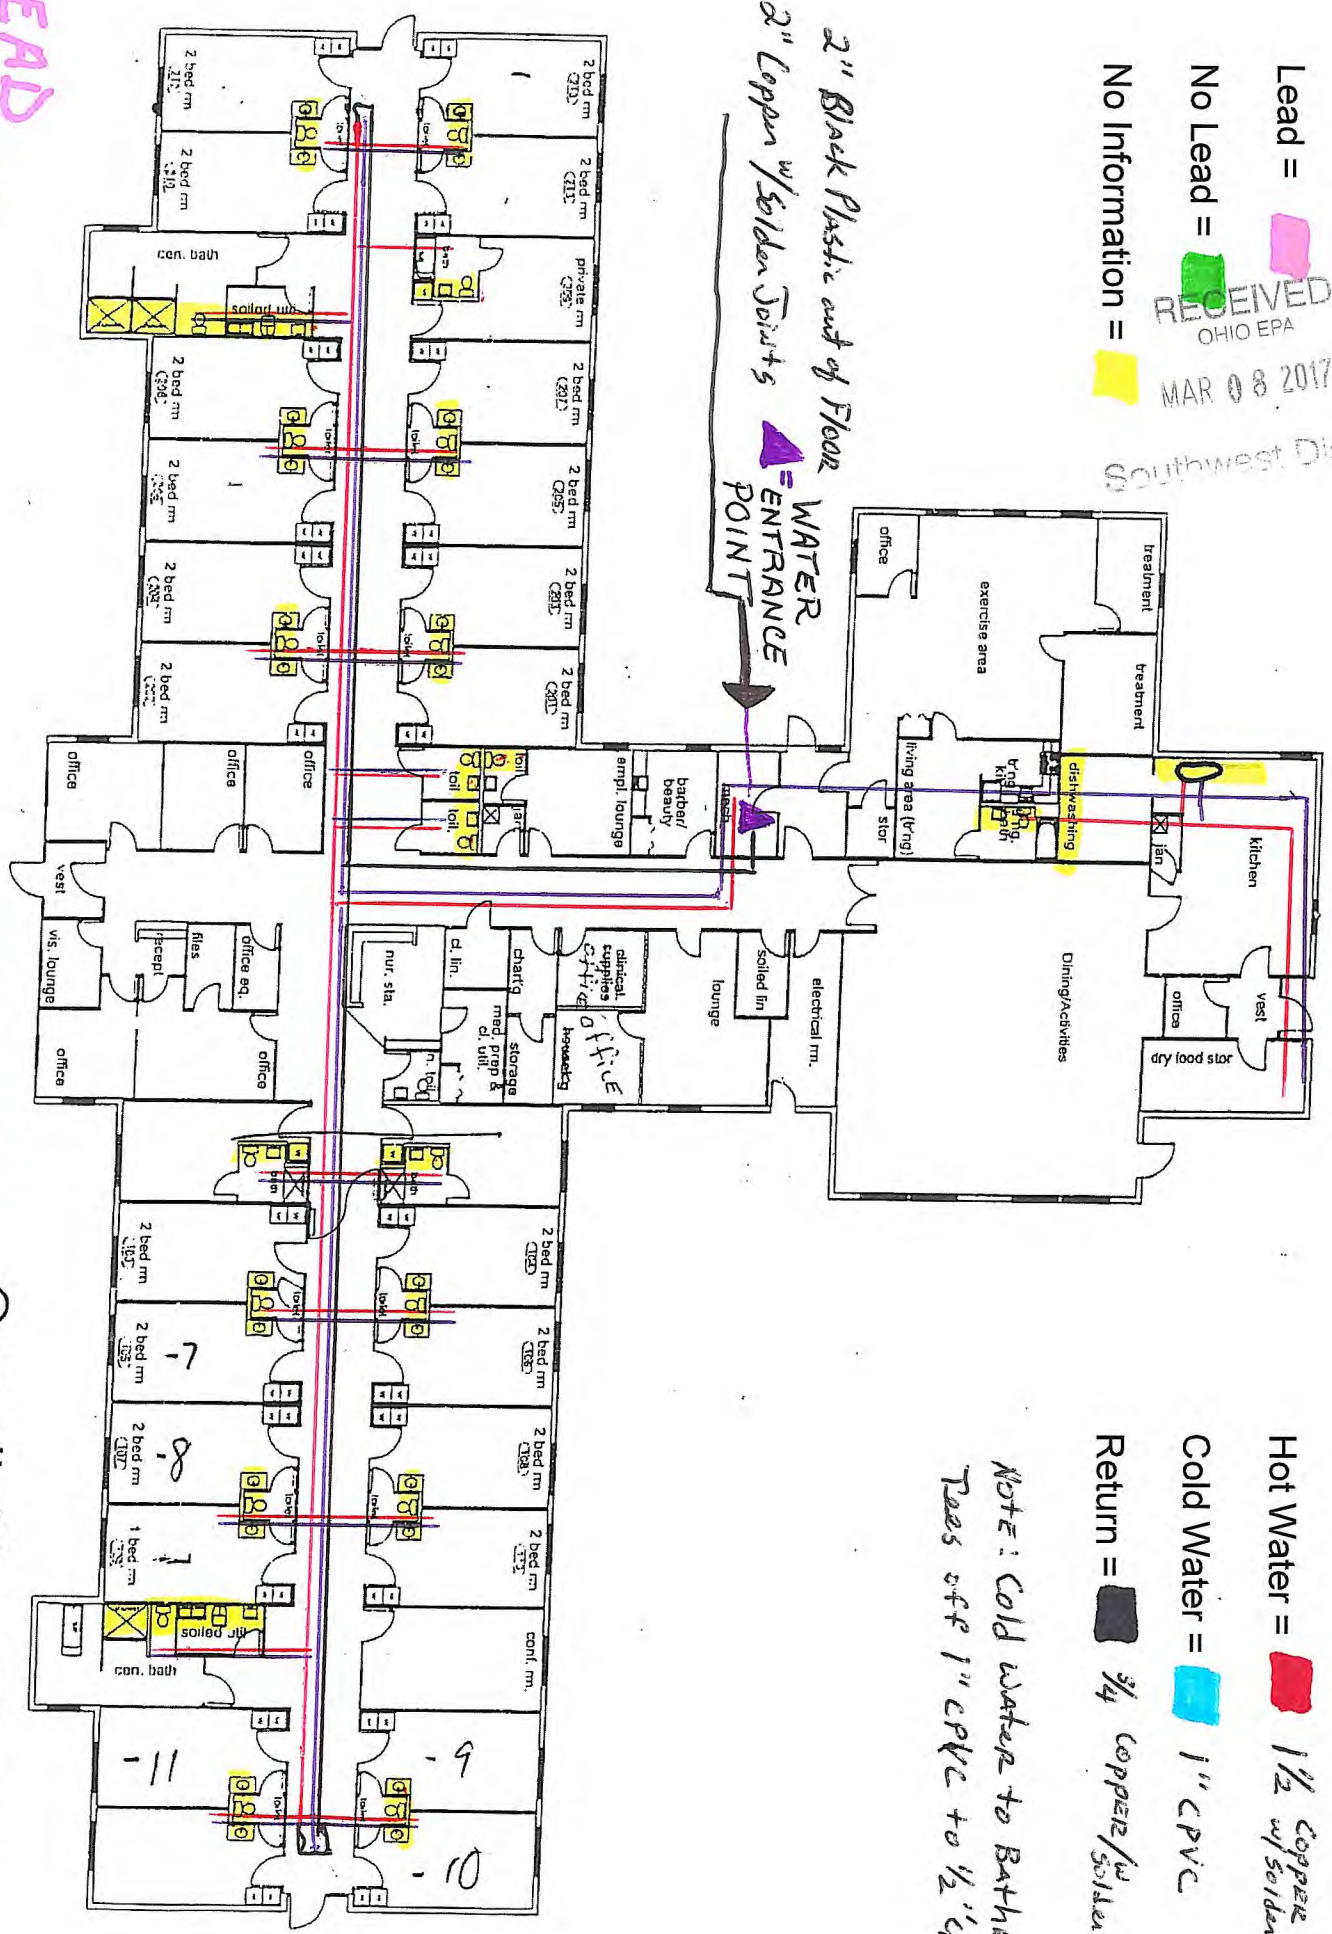
RECEIVED  
OHIO EPA




MAR 08 2017

Southwest District

Lead =   
No Lead =   
No Information = 

2" Black Plastic out of Floor  
to 2" Copper w/Solder Joints  
WATER  
ENTRANCE  
POINT



Hot Water =  1/2" Copper w/Solder Joints  
Cold Water =  1" CPVC  
Return =  3/4" Copper w/Solder Joints

NOTE: Cold Water to Bathrooms  
Runs off 1" CPVC to 1/2" CPVC

LEAD  
NO LEAD  
NO INFORMATION

HOT WATER  
COLD WATER  
RETURN WATER

Overall Floor Plan

