

RECEIVED
OHIO EPA

MAR 08 2017

Southwest District

COTTONWOOD ENTERPRISES
MOBILE HOME PARK
8312 ST. RT. 366
RUSSELLS POINT, OHIO 43348
419-236-2790

3-5-2017

PWS# OH4634612

LEAD SERVICE LINE;
Mapping Statement

Cottonwood Enterprises mobile home park has NO LEAD SERVICE LINES!


This information is based on the following parameters:


1. It is known, that the entire water distribution system is galvanized piping including the water mains and service lines to the valve for the trailer shut-off.
2. All excavations that have been performed since the park was developed have un-covered only the above mentioned galvanized materials. There is absolutely no evidence that any lead service lines exist.

Contained within the shaded area of green and yellow striping are components that are likely to have lead content.

Buildings in Ohio built prior to 1998 or that use plumbing material or solder manufactured before 1998 may have materials with greater than 8% lead and are at a higher risk of contributing lead to the drinking water than materials manufactured after 1998. In addition, buildings built and plumbing materials after 2014 were required to have less than 0.25% lead by weight and have the lowest risk for contributing lead to the drinking water. It should be noted however that, although prohibited, some use of leaded solder or leaded components may have occurred after the prohibitions became effective.

Dale Albert
Cottonwood Enterprises
Water Technical Representative

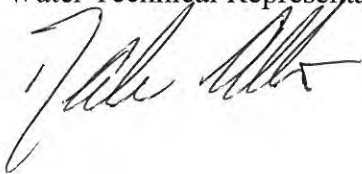


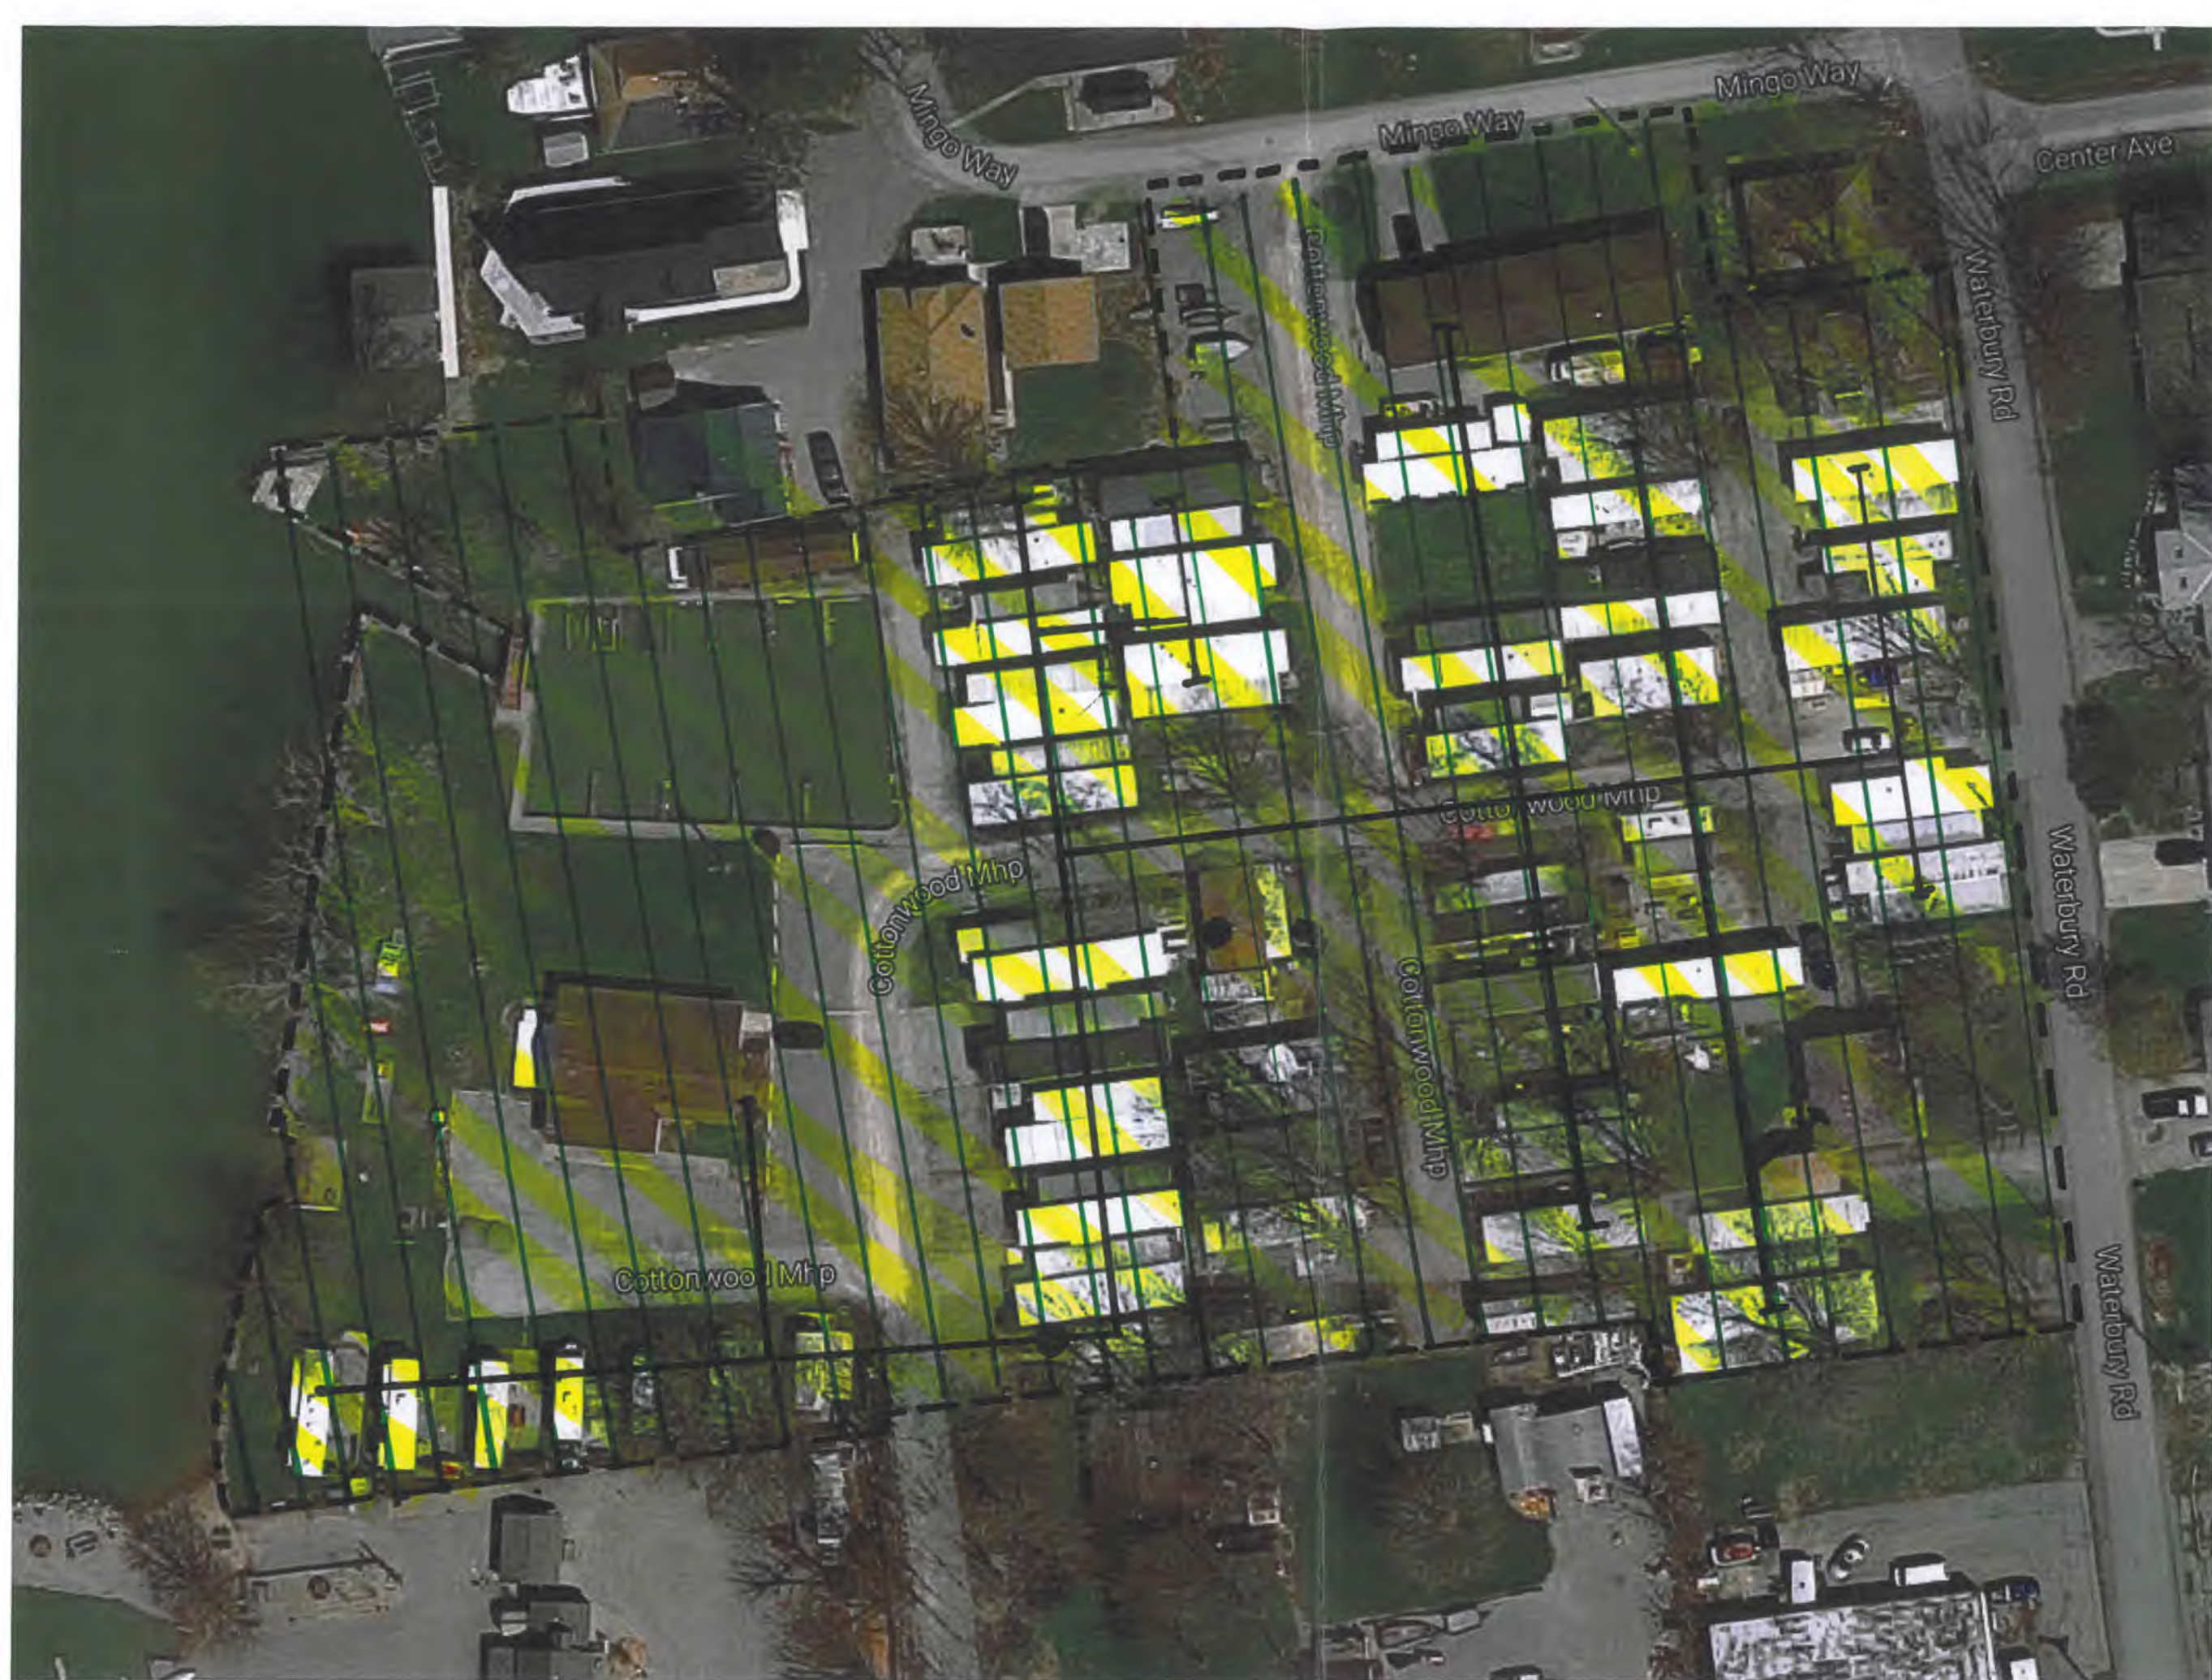

RECEIVED
OHIO EPA
MAR 08 2017
Southwest District

PROPERTY LINE
- - - - -
WATER MAINS - ALL 2"
—————

LEGEND:
Non-LEAD WITH POSSIBLE
LEAD COMPONENTS

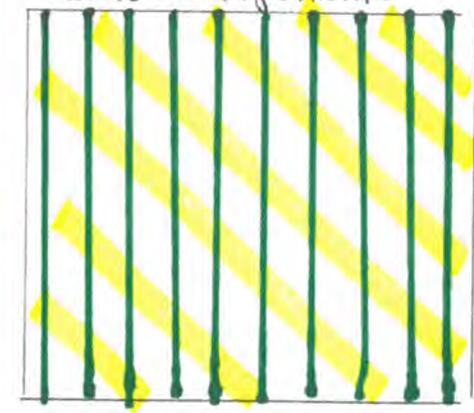

PWS# OH4634612