


Lead Service Line and Fixture Map
for TRC Water Well System

Date of Drawing: 2-10-2017
File Name: TRC PbCu.dwg
Generated by: TRC FAC

NOTES
Ohio House Bill 512 Drawing

PWS ID: OH4644012
PWS Name: Transportation Research Center Inc.

Address: 10820 State Route 347
East Liberty, Ohio 43319
Phone: (937) 666-2011

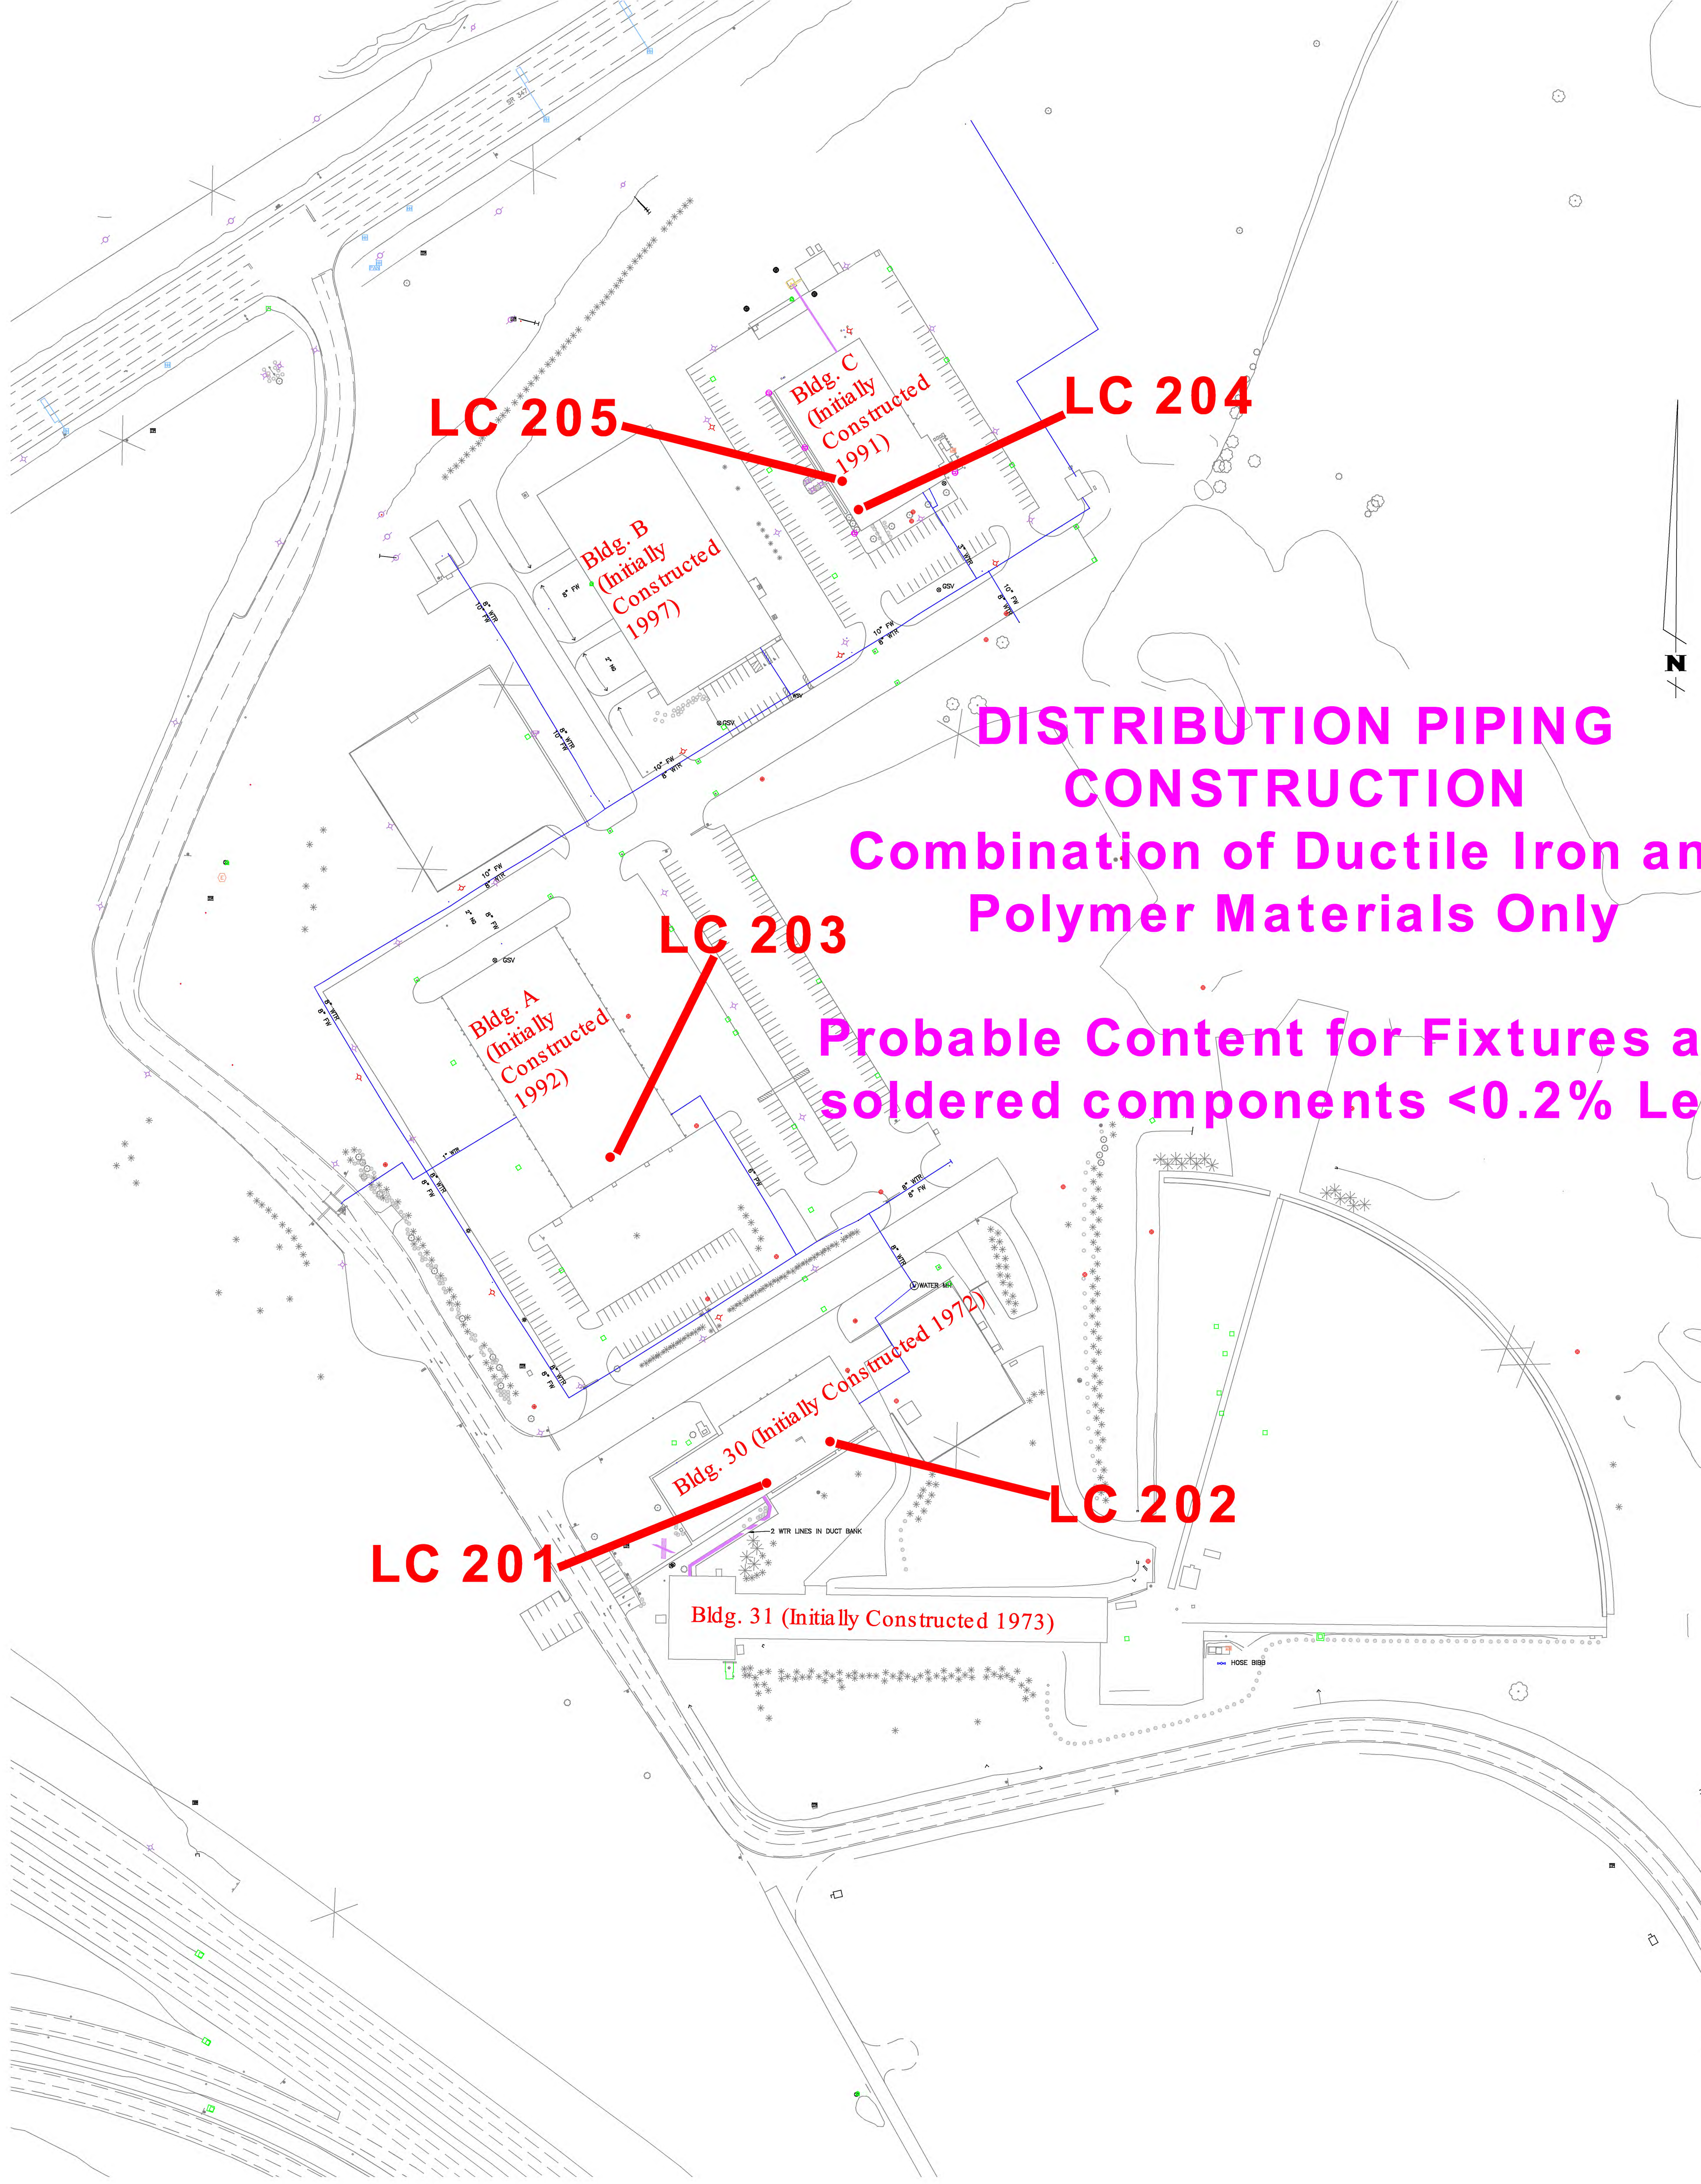

**DISTRIBUTION PIPING
CONSTRUCTION**
Combination of Ductile Iron and
Polymer Materials Only

**Probable Content for Fixtures and
soldered components <0.2% Lead**



Spreadsheet for lead and copper sample sites

* = Required field							
PWS ID*	PWS Name*	SMP ID*	Tap Location*	Plumbing Age*	Type of Interior Plumbing	Service Line Material*	Structure Type*
OH4644012	Transportation Research Center	LC201	Bldg 30 Men RR	CuPb<83	Copper	Other	BLDG
OH4644012	Transportation Research Center	LC202	Bldg 30 Wkrm 5	CuPb<83	Copper	Other	BLDG
OH4644012	Transportation Research Center	LC203	Bldg A Men RR	CuPb>82	Copper	Other	BLDG
OH4644012	Transportation Research Center	LC204	Bldg C Men RR	CuPb>82	Copper	Other	BLDG
OH4644012	Transportation Research Center	LC205	Bldg C Kitchen	CuPb>82	Copper	Other	BLDG