



North
↑

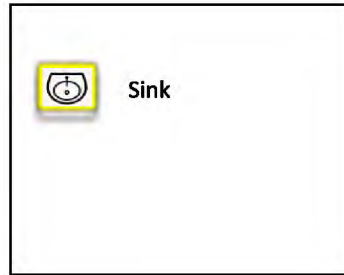

Lead/Copper Map Narrative NEX Transport Inc.

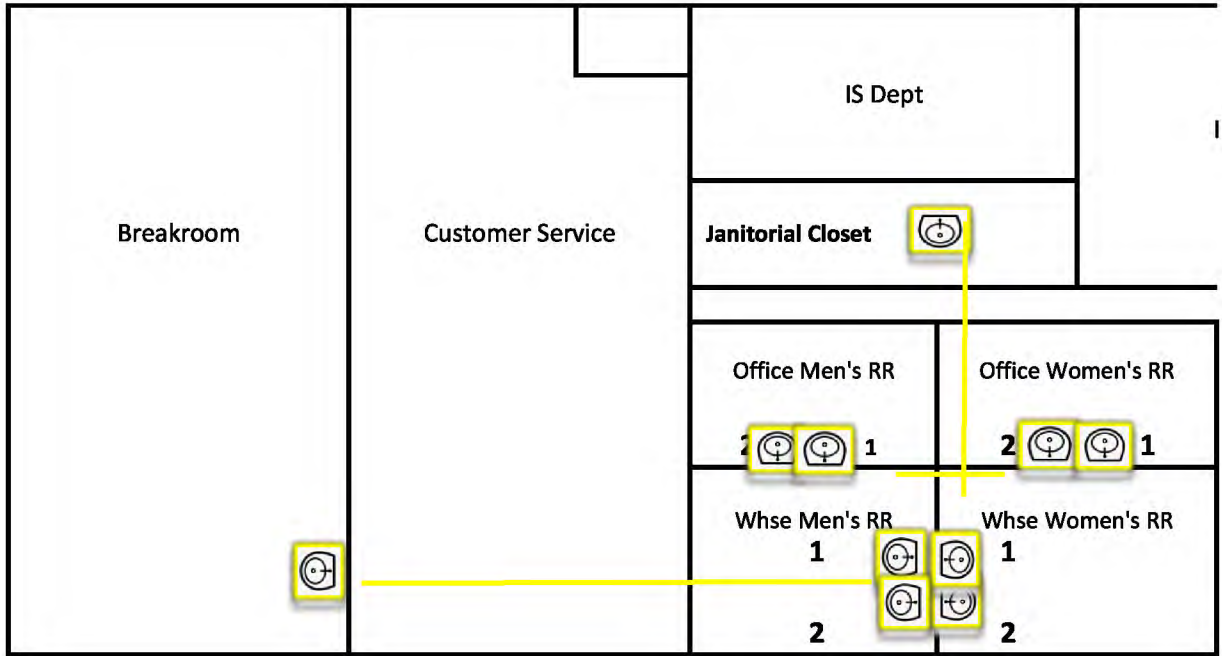

COUNTY ENGINEER'S

LOGAN COUNTY, OHIO

REAL PROPERTY MAP

AERIAL PHOTOGRAPHY	REAL PROPERTY MAP	REAL PROPERTY MAP	MAPPING LEGEND				MAP DATE & SCALE	ADJOINING MAPS	MODULE MAP NUMBERS
<p>PREPARED BY DIGITAL ORTHOPHOTOGRAPHY BARTON AERIAL TECHNOLOGIES, INC. 6530 SINGLETREE DR. COLUMBUS, OH 43229</p>	<p>PREPARED FOR COUNTY COMMISSIONERS LOGAN COUNTY, OHIO LOGAN COUNTY COURTHOUSE BELLEFONTAINE, OHIO 43311</p>	<p>DIGITAL CONVERSION BY THE SANBORN MAP COMPANY INC. 829 FIFTH AVENUE PETALUMA, CA 94952 (415) 930-3285</p>	<p>STATE OR COUNTY LINE CITY LINE TOWNSHIP LINE SECTION LINE SURVEY LINE HIGHWAY & STREET R.O.W.</p>	<p>PROPERTY LINE LAND HOOK WATER SPECIAL DISTRICT LINE PARCEL NUMBER</p>	<p>BLOCK NUMBER ORIGINAL SUBDIVISION BLOCK NO. ORIGINAL SUBDIVISION LOT NO. SECTION NUMBER VIRGINIA MILITARY SURVEY</p>	<p>UNITED STATES HIGHWAY OHIO STATE ROUTE COUNTY ROUTE STREET NAME TOWN ROUTE</p>	<p>DATE OF MAPS: 9-1-82 DATE OF REVISION: 05 12 98 DATE OF PHOTOGRAPHY: 2005 SCALE: 1"=400'</p>	<p>ADJOINING MAP NO'S N E S</p>	<p>141-00 TAX PAYER'S IDENTIFICATION NUMBER E1,700,000 X N220,000 -170,22-00 OHIO STATE PLANE GRID-COORDINATE MAP NUMBER</p>


Building 1 - North Well ID#4644112

3/10/2017

Expansion of South Well

Building 1 - North Well ID#4644112

3/10/2017

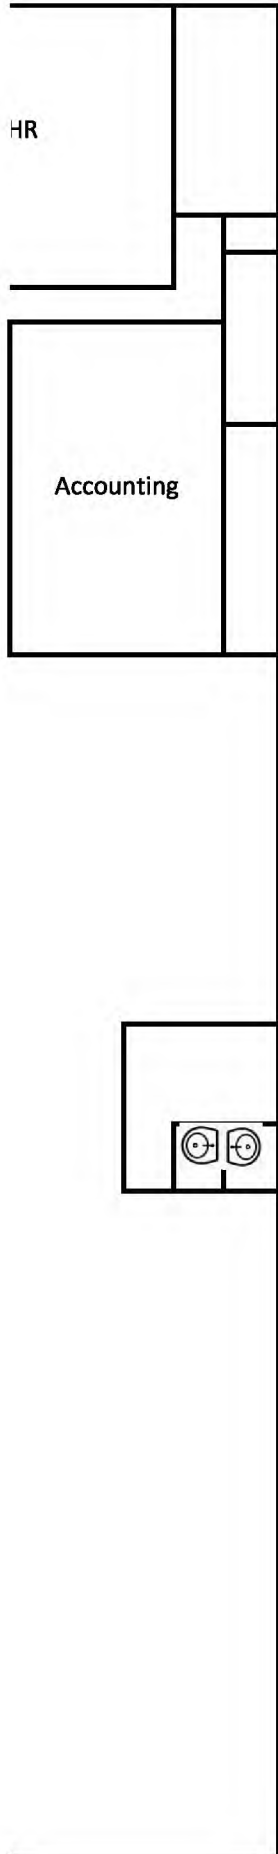

Nex Transport Building #1 North PWS OH4644112
13900 State Route 287, East Liberty, OH 43319
Phone: (937) 642-8333
Building #1 North Built 1989 renovated 1991
Well line to building is plastic
Interior Plumbing is Mostly Copper

- a. Yellow = pre 98
- b. Green = 98-'14
- c. Light blue = 2014 or newer

Because it is practically impossible to determine the lead content of an installed fixture, fitting or pipe, it should be assumed that the manufacture or installation date is the primary indicator of the lead content. Therefore, the characteristics of buildings and piping solder or fixtures would be buildings built prior to 1998 or that use plumbing material or solder manufactured before 1998 may have materials with greater than 8% lead and are at a higher risk of contributing lead to the drinking water than materials manufactured after 1998. In addition, buildings built and plumbing materials manufactured after 2014 were required to have less than 0.25% lead by weight and have the lowest risk for contributing lead to the drinking water. It should be noted however that, although prohibited, some use of leaded solder or leaded components may have occurred after the prohibitions became effective.

Auditor Link

http://realestate.co.logan.oh.us/Parcel/Default/Summary?Property_ID=33864&TaxYear=2016

SMP ID*	Tap Location*
LC201	Womens RR Right Sink
LC202	Mens RR Left Sink
LC203	Front Break Room Sink
LC204	Womens RR Left Sink
LC205	Weld Operators Office