2F

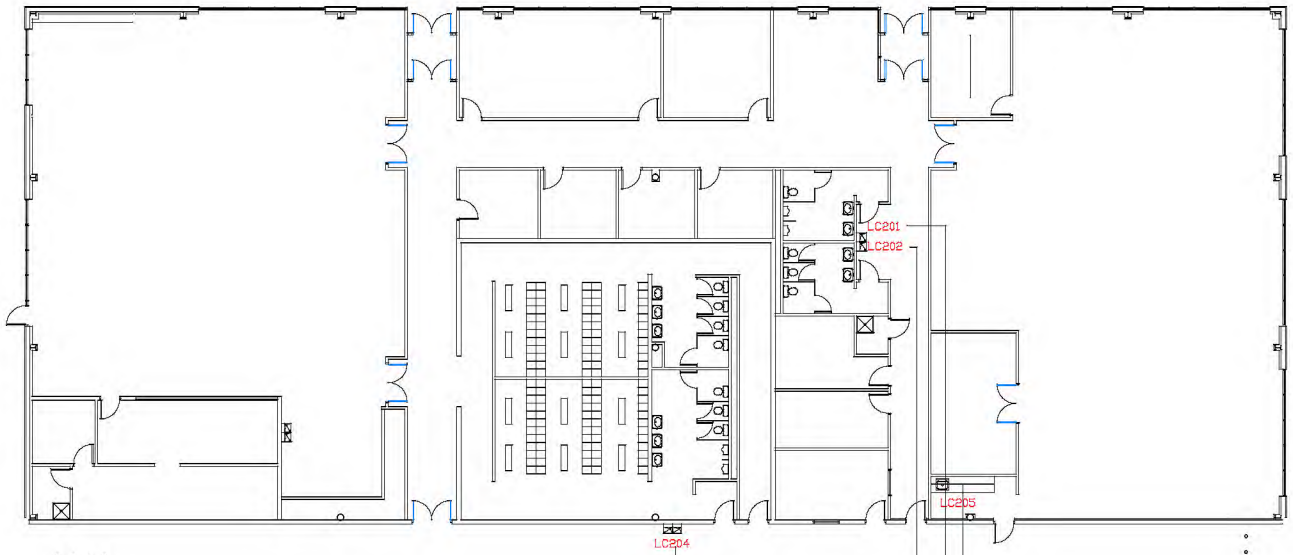

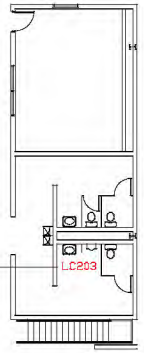

SMP ID	TAP LOCATION
LC201	2F VISITORS ENTRANCE MEN'S RR SINK
LC202	2F VISITORS ENTRANCE LEFT DRINKING FOUNTAIN
LC203	2F BACK MEN'S RR SINK
LC204	2F LEFT TIME CLOCK DRINKING FOUNTAIN
LC205	2F KITCHEN SINK

PWS NAME
2F WELL

PWS ID
OH 4648112

2F BUILDING 2000
PLUMBING MATERIALS USED AT MIDWEST EXPRESS, INCORPORATED
FIT THE TIME PERIOD BETWEEN 1986–2014, WHEN LEAD SOLDER
WAS BANNED AND THERE WAS LOWER CONTENT OF LEAD IN BRASS

Midwest Express, Inc.
Engineering Division
East Liberty Plant
11500 TR 208
East Liberty, OHio 43319
a subsidiary of Tanda Logistics North America

BUILDING 2F
Cu/Pb
PWS TAP LOCATION

DRAWING NUMBER: SKETCH12–15
REV: C