



2A

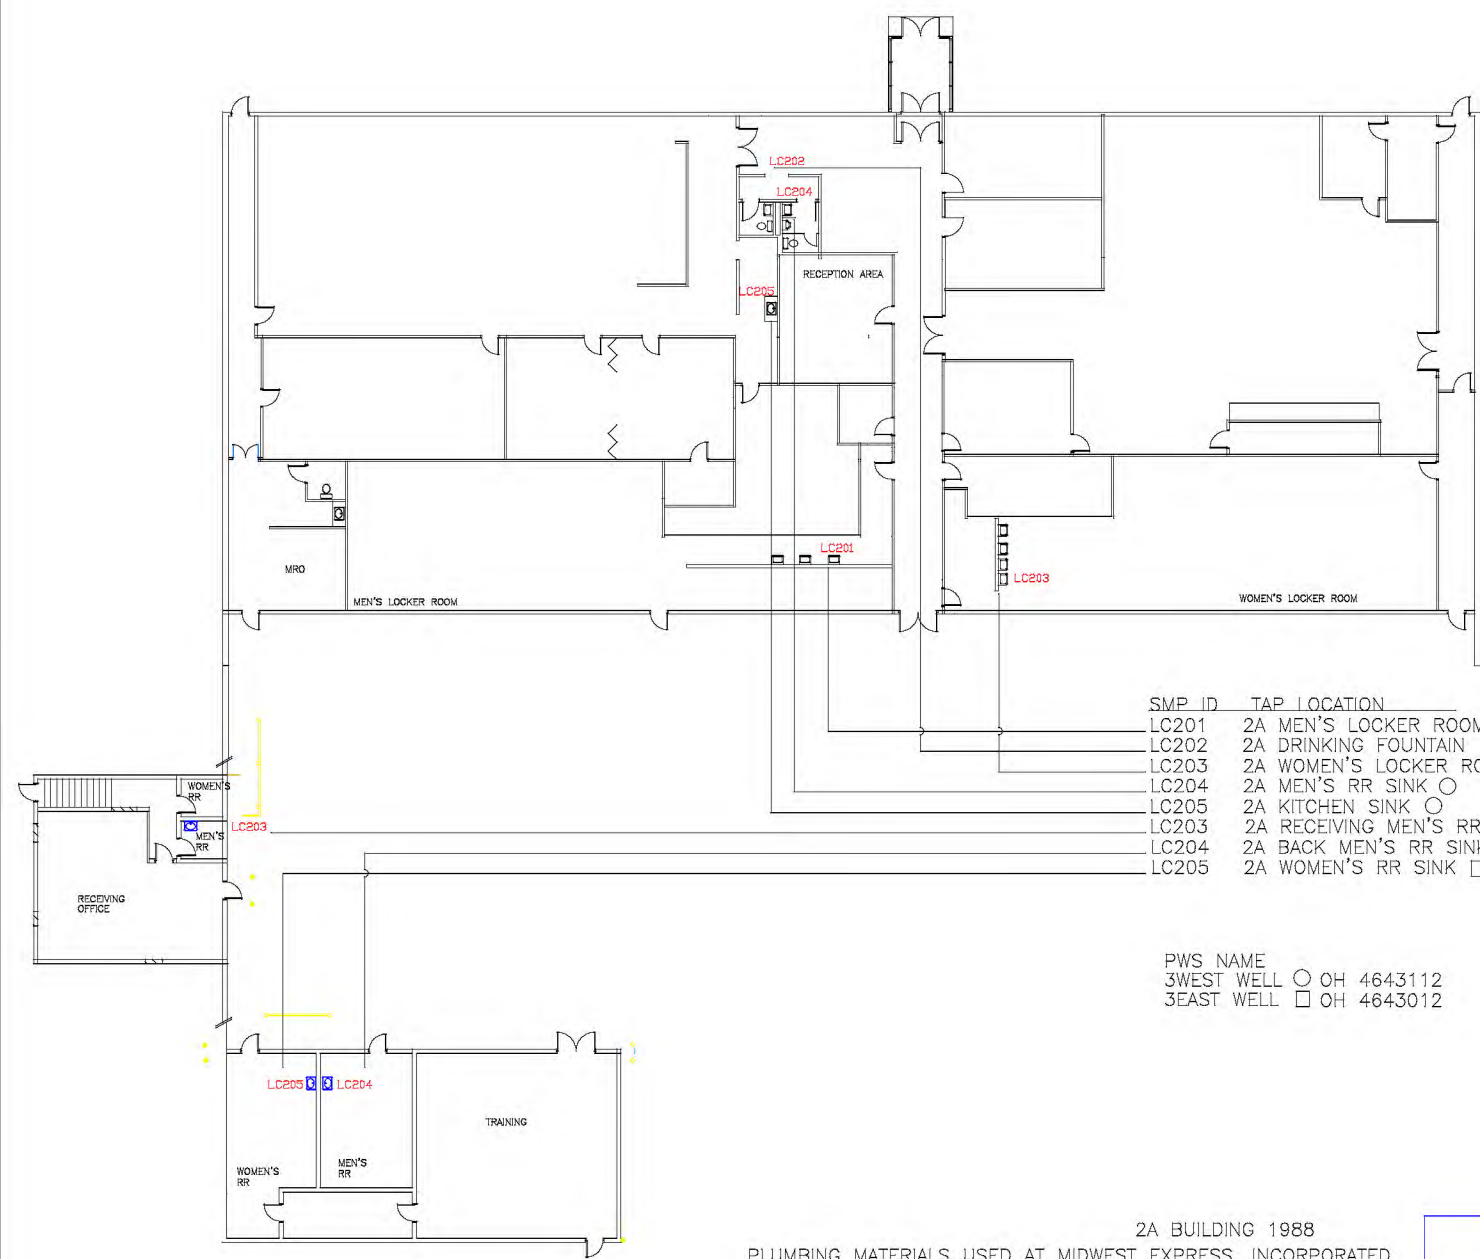


SMP ID	TAP LOCATION	Symbol
LC201	2A MEN'S LOCKER ROOM SINK1	○
LC202	2A DRINKING FOUNTAIN	○
LC203	2A WOMEN'S LOCKER ROOM SINK 2	○
LC204	2A MEN'S RR SINK	○
LC205	2A KITCHEN SINK	○
LC203	2A RECEIVING MEN'S RR SINK	□
LC204	2A BACK MEN'S RR SINK	□
LC205	2A WOMEN'S RR SINK	□

PWS NAME
 3WEST WELL ○ OH 4643112
 3EAST WELL □ OH 4643012

2A BUILDING 1988
 PLUMBING MATERIALS USED AT MIDWEST EXPRESS, INCORPORATED
 FIT THE TIME PERIOD BETWEEN 1986-2014, WHEN LEAD SOLDER
 WAS BANNED AND THERE WAS LOWER CONTENT OF LEAD IN BRASS





Midwest Express, Inc.

BUILDING 2A
 Cu/Pb
 PWS TAP LOCATION
 SKETCH12-15 C