


ELB building OH4651412

13434 St Rt 287
 East Liberty Ohio
 43319

- Hot water
- Cold water
- Service water

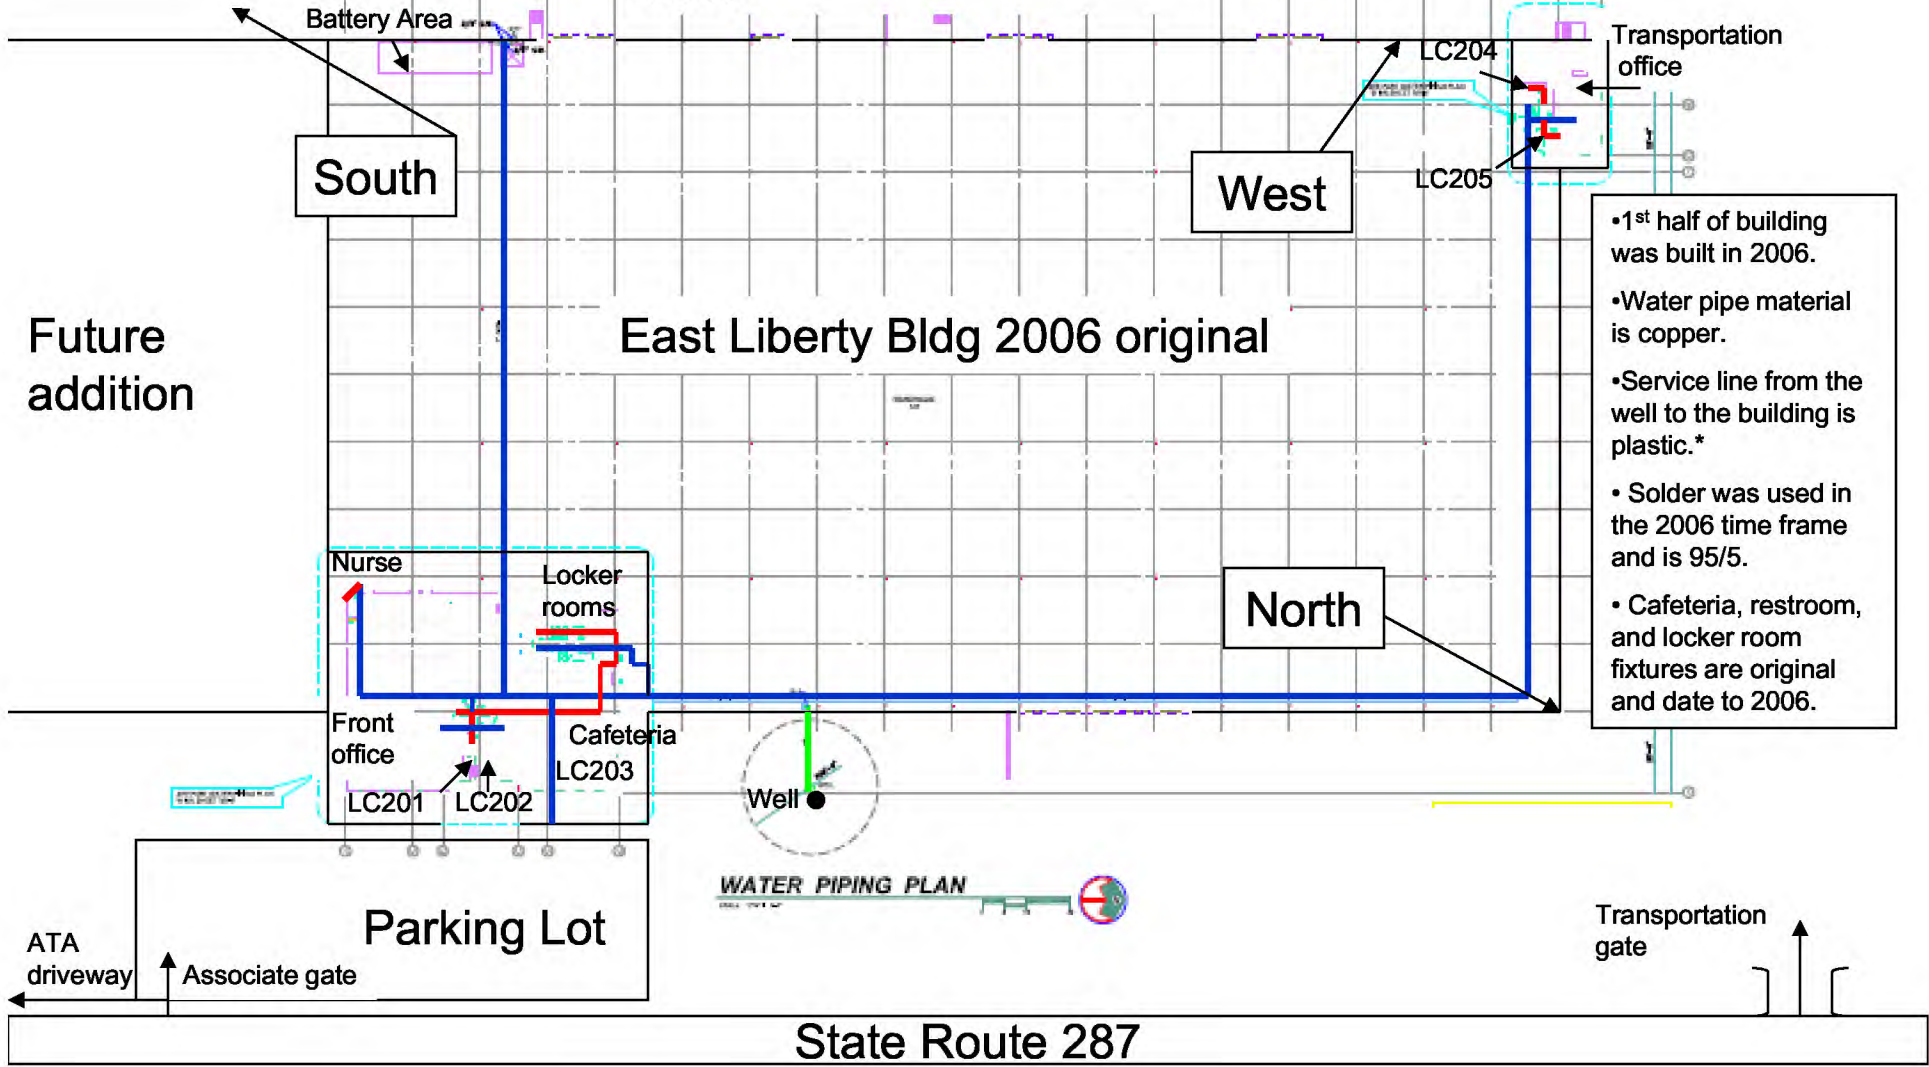


- 1st half of building was built in 2006.
- Water pipe material is copper.
- Service line from the well to the building is plastic.*
- Solder was used in the 2006 time frame and is 95/5.
- Cafeteria, restroom, and locker room fixtures are original and date to 2006.

WATER PIPING PLAN


State Route 287

Interstate 33

Interstate 33

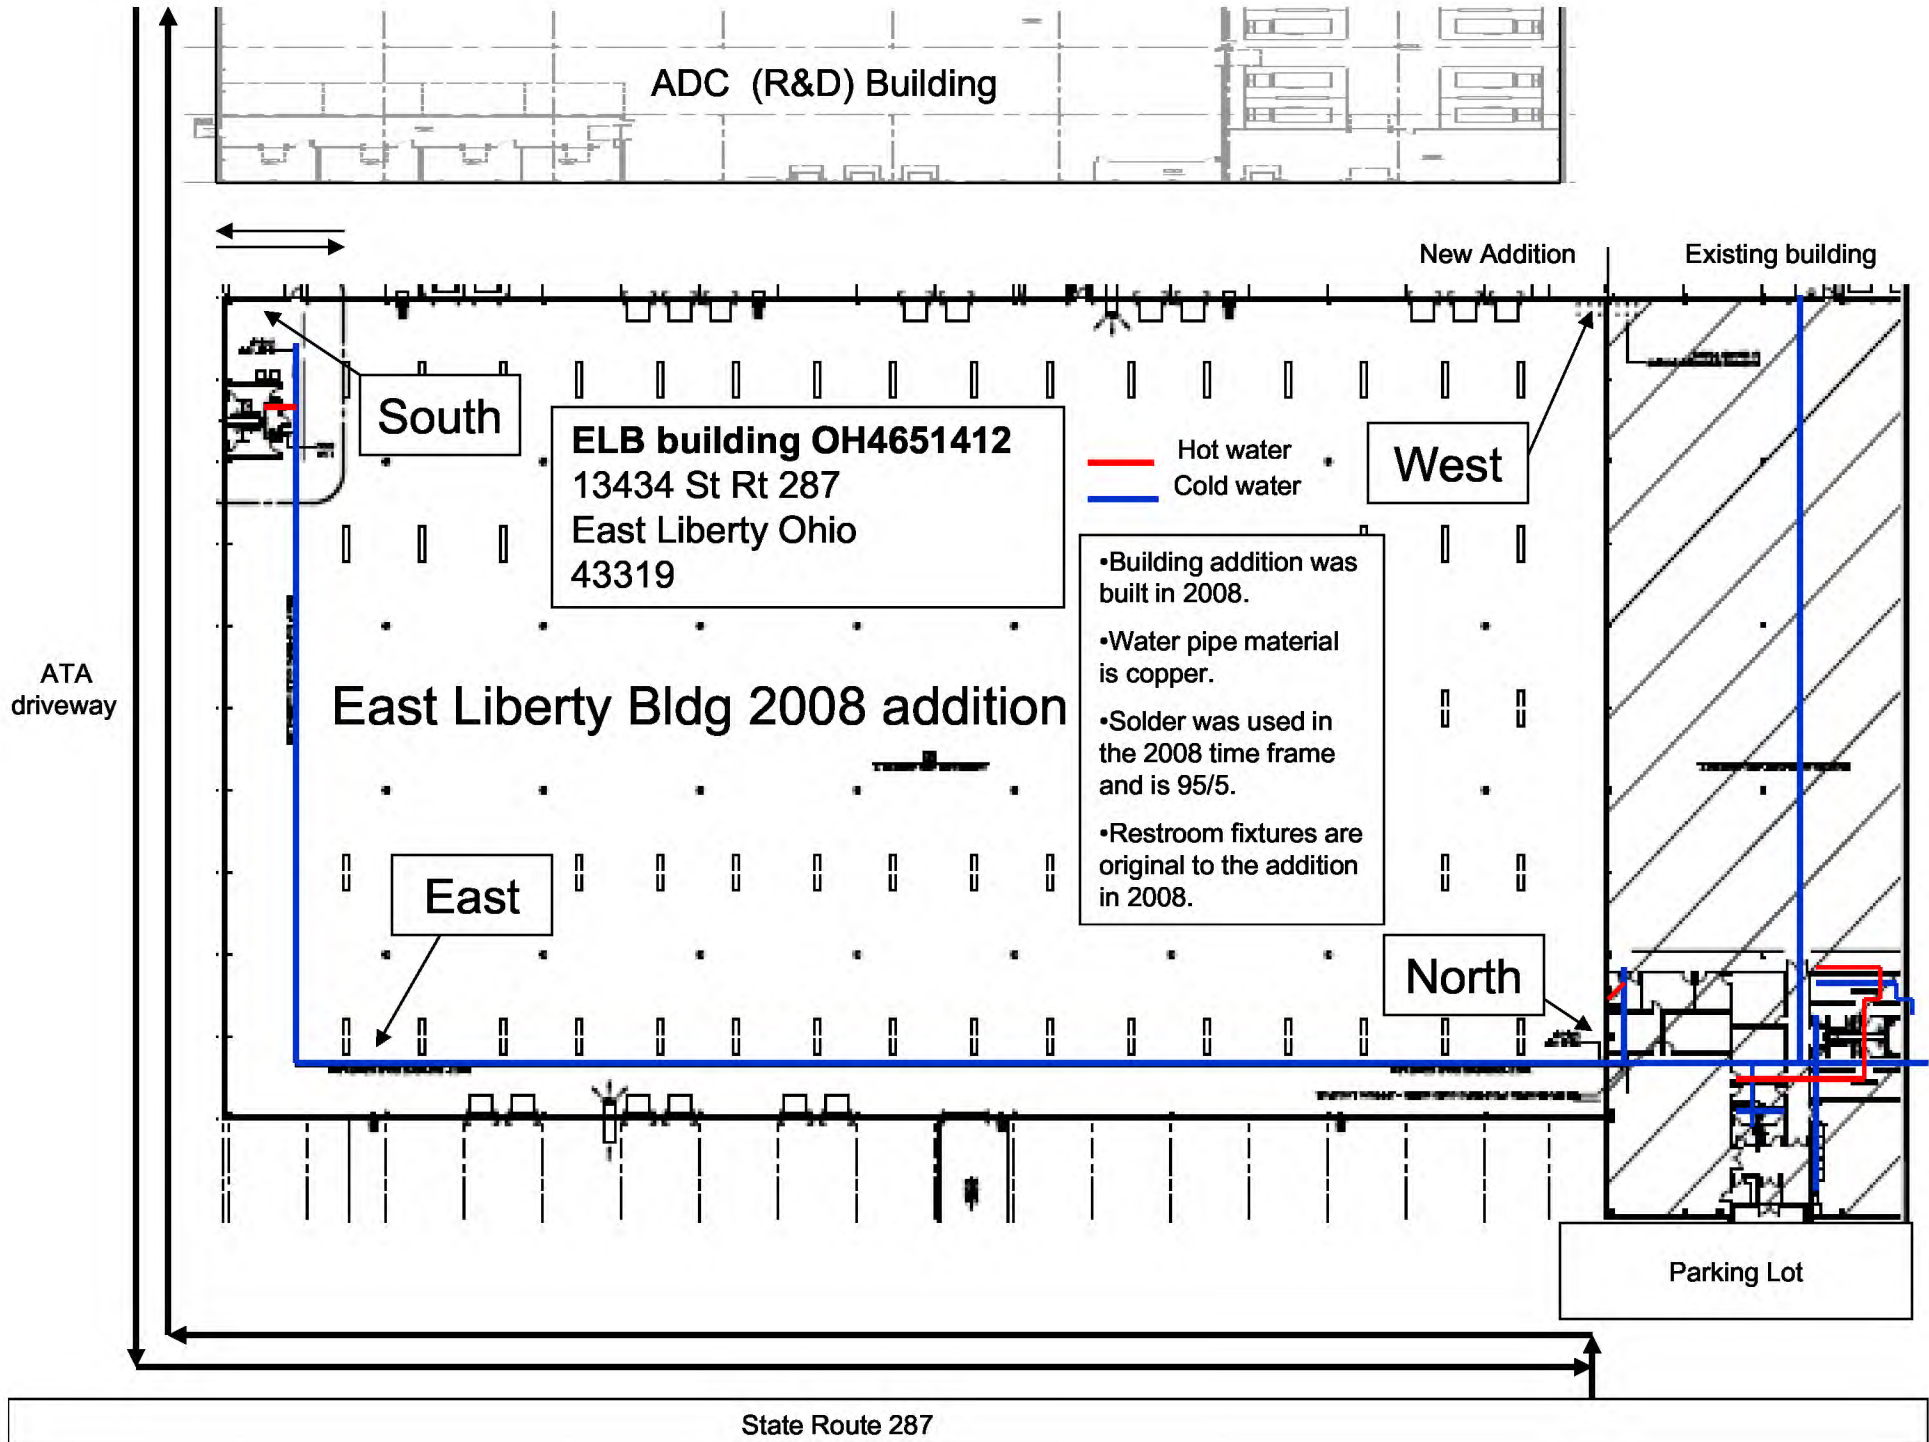

Driveway to front
of ELB Bldg and
State Route 287

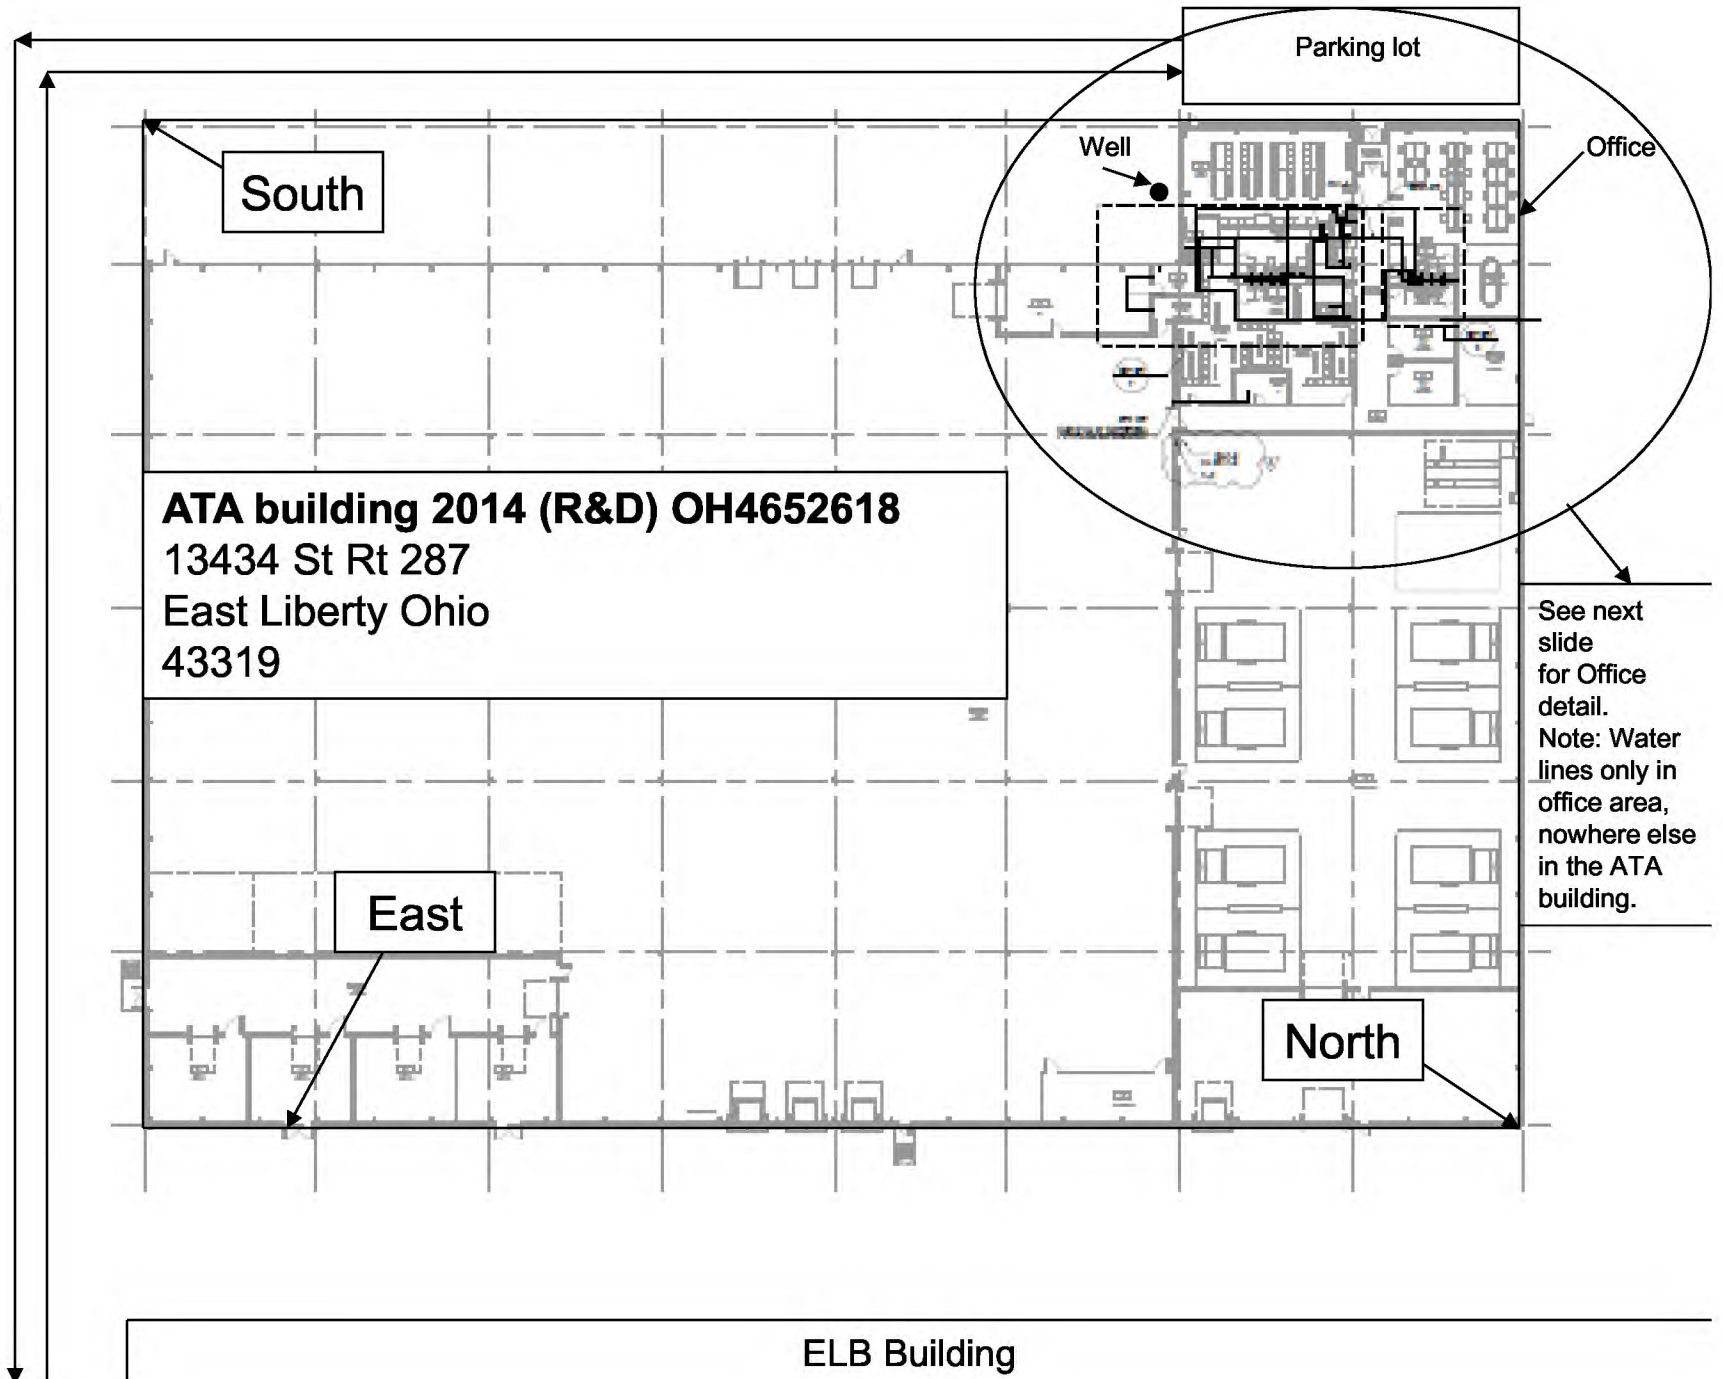

South

Parking lot

Well

Office


ATA building 2014 (R&D) OH4652618
13434 St Rt 287
East Liberty Ohio
43319


East

North

ELB Building

See next
slide
for Office
detail.
Note: Water
lines only in
office area,
nowhere else
in the ATA
building.

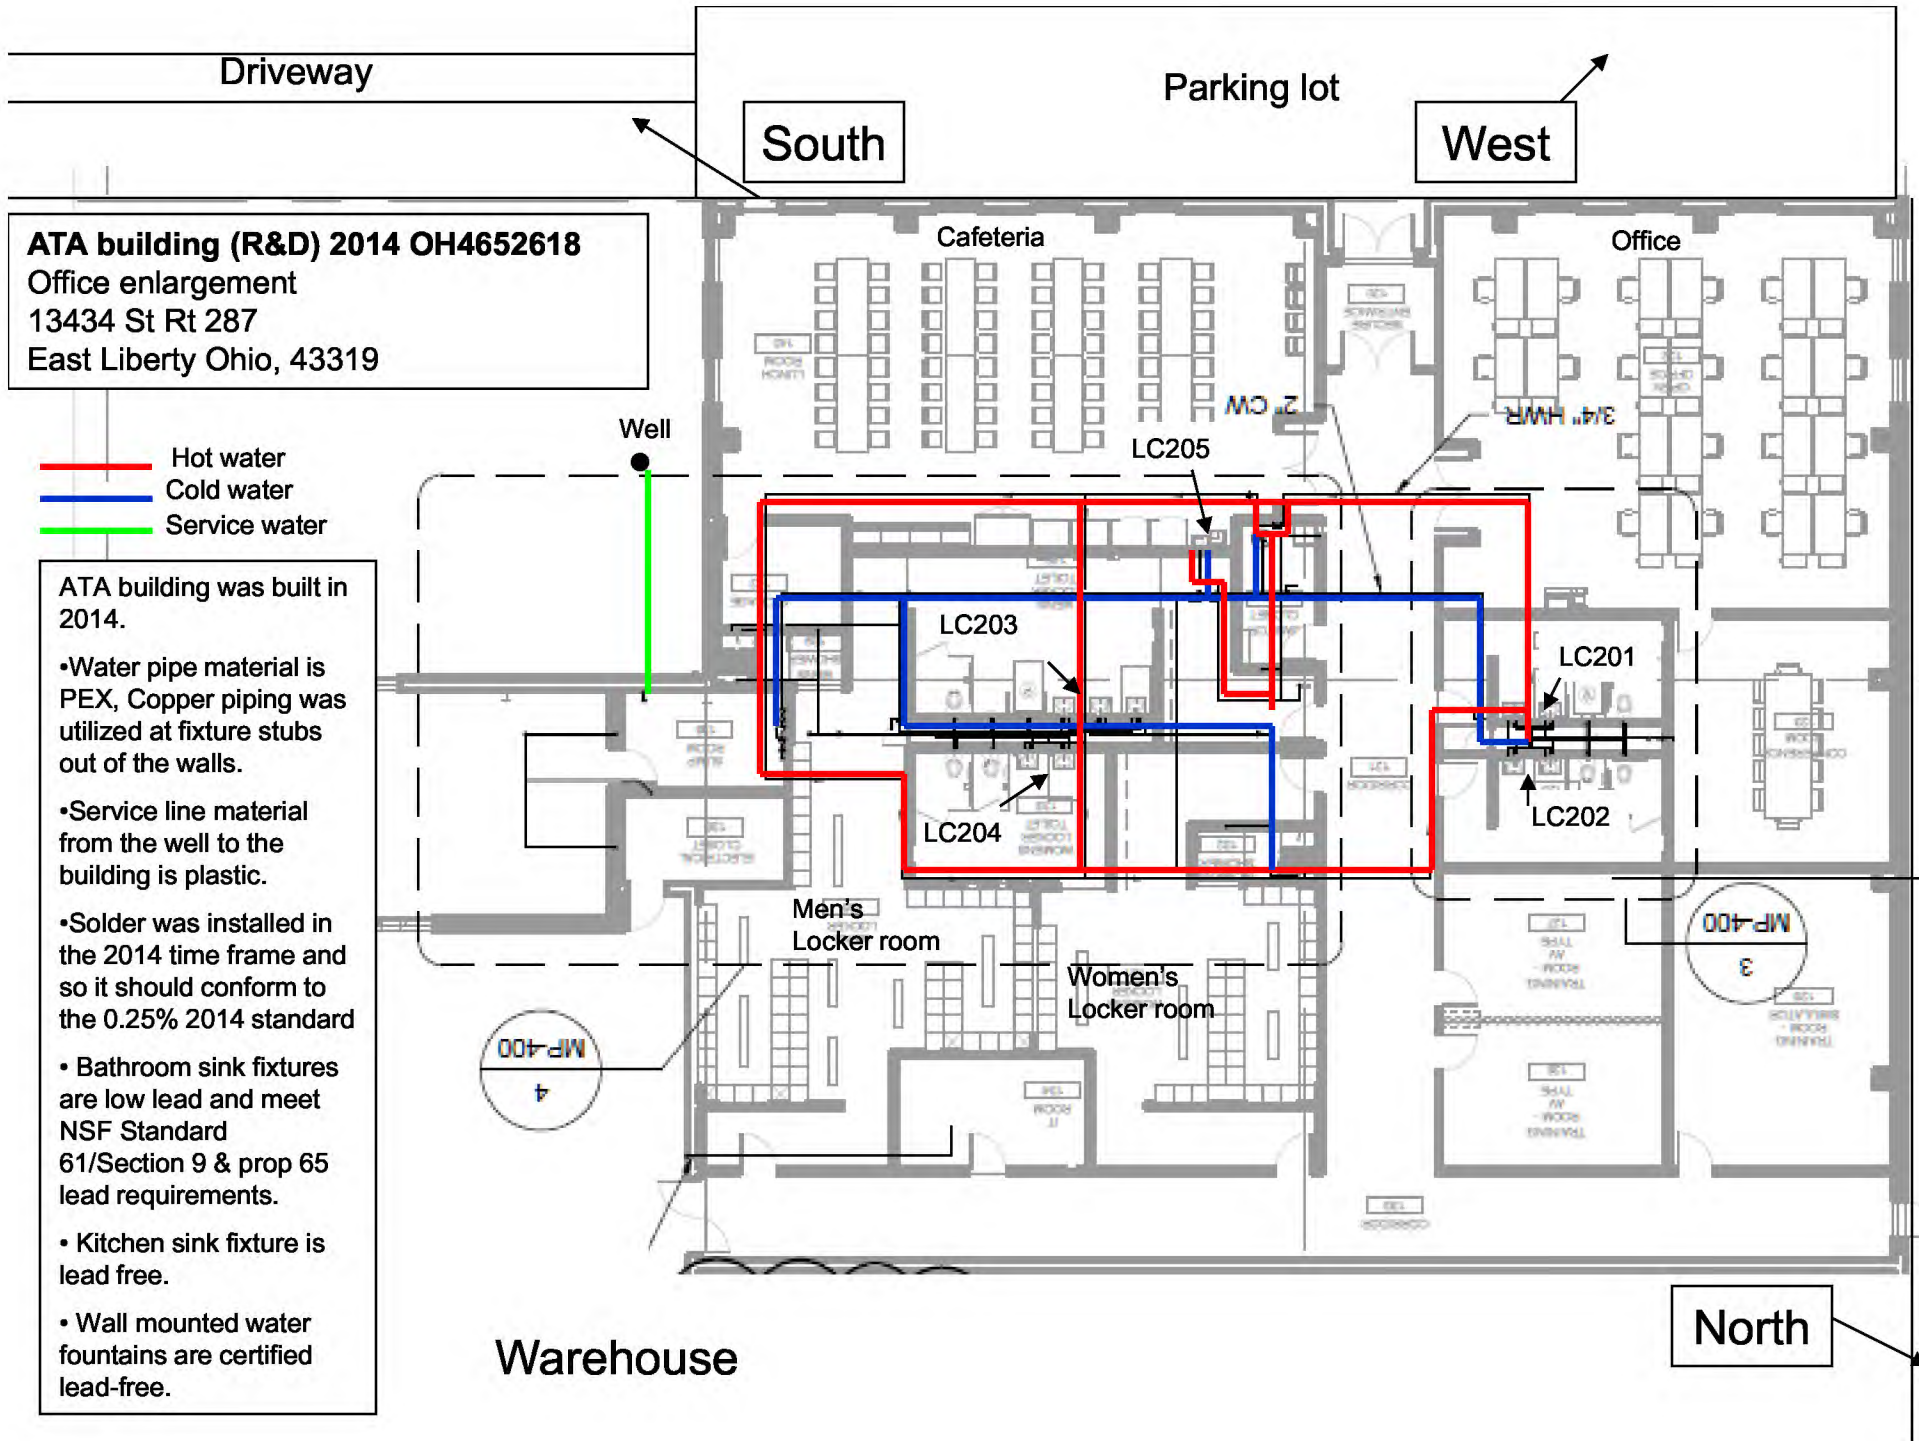

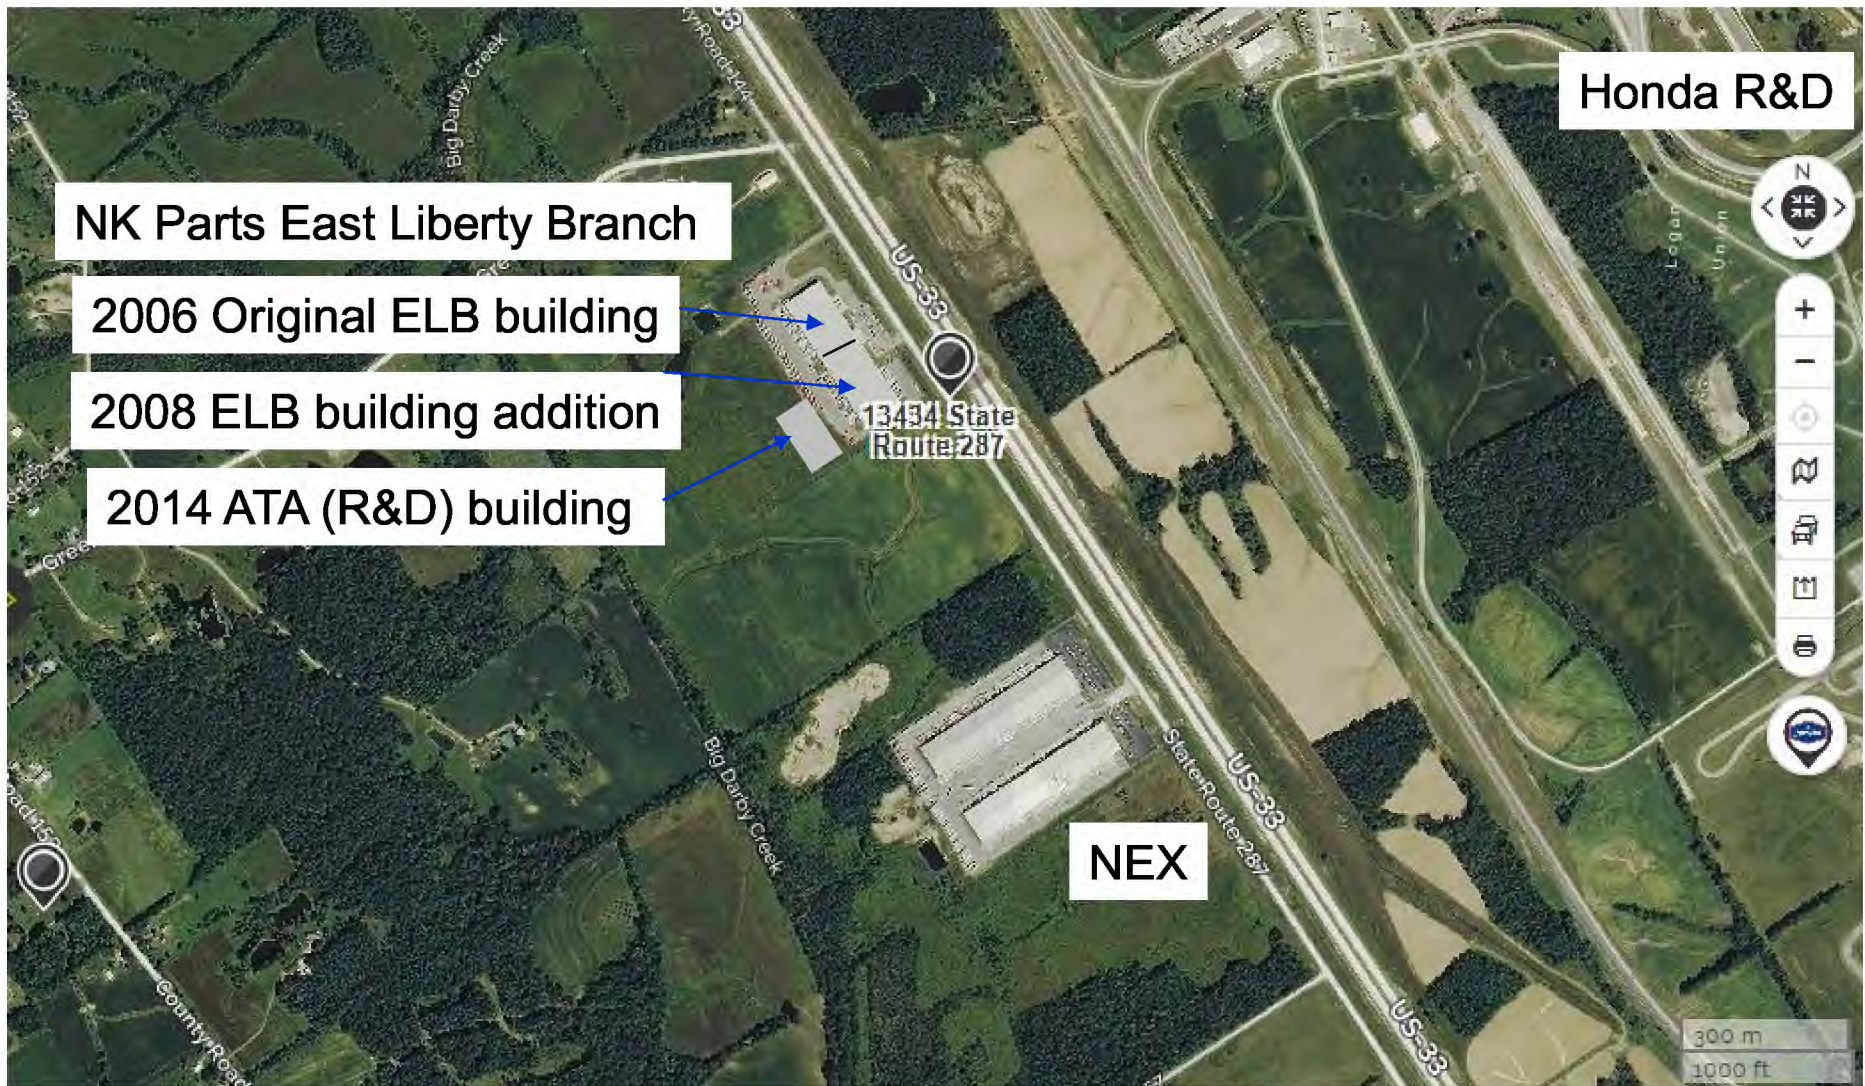

Honda R&D

NK Parts East Liberty Branch

2006 Original ELB building

2008 ELB building addition

2014 ATA (R&D) building

13434 State Route 287

NEX

300 m
1000 ft