



RE: CARBO FORGE
Report
Drinking Water Program
Sandusky County
PWS ID: OH7251912

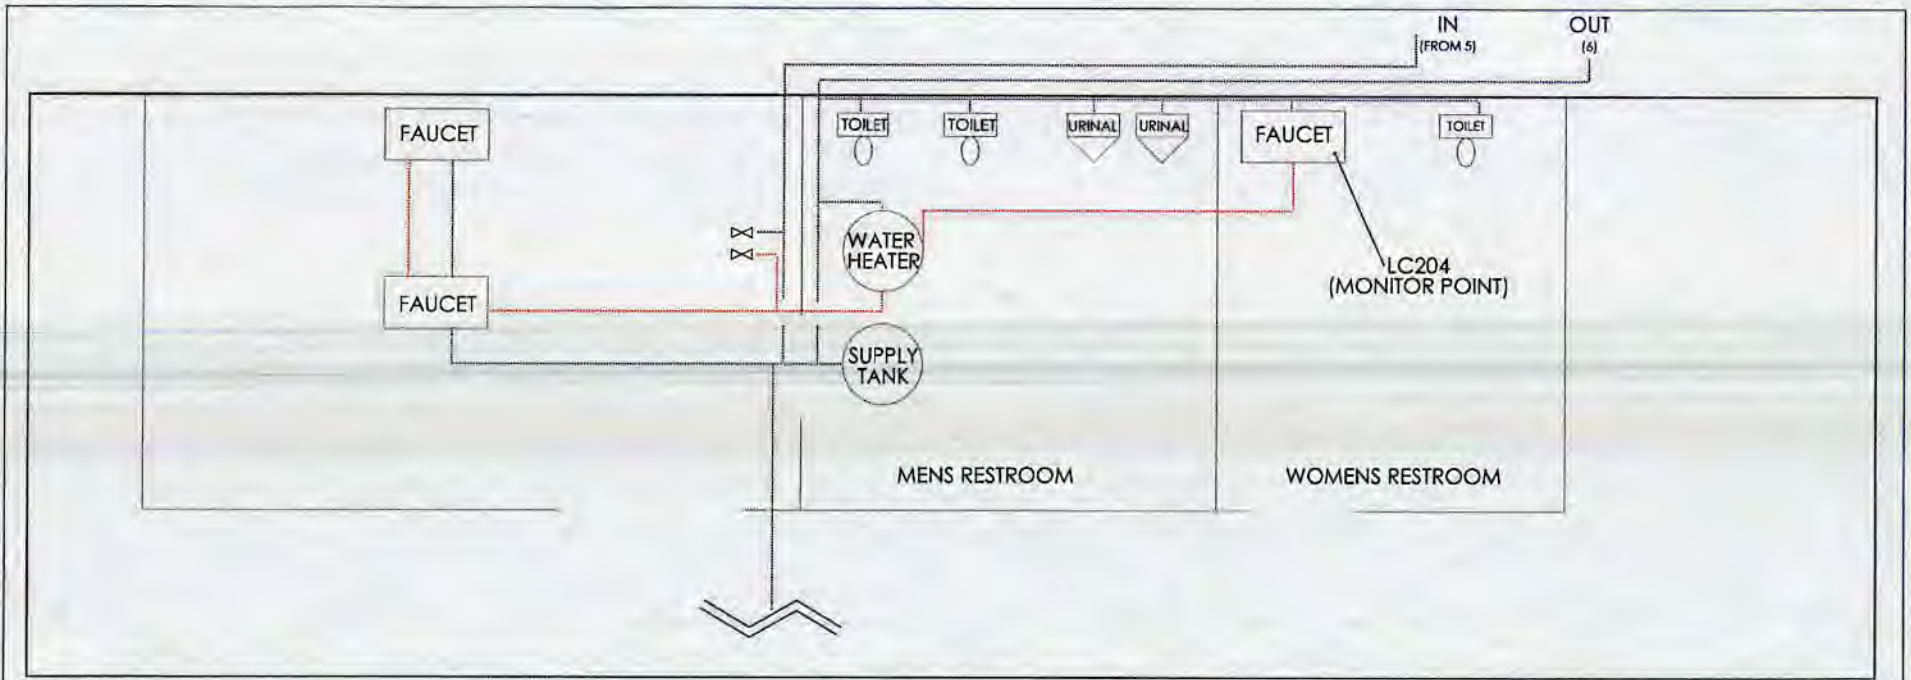

DETAIL B
SCALE 1 : 40

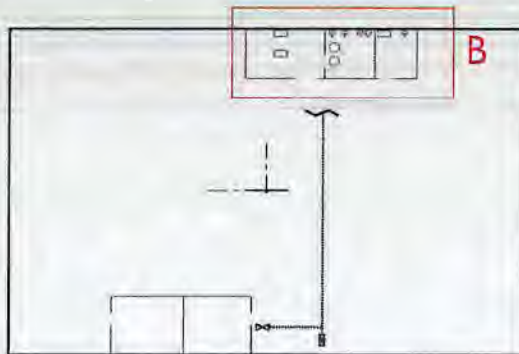

Installed 1976/1977.




LEGEND HOT WATER COLD WATER GATE VALVE BALL VALVE	PROPRIETARY AND CONFIDENTIAL: THE INFORMATION IN THIS DRAWING IS THE PROPERTY OF CARBO FORGE INC. ANY REPRODUCTION IN PART OR IN WHOLE IS PROHIBITED WITHOUT THE WRITTEN PERMISSION OF CARBO FORGE INC.	Since 1961 Carbo Forge, Inc. 150 State Route 523 Fremont, OH 43420 P 419.334.9788 F 419.334.4767 www.carboforge.com	ISO/TS 16949 Registered		
				PLANT LOCATION TOOL ROOM LAYOUT	
SHEET REVISION P-A-01	DRAWN BY C. LUNSFORD	DATE 2/27/2017	SCALE 0.003:1	SIZE B	SHEET 1 of 1

RECEIVED

MAR 08 2017

DDAGW - NWDO

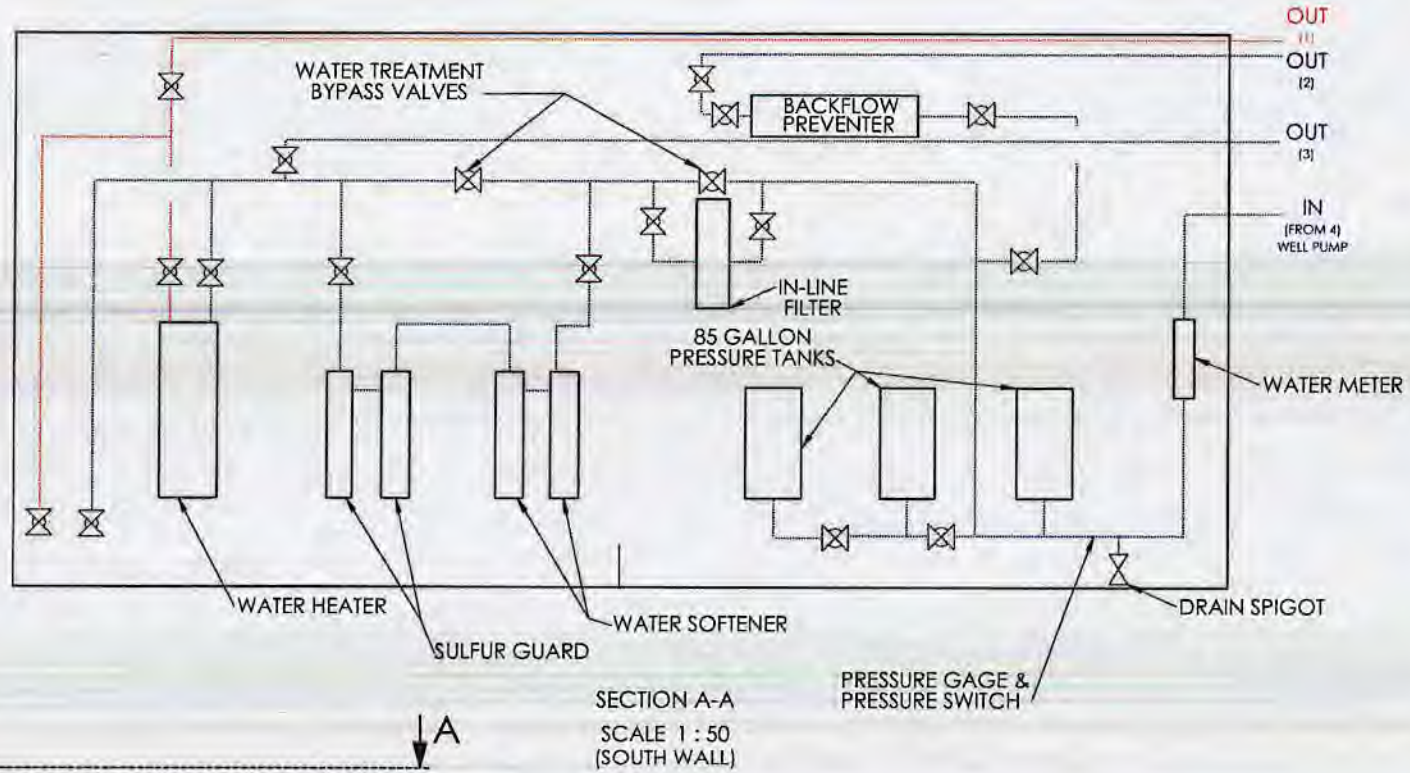

OUT (1)
OUT (2)
OUT (3)
IN (FROM 4) WELL PUMP

SECTION A-A
SCALE 1 : 50
(SOUTH WALL)



Installed 1976/1977.



LEGEND	
	HOT WATER
	COLD WATER
	GATE VALVE
	BALL VALVE

PROPRIETARY AND CONFIDENTIAL:
THE INFORMATION IN THIS DRAWING IS THE PROPERTY OF CARBO FORGE INC. ANY REPRODUCTION IN PART OR IN WHOLE IS PROHIBITED WITHOUT THE WRITTEN PERMISSION OF CARBO FORGE INC.





Carbo Forge, Inc.
150 State Route 523
Fremont, OH 43420
P 419.334.9288 F 419.334.4967
www.carboforge.com
ISO/TS 16949 Registered

FLANT LOCATION					
NORTH COMPRESSOR ROOM LAYOUT					
SHEET REVISION P-A-01	DRAWN BY C. LUNSFORD	DATE 2/27/2017	SCALE 0.01:1	SHEET 8	TOTAL SHEETS Tot 1


RECEIVED

MAR 08 2017
DDAGW - NWDO

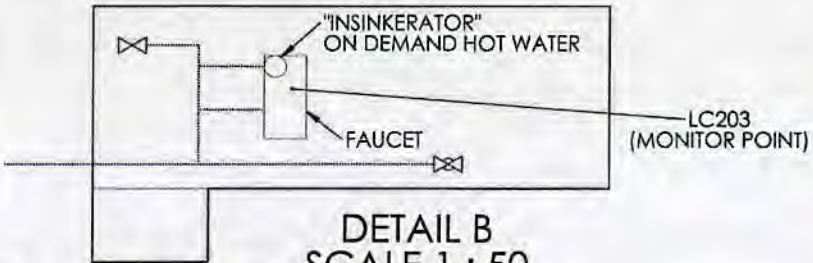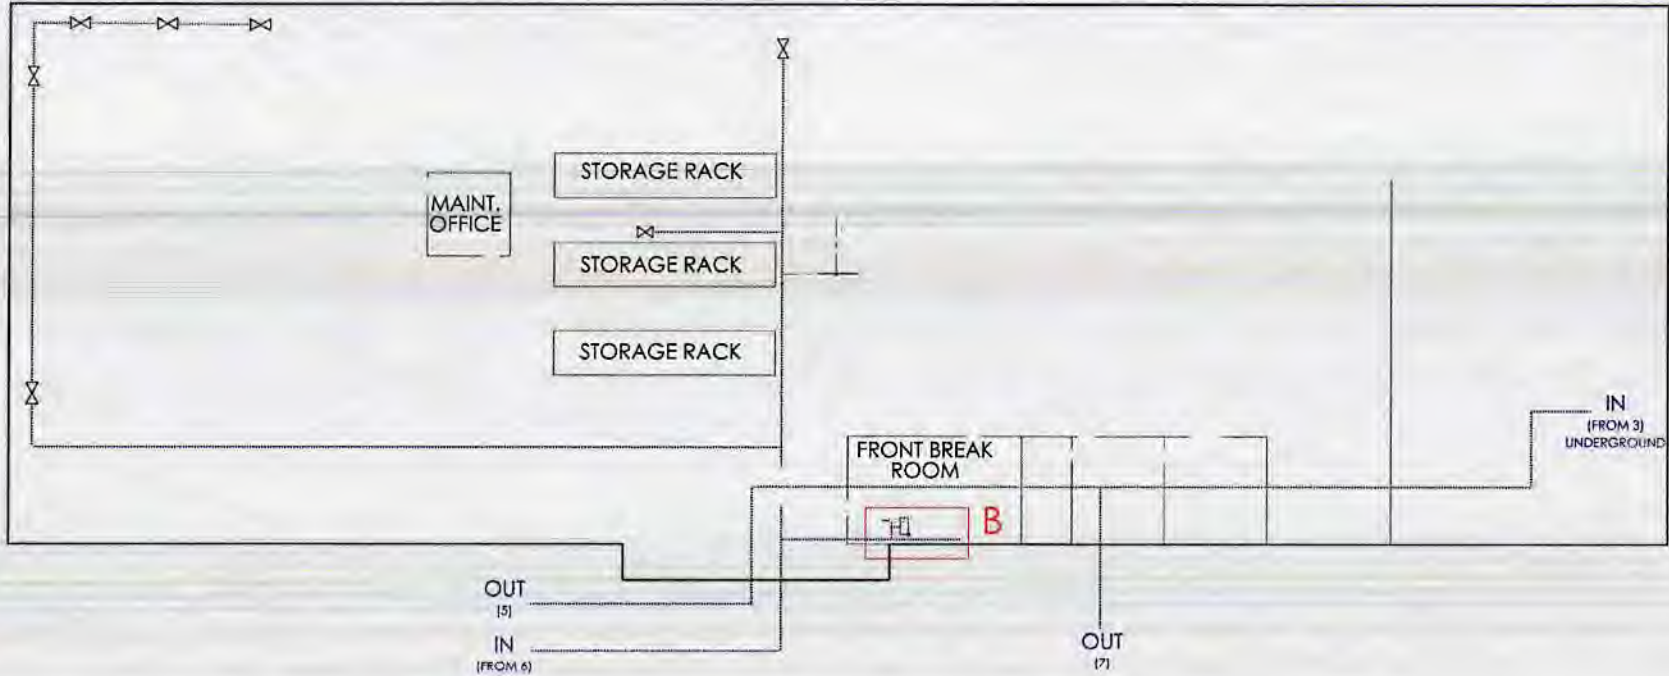

DETAIL B
SCALE 1 : 50
RECEIVED

MAR 08 2017
 DDAGW - NWDO

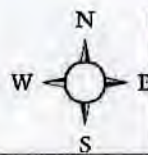

LEGEND	
	HOT WATER
	COLD WATER
	GATE VALVE
	BALL VALVE

PROPRIETARY AND CONFIDENTIAL:
 THE INFORMATION IN THIS DRAWING IS THE PROPERTY OF CARBO FORGE INC. ANY REPRODUCTION IN PART OR IN WHOLE IS PROHIBITED WITHOUT THE WRITTEN PERMISSION OF CARBO FORGE INC.




Carbo Forge, Inc.
 150 State Route 523
 Fremont, OH 43420
 P 419.334.9788 F 419.334.4967
 www.carboforge.com

ISO/TS 16949
 Registered

Partially installed 1976/1977
 and additions made in 1980.

FLAME LOCATION					
MAINTENANCE-SECONDARY-WHEELABRATOR LAYOUT					
SHEET REVISION	DRAWN BY	DATE	SCALE	DR	SHEET
P-A-01	C.LUNSFORD	2/27/2017	0.004:1	B	1 of 1

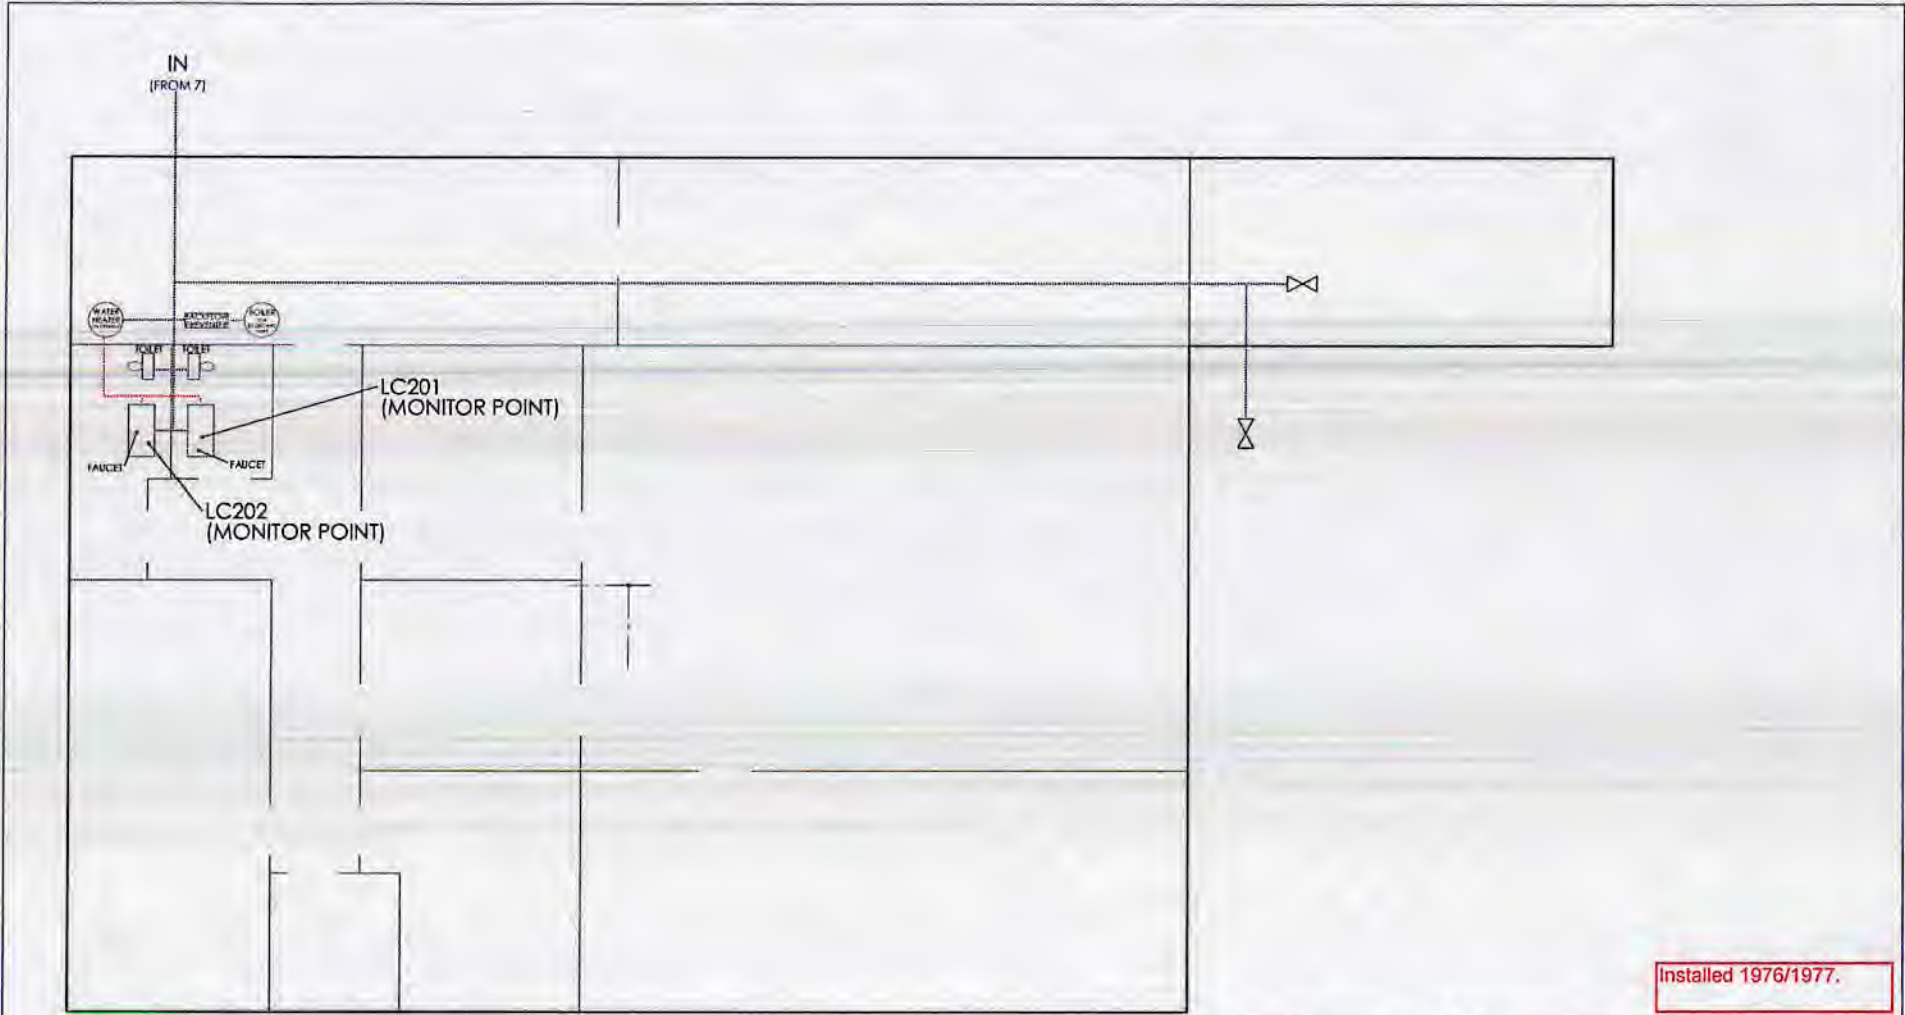

Installed 1976/1977.

RECEIVED

MAR 08 2017

DDAGW - NWDO



LEGEND

	HOT WATER
	COLD WATER
	GATE VALVE
	BALL VALVE

PROPRIETARY AND CONFIDENTIAL:
 THE INFORMATION IN THIS DRAWING IS THE PROPERTY OF CARBO FORGE INC. ANY REPRODUCTION IN PART OR IN WHOLE IS PROHIBITED WITHOUT THE WRITTEN PERMISSION OF CARBO FORGE INC.





Carbo Forge, Inc.
 150 State Route 523
 Fremont, OH 43420
 P 419.334.9788 F 419.334.4947
 www.carboforge.com

ISO/TS 16949
 Registered

FRONT OFFICE LAYOUT

SHEET REVISION	DRAWN BY	DATE	SCALE	SIZE	SHEET
P-A-01	C.LUNSFORD	2/27/2017	0.0125:1	B	1 of 1

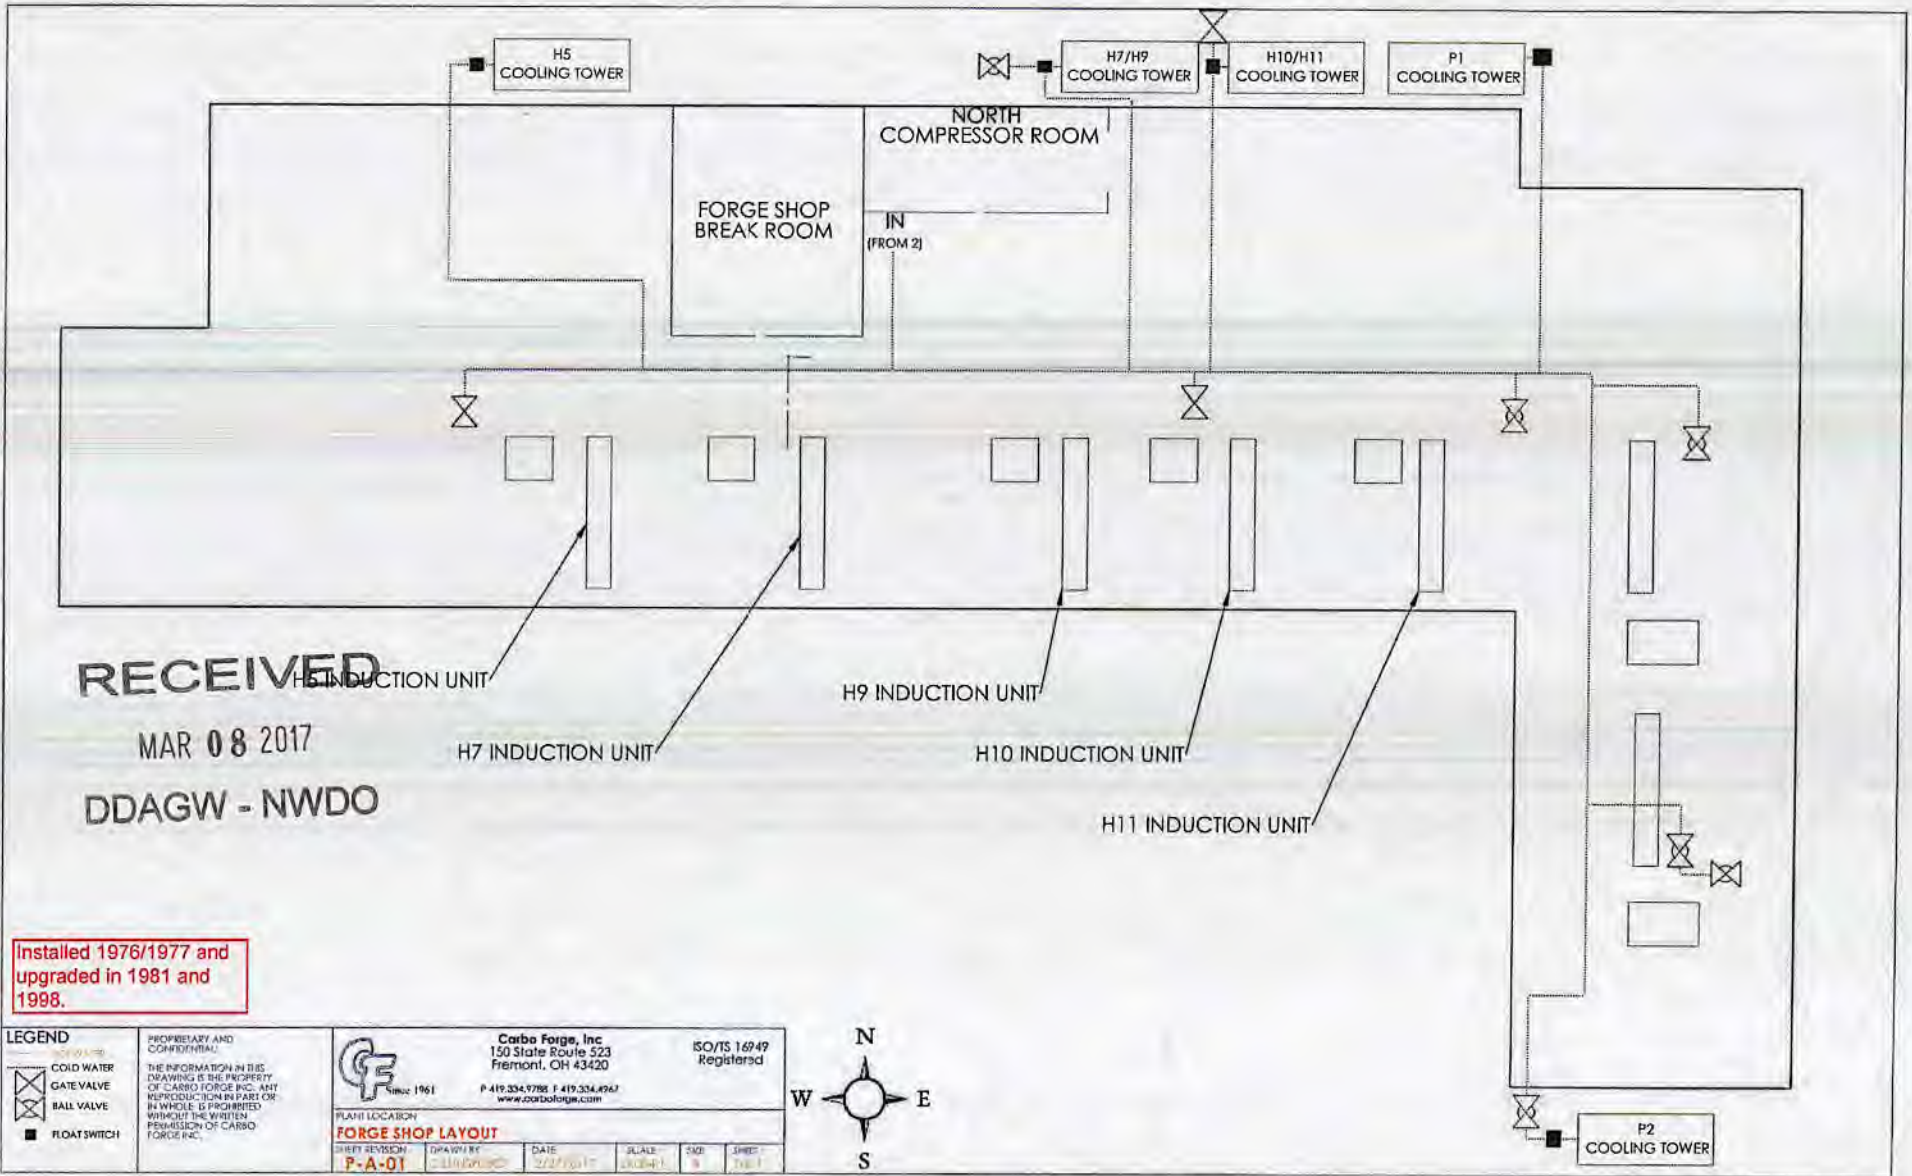

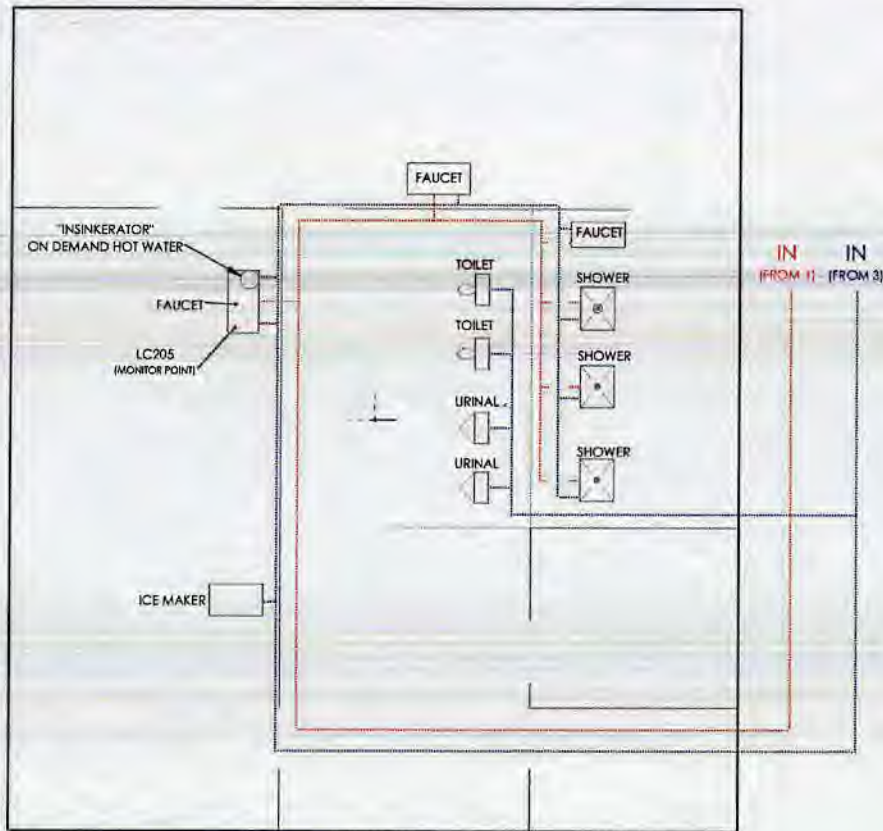

Installed 1976/1977 and upgraded in 1996.


RECEIVED

MAR 08 2017

DDAGW - NWDO



LEGEND HOT WATER COLD WATER GATE VALVE BALL VALVE	PROPRIETARY AND CONFIDENTIAL: THE INFORMATION IN THIS DRAWING IS THE PROPERTY OF CARBO FORGE INC. ANY REPRODUCTION IN PART OR IN WHOLE IS PROHIBITED WITHOUT THE WRITTEN PERMISSION OF CARBO FORGE INC.		Since 1961 Carbo Forge, Inc. 150 State Route 523 Fremont, OH 43420 P 419.334.9788 F 419.334.4947 www.carboforge.com		ISO/TS 16949 Registered	
	PLANT LOCATION Forge Shop Break Room					
SHEET REVISION P-A-01	DRAWN BY C.LUNSFORD	DATE 2/27/2017	SCALE 0.015:1	SIZE 8	SHEET 1 of 1	

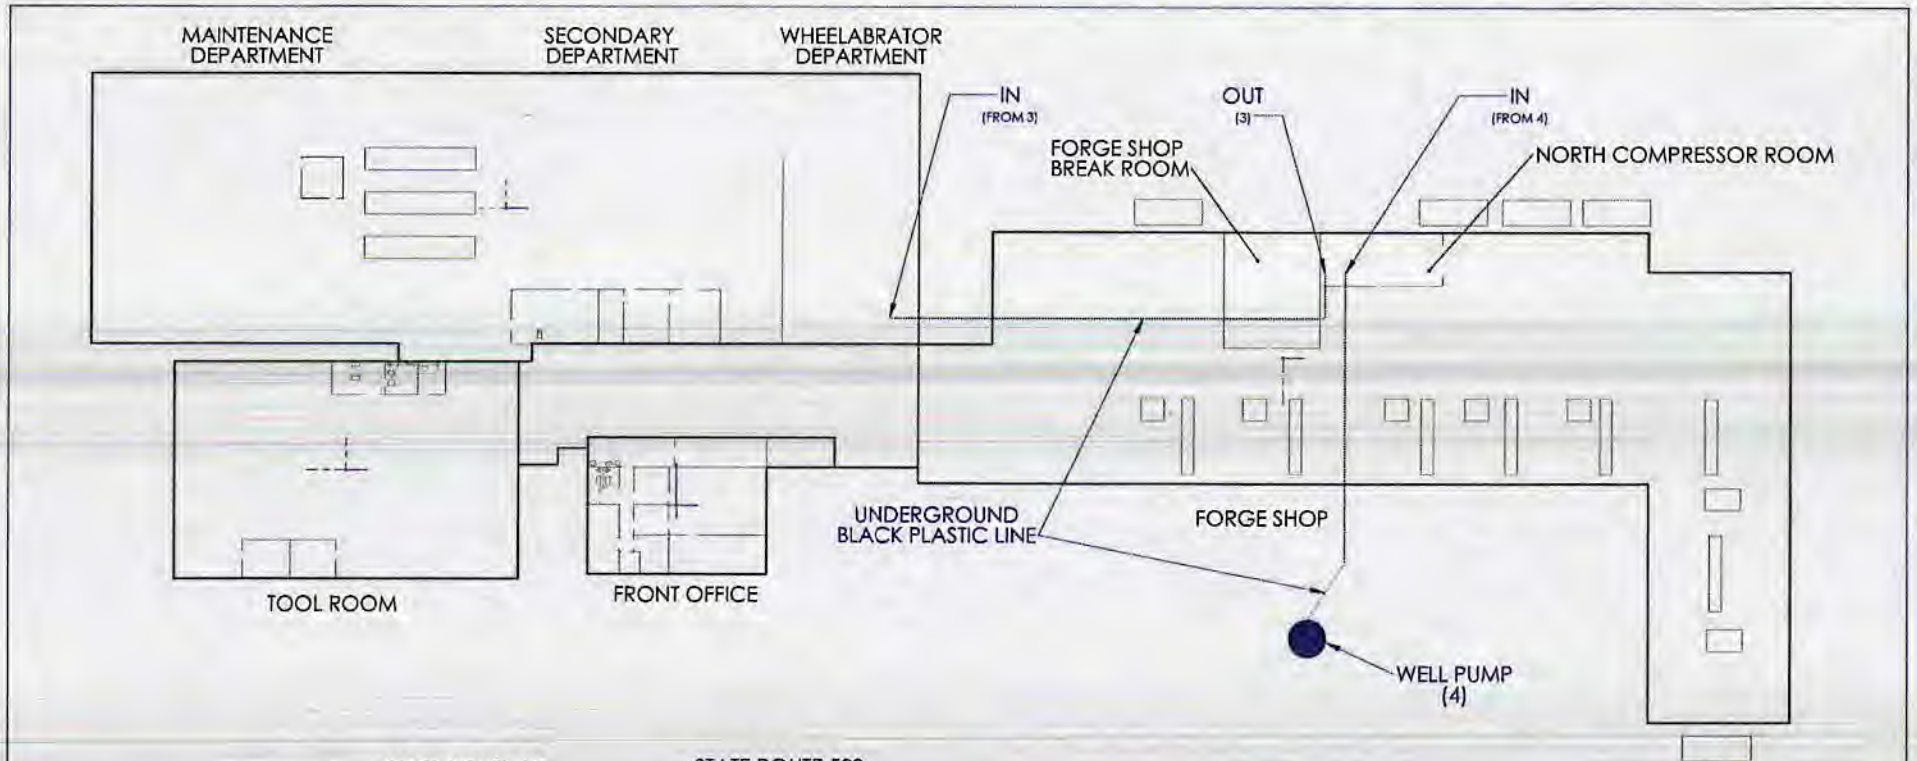


← STATE ROUTE 19 STATE ROUTE 523 ↓

Because it is practically impossible to determine the lead content of an installed fixture, fitting or pipe, it should be assumed that the manufacture or installation date is the primary indicator of the lead content. Therefore, the characteristics of buildings and piping solder or fixtures would be buildings built prior to 1998 or that use plumbing material or solder manufactured before 1998 may have material with greater than 8% lead and are at a high risk of contributing lead to the drinking water than material manufactured after 1998. In addition, buildings built and plumbing material manufactured after 2014 were required to have less than 0.25% lead by weight and have the lowest risk for contributing lead to the drinking water. It should be noted however that, although prohibited, some use of leaded solder or leaded components may have occurred after the prohibitions became effective.
****All piping should be considered copper unless identified otherwise.****



RECEIVED
 MAR 08 2017
 DDAGW - NWDO

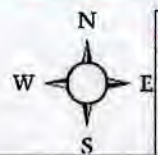

LEGEND HOT WATER COLD WATER GATE VALVE BALL VALVE	PROPRIETARY AND CONFIDENTIAL: THE INFORMATION IN THIS DRAWING IS THE PROPERTY OF CARBO FORGE INC. ANY REPRODUCTION IN PART OR IN WHOLE IS PROHIBITED WITHOUT THE WRITTEN PERMISSION OF CARBO FORGE INC.		Carbo Forge, Inc. 150 State Route 523 Fremont, OH 43420 P 419.334.9788 F 419.334.6967 www.carboforge.com	ISO/TS 16949 Registered
	PLANT LOCATION SHEET REVISION: P-A-01 DRAWN BY: C.LUNSFORD DATE: 2/27/2017 SCALE: 0.002:1 SIZE: B SHEET: 1 of 1			