

RE: NORTHLAND SENIOR
COMMUNITY
Report
Drinking Water Program
Williams County
PWS ID: OH8601112



INDUSTRIAL FLUID MANAGEMENT, INC.

McCLURE, OH | ATLANTIC, IA | HILLIARD, OH

March 7, 2017

2926 US HWY 6
McClure, OH 43534
866-435-4436

Re: Northland Senior Community
PWS ID: OH8601112
Williams County


To Whom It May Concern:

Industrial Fluid Management has been contracted by M. Shapiro Real Estate Group Ohio, LLC, 31550 Northwestern Highway, Suite 220, Farmington Hills, MI 48334, to prepare and submit the required documentation and mapping set forth in the Ohio House Bill 512 for Northland Senior Community 13673 County Road E, Bryan, OH 43506, Williams County, PWS ID: OH8601112.


All submitted information was translated from old hand drawn maps, therefore all water lines should be treated as lead service lines, until proper identification is completed. The age of the system is being considered unknown due to lack of documentation.

Industrial Fluid Management has been contracted as the operator of record for Northland Senior Community since July 8, 2013 to present, and can only answer relative question in that time frame. Furthermore, we take no responsibility for the information relayed to us concerning this matter. If you have any questions, please feel free to contact us at 866-435-4436.

Sincerely,

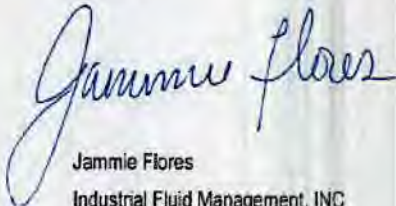
Jammie Flores
Industrial Fluid Management, INC

RECEIVED
MAR 07 2017
DDAGW - NWDO

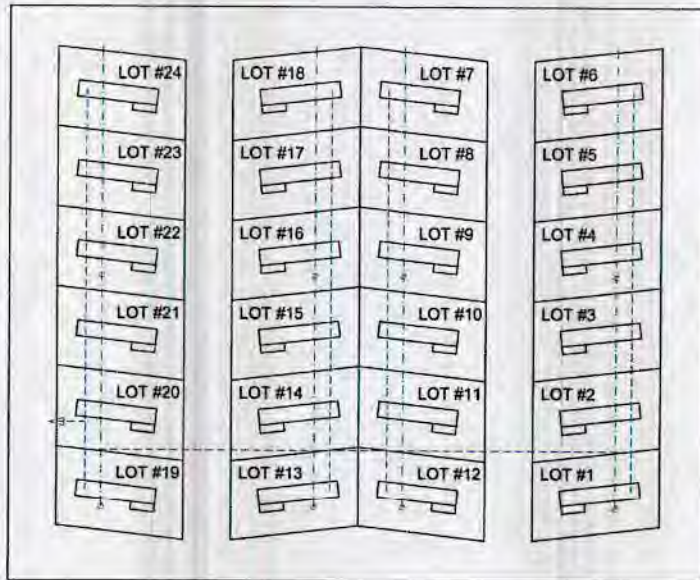

Buildings in Ohio built prior to 1998 or that use plumbing material or solder manufactured before 1998 may have materials with greater than 8% lead and are at a higher risk of contributing lead to the drinking water than materials manufactured after 1998. In addition, buildings built and plumbing materials manufactured after 2014 were required to have less than 0.25% lead by weight and have the lowest risk for contributing lead to the drinking water. It should be noted however that, although prohibited, some use of leaded solder or leaded components may have occurred after the prohibitions became effective.

DRAWING IS REPRESENTATION OF WATER AND SEWER LINES. DO NOT USE FOR BUILDING OR DIGGING. DRAWING IS REFERENCE ONLY.

LEGEND:		SMPID MAP
WATER:	-----	NORTHLAND COMMUNITY
SEWER:	-----	

RECEIVED
 MAR 07 2017
 DDAGW - NWDO