

HONEY CREEK

2/28/2017

**Honey Creek MHP, LLC.**  
11000 Marquart Rd.  
New Carlisle, Ohio 45344

The wells for Honey Creek MHP were installed on October 1, 1991. We purchased Honey Creek MHP on March 15, 2016. Attached you will find both Maintenance Records from March 15<sup>th</sup>, 2016 to date and The Well and Drilling report from Install.

The Pump House and Wells for Honey Creek MHP are located between off of Marquart Rd. between Jeffrey Ln. and Scott St. in the basement of the Office Building. This structure houses the community's Water System. From this structure, PVC Mains feed Steel Mains. You will note on the map Water Laterals are either Pex or Copper.

However, because it is practically impossible to determine the lead content of an installed fixture, fitting or pipe, it should be assumed that the manufacture or installation date is the primary indicator of the lead content. Therefore, the characteristics of buildings and piping solder or fixtures would be buildings in Ohio built prior to 1998 or that use plumbing material or solder manufactured before 1998 may have materials with greater than 8% lead and are at a higher risk of contributing lead to the drinking water than materials manufactured after 1998. In addition, buildings built and plumbing materials manufactured after 2014 were required to have less than 0.25% lead by weight and have the lowest risk for contributing lead to the drinking water. It should be noted however that, although prohibited, some use of leaded solder or leaded components may have occurred after the prohibitions became effective.

Approximately 60 Water Laterals are not in service.

Honey Creek MHP, LLC.  
HC PWS DISTRIBUTION SUMMARY




## VERIFICATION FORM FOR COMMUNITY PUBLIC WATER SYSTEMS CLAIMING NO LEAD SERVICE LINES

The owner or operator of all community public water systems must identify and map areas of their distribution system that are known or are likely to contain lead service lines. Systems must submit a copy of the applicable map to the Ohio Department of Health and the Ohio Department of Job and Family Services. Systems must also submit a report to the director containing at least both of the following: (1) The applicable map with narrative, and (2) A list of sampling locations used to collect samples as required by Ohio Revised Code (ORC) Section 6109.121 and any rules adopted thereunder, including contact information for the owner and occupant of each sampling site.

Should a water system determine no lead service lines exist in their distribution system, they must provide information stating they reviewed, at the minimum, historical permit records and local ordinances, distribution maintenance records and information pertaining to installation dates or materials for all services lines. This information must be verified below.

I HEREBY CERTIFY THAT THE FOLLOWING METHOD(S) WERE USED TO DETERMINE NO LEAD SERVICE LINES EXIST IN THIS WATER SYSTEM'S DISTRIBUTION SYSTEM, AS REQUIRED BY ORC 6109.121(F):

LEAD SERVICE LINE VERIFICATION
<p><b>This PWS states they have no lead service lines and has reviewed the following information (select one or more of the following):</b></p> <ul style="list-style-type: none"><li><input type="checkbox"/> Historical permit records and/or local ordinances</li><li><input checked="" type="checkbox"/> Distribution maintenance records (i.e. meter replacement, waterline break repairs)</li><li><input type="checkbox"/> Information pertaining to installation dates for all service lines (i.e. after 1986 when lead services lines were banned)</li><li><input checked="" type="checkbox"/> Service line material of all service lines is known (i.e. all service lines are known to be PVC)</li></ul>

  
\_\_\_\_\_  
Signature of Responsible Person      Date 3-2-17  
Virginia Bolina district manager  
\_\_\_\_\_  
Printed Name and Title of Responsible Person

PWS NAME: Honey Creek  
PWS ID: OH 1206212  
COUNTY: Clark

### For Ohio EPA use only:

Date Verification Rec'd: \_\_\_\_\_

# HC Service Line Maintenance Record

Honey Creek MHP, LLC, 11000 Marquart Rd. New Carlisle, Ohio 45344

[illegible]

736359

Ohio Department of Natural Resources, Division of Water  
1939 Fountain Square Drive, Columbus, Ohio 43224 Phone (614) 265-6739

Permit Number EPA  
EASTWELL

SECTION LOT No. 26  
(CIRCLE ONE)

(ADDRESS OF WELL LOCATION A)

## CONSTRUCTION DETAILS

WELL LOG\*

☐ Bailing      ☐ Pumping      ☒ Other HP  
 Test rate 70 gpm      Duration of test 1 hrs.  
 Drawdown 10 ft.  
 Measured from: ☐ top of casing      ☒ ground level      ☐ Other \_\_\_\_\_  
 Static Level (depth to water) 47 ft.      Date: 9-26-91  
 Quality (clear, cloudy, taste, odor) clear

**\* (Attach a copy of the pumping test record, per section 1521.05, ORC)**

**PUMP**

Type of pump Submersible Capacity 10 gpm  
Pump set at 80 ft.  
Pump installed by Blessing Pump Service

**SKETCH SHOWING WELL LOCATION**

Show distances well lies from numbered state highways, street intersections, county roads, etc.

4

Well  
X ← 1/2 Mi →  
MATQUART Rd.  
ST. RT. 235

\*If additional space is needed to complete well log, use next consecutively numbered form.

DNR 7802.90

Signed Donald Estrow

Date 10-1-96

OPM Registration Number 481

Completion of this form is required by section 1521.05, Ohio Revised Code - file within 30 days after completion of drilling.

ORIGINAL COPY TO - ODNR, DIVISION OF WATER, 1939 FOUNTAIN SQ. DRIVE, COLS., OHIO 43224

Blue - Customer's copy Pink - Driller's copy Green - Local Health Dept. copy



## 736358

Ohio Department of Natural Resources, Division of Water  
1939 Fountain Square Drive, Columbus, Ohio 43224. Phone (614) 265-6739

Permit Number EPA  
West Well

SECTION LOT No. 26  
(CIRCLE ONE)

LOCATION OF PROPERTY: 1/2 MI. W. OF ST. RT. 235 ON MARQUART Rd. (North side)

<b>CASING</b>		Borehole Diameter <u>12 3/4</u> in.		<b>GROUT</b>	
<input type="checkbox"/> Diameter	<u>8" ± D.</u> in.	Length	_____ ft.	Material	<u>Benseal</u> Volume used <u>100 #</u>
<input type="checkbox"/> Diameter	_____ in.	Length	_____ ft.	Method of installation	<u>Thermite</u>
Type:	<input type="checkbox"/> Steel <input type="checkbox"/> Galv. <input checked="" type="checkbox"/> PVC	Wall Thickness	<u>SDR 21</u> in.	Depth: placed from	<u>0</u> ft. to <u>27</u> ft.
	<input type="checkbox"/> Other _____			<b>GRAVEL PACK (Filter Pack)</b>	
Joints:	<input type="checkbox"/> Threaded <input type="checkbox"/> Welded <input checked="" type="checkbox"/> Solvent	Material	_____	Volume used	_____
	<input type="checkbox"/> Other _____	Method of installation	_____		
Liner:	Length _____ Type _____	Wall Thickness	_____ in.	Depth: placed from	<u>X</u> ft. to _____ ft.
<b>SCREEN</b>		Pitless Device	<input checked="" type="checkbox"/> Adapter <input type="checkbox"/> Preassembled unit		
Type (wire wrapped, louvered, etc.)	_____	Material	_____	Use of Well	<u>Mobil Home Park</u>
Length _____ ft.	<input checked="" type="checkbox"/> Diameter _____ in.	<input checked="" type="checkbox"/> Rotary <input type="checkbox"/> Cable <input type="checkbox"/> Augered <input type="checkbox"/> Driven <input type="checkbox"/> Dug <input type="checkbox"/> Other _____		Date of Completion	<u>9-26-81</u>
Set between _____ ft. and _____ ft.	Slot _____				

## WELL TEST

☐ Bailing      ☐ Pumping      ☒ Other Alt  
 Test rate 50 gpm      Duration of test \_\_\_\_\_ hrs.  
 Drawdown 15 ft.  
 Measured from: ☐ top of casing      ☒ ground level      ☐ Other \_\_\_\_\_  
 Static Level (depth to water) 46 ft.      Date: 9-26-91  
 Quality (clear, cloudy, taste, odor) Clear

\*(Attach a copy of the pumping test record, per section 1521.05, ORC)

**PUMP**

Type of pump Submersible Capacity 50 gpm  
Pump set at 80' ft.  
Pump installed by Blessing Pump Service

SKETCH SHOWING WELL LOCATION

Show distances well lies from numbered state highways, street intersections, county roads, etc.

\*If additional space is needed to complete well log, use next consecutively numbered form.

DNR 7802.90

Signed Donald Eaton

Date 10-1-91

ODH Registration Number 41


Completion of this form is required by section 1521.05, Ohio Revised Code - file within 30 days after completion of drilling.

ORIGINAL COPY TO - ODNR, DIVISION OF WATER, 1939 FOUNTAIN SQ. DRIVE, COLS., OHIO 43224

Blue - Customer's copy Pink - Driver's copy Green - Local Health Dept. copy



Because it is practically impossible to determine the lead content of an installed fixture, fitting or pipe, it should be assumed that the manufacture or installation date is the primary indicator of the lead content. Therefore, the characteristics of buildings and piping solder or fixtures would be buildings in Ohio built prior to 1998 or that use plumbing material or solder manufactured before 1998 may have materials with greater than 8% lead and are at a higher risk of contributing lead to the drinking water than materials manufactured after 1998. In addition, buildings built and plumbing materials manufactured after 2014 were required to have less than 0.25% lead by weight and have the lowest risk for contributing lead to the drinking water. It should be noted however that, although prohibited, some use of leaded solder or leaded components may have occurred after the prohibitions became effective.

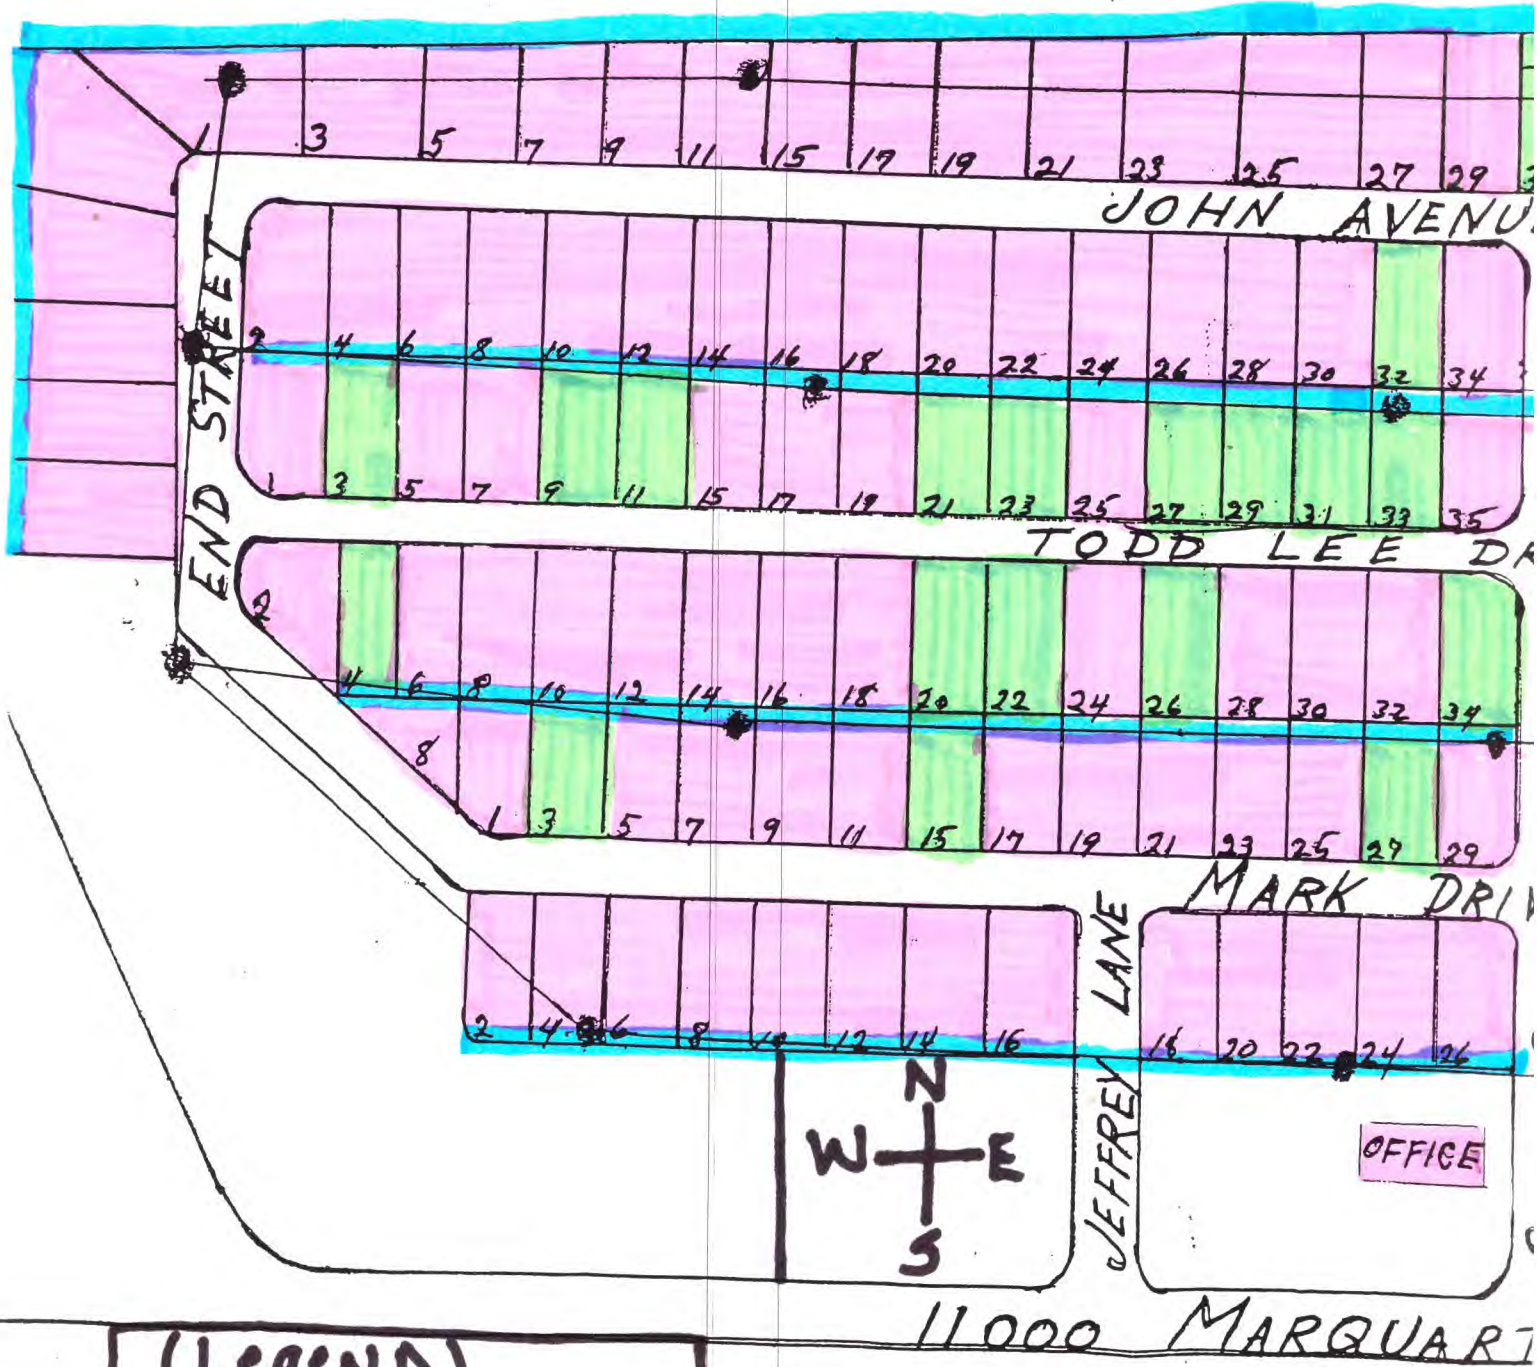

(LEGEND)  
Steel Mains: Blue  
Copper Feeds: PINK  
Pex Feeds : GREEN

PWS ID: 120621