


IRN # JR. HIGH- 017400
SR. HIGH- 014571

GREENON JR./SR. HIGH SCHOOL FIRST FLOOR
3950 SOUTH TECUMSEH RD.
SPRINGFIELD, OHIO

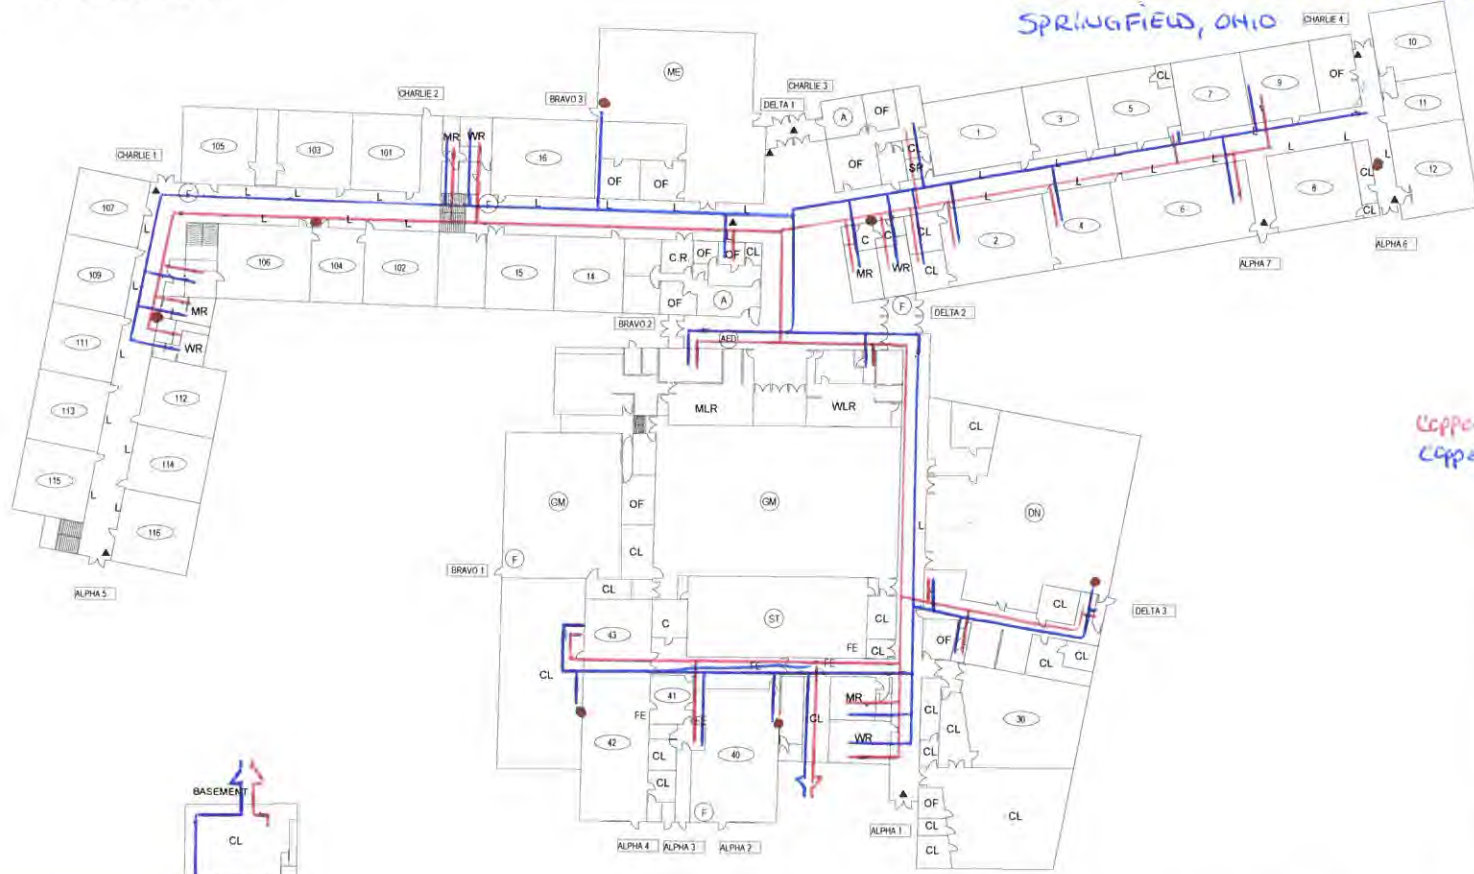


● = DRINKING WATER
Copper — = HOT WATER LINES
Copper — = COLD WATER LINES

CRITICAL	(AD)	LOCATION OF EXISTING AED	
	(E)	ELECTRICAL SHUTOFF	
	(FH)	FIRE HYDRANTS	
	(F)	FIRE ALARM PANEL	
	(G)	GAS SHUT-OFF	
	(K)	KNOX BOX	
	(S)	SPRINKLER SHUTOFF	
	(W)	WATER SHUTOFF	
	NON-CRITICAL	(A)	ADMINISTRATIVE SUITE
		(R)	AREA OF REFUGE
(▲)		CAMERA	
(COR)		CORRIDOR	
(E)		ELEVATOR	
(DR I)		EXTERIOR DOORS	
(FE)		FIRE EXTINGUISHER	
(P)		LOCATION OF BLUEPRINTS	
(RA)		ROOF ACCESS POINT	
(123)		ROOM NUMBER	
COMMON AREAS	(SM)	SECURITY MONITORING AND ACCESS CONTROL	
	(SE 1)	SERVICE ENTRANCE	

GREENON JR./SR. HIGH KEY:
MR - MEN'S RESTROOM
SMR - STAFF MEN'S RESTROOM
WR - WOMEN'S RESTROOM
SWR - STAFF WOMEN'S RESTROOM
WLR - WOMEN'S LOCKER ROOM
RR - UNISEX RESTROOM
SR - UNISEX STAFF RESTROOM
AV - AUDIO VISUAL ROOM
C - CUSTODIAL
C.OF - CUSTODIAL OFFICE
C.R. - CONFERENCE ROOM
OR - CLASS ROOM
DR - DISH ROOM
OF - OFFICE
E - ELEVATOR
CL - CLOSET / STORAGE AREA
M - MECHANICAL ROOM
L - LOCKERS
NR - NETWORK ROOM



SERVICE LINE

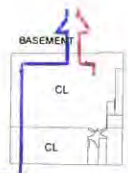

- All PLUMBING LINES ARE COPPER/GALV. IRON
- All FIXTURES ARE PRE-1998




- FIXTURES AND PLUMBING WERE INSTALLED PRIOR TO 1948 AND COULD CONTAIN LEAD PRODUCTS

GREENON JR./SR. HIGH SCHOOL
3950 S TECUMSEH RD
SPRINGFIELD, OHIO 45502
(937) 340-6372
FACILITY SAFETY PLAN
OHIO FACILITIES CONSTRUCTION COMMISSION

IRN # JR. HIGH- 017400
 SR. HIGH- 014571

GREENON JR./SR. HIGH SCHOOL SECOND FLOOR

• All PLUMBING LINES ARE COPPER/IRON GAV.

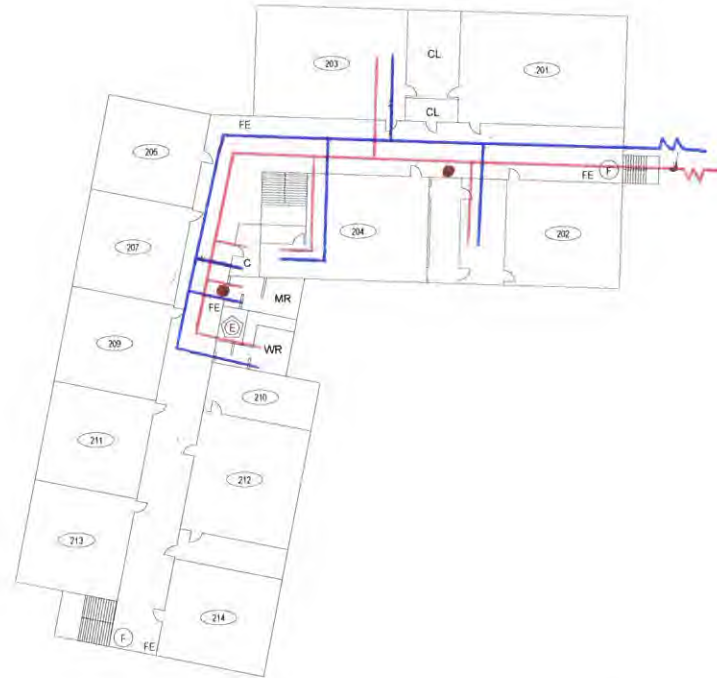

• = DRINKING FOUNTAINS
 — = HOT WATER LINES
 — = COLD WATER LINES

CRITICAL	(AED)	LOCATION OF EXISTING AED	
	(E)	ELECTRICAL SHUTOFF	
	(PH)	FIRE HYDRANT	
	(F)	FIRE ALARM PANEL	
	(G)	GAS SHUT OFF	
	(K)	KNOX BOX	
	(S)	SPRINKLER SHUTOFF	
	(W)	WATER SHUTOFF	
	NON-CRITICAL	(A)	ADMINISTRATIVE SUITE
		(R)	AREA OF REFUGE
(CAM)		CAMERA	
(COR)		CORRIDOR	
(E)		ELEVATOR	
(DR T)		EXTERIOR DOORS	
(FE)		FIRE EXTINGUISHER	
(P)		LOCATION OF BLUEPRINTS	
(RA)		ROOF ACCESS POINT	
(R#)		ROOM NUMBER	
(SM)	SECURITY MONITORING AND ACCESS CONTROL		
(SE 1)	SERVICE ENTRANCE		

GREENON JR./SR. HIGH KEY:
 MR - MEN'S RESTROOM
 SMR - STAFF MEN'S RESTROOM
 WR - WOMEN'S RESTROOM
 SWR - STAFF WOMEN'S RESTROOM
 WLR - WOMEN'S LOCKER ROOM
 RR - UNISEX RESTROOM
 SR - UNISEX STAFF RESTROOM
 AV - AUDIO VISUAL ROOM
 C - CUSTODIAL
 C.O.F - CUSTODIAL OFFICE
 C.R - CONFERENCE ROOM
 CR - CLASS ROOM
 DR - DISH ROOM
 OF - OFFICE
 E - ELEVATOR
 CL - CLOSET / STORAGE AREA
 M - MECHANICAL ROOM
 L - LOCKERS
 NR - NETWORK ROOM

COMMON AREAS	(DN)	DINING
	(GM)	GYMNASIUM
	(ME)	MEDIA
	(ST)	STAGE

GREENON JR./SR. HIGH SCHOOL
 3950 S TECUMSEH RD
 SPRINGFIELD, OHIO 45502
 (937) 340-6372
 FACILITY SAFETY PLAN
 OHIO FACILITIES CONSTRUCTION COMMISSION

